




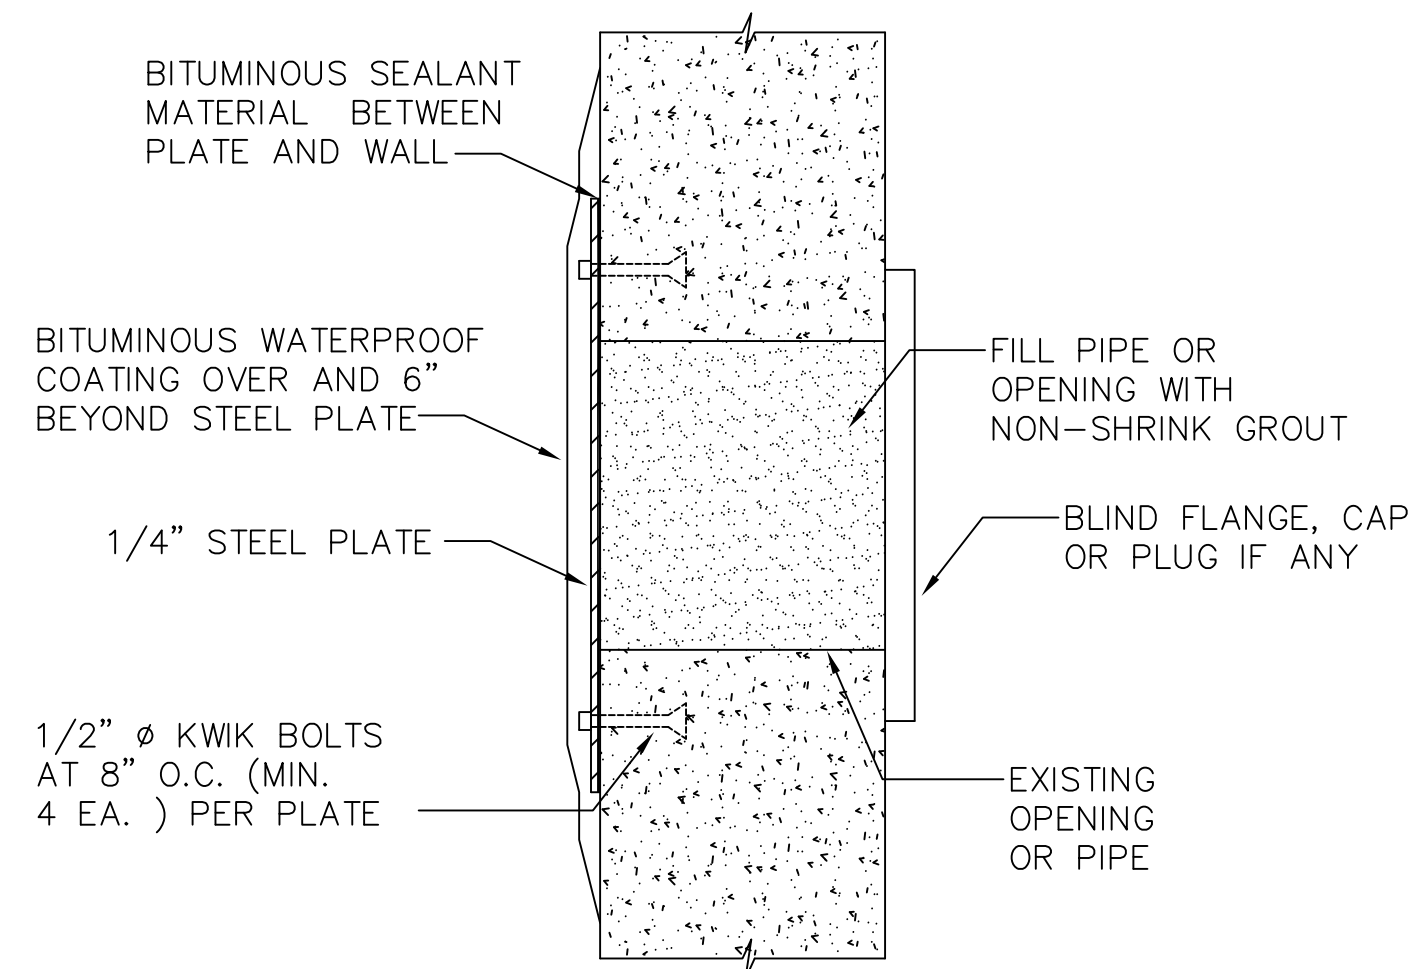

SEALING OF EXISTING OPENINGS
SCALE 1 1/2" = 1'-0"

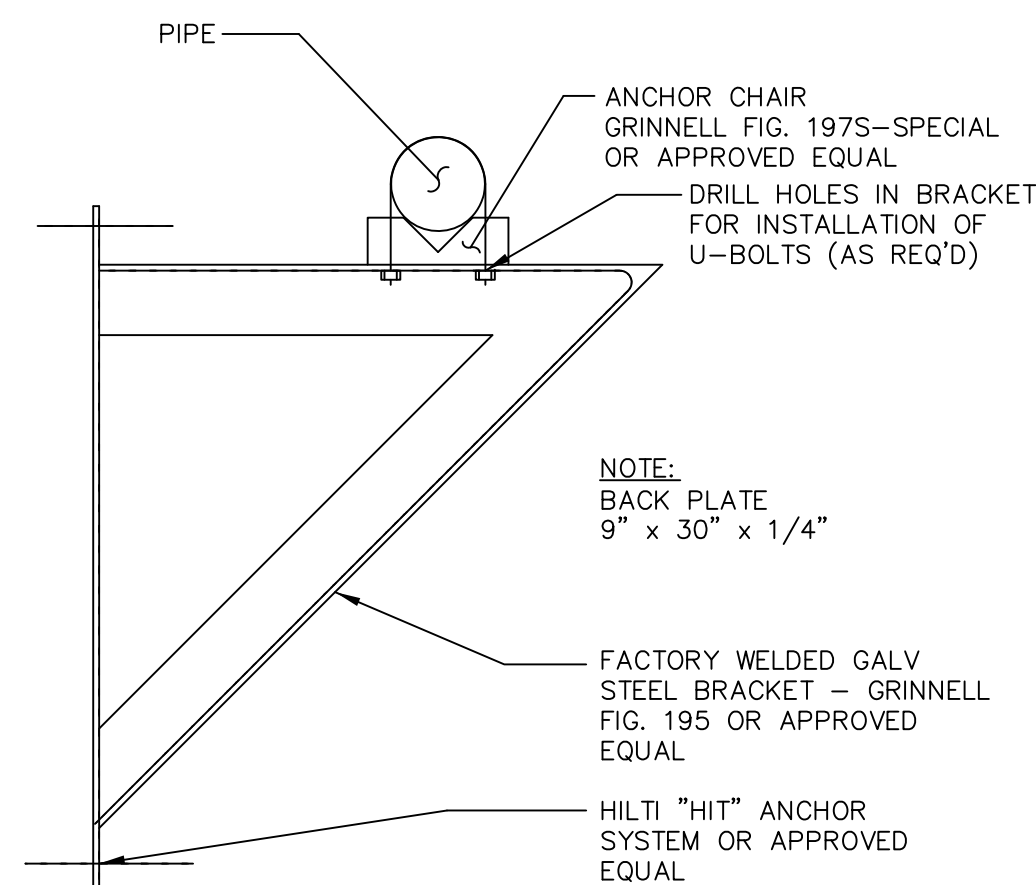


WALL BRACKET PIPE SUPPORT
NTS

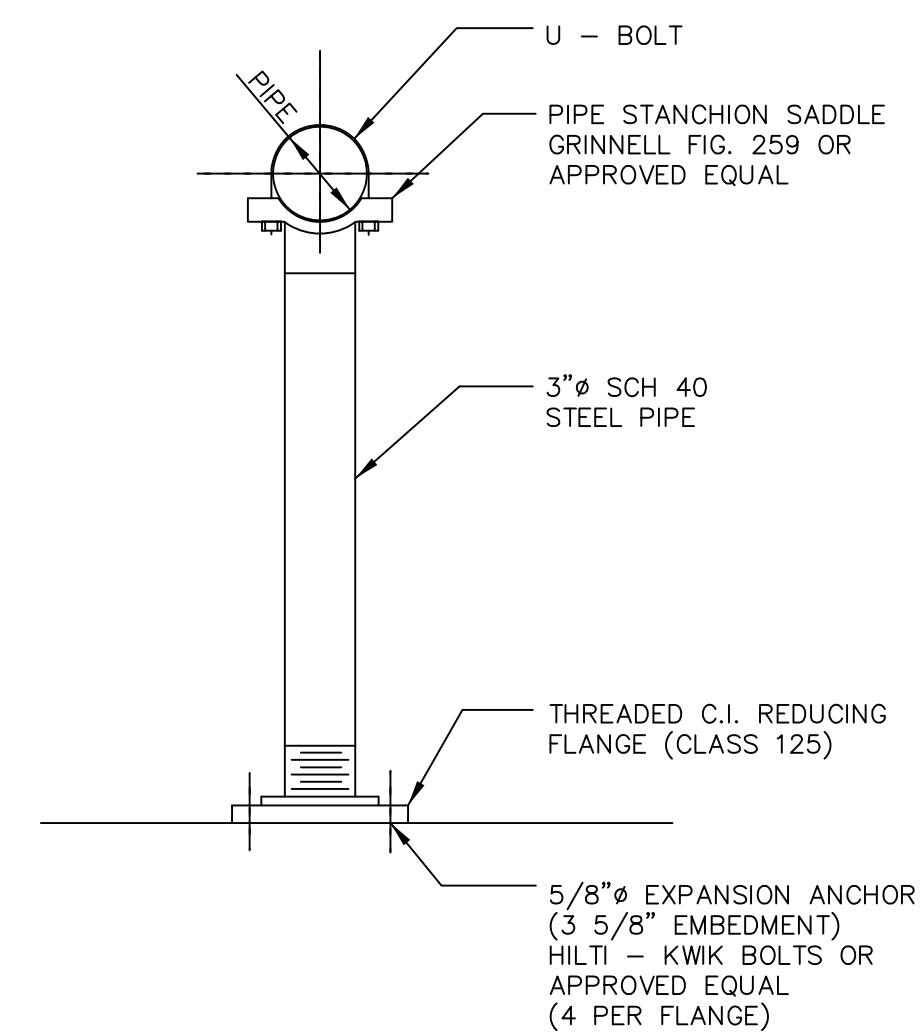


PIPE STANCHION SUPPORT
NTS

NOTE:
WHEN USED WITH PVC OR FIBERGLASS PIPE, PROVIDE STEEL SHEILD AROUND PIPE AT 'U' BOLT, WITH LOOSE FIT WRAP COPPER TUBES WITH 2" STRIP OF RUBBER FABRIC

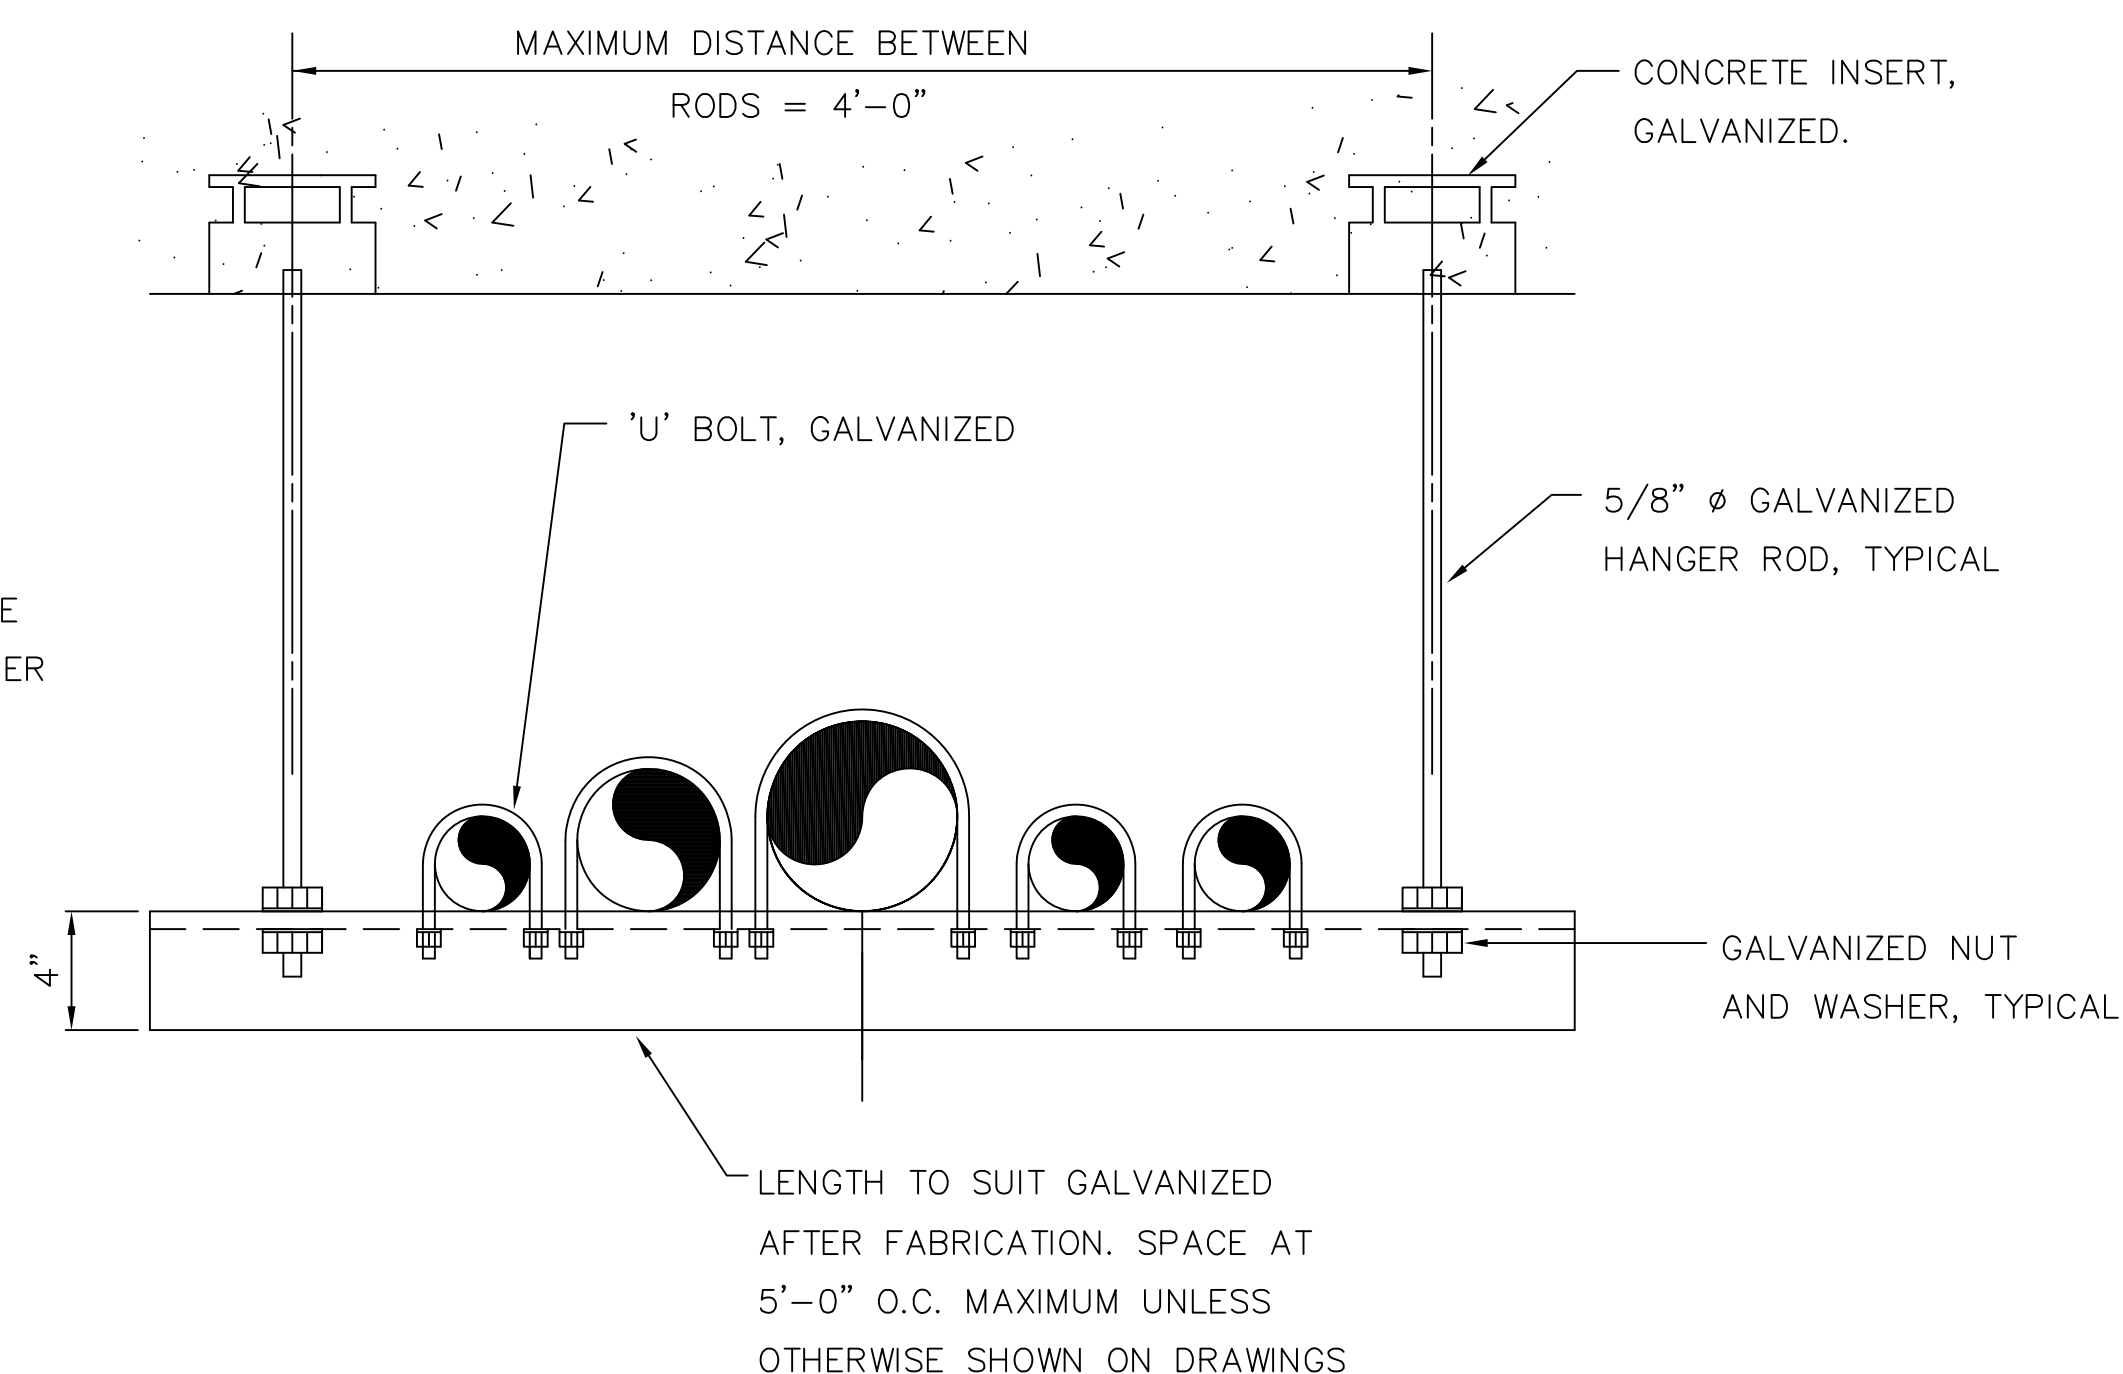

TRAPEZE PIPE HANGER
SCALE 1 1/2" = 1'-0"

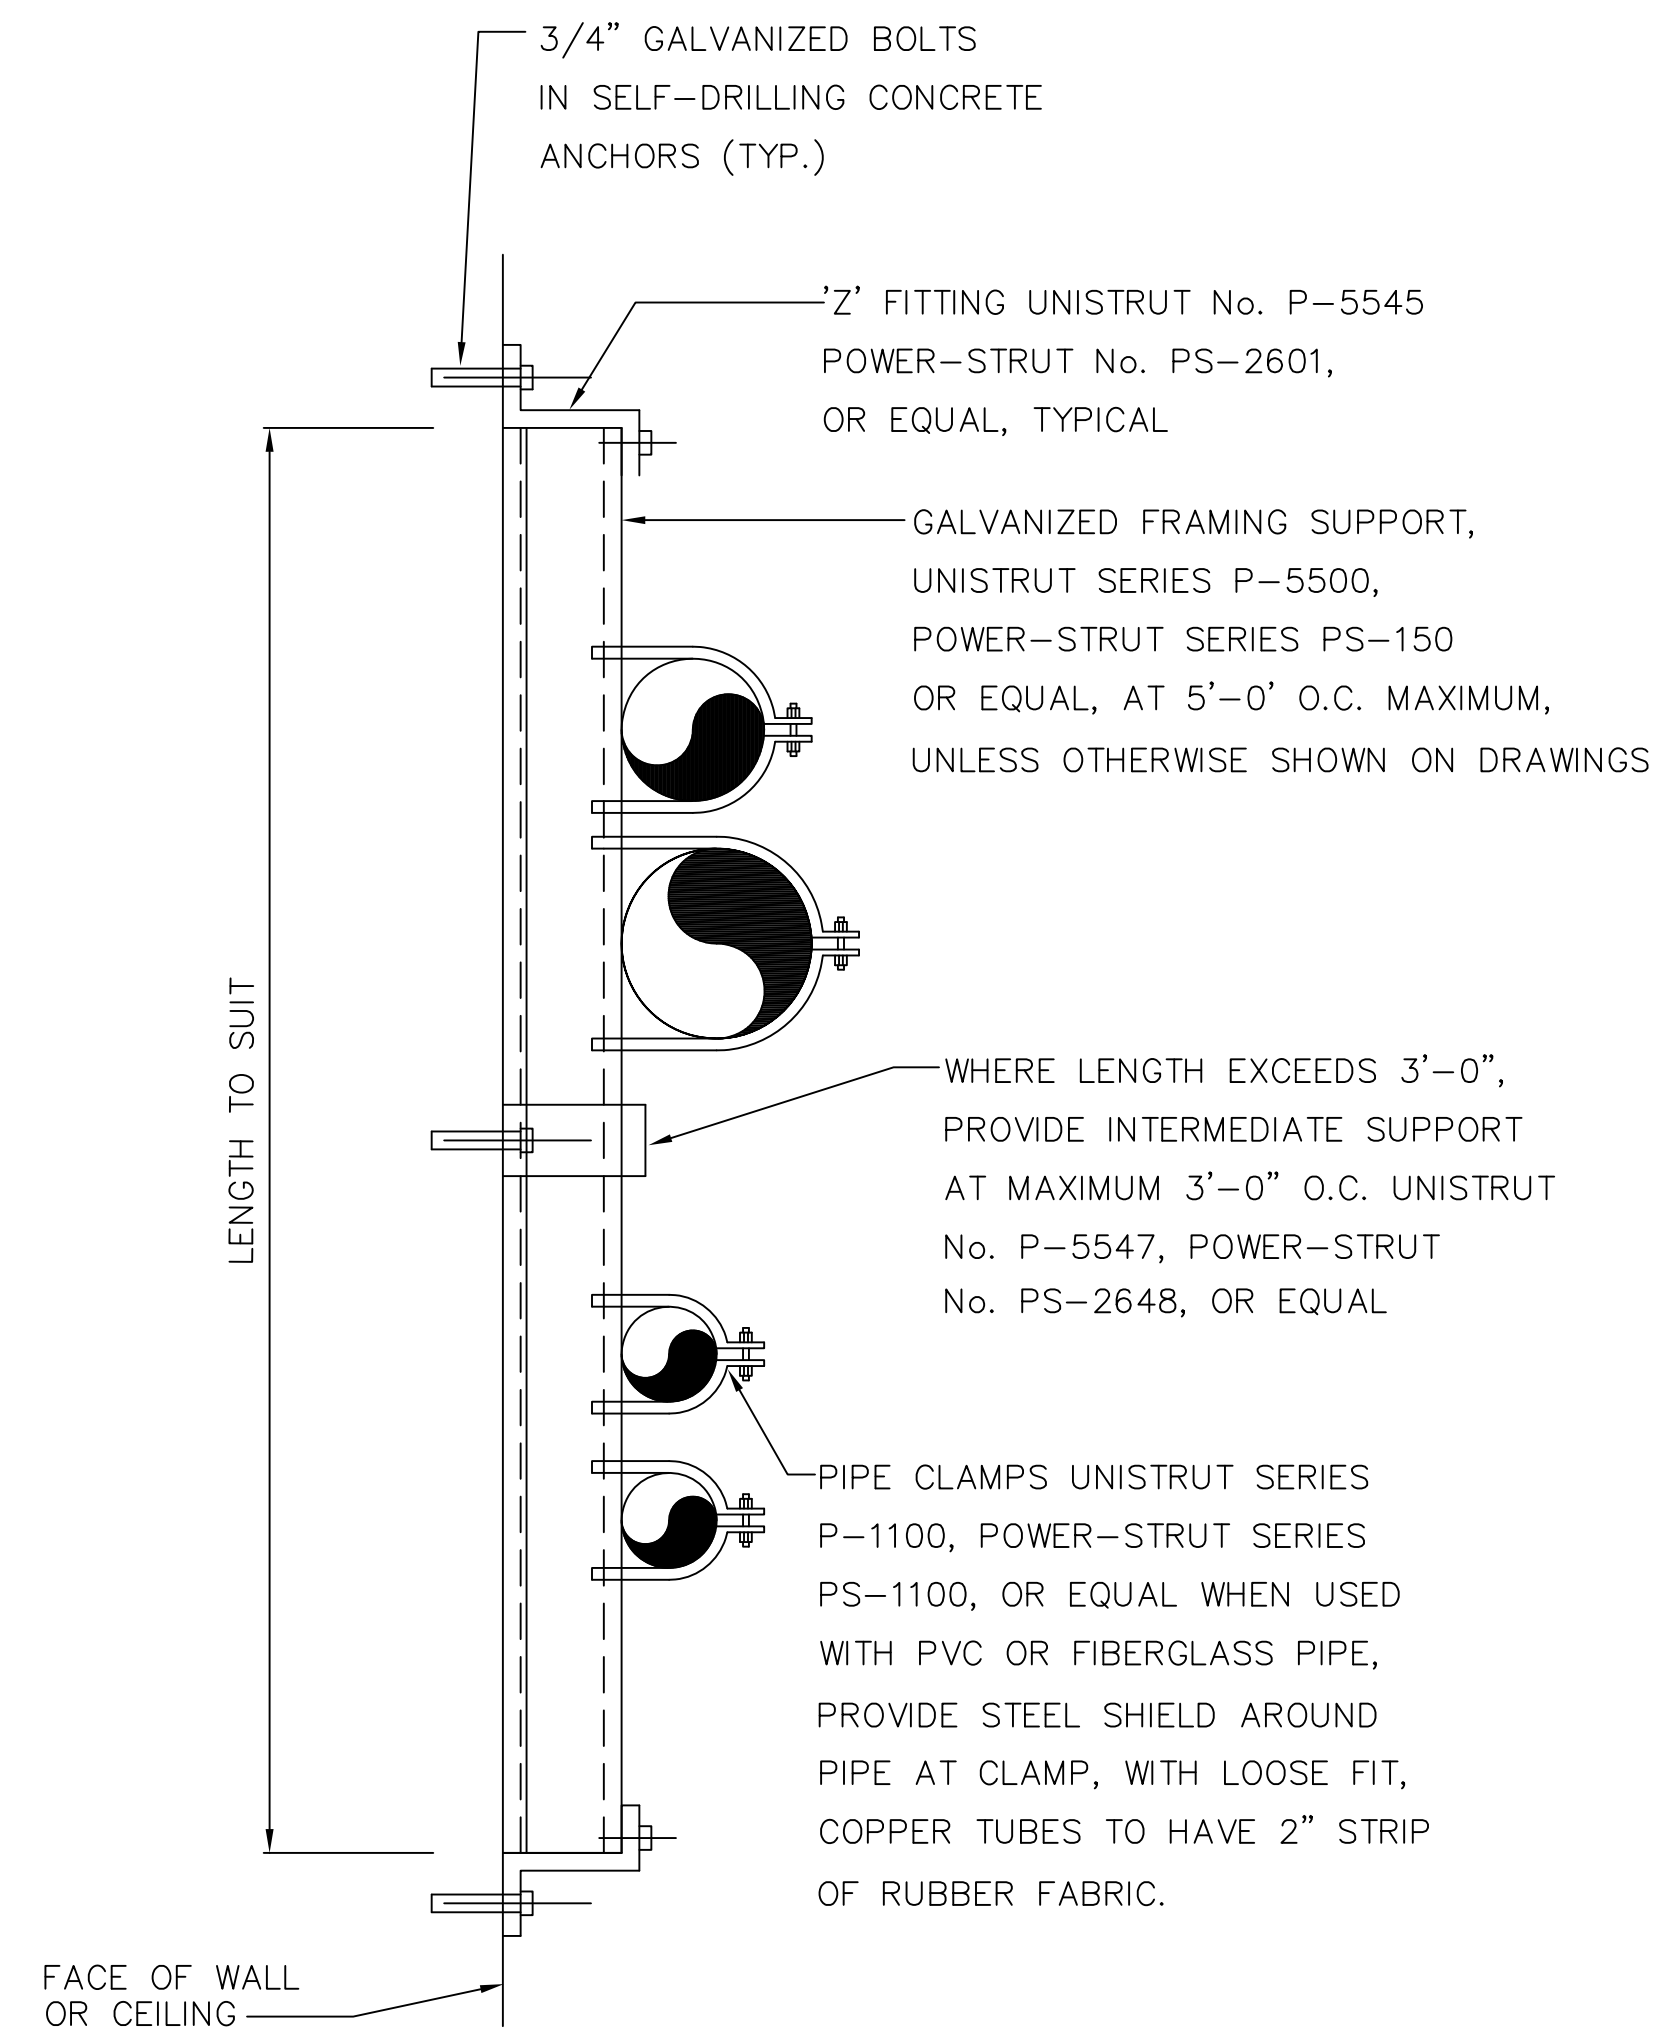

FLUSH MOUNTED PIPE SUPPORT
SCALE 1 1/2" = 1'-0"

THESE RECORD DOCUMENTS HAVE BEEN PREPARED BASED ON INFORMATION PROVIDED BY OTHERS. CTI ENVIRONMENTAL HAS REVIEWED THE INFORMATION SUBMITTED AND BELIEVES IT REFLECTS THE WORK AS CONSTRUCTED. HOWEVER, ALL PERSONS SHALL VERIFY INFORMATION TAKEN FROM THIS DRAWING.

THIS DRAWING IS AN INSTRUMENT OF SERVICE OWNED BY CTI ENVIRONMENTAL, INC. WHICH SHALL BE DEEMED THE AUTHOR AND WHICH SHALL RETAIN ALL STATUTORY AND COMMON LAW RIGHTS. THIS DRAWING SHALL NOT BE REPRODUCED, COPIED, OR ANY OTHER PURPOSE OR PROJECT WITHOUT PRIOR WRITTEN CONSENT OF CTI ENVIRONMENTAL, INC. THAT ELECTRONIC COPIES OF THIS DRAWING ARE EXACT DUPLICATES OF THE SEALED ORIGINAL DRAWING. ANY COPIES OF THIS DRAWING THAT ARE NOT THE SEALED ORIGINAL SHALL BE VOID AND SHALL GOVERN.

DESIGNED BY		REVISIONS		DATE		BY		APP'D	
AJP		DESCRIPTIONS		6/05		MGW		WAD	
DRAWN BY		RECORD DRAWING							
ELR									
CHECKED BY									
WAD									
APPROVED BY									
RWR									

ENVIRONMENTAL, INC.
ENGINEERS IN WATER AND EARTH SCIENCES
UNIONTOWN, OHIO



CITY OF MASSILLON, OHIO
WWTP UPGRADE 2000
PIPE SUPPORT DETAILS

JOB NO. E9031
DATE 08/13/01
SCALE AS NOTED
SHEET P140