


THIS DRAWING IS AN INSTRUMENT OF SERVICE OWNED BY CTE ENVIRONMENTAL, INC. WHICH SHALL BE DEEMED THE AUTHOR AND WHICH SHALL RETAIN ALL STATUTORY AND COMMON LAW RIGHTS, INCLUDING COPYRIGHTS. THIS DRAWING SHALL NOT BE SCANNED, COPIED, OR DISTRIBUTED IN ANY FORM OR USED FOR ANY OTHER PURPOSE OR PROJECT WITHOUT PRIOR WRITTEN CONSENT OF CTE ENVIRONMENTAL, INC. CTE ENVIRONMENTAL, INC. CANNOT GUARANTEE THAT ELECTRONIC COPIES OF THIS DRAWING ARE EXACT DUPLICATES OF THE SEALED ORIGINAL DRAWING. IN THE EVENT OF A DISCREPANCY BETWEEN AN ELECTRONIC COPY AND THE SEALED ORIGINAL, THE SEALED ORIGINAL SHALL GOVERN.

NOT TO SCALE
* SEE SCHEDULE
ON SHEET P141

NOTE: DIMENSIONS APPLY TO
DS-2A THRU DS-8A ALSO.

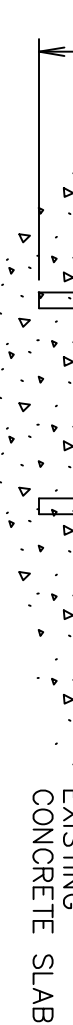

NOT TO SCALE



NOT TO SCALE
* SEE SCHEDULE
ON SHEET P141

THESE RECORD DOCUMENTS HAVE BEEN PREPARED BASED ON INFORMATION PROVIDED BY OTHERS. CTH ENVIRONMENTAL HAS REVIEWED THE INFORMATION SUBMITTED AND BELIEVES IT REFLECTS THE WORK AS CONSTRUCTED. HOWEVER, ALL PERSONS SHALL VERIFY INFORMATION TAKEN FROM THIS DRAWING.

DESIGNED BY WAD	REVISIONS				
	NO.	DESCRIPTIONS	DATE	BY	APP'D
DRAWN BY TGL	1	RECORD DRAWING	6/05	MGW	WAD
CHECKED BY WAD					
APPROVED BY WAD					

JOB NO.	E9031
DATE	08/13/01
SCALE	AS NOTED
SHEET	P142

CITY OF MASSILLON, OHIO
WWTP UPGRADE 2000
ODOR CONTROL – MISC. DETAILS