




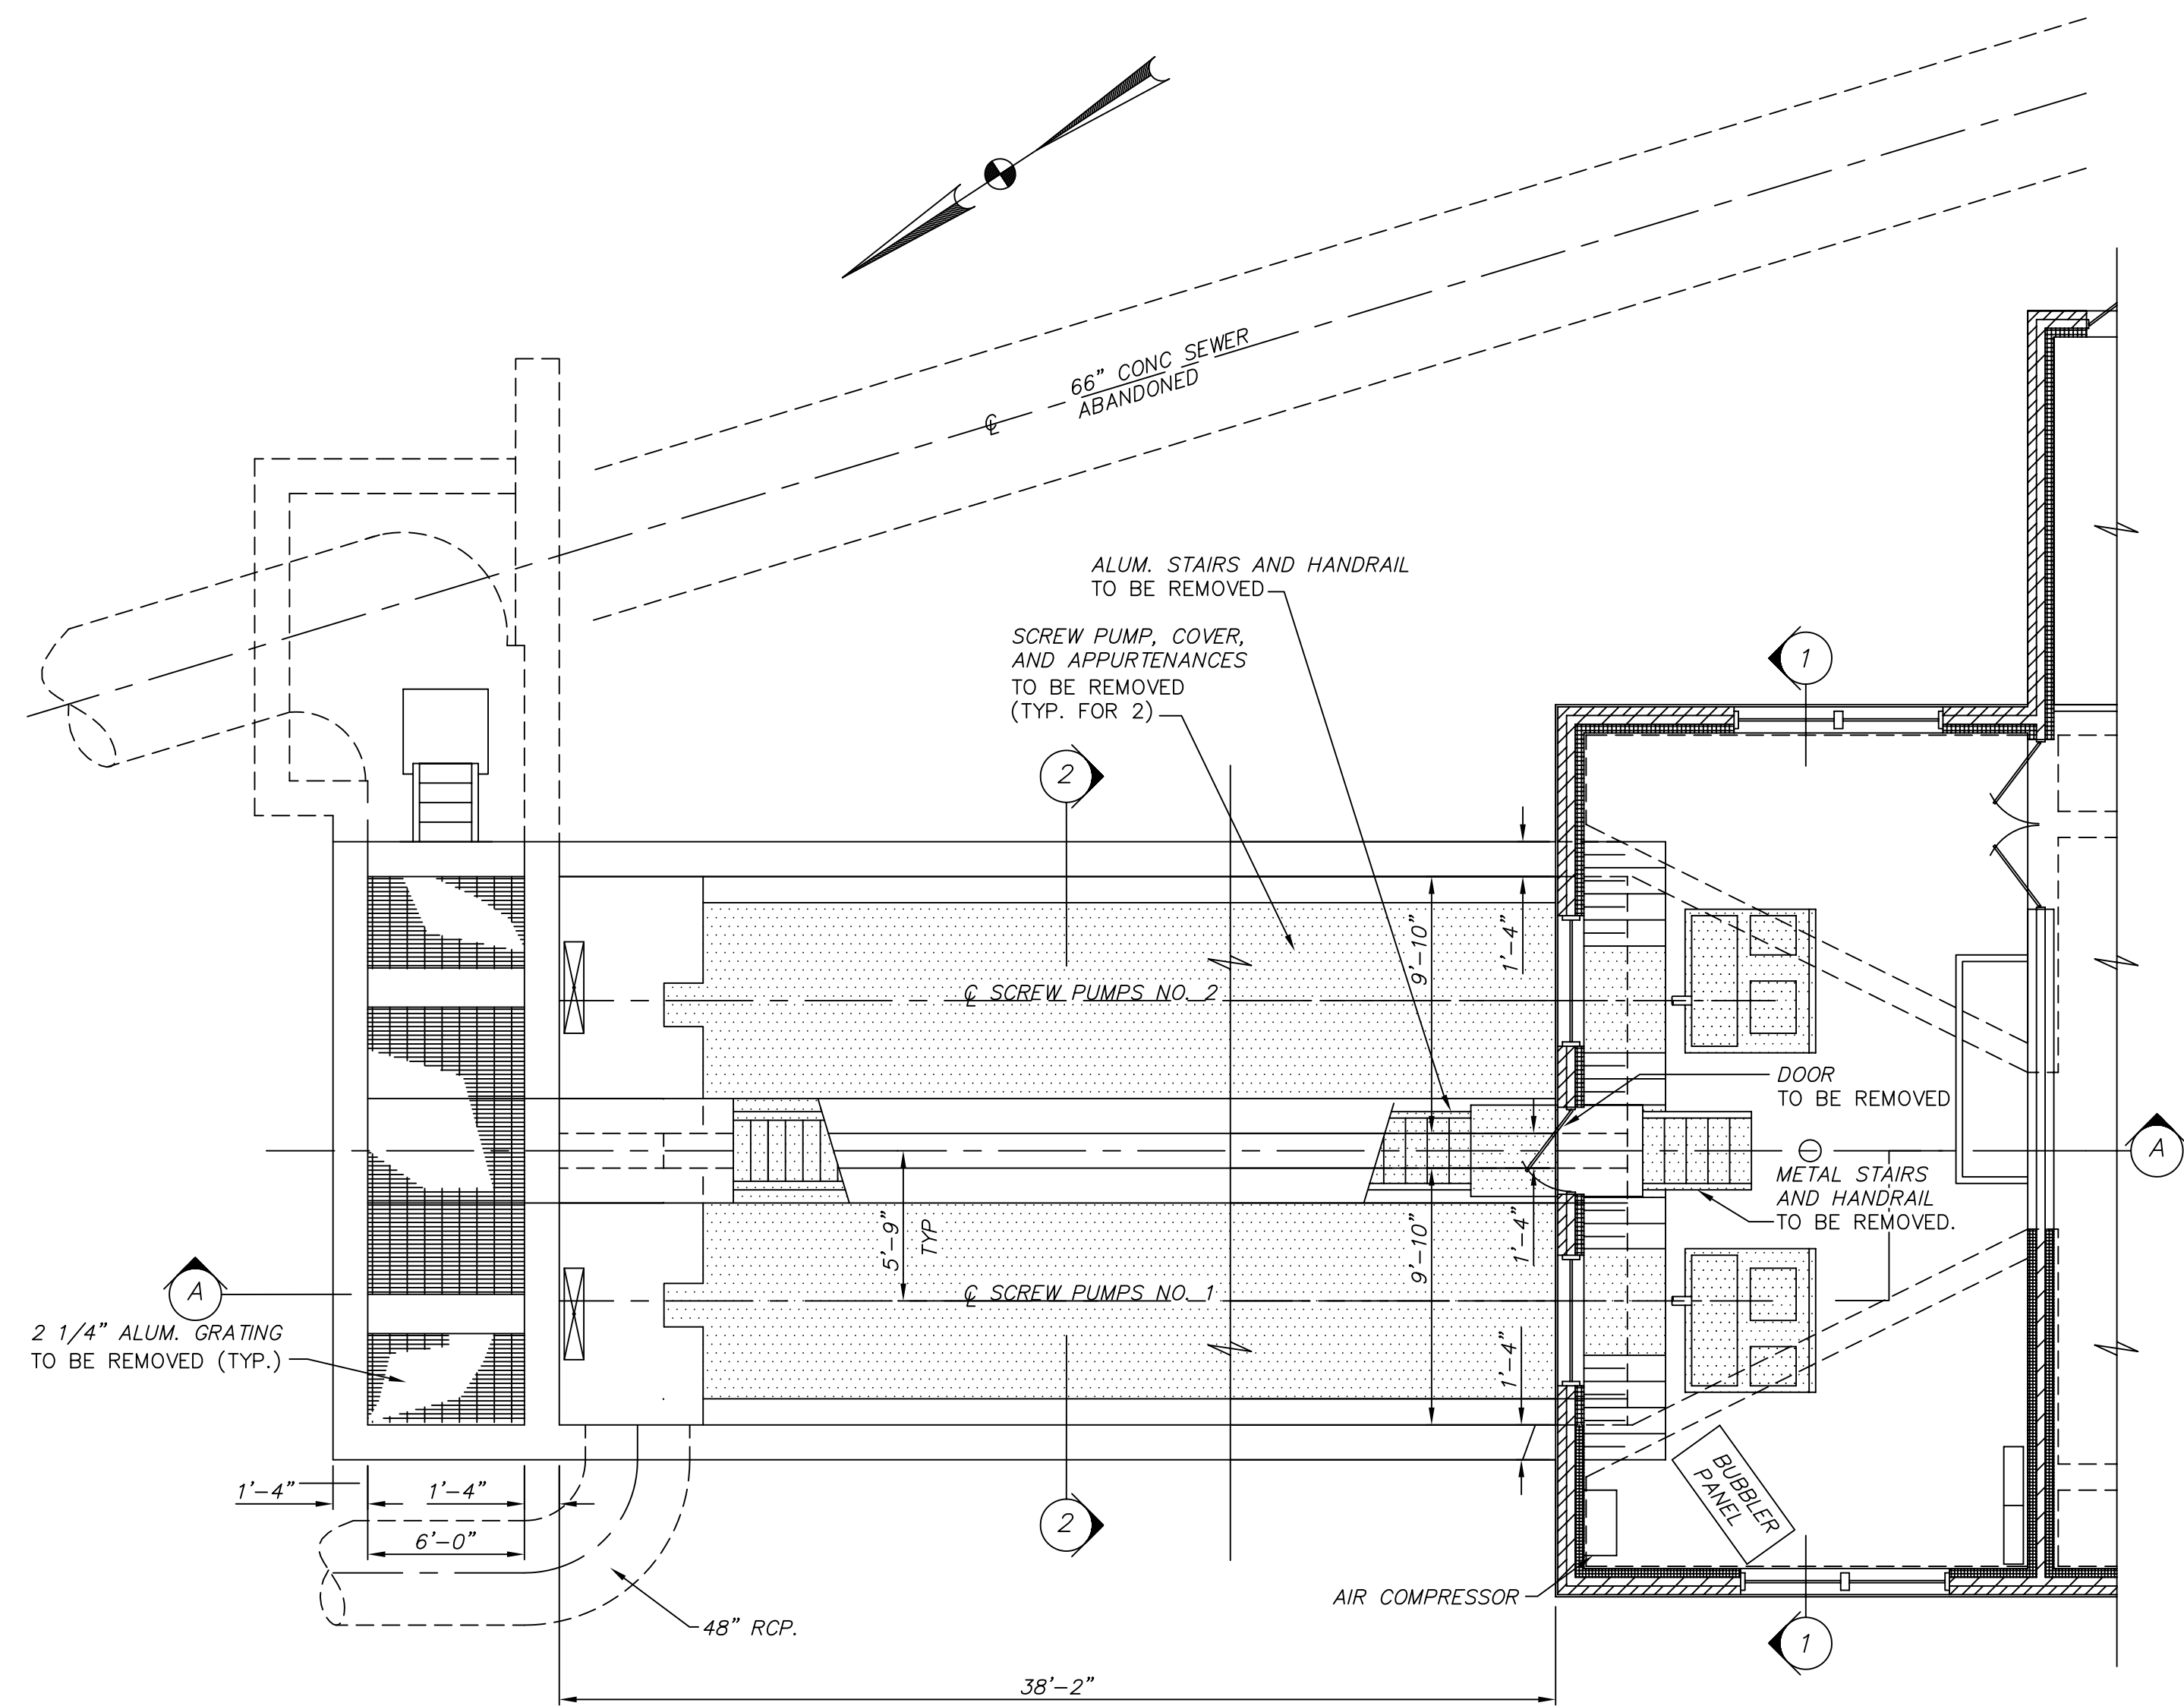

PLAN  
SCALE: 3/16" = 1'-0"

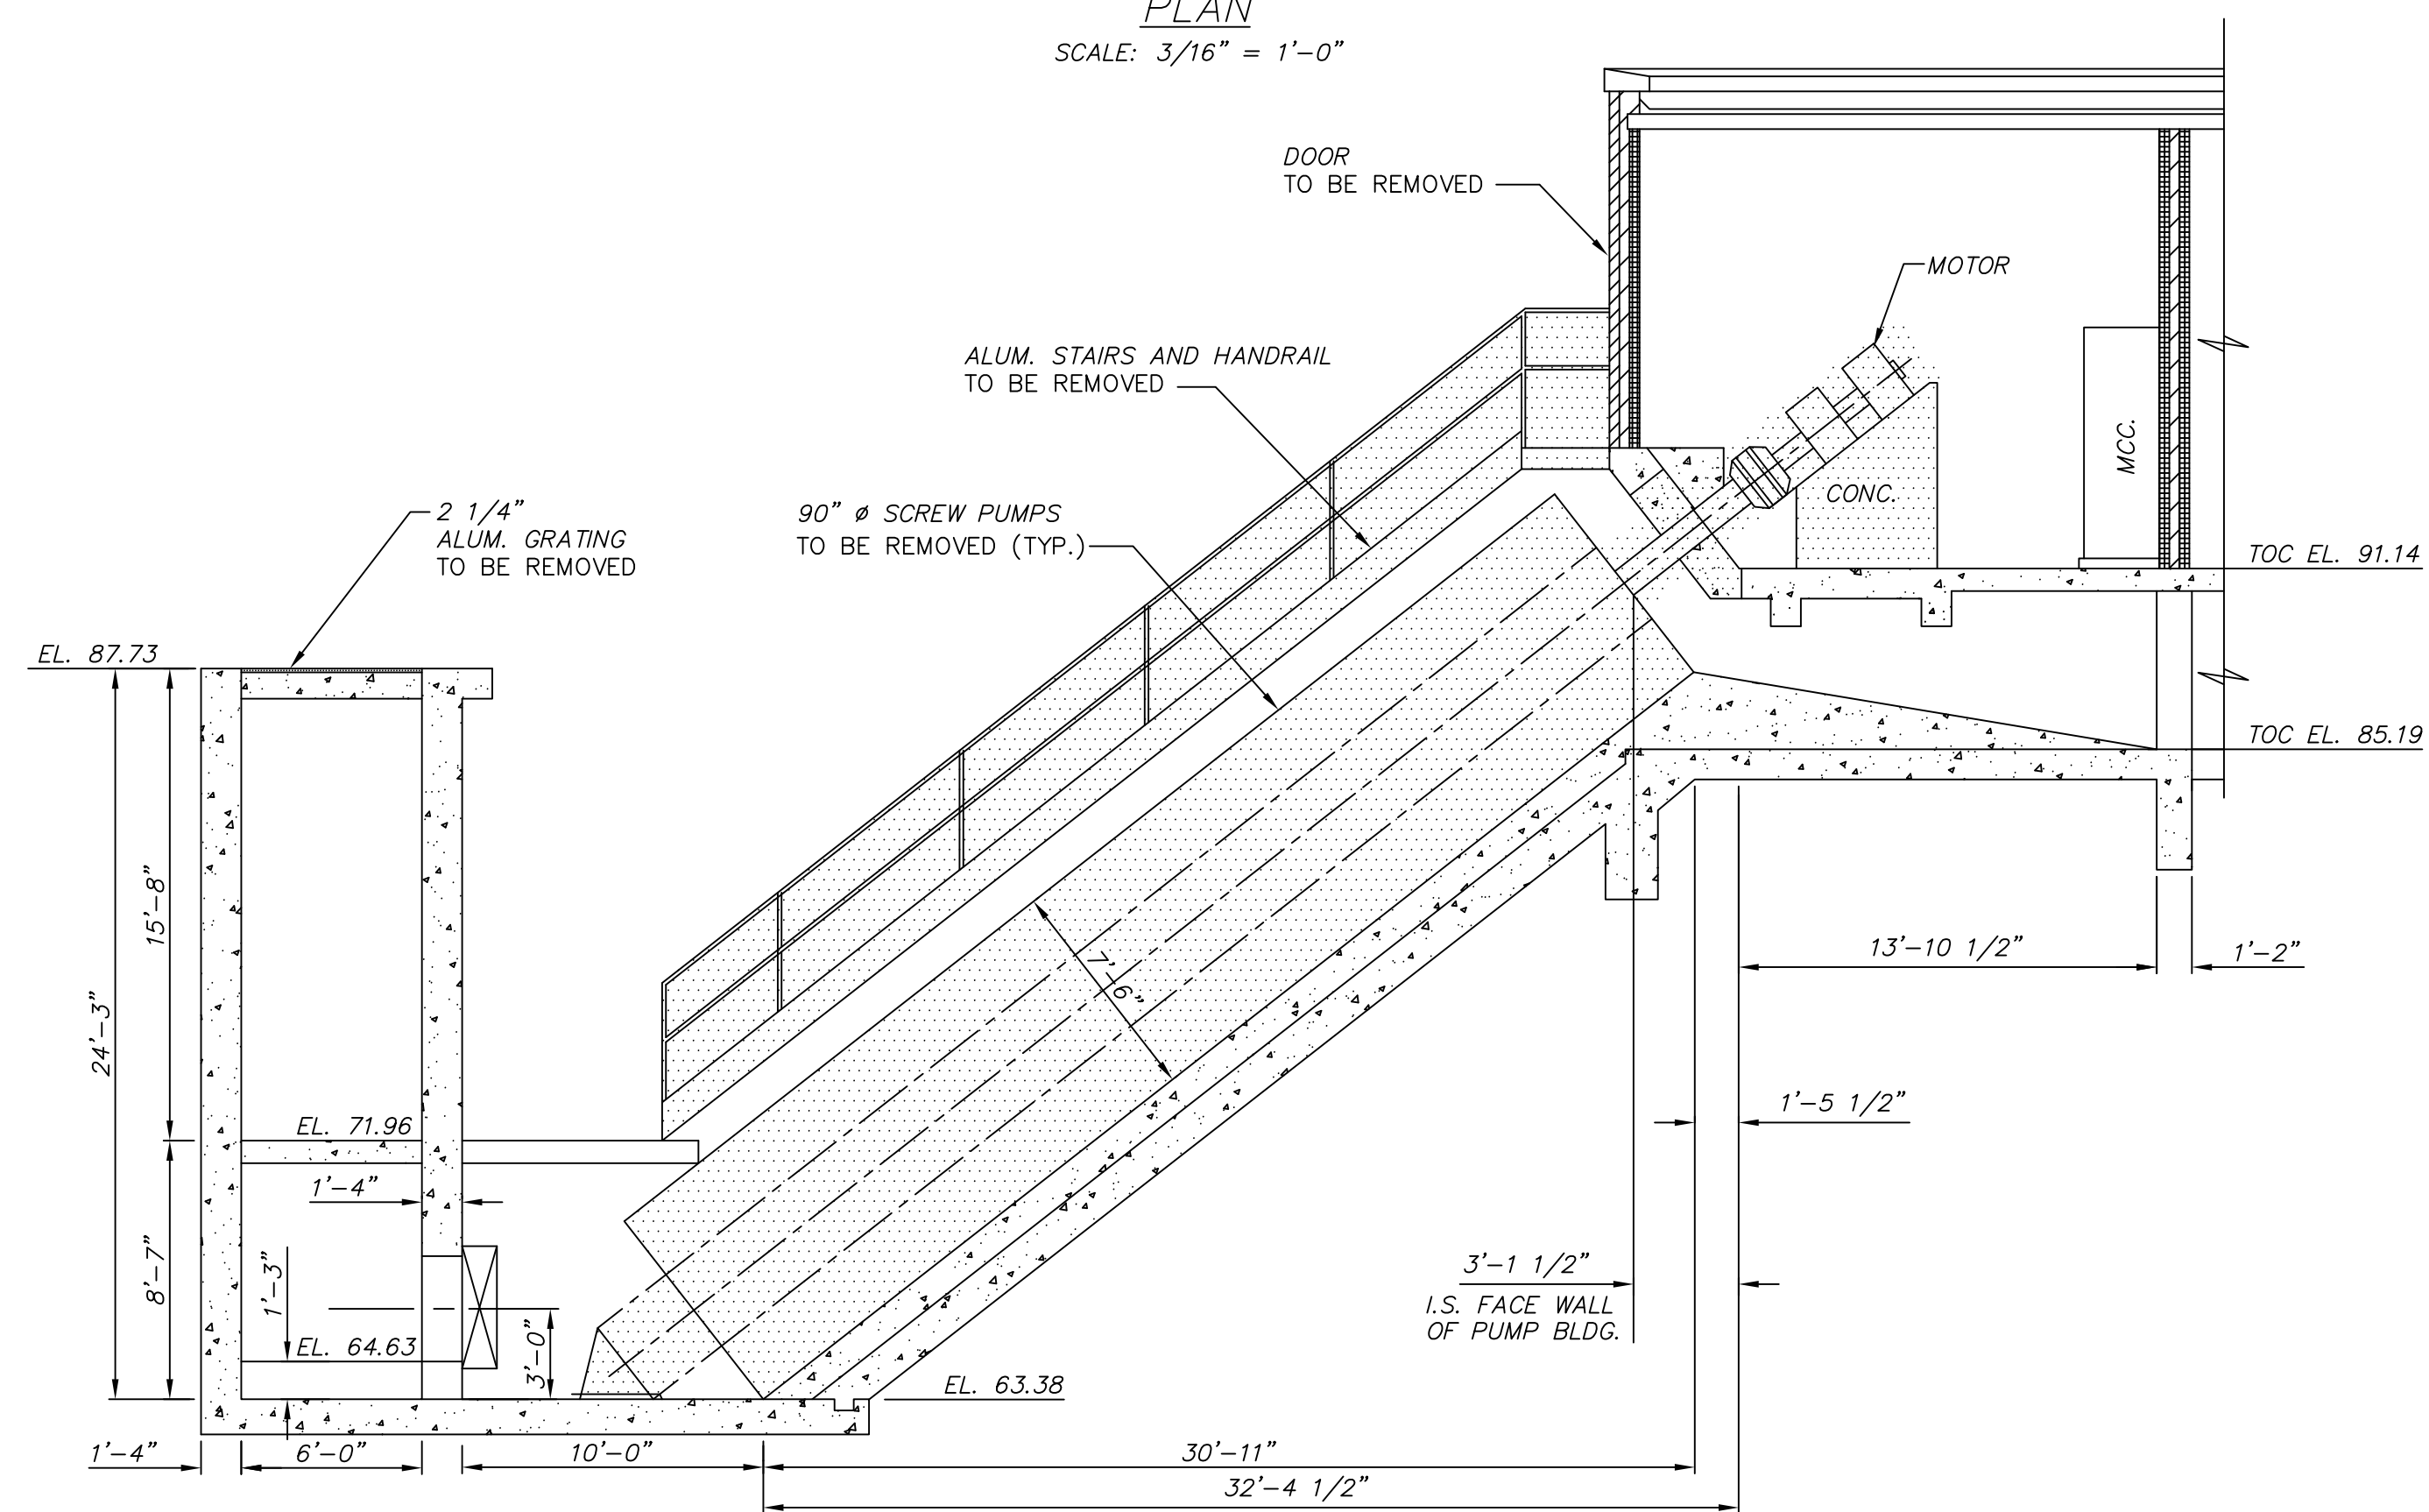


SECTION A  
SCALE 3/16" = 1'-0"

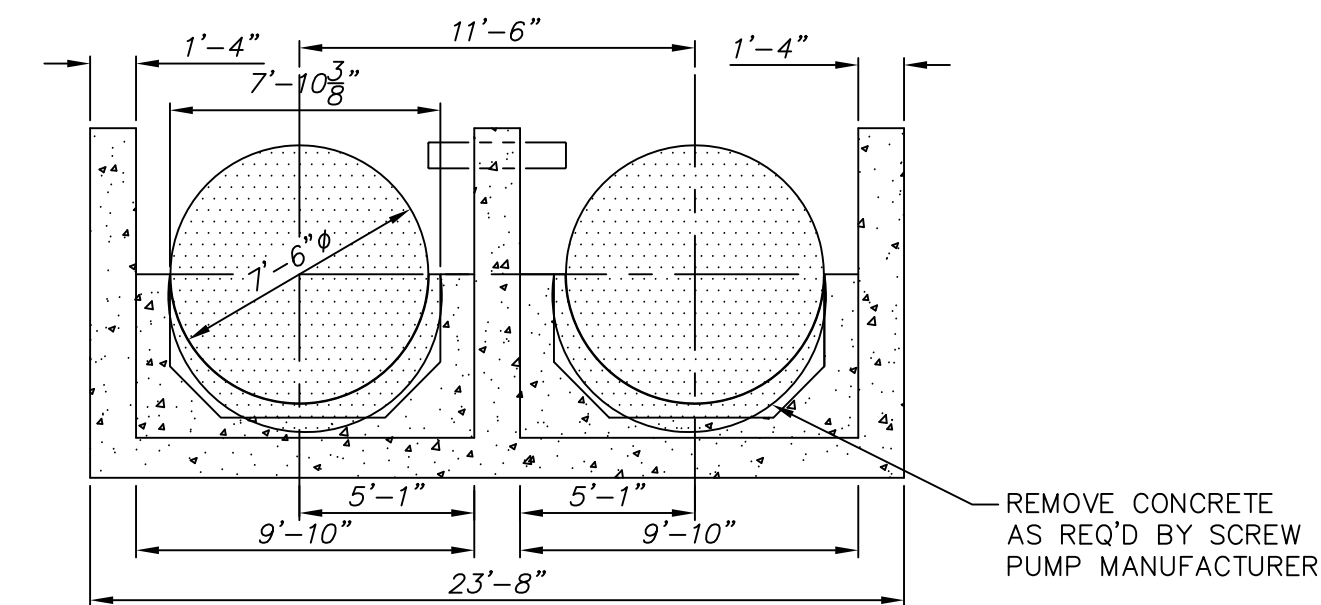

SECTION 2  
SCALE : 3/16" = 1'-0"


NOTE:  
1. ITEMS FOR DEMOLITION

NOTE :  
1. SEQUENCE OF CONSTRUCTION (DEMOLITION)  
SHALL BE IN ACCORDANCE WITH SECTION 01010,  
SUMMARY OF WORK. ONE PUMP MUST REMAIN  
IN CONTINUOUS OPERATION AT ALL TIMES.

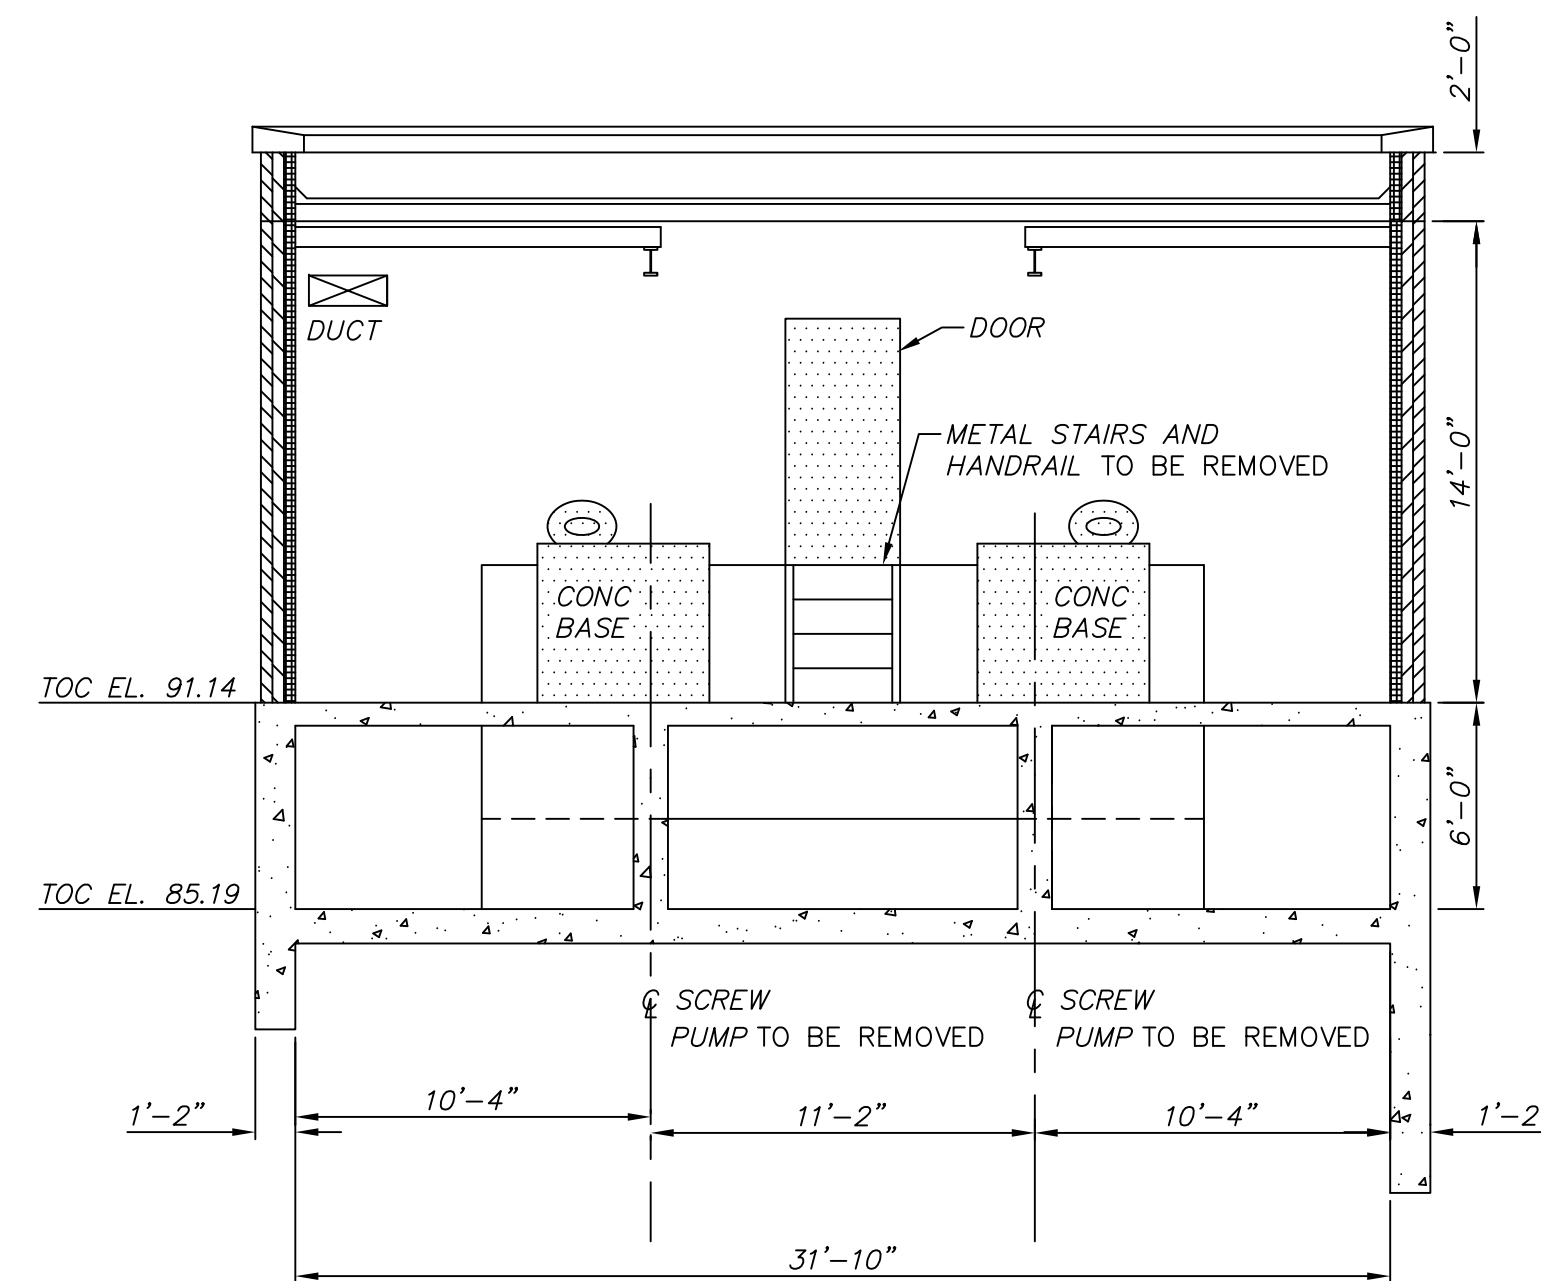

SECTION 1  
SCALE : 3/16" = 1'-0"

THESE RECORD DOCUMENTS HAVE BEEN PREPARED  
BASED ON INFORMATION PROVIDED BY OTHERS. CTI  
ENVIRONMENTAL HAS REVIEWED THE INFORMATION  
SUBMITTED AND BELIEVES IT REFLECTS THE WORK AS  
CONSTRUCTED. HOWEVER, ALL PERSONS SHALL  
VERIFY INFORMATION TAKEN FROM THIS DRAWING.

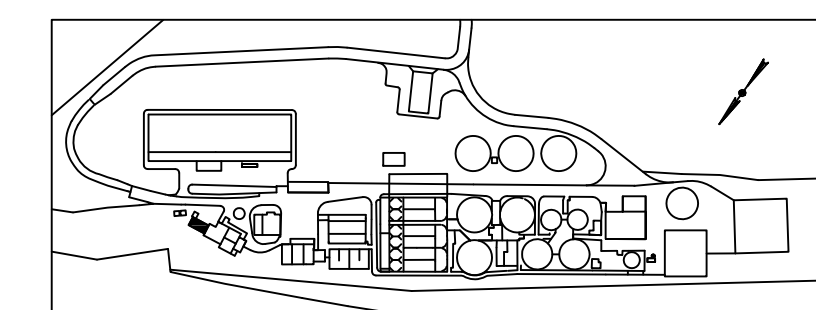

KEY PLAN

THIS DRAWING IS AN INSTRUMENT OF SERVICE OWNED  
BY CTI ENVIRONMENTAL, INC. WHICH SHALL BE LOANED  
TO THE CLIENT AND NOT BE REPRODUCED, COPIED, OR  
THIS DRAWING SHALL NOT BE REPRODUCED, COPIED, OR  
ANY OTHER PURPOSE OR PROJECT WITHOUT PRIOR  
WRITTEN CONSENT OF CTI ENVIRONMENTAL, INC.  
ELECTRONIC COPIES OF THIS DRAWING ARE EXACT  
REPRODUCTIONS OF THE ORIGINAL DRAWING.  
IN THE EVENT OF A CONFLICT BETWEEN AN ELECTRONIC  
COPY AND THE SEALED ORIGINAL, THE SEALED ORIGINAL  
SHALL GOVERN.

| DESIGNED BY | NO. | REVISIONS      | DATE | BY  | APP'D |
|-------------|-----|----------------|------|-----|-------|
| RNF         | 1   | RECORD DRAWING | 4/05 | MGW | WAD   |
| DRAWN BY    |     |                |      |     |       |
| CHECKED BY  |     |                |      |     |       |
| APPROVED BY |     |                |      |     |       |
| SAT         |     |                |      |     |       |
| MGW         |     |                |      |     |       |
| WAD         |     |                |      |     |       |

ENVIRONMENTAL, INC.  
ENGINEERS IN WATER AND EARTH SCIENCES  
UNIONTOWN, OHIO

CITY OF MASSILLON, OHIO  
WWTP UPGRADE 2000  
INFLUENT SCREW PUMP DEMOLITION

|                   |
|-------------------|
| JOB NO.<br>E9031  |
| DATE<br>08/13/01  |
| SCALE<br>AS NOTED |
| SHEET<br>P16      |