




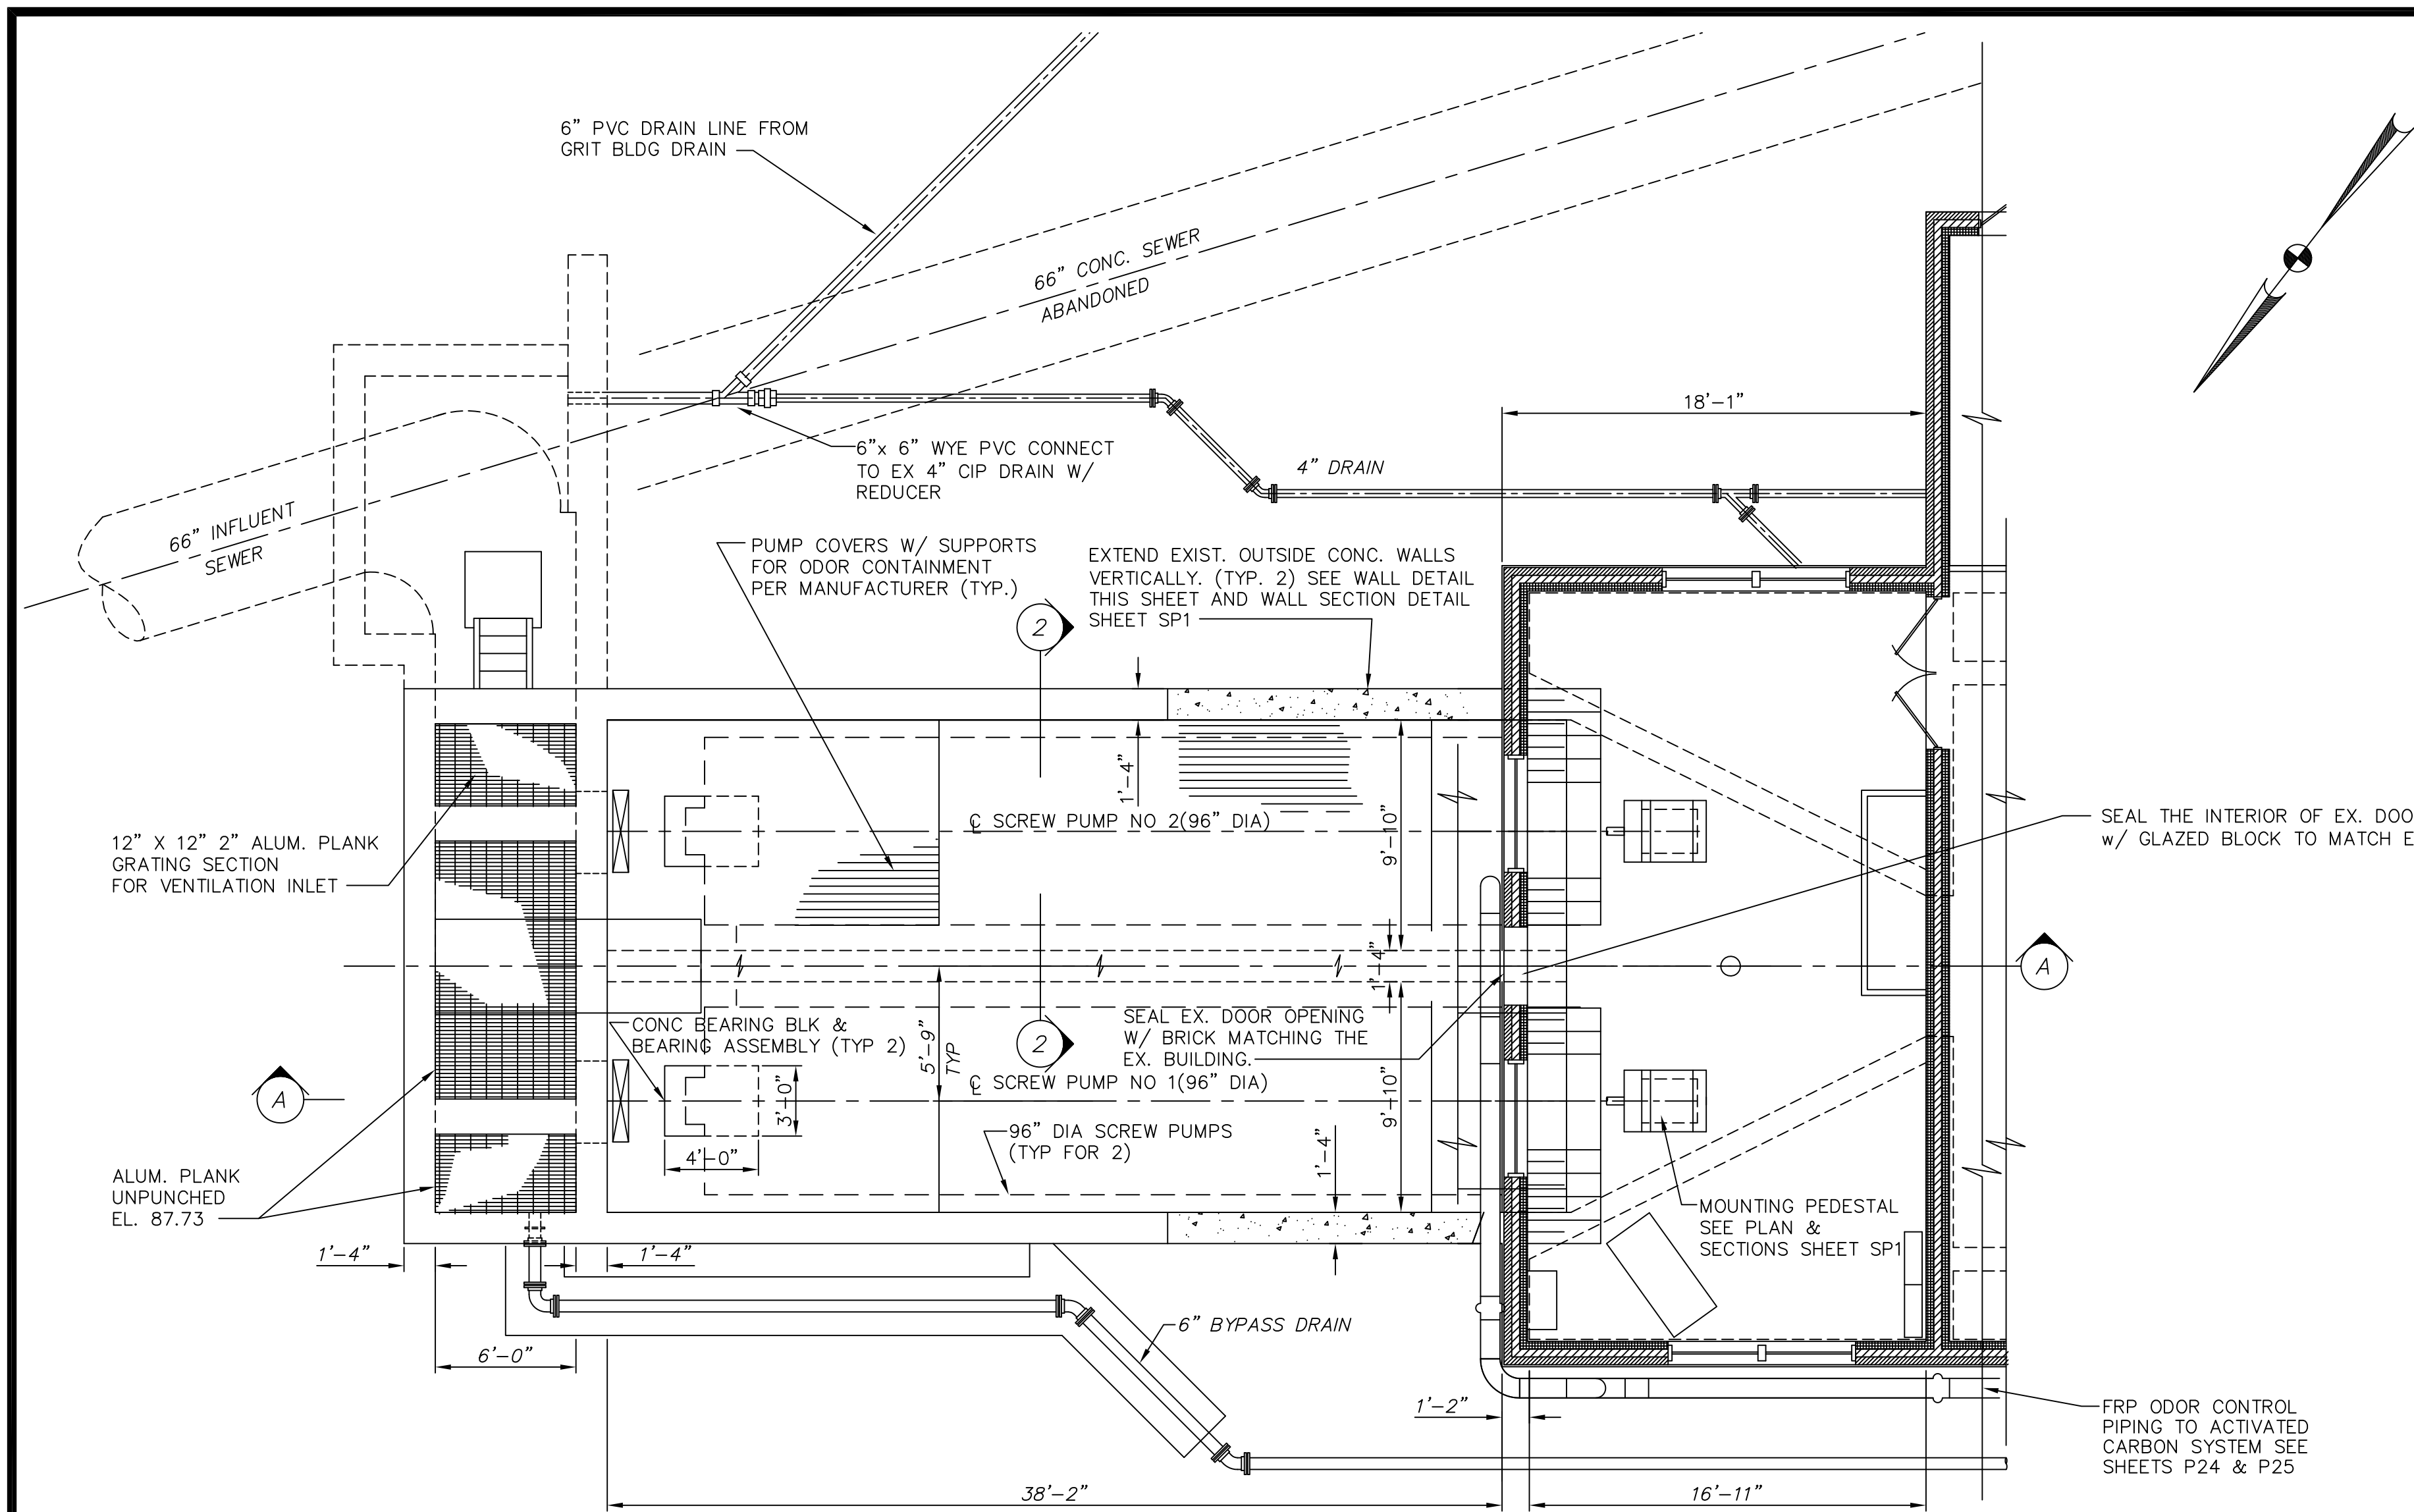

PLAN
SCALE: 3/16" = 1'-0"

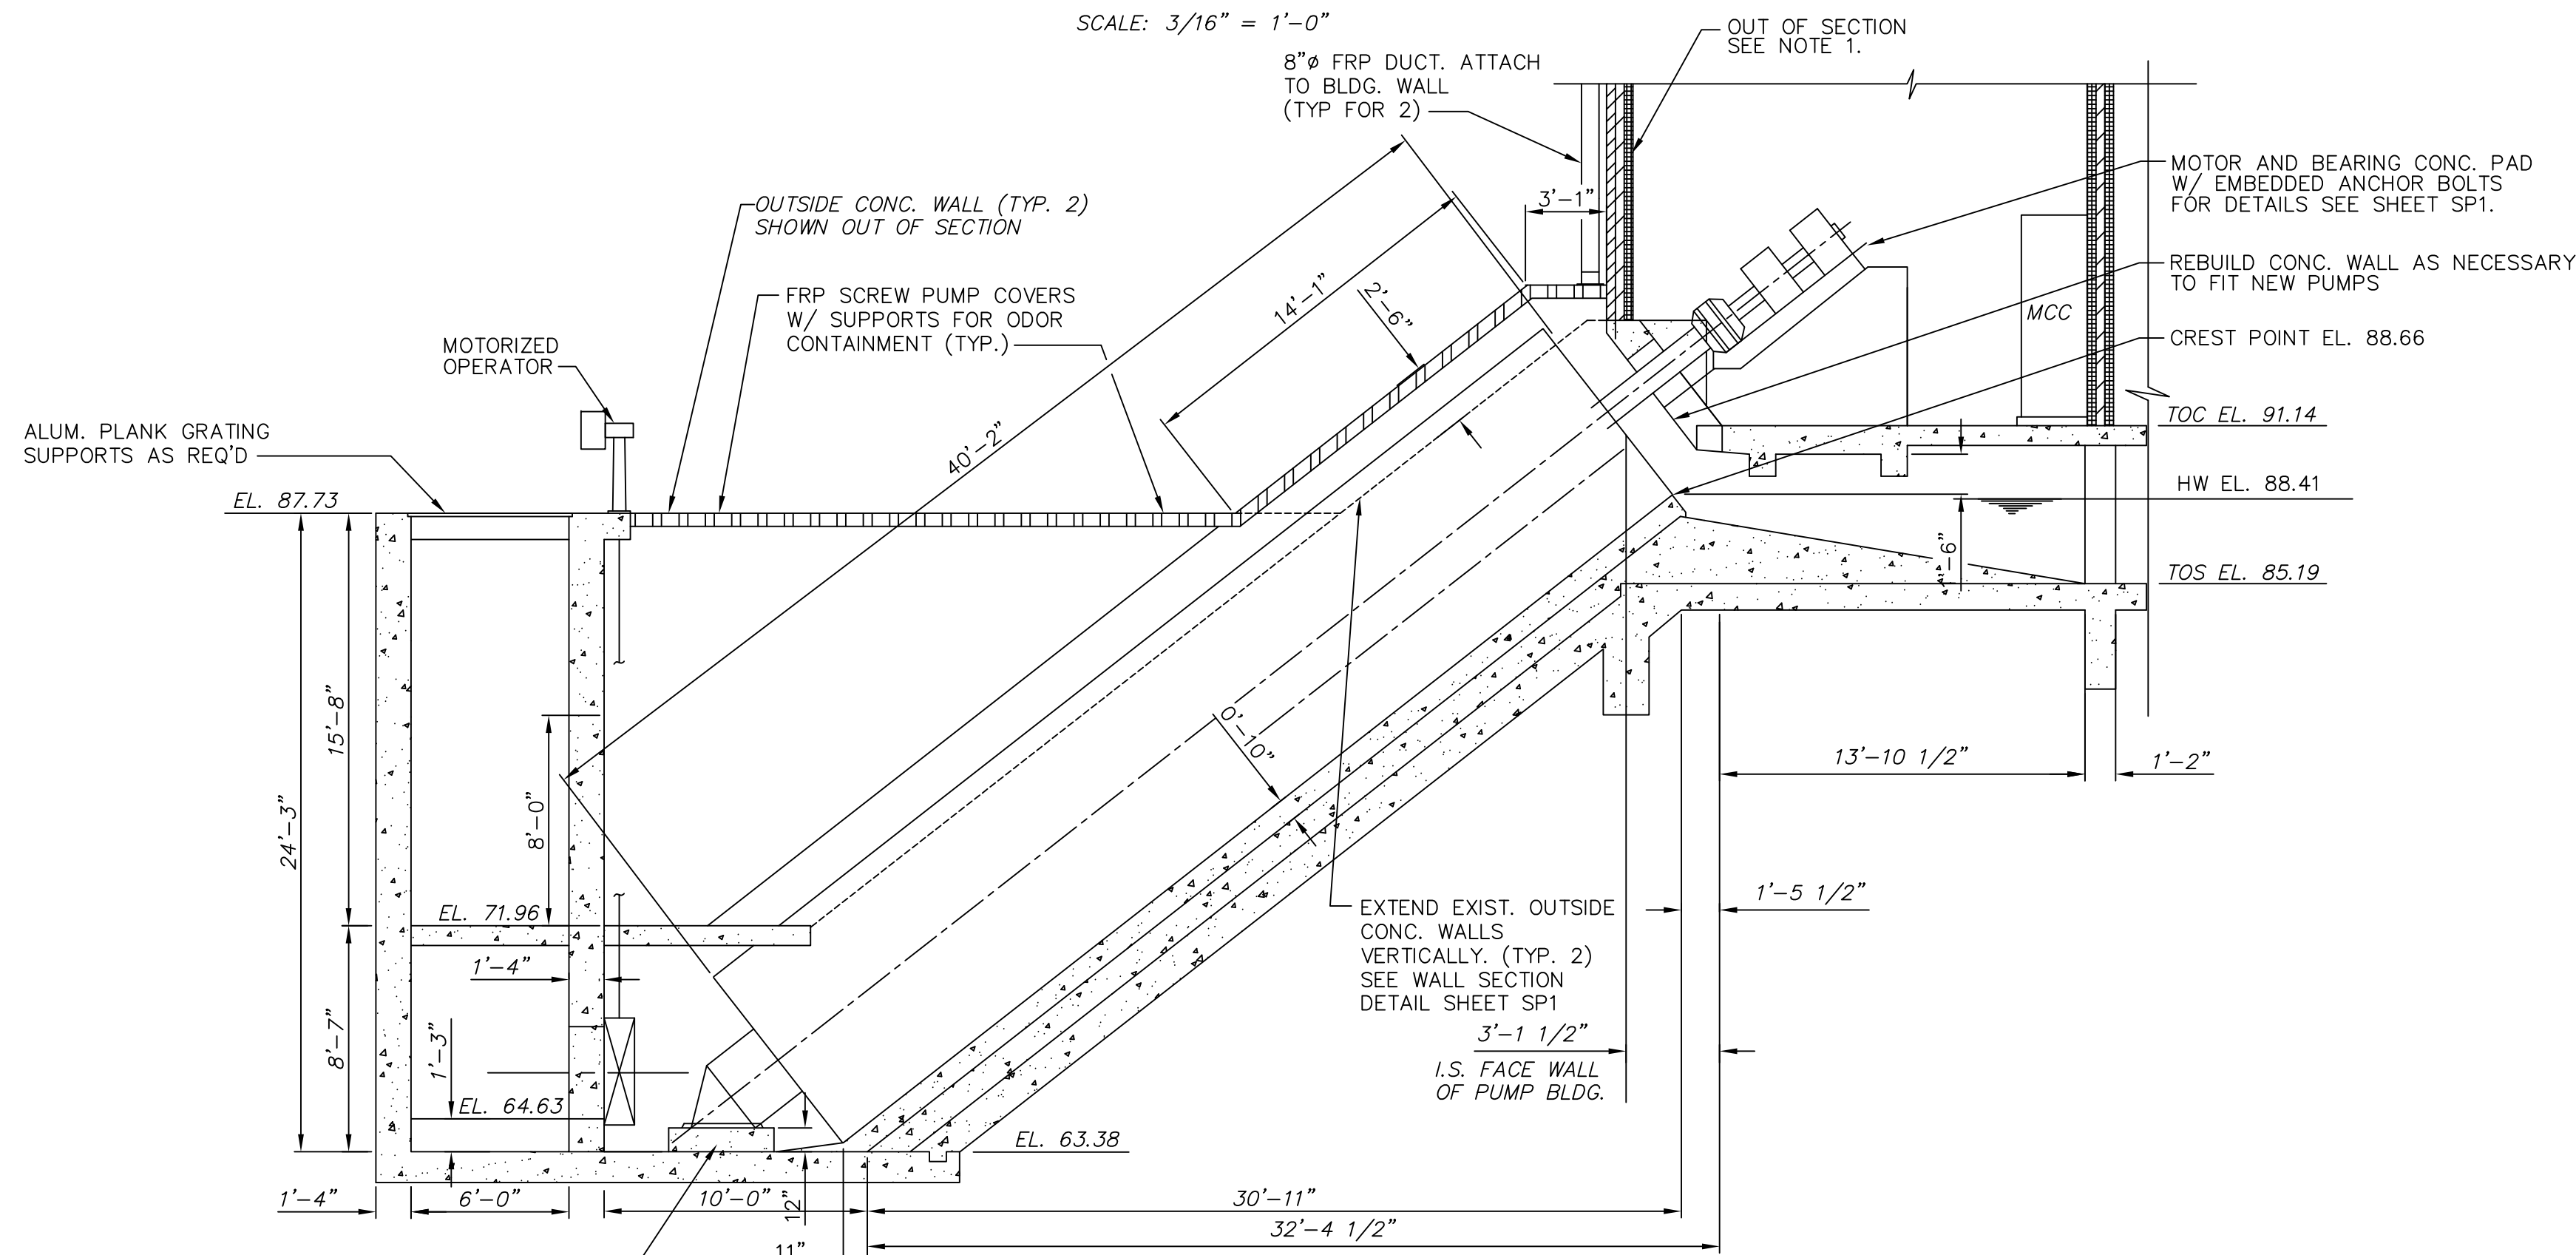


SECTION
SCALE 3/16" = 1'-0" A

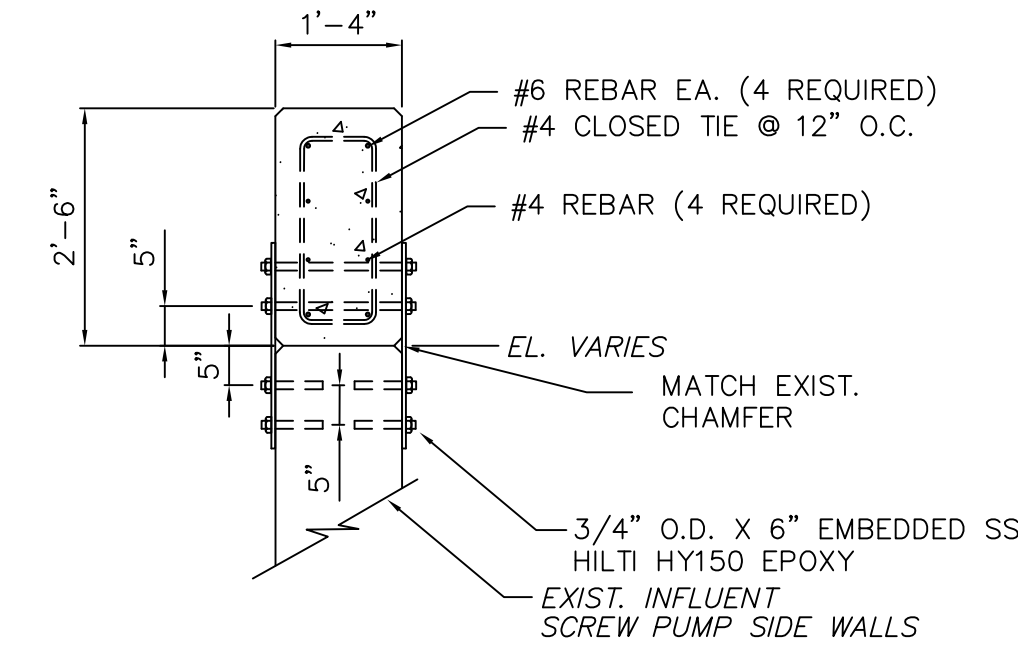

WALL SECTION
SCALE: 1/2" = 1'-0"

NOTES:

1. SEAL EXIST. DOOR OPENING WITH BRICK MATCHING THE EXIST. BUILDING
2. ALLOW FOR ODOR CONTROL COVERS TO MOUNT BETWEEN WALLS PER MANUFACTURER'S RECOMMENDATION
3. SEE SHEET SP1 FOR STRUCTURAL DETAILS

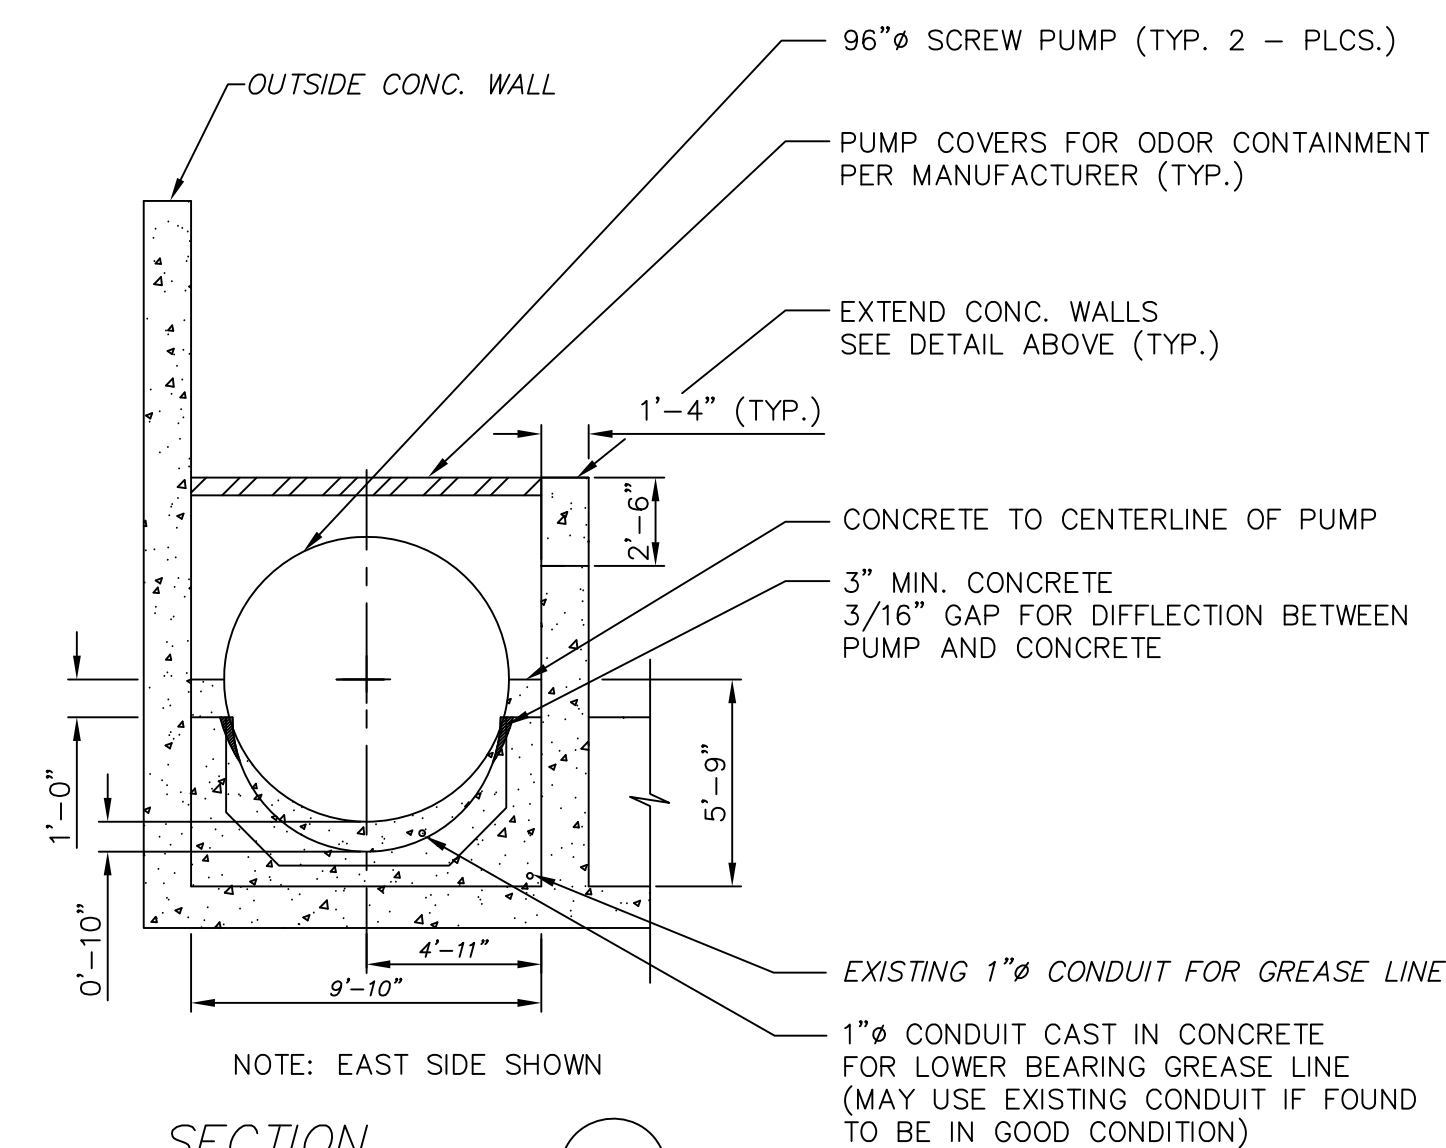

SECTION
SCALE 3/16" = 1'-0" 2

THESE RECORD DOCUMENTS HAVE BEEN PREPARED
BASED ON INFORMATION PROVIDED BY OTHERS. CTI
ENVIRONMENTAL HAS REVIEWED THE INFORMATION
SUBMITTED AND BELIEVES IT REFLECTS THE WORK AS
CONSTRUCTED. HOWEVER, ALL PERSONS SHALL
VERIFY INFORMATION TAKEN FROM THIS DRAWING.

THIS DRAWING IS AN INSTRUMENT OF SERVICE OWNED
BY CTI ENVIRONMENTAL, INC. WHICH SHALL BE DEEMED
TO BE THE PROPERTY OF CTI ENVIRONMENTAL, INC.
AND NO PART OF THIS DRAWING SHALL BE REPRODUCED,
COPIED, OR TRANSMITTED IN ANY MANNER, OR
FOR ANY OTHER PURPOSE OR PROJECT WITHOUT PRIOR
WRITTEN CONSENT OF CTI ENVIRONMENTAL, INC.
ELECTRONIC COPIES OF THIS DRAWING ARE EXACT
REPRODUCTIONS OF THE ORIGINAL DRAWING. THE
ORIGINAL DRAWING SHALL BE KEPT IN THE OFFICE OF
CTI ENVIRONMENTAL, INC. AND THE SEALED ORIGINAL
SHALL GOVERN.

DESIGNED BY	NO.	DESCRIPTIONS	DATE	BY	APPROVED
RNF	1	ADDENDUM NO. 3	9/28	RWR	WAD
SAT	2	RECORD DRAWING	1/25	RWR	WAD
MGW					
WAD					

ENVIRONMENTAL, INC.
ENGINEERS IN WATER AND EARTH SCIENCES
UNIONTOWN, OHIO

CITY OF MASSILLON, OHIO
WWTP UPGRADE 2000
INFLUENT SCREW PUMP PLAN AND SECTION

JOB NO. E9031
DATE 08/13/01
SCALE AS NOTED
SHEET P17