
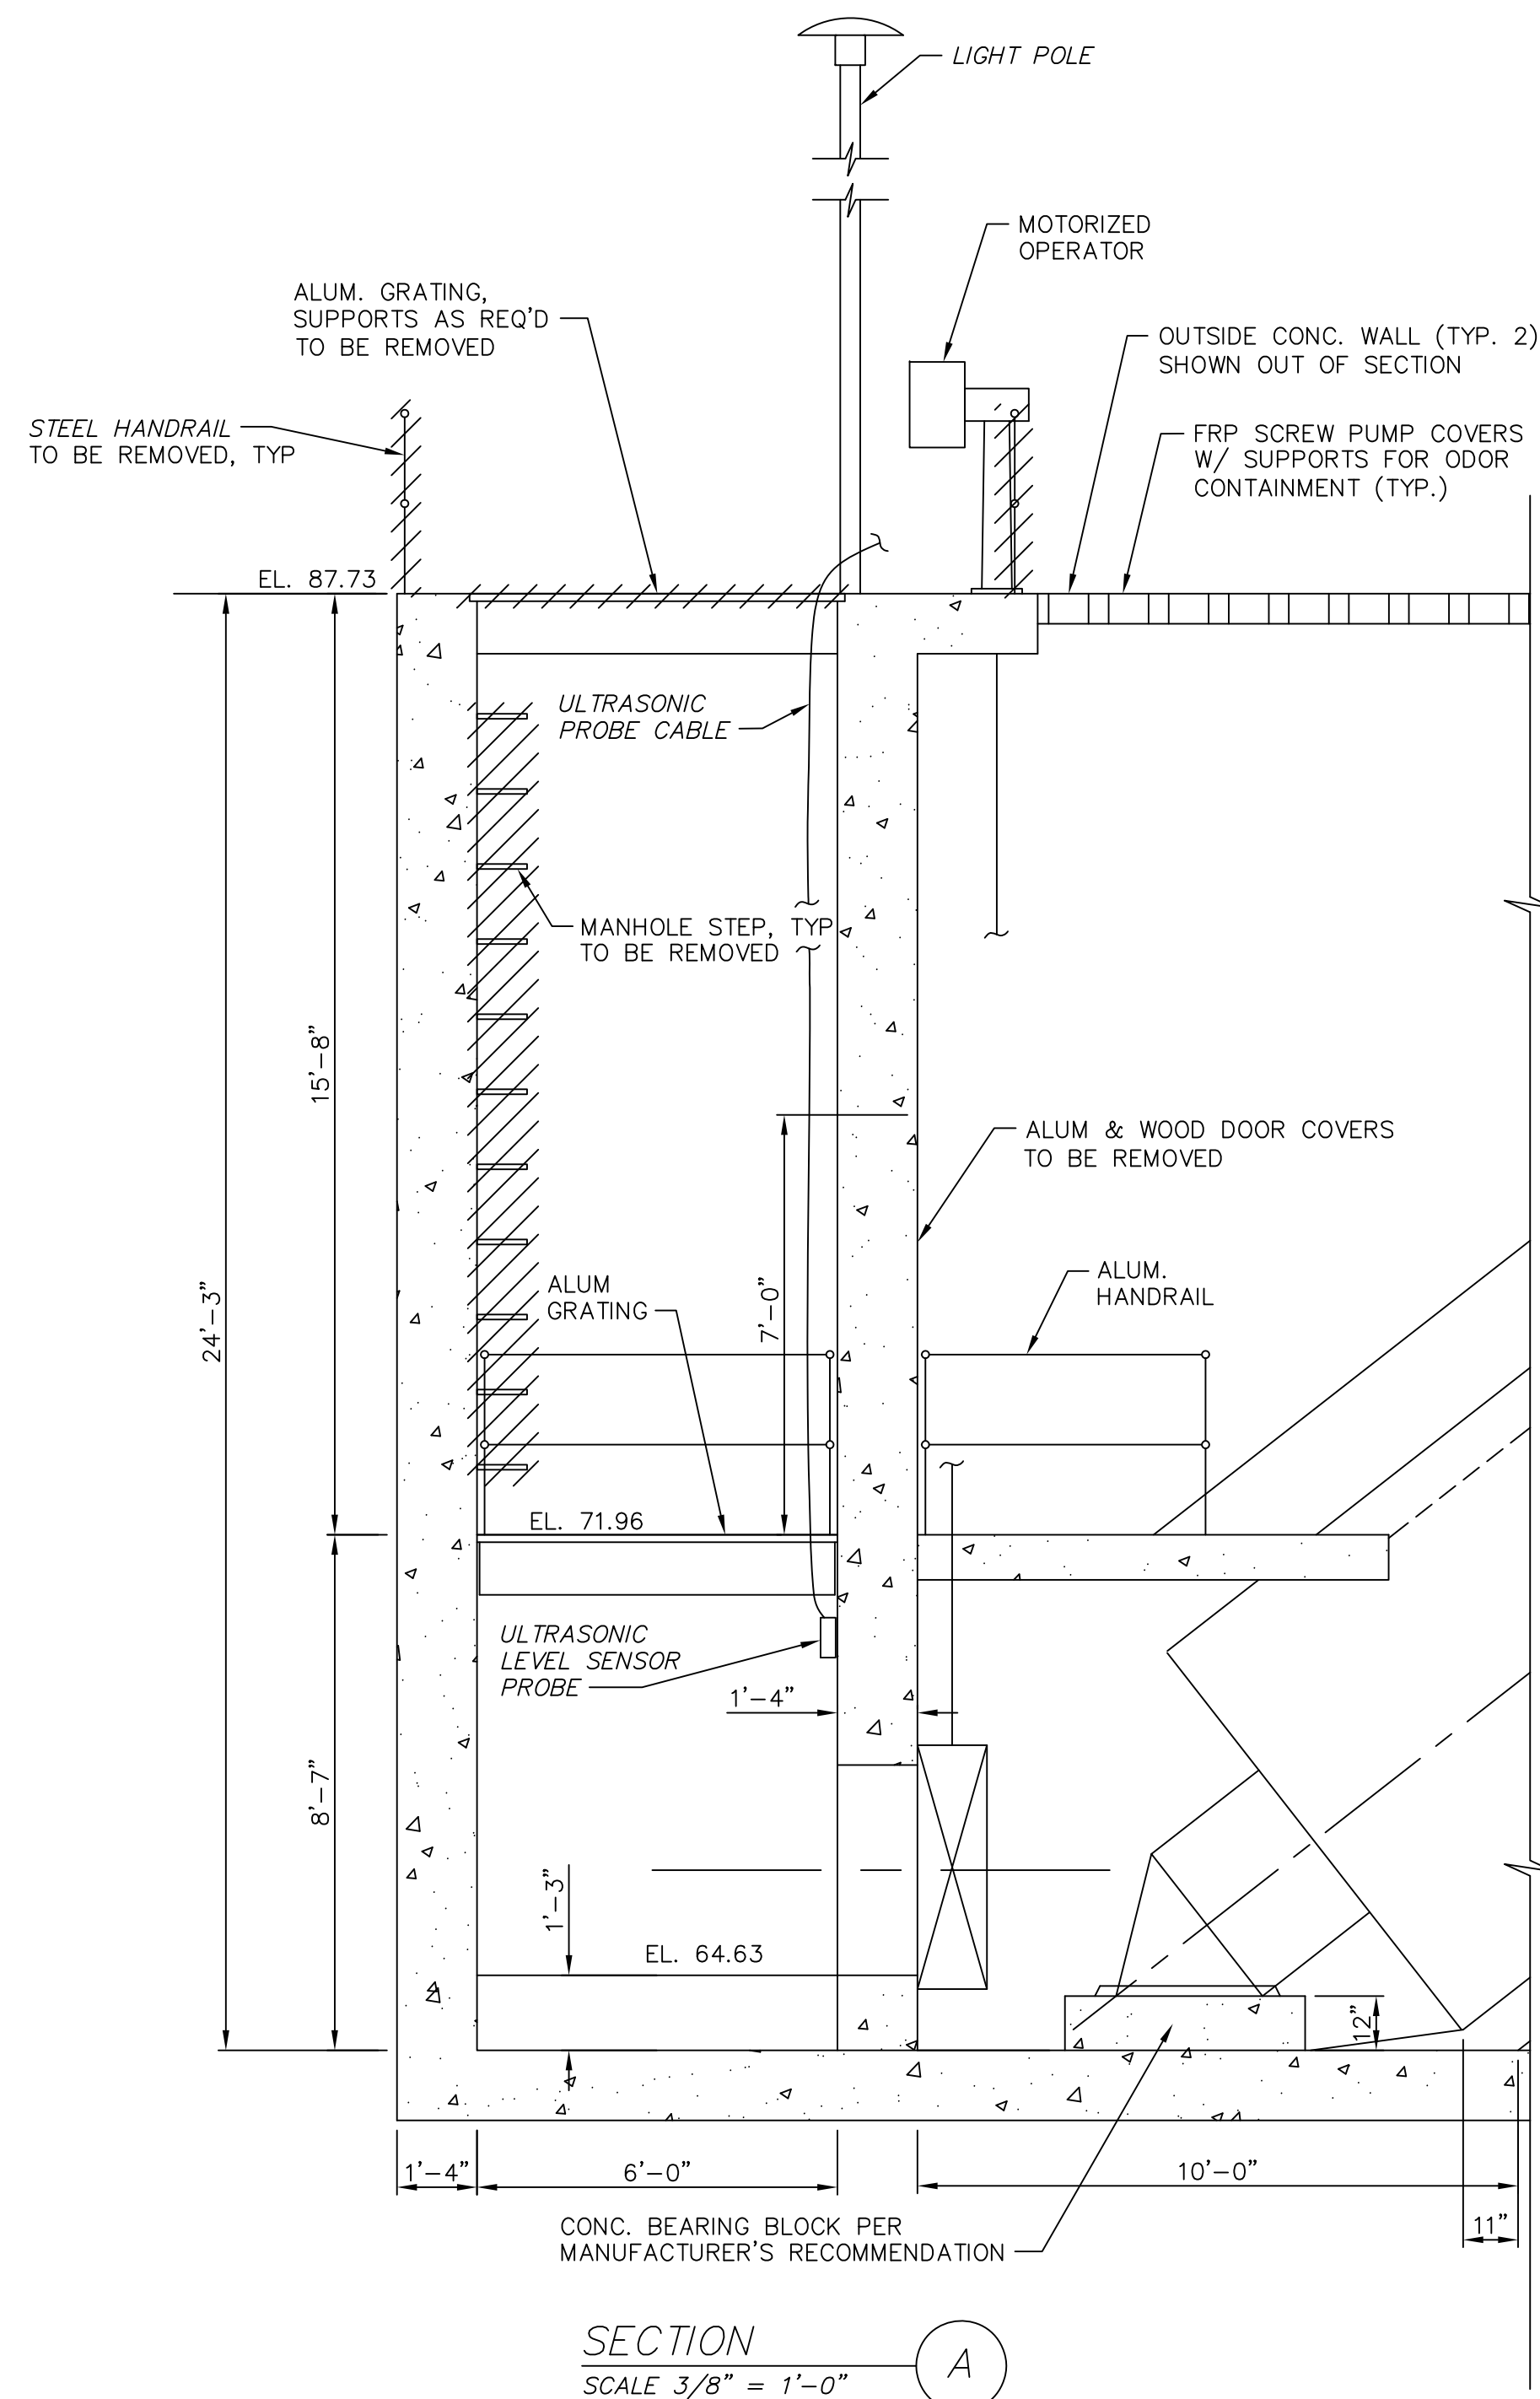


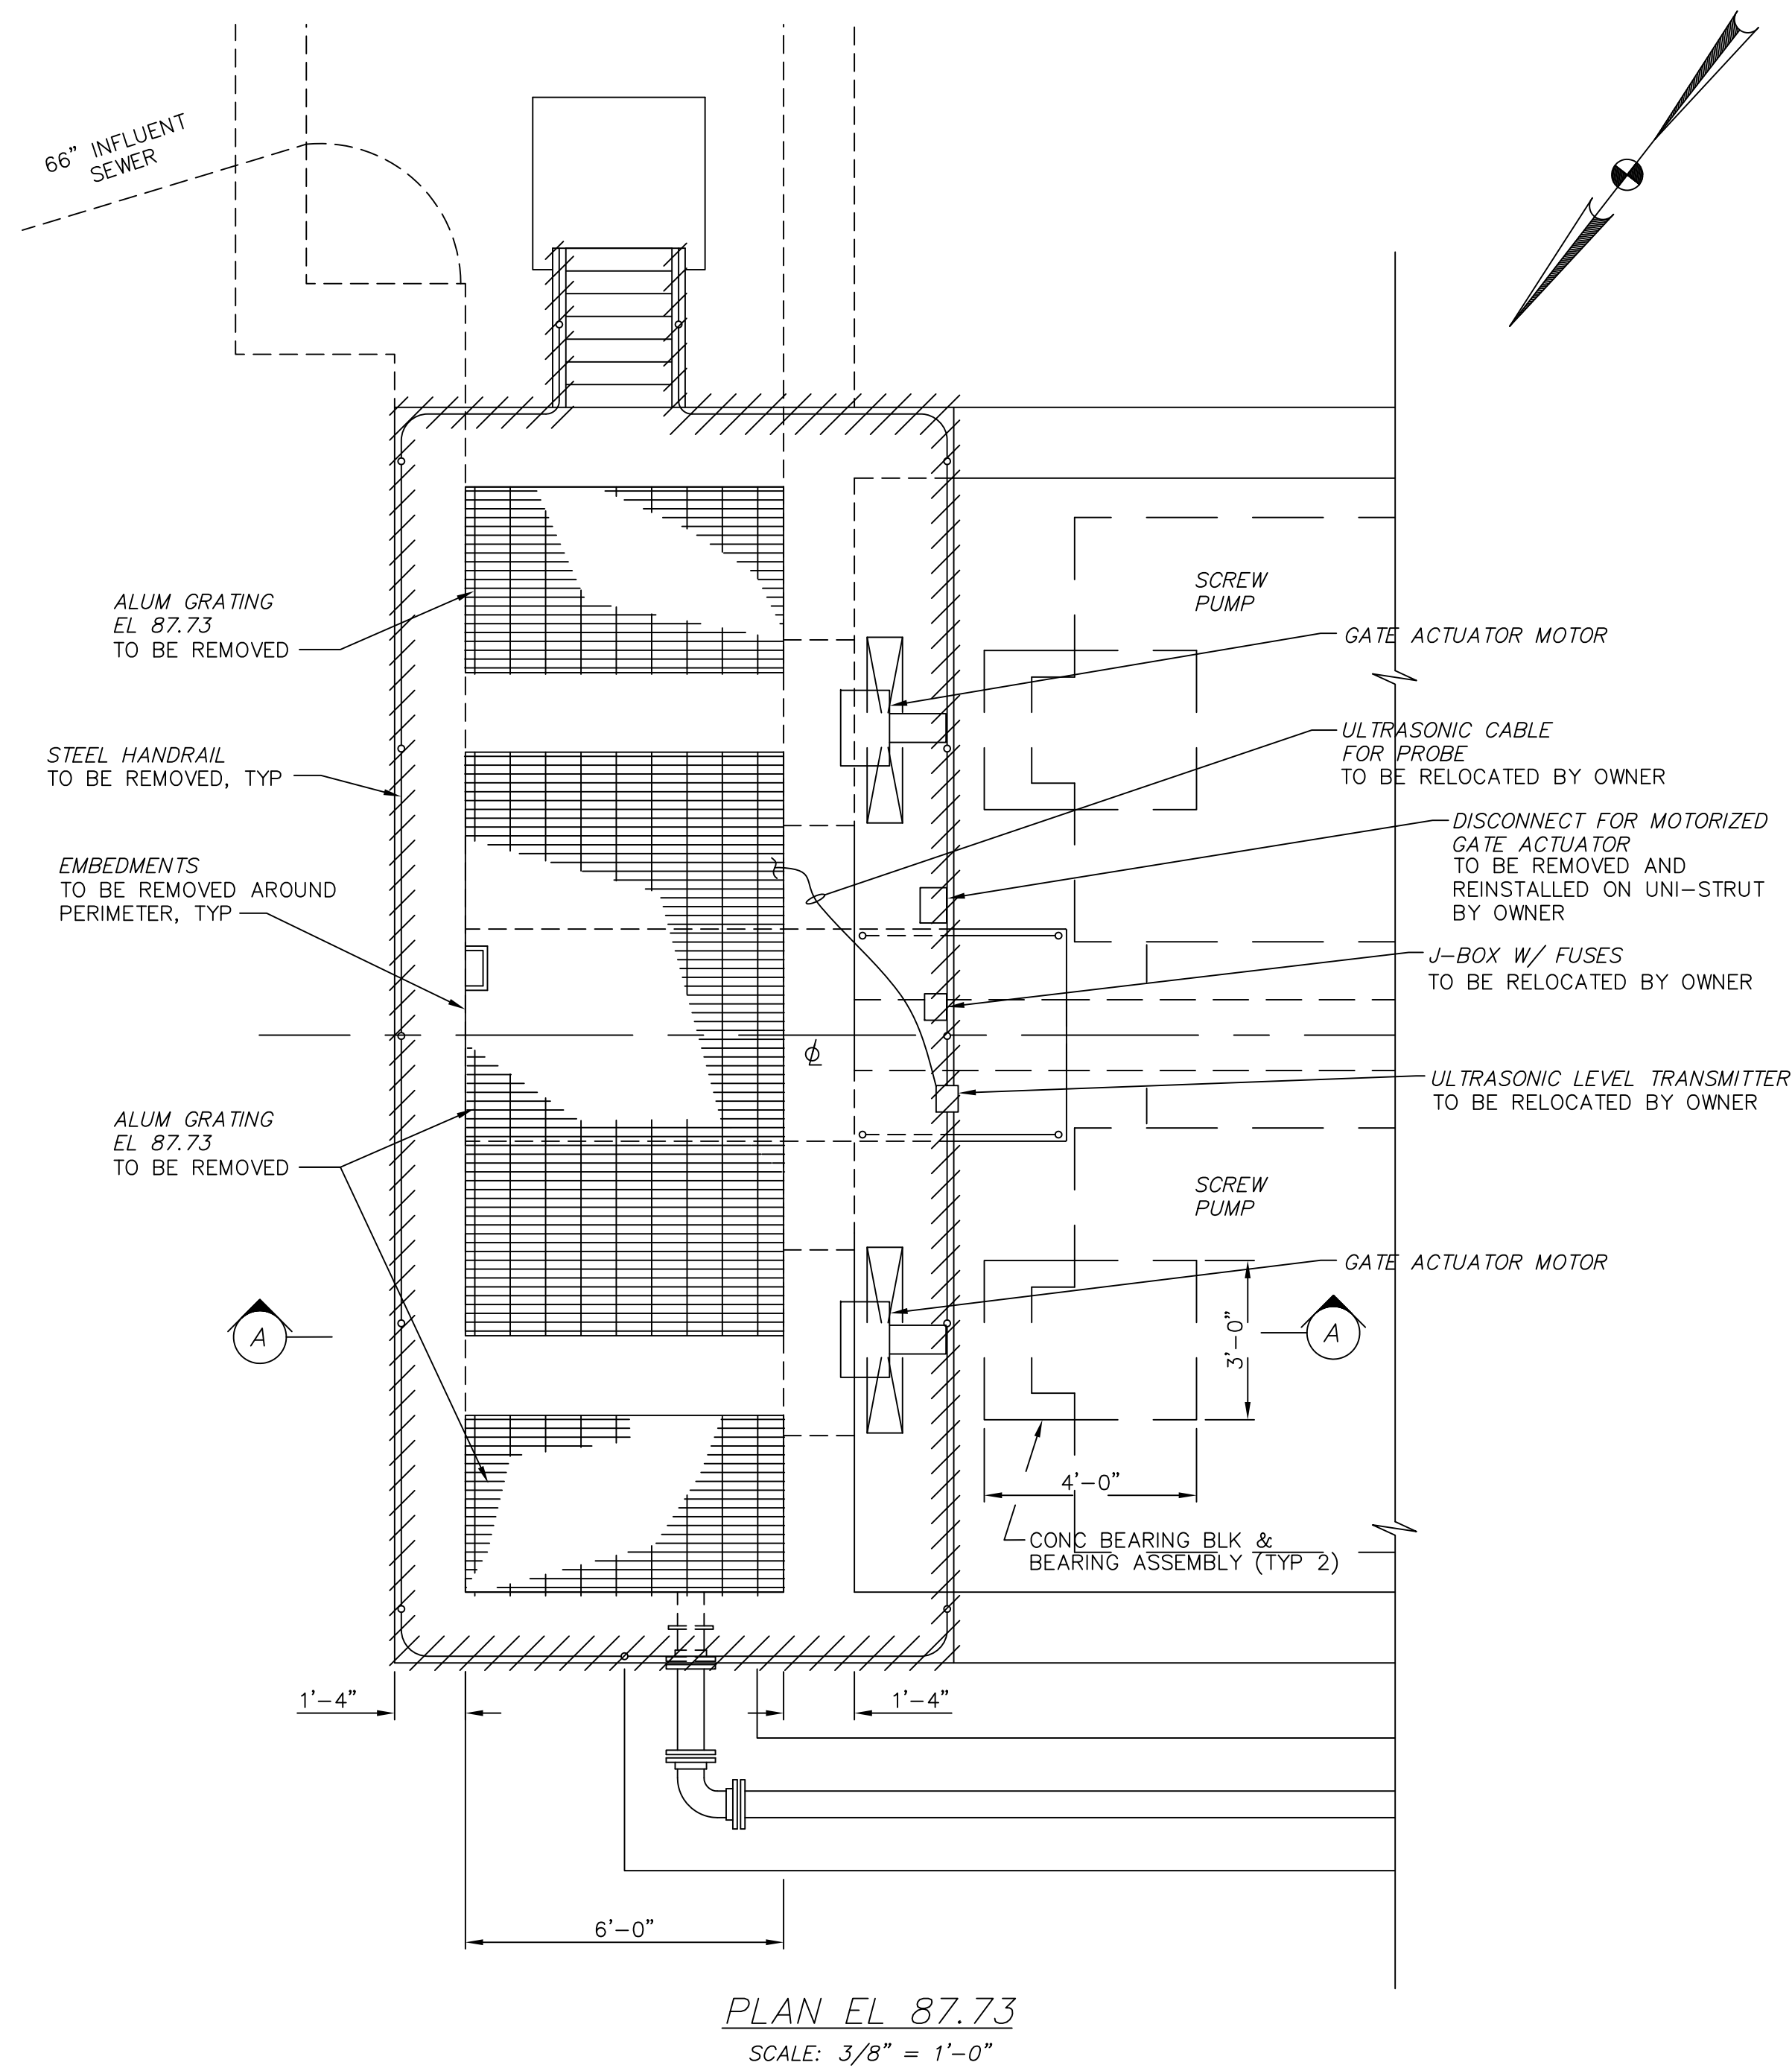

THESE RECORD DOCUMENTS HAVE BEEN PREPARED
BASED ON INFORMATION PROVIDED BY OTHERS. CTI
ENVIRONMENTAL HAS REVIEWED THE INFORMATION
SUBMITTED AND BELIEVES IT REFLECTS THE WORK AS
CONSTRUCTED. HOWEVER, ALL PERSONS SHALL
VERIFY INFORMATION TAKEN FROM THIS DRAWING.

THIS DRAWING IS AN INSTRUMENT OF SERVICE OWNED
BY CTI ENVIRONMENTAL, INC. WHICH SHALL BE DEEMED
TO BE THE PROPERTY OF CTI ENVIRONMENTAL, INC.
AND NO PARTS OF THIS DRAWING SHALL BE REPRODUCED
OR COPIED IN ANY MANNER WITHOUT THE WRITTEN
CONSENT OF CTI ENVIRONMENTAL, INC. THAT
ELECTRONIC COPIES OF THIS DRAWING ARE EXACT
REPRODUCTIONS OF THE ORIGINAL DRAWING. THE
ORIGINAL DRAWING SHALL BE KEPT IN THE ORIGINAL
COPY AND THE SEALED ORIGINAL SHALL COVER.

DESIGNED BY				REVISIONS			
NO.	DESCRIPTIONS	DATE	BY	NO.	DESCRIPTIONS	DATE	BY
1	RECORD DRAWING	1/25	MGW				

CTI ENVIRONMENTAL, INC. ENGINEERS IN WATER AND EARTH SCIENCES UNIONTOWN, OHIO	CITY OF MASSILLON, OHIO	
	WWTP UPGRADE 2000	
	INFLUENT SCREW PUMP DEMOLITION PLAN AND SECTION	

JOB NO.	E02008-4-8
DATE	4/28/03
SCALE	AS NOTED
SHEET	P17A