




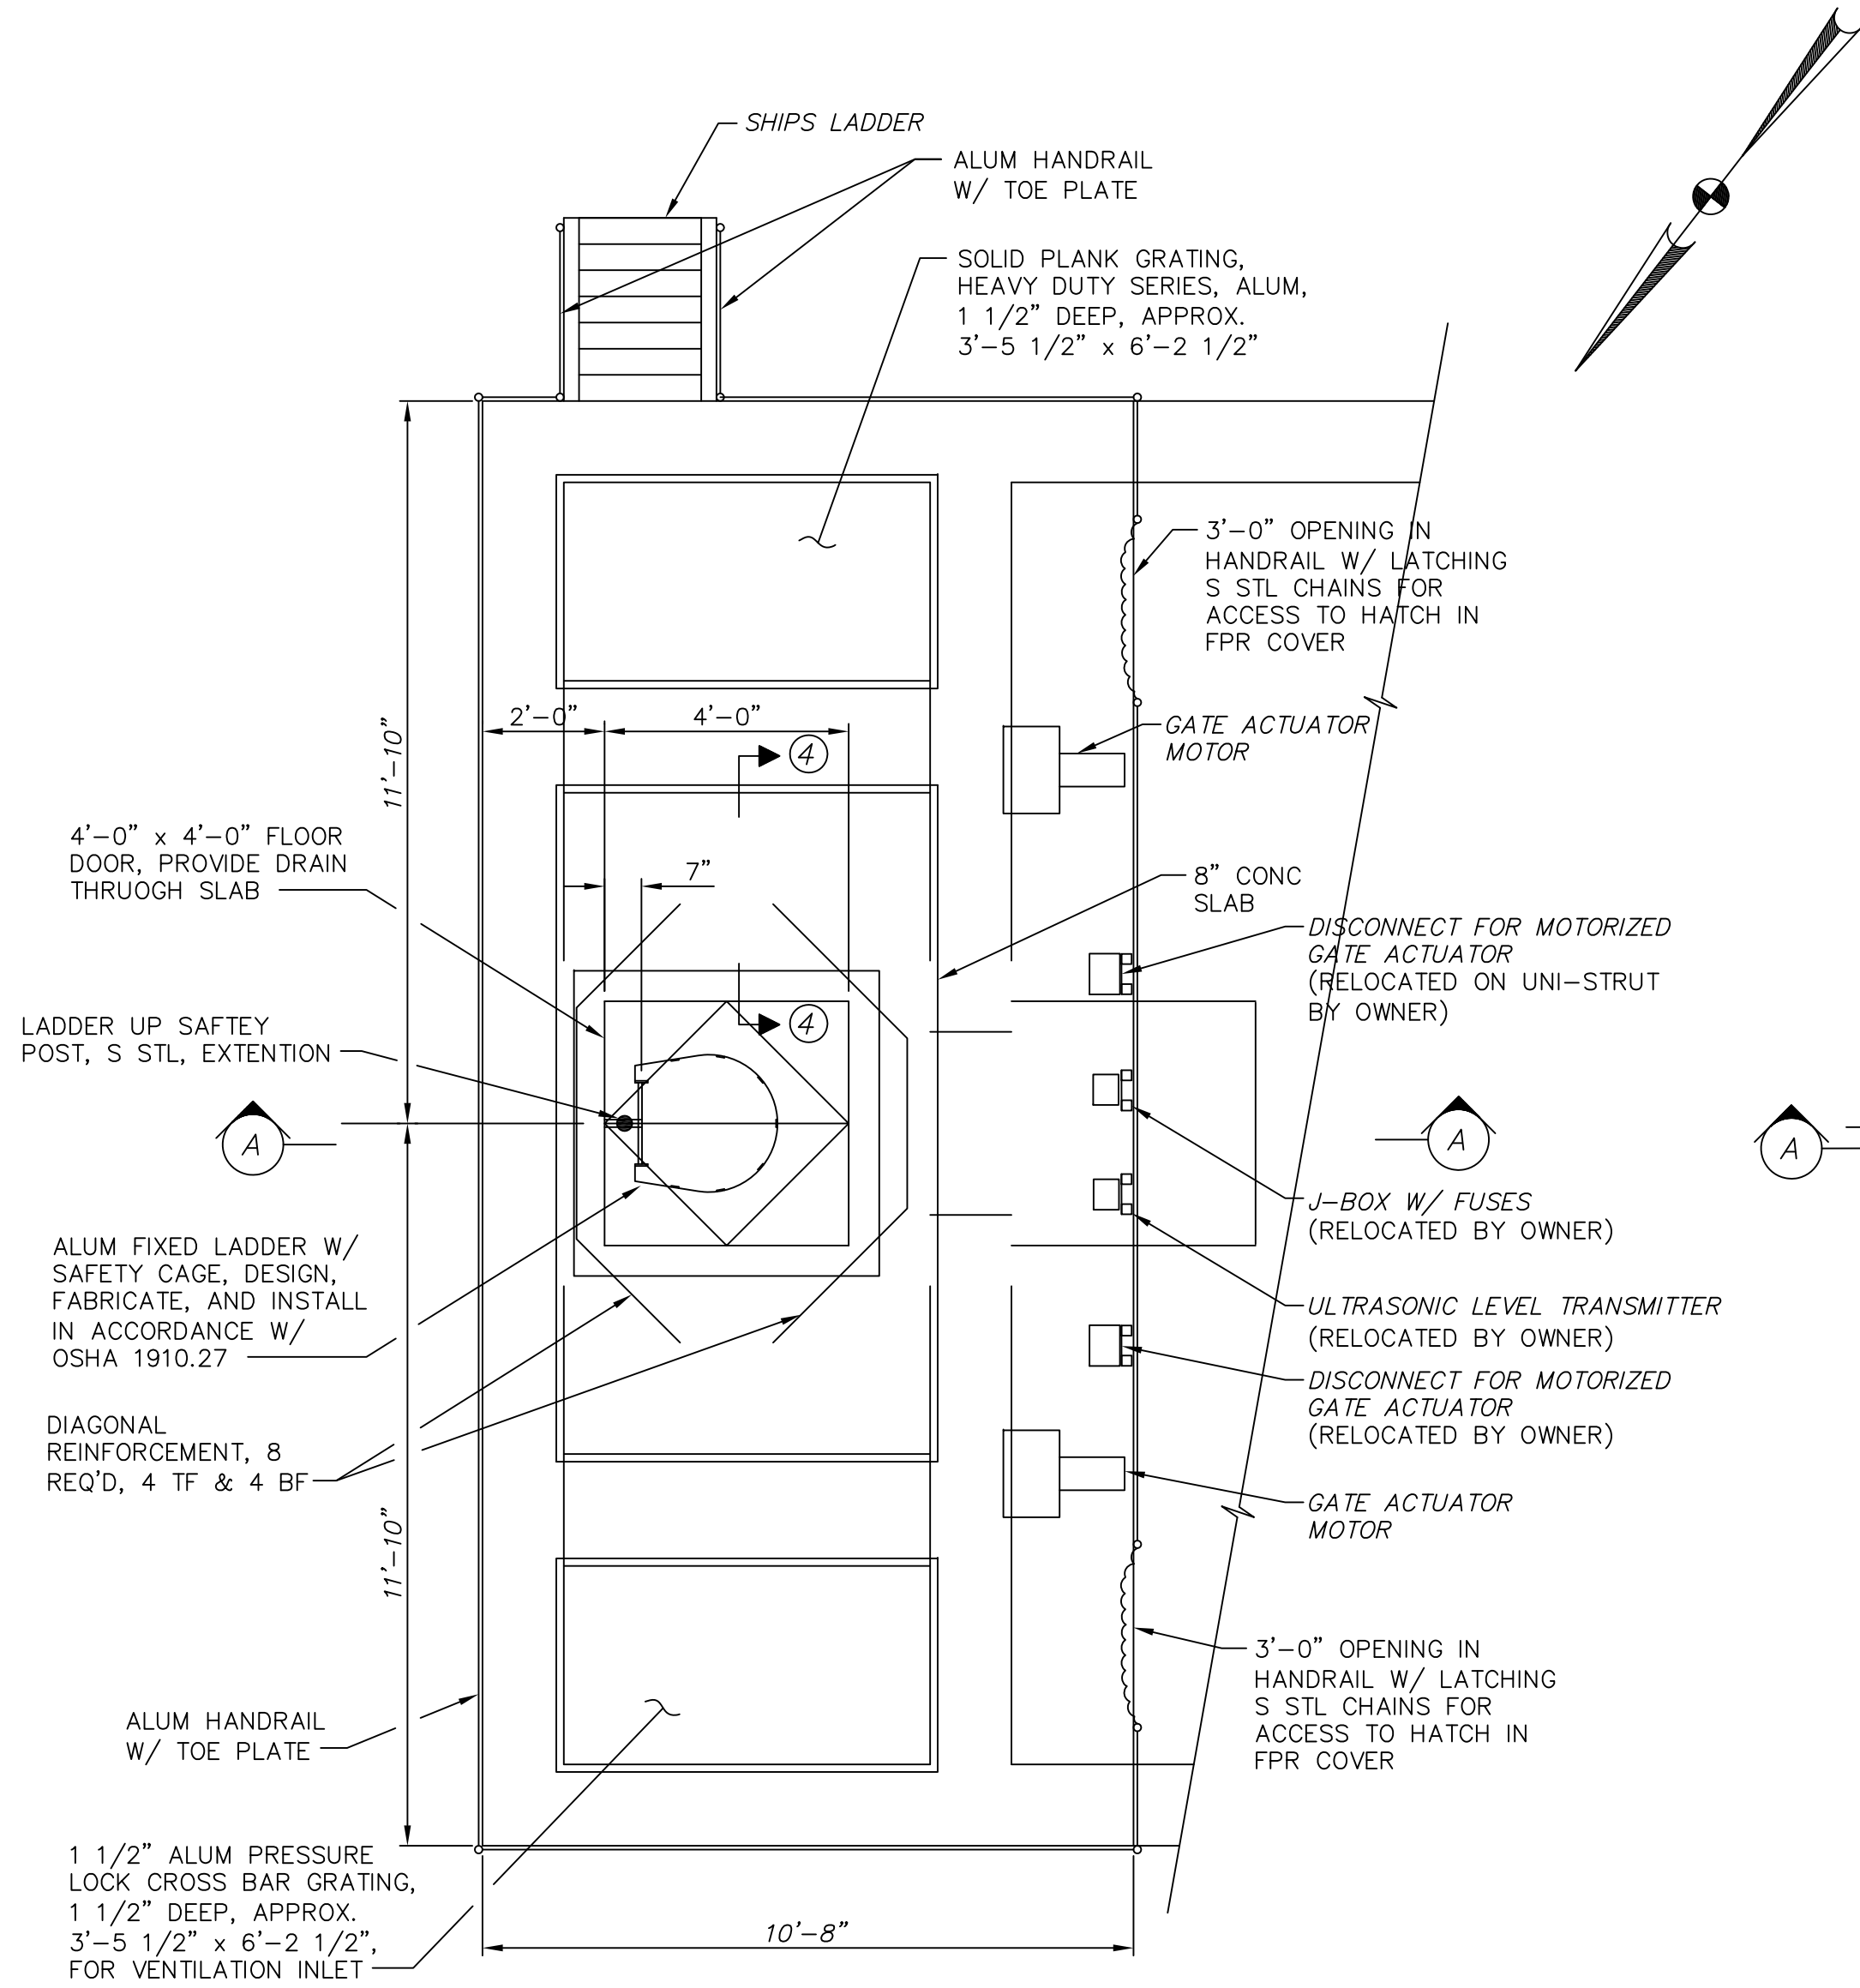


PLAN EL 87.73
SCALE: 3/8" = 1'-0"

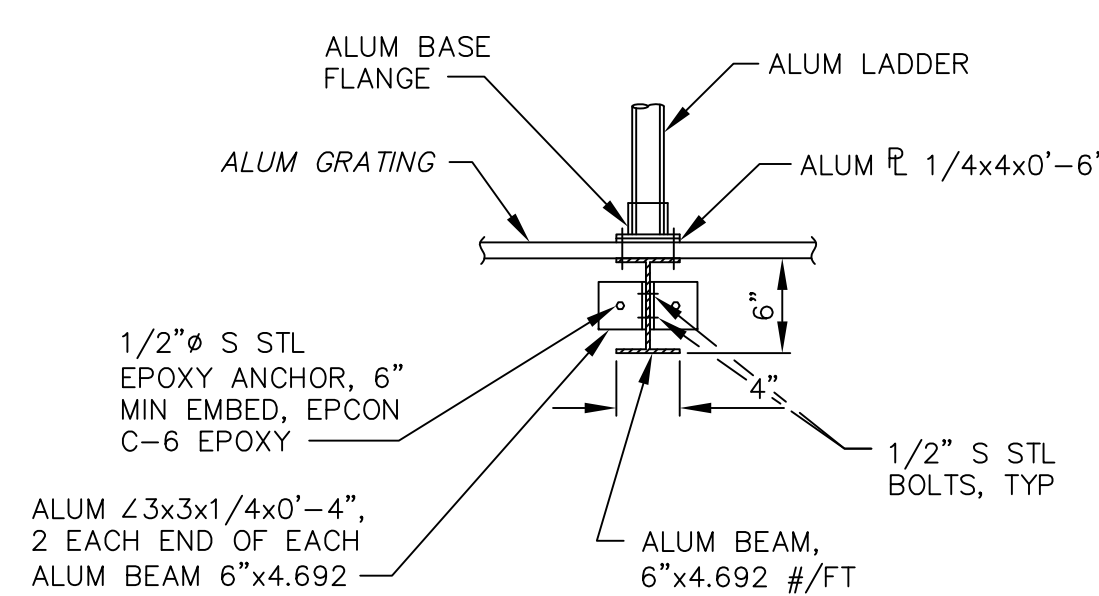


SECTION 1
SCALE 1" = 1'-0"

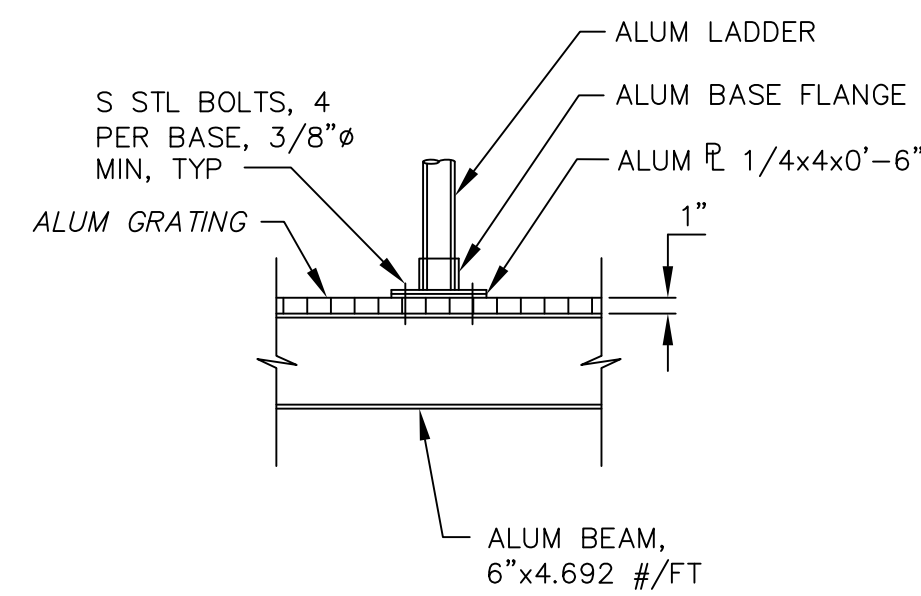


DETAIL 2
SCALE 1" = 1'-0"

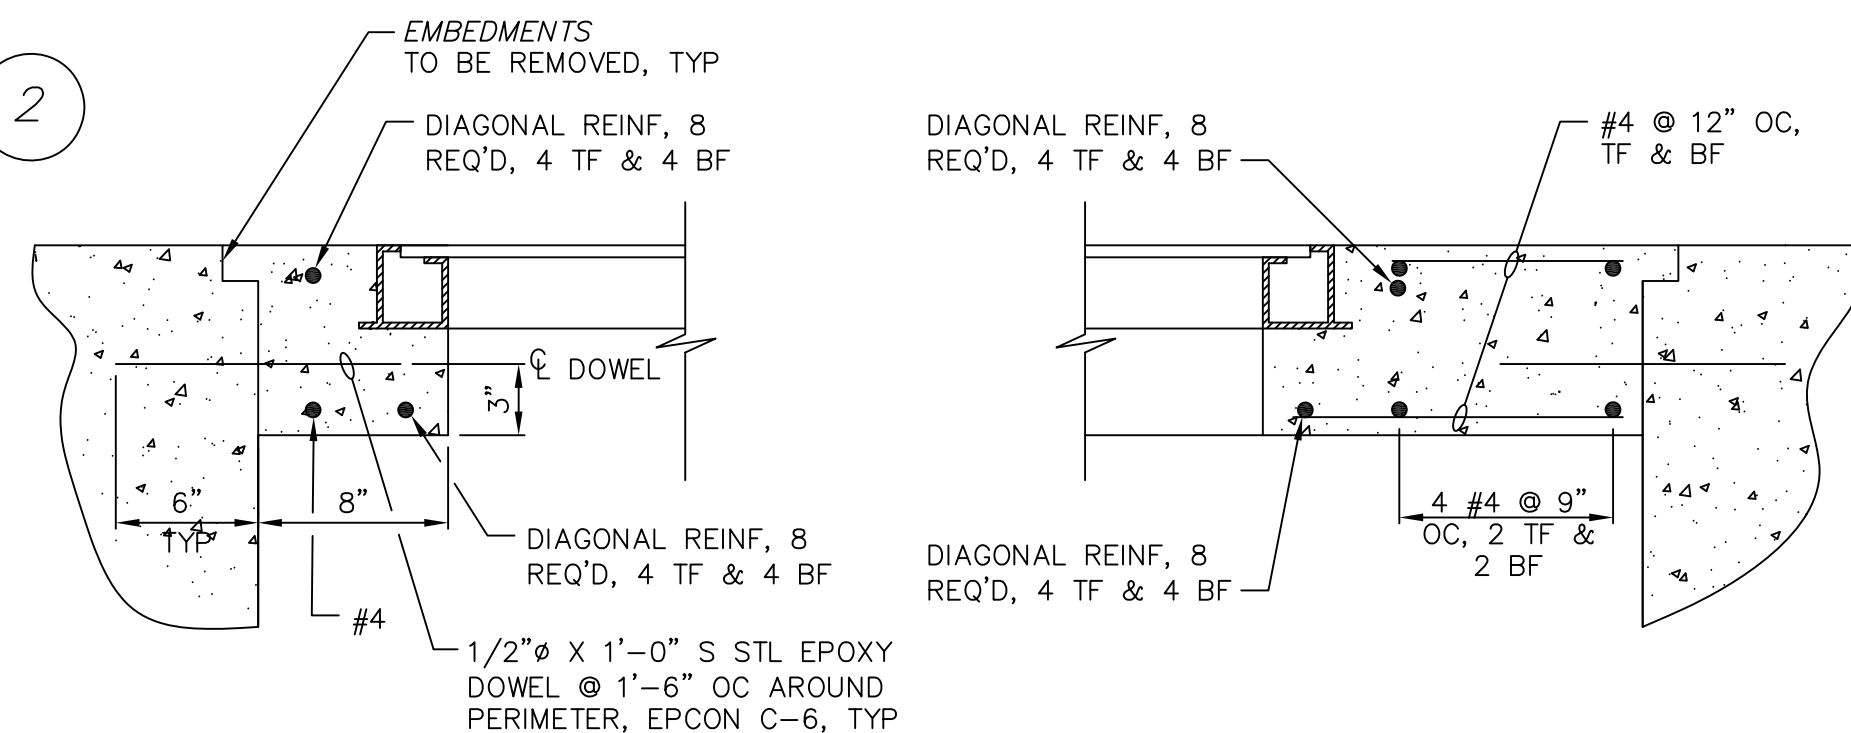


DETAIL 3
SCALE 1 1/2" = 1'-0"

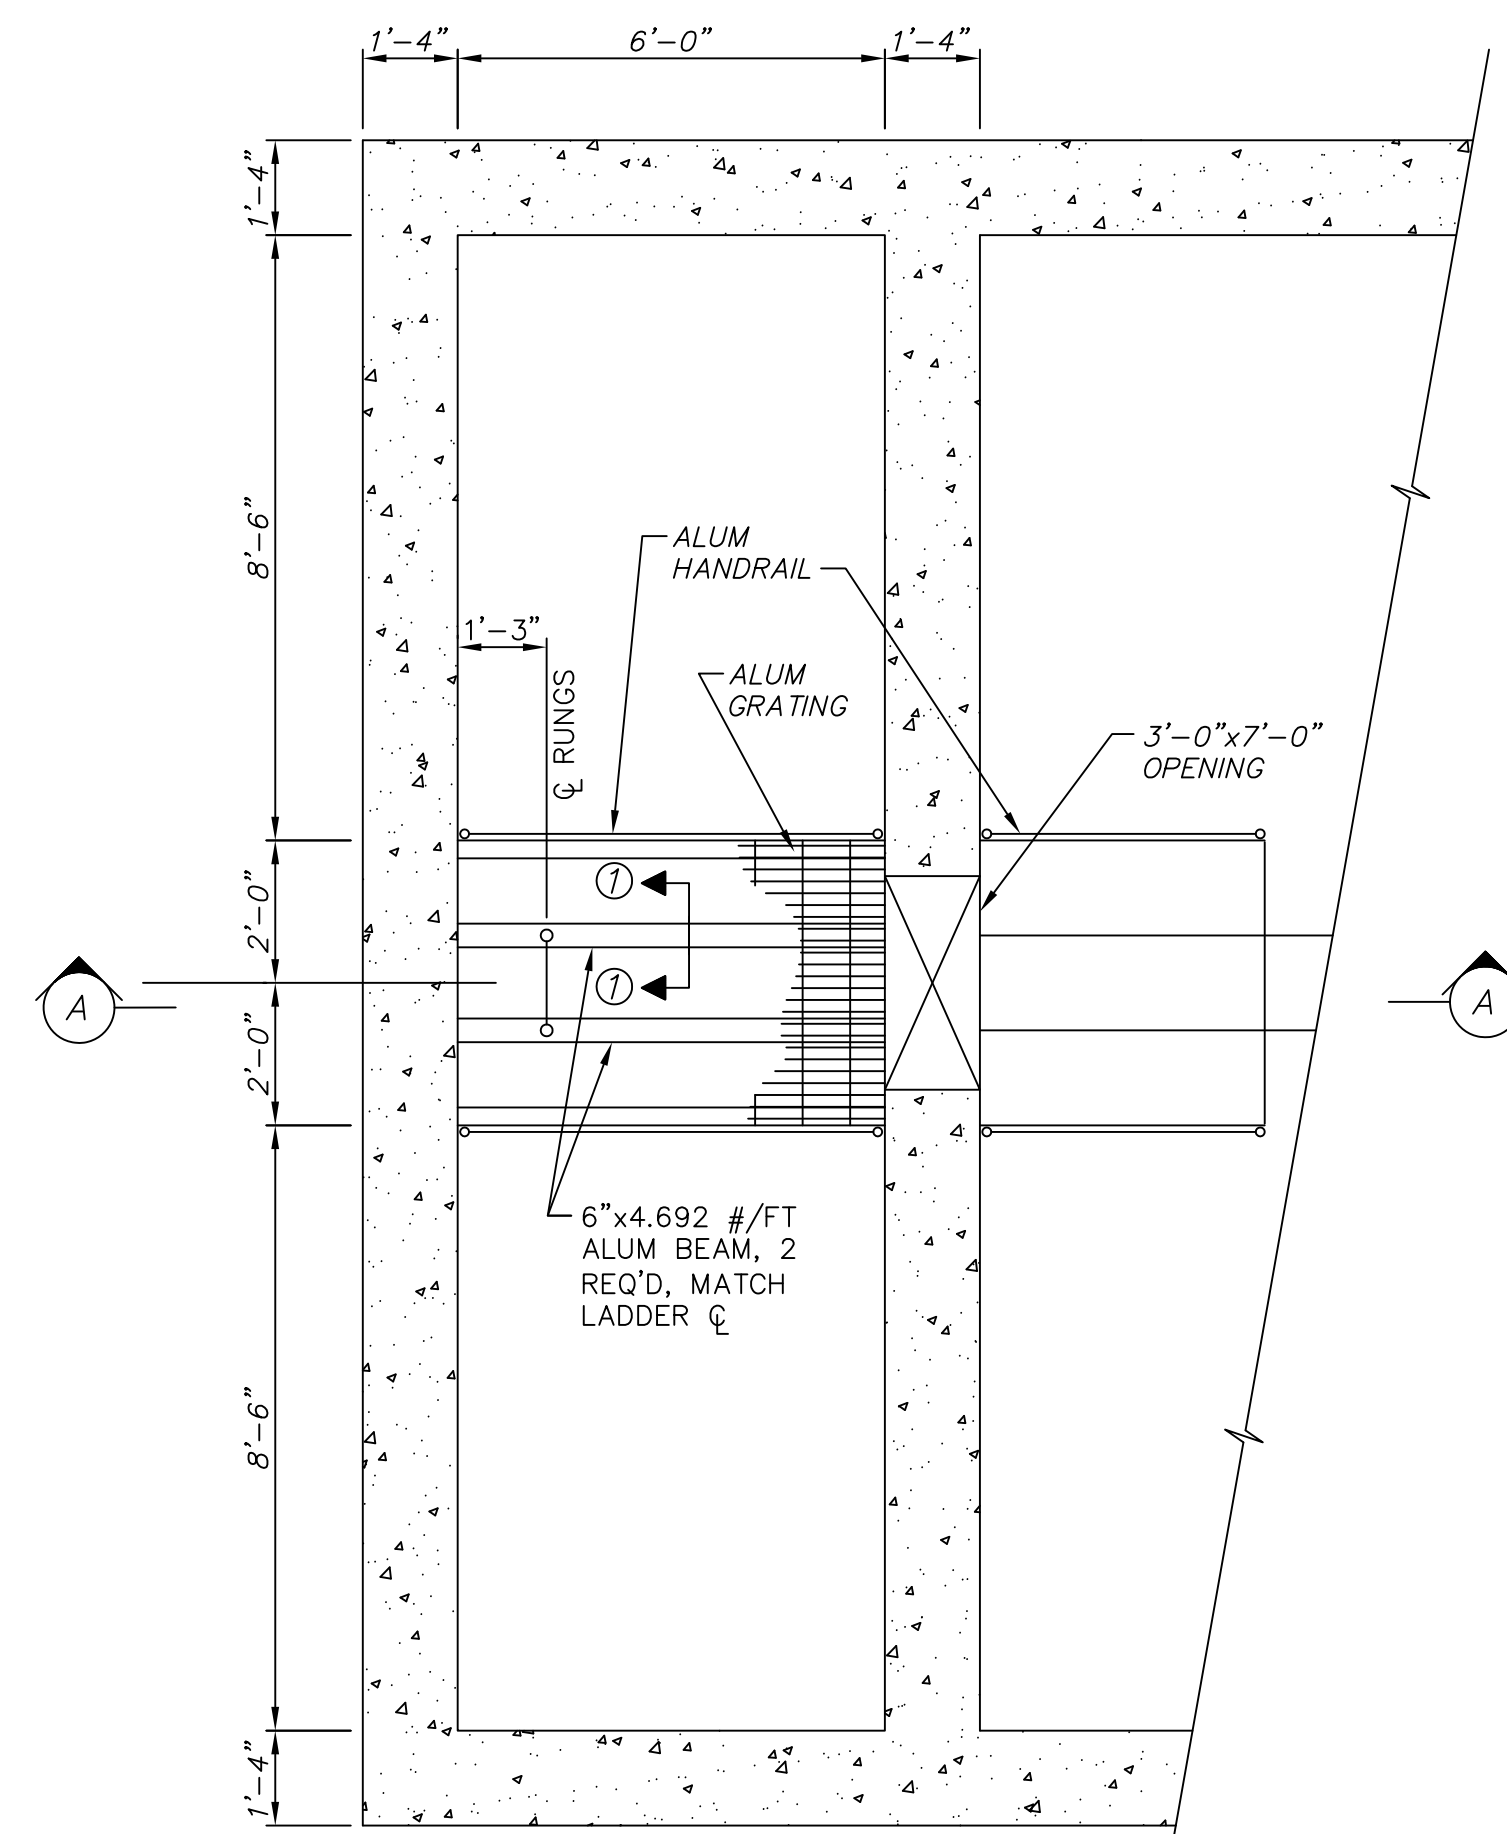

PLAN EL 71.96
SCALE: 3/8" = 1'-0"

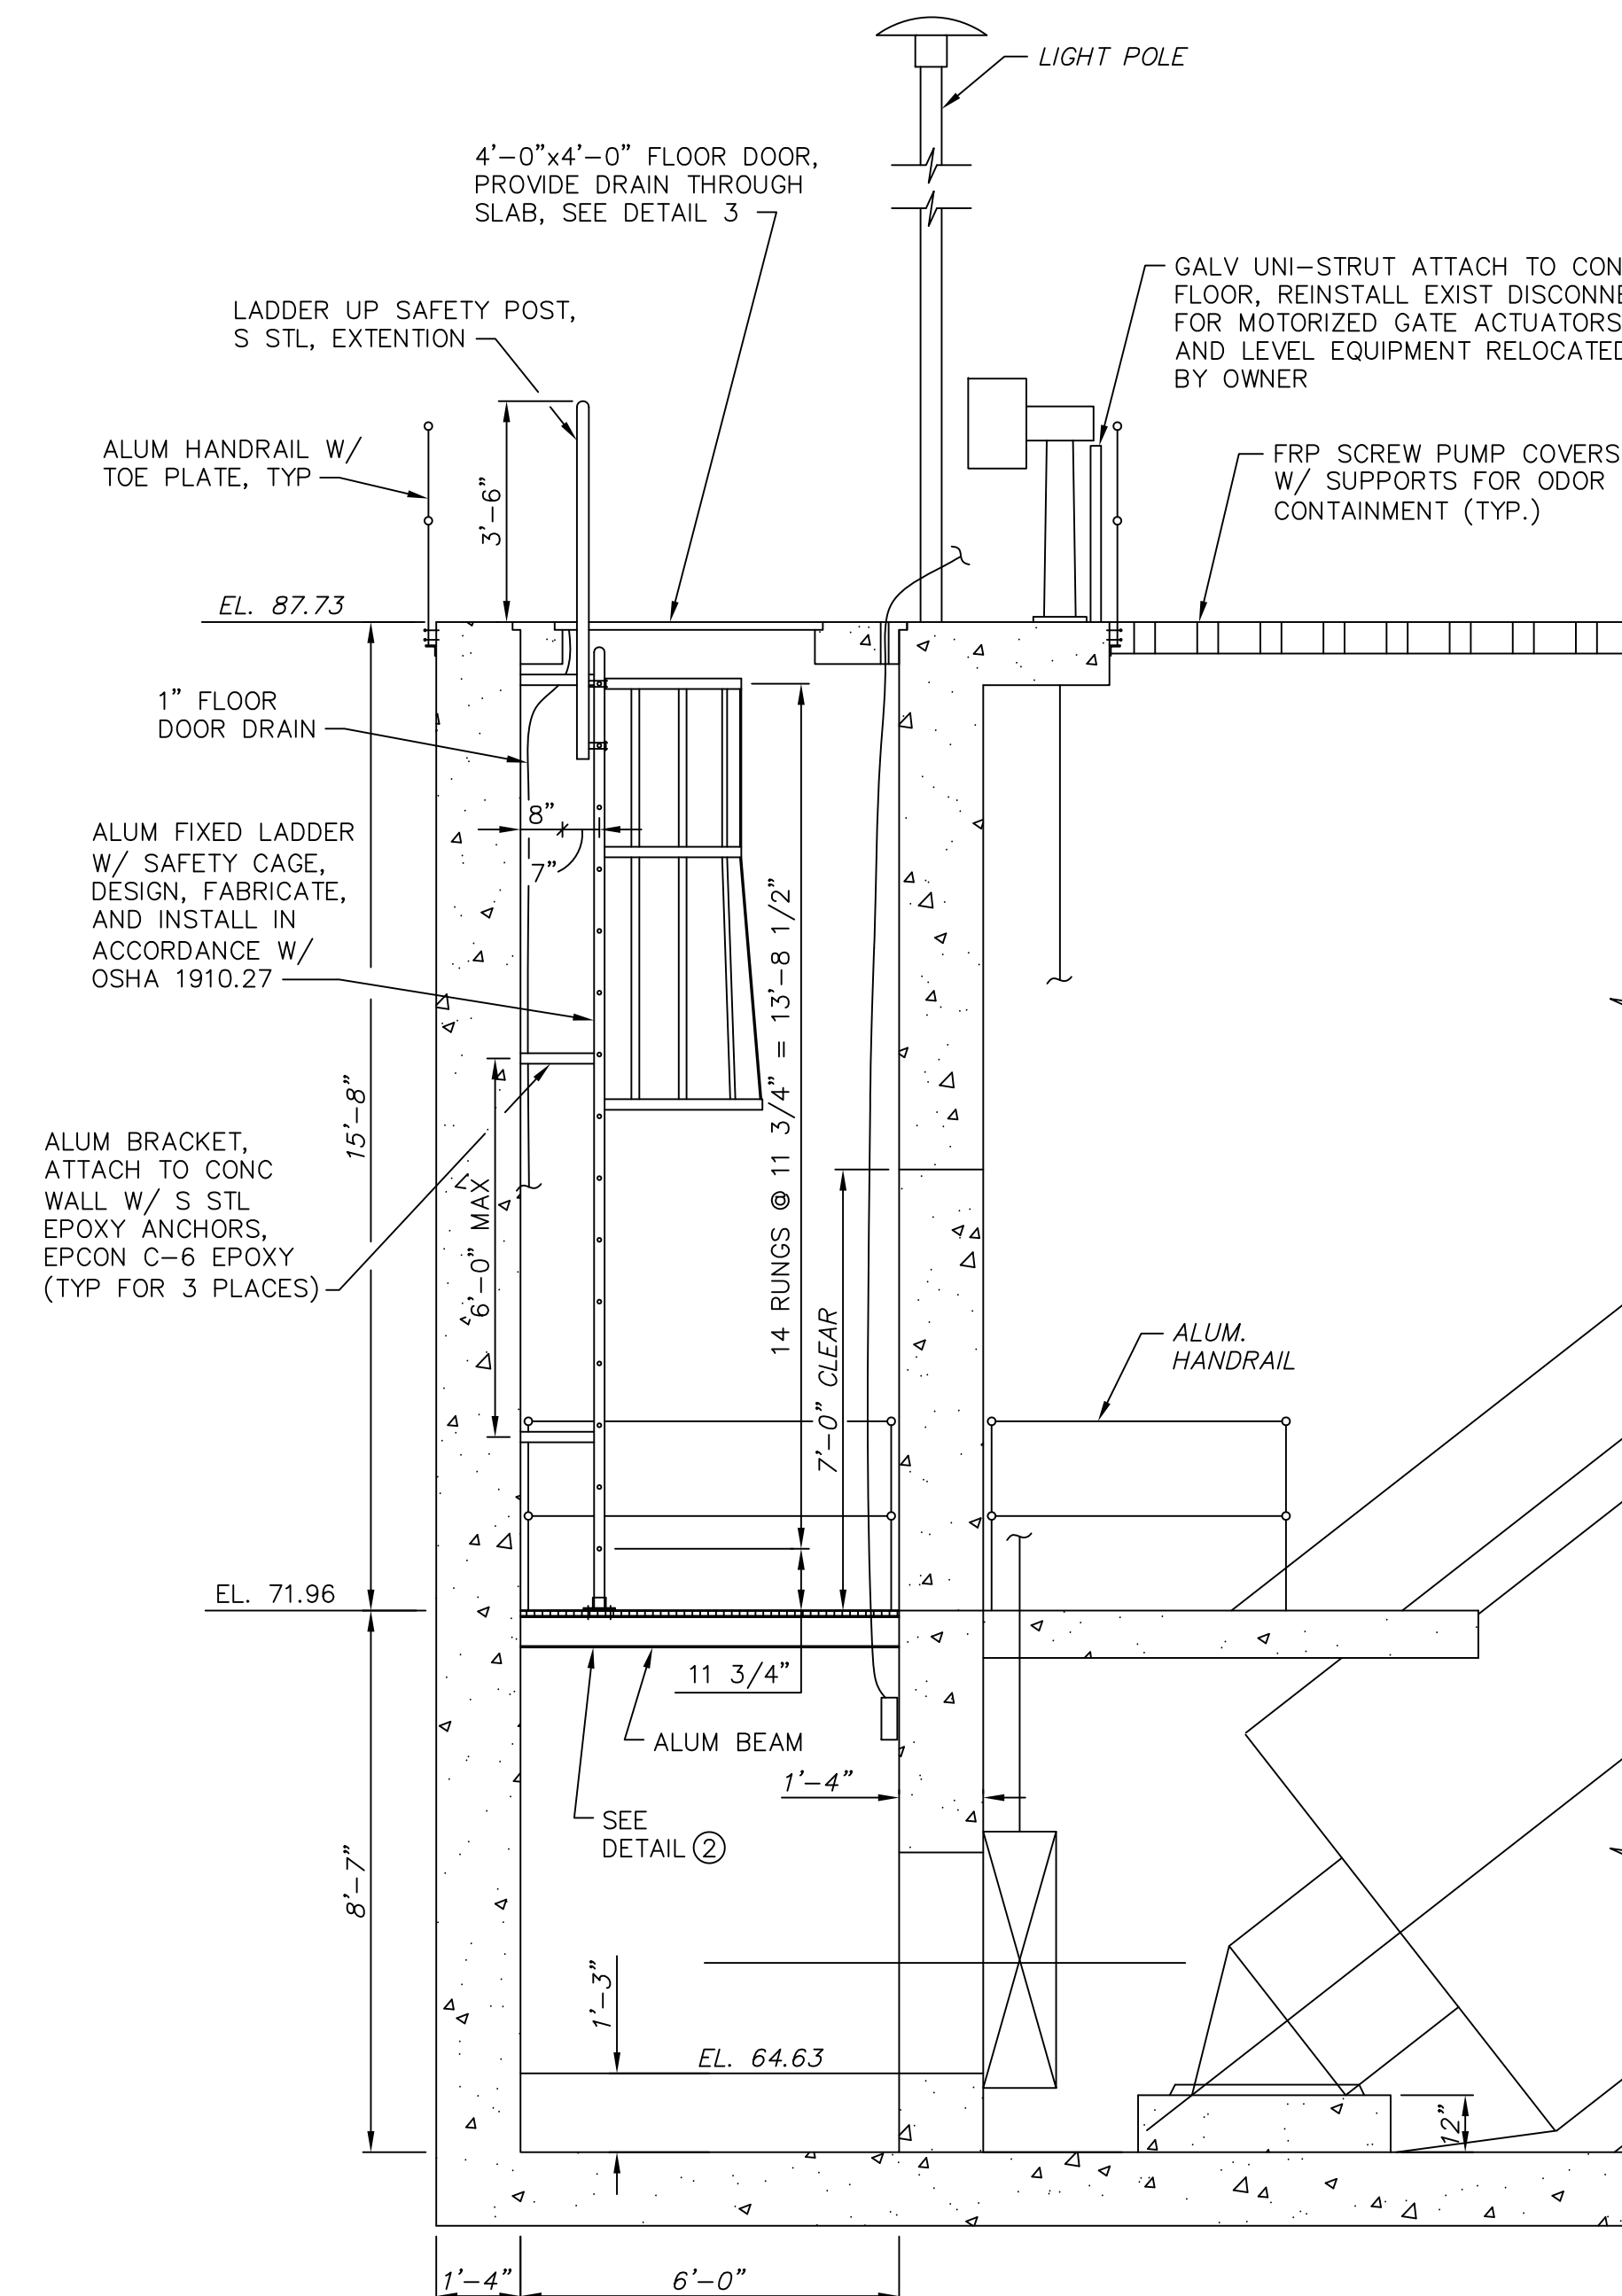

SECTION A
SCALE 3/8" = 1'-0"

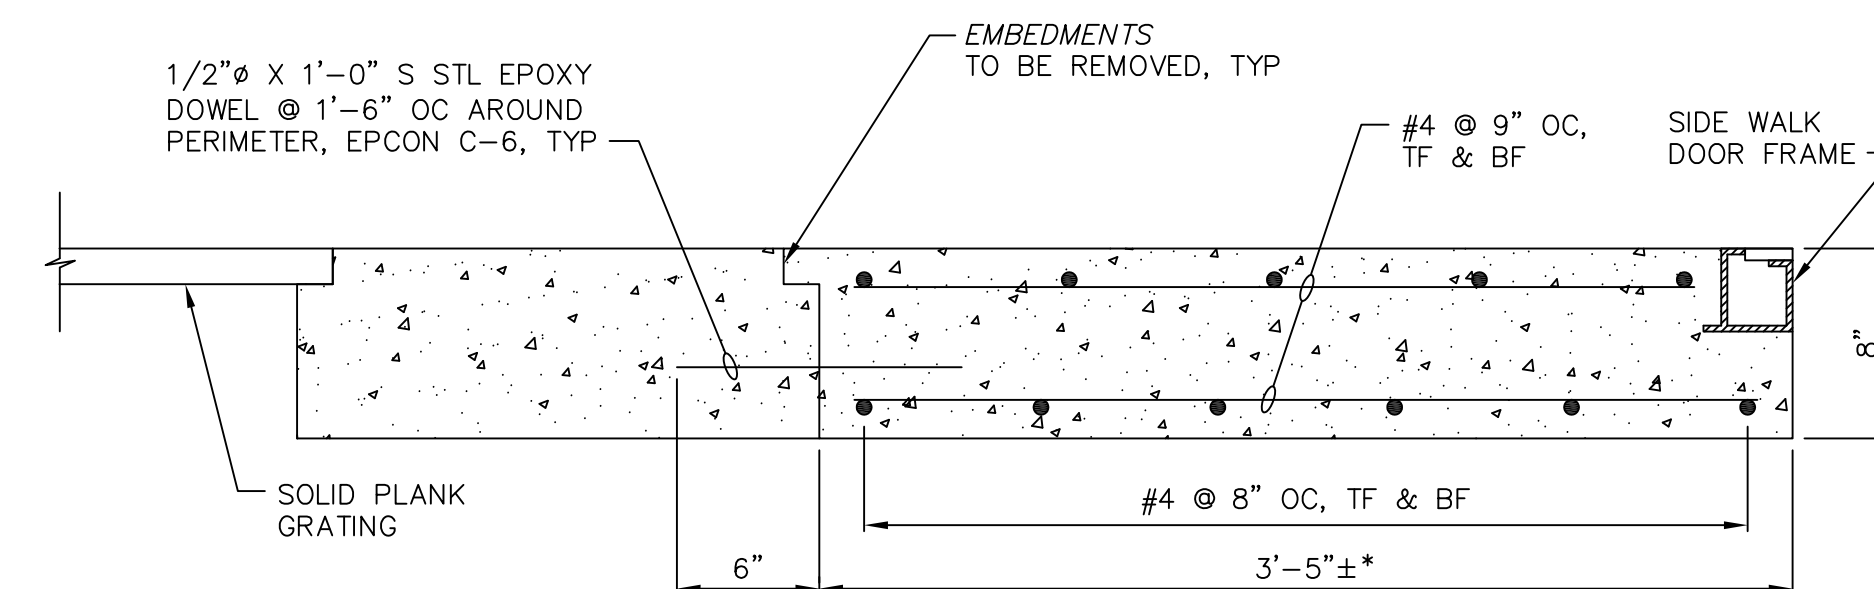

SECTION 4
SCALE 1 1/2" = 1'-0"

THESE RECORD DOCUMENTS HAVE BEEN PREPARED BASED ON INFORMATION PROVIDED BY OTHERS. CTI ENVIRONMENTAL HAS REVIEWED THE INFORMATION SUBMITTED AND BELIEVES IT REFLECTS THE WORK AS CONSTRUCTED. HOWEVER, ALL PERSONS SHALL VERIFY INFORMATION TAKEN FROM THIS DRAWING.

THIS DRAWING IS AN INSTRUMENT OF SERVICE OWNED BY CTI ENVIRONMENTAL, INC. WHICH SHALL BE DEEMED TO BE THE PROPERTY OF CTI ENVIRONMENTAL, INC. AND NO PART OF THIS DRAWING SHALL BE REPRODUCED, COPIED, OR ANY OTHER PURPOSE OR PROJECT WITHOUT PRIOR WRITTEN CONSENT OF CTI ENVIRONMENTAL, INC. THAT ELECTRONIC COPIES OF THIS DRAWING ARE EXACT REPRODUCTIONS OF THE ORIGINAL DRAWING. THE ORIGINAL DRAWING SHALL BE KEPT IN THE OFFICE OF THE ENGINEER. THE SEALED ORIGINAL SHALL COVER.

DESIGNED BY	NO.	REVISIONS	DATE	BY	APP'D
TMK	1	RECORD DRAWING	1/25	MGW	WAD
DRAWN BY					
CHECKED BY					
APPROVED BY					

ENVIRONMENTAL, INC.
ENGINEERS IN WATER AND EARTH SCIENCES
UNIONTOWN, OHIO

CITY OF MASSILLON, OHIO
WWTP UPGRADE 2000
INFLUENT SCREW PUMP PLAN AND SECTION

JOB NO.	E02008-4-8
DATE	4/28/03
SCALE	AS NOTED
SHEET	P17B