



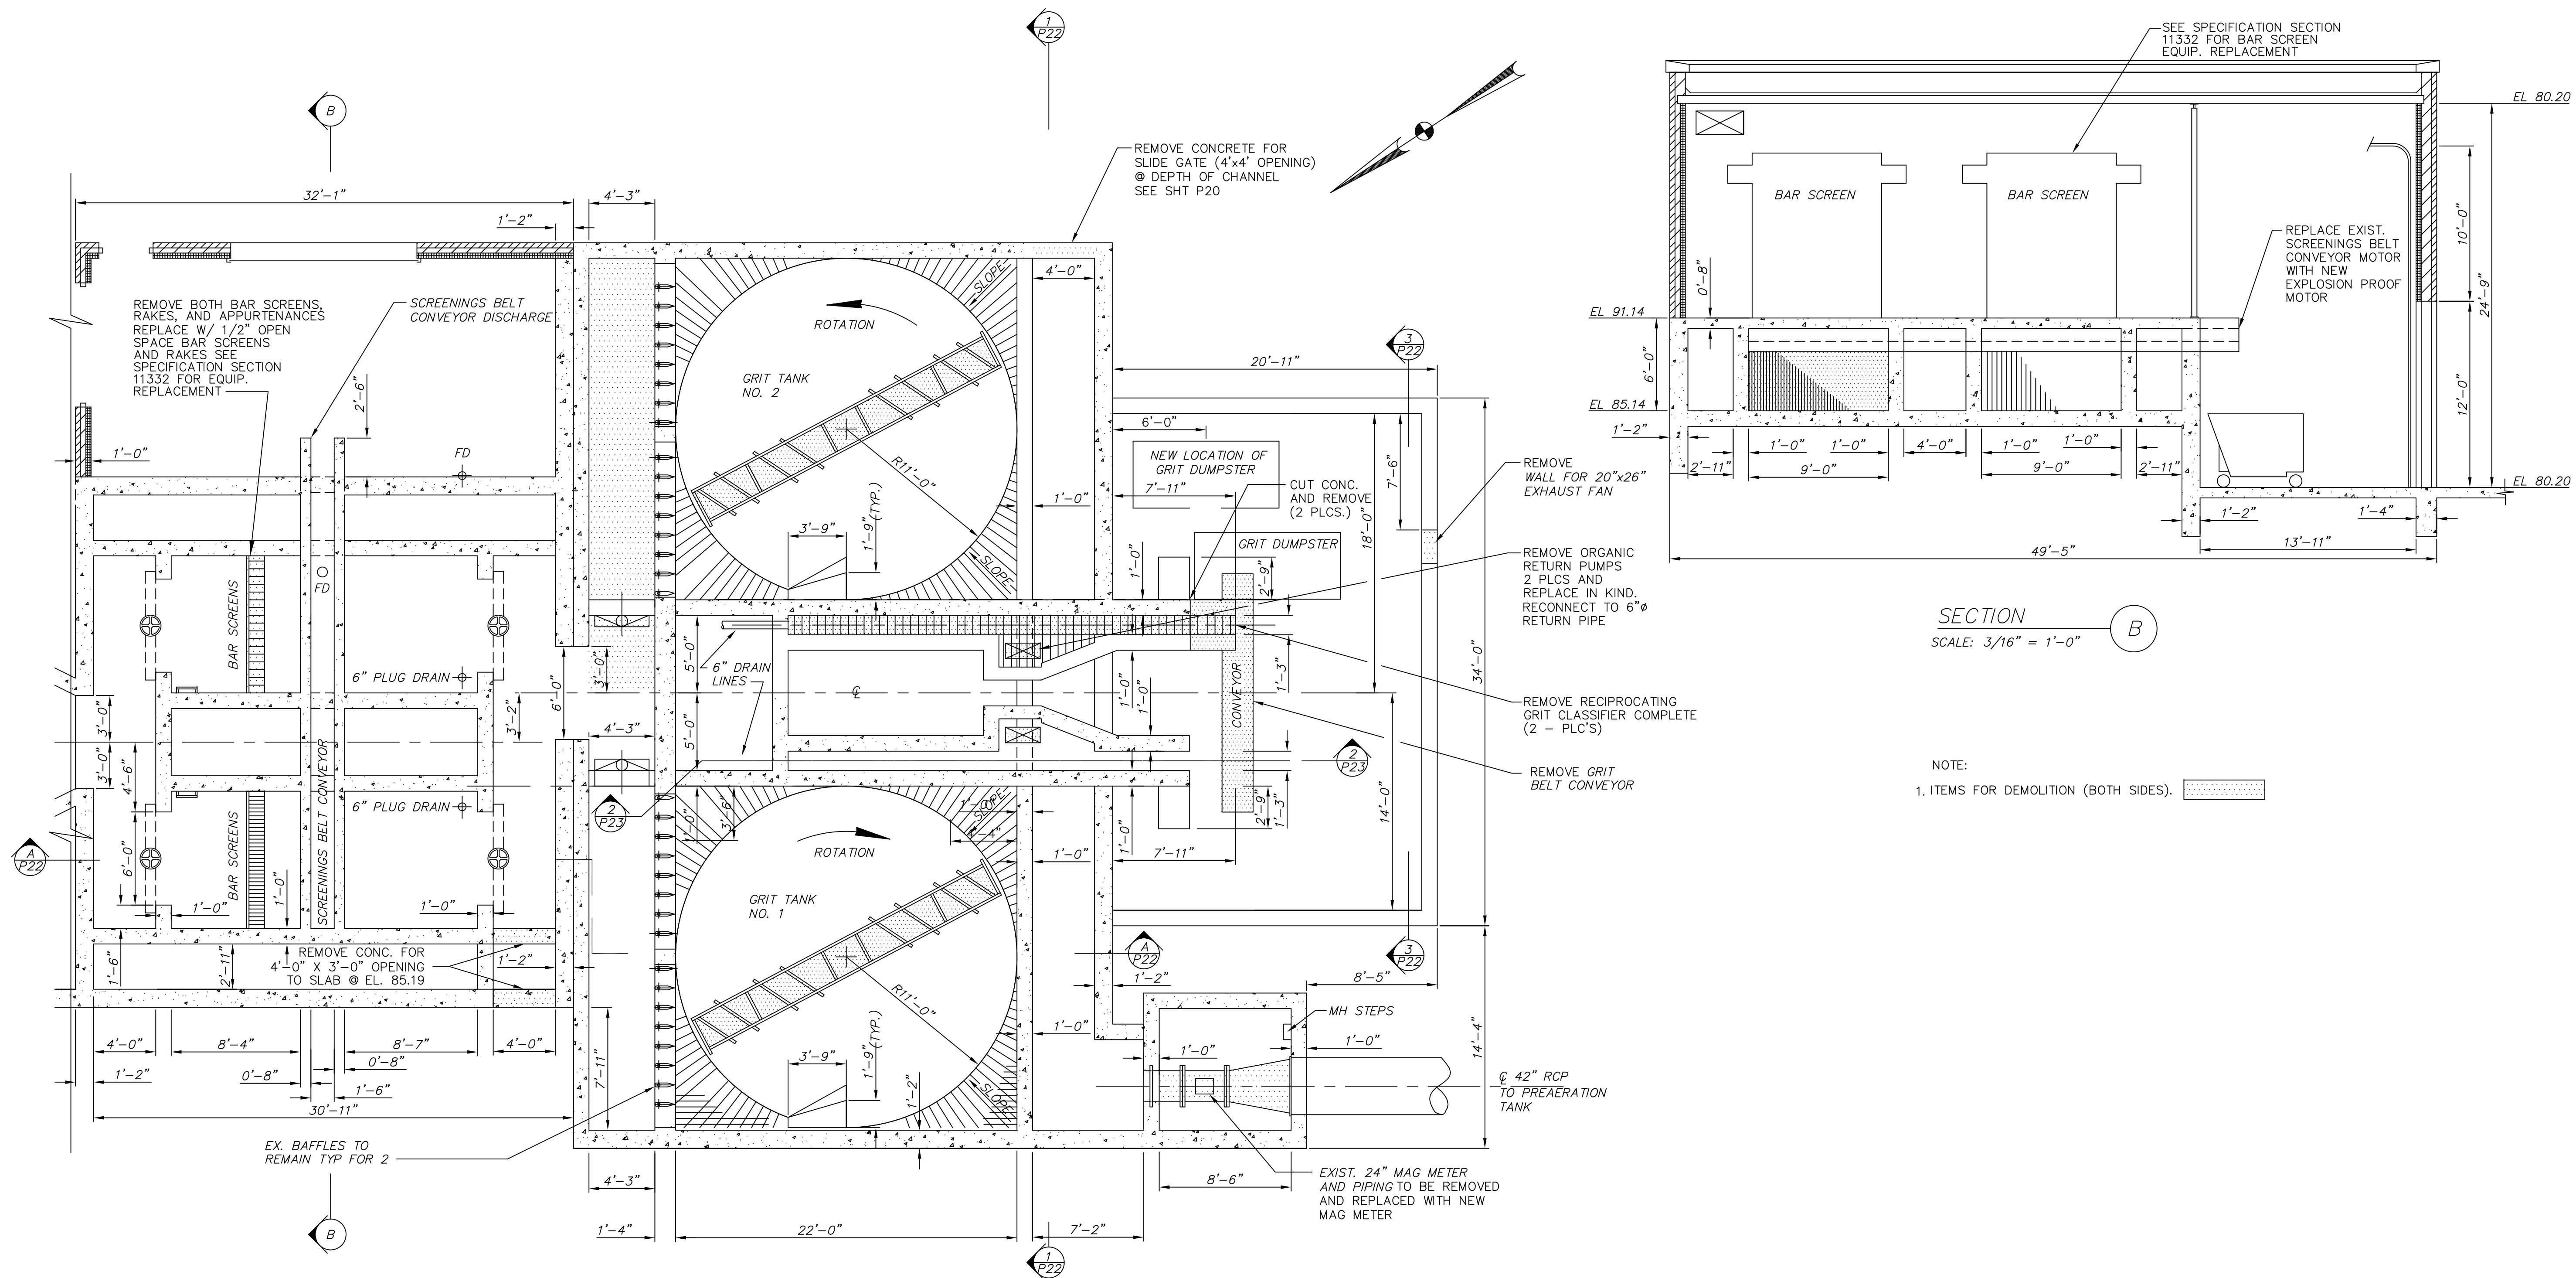

LOWER DEMOLITION PLAN
SCALE: 3/16" = 1'-0"

THESE RECORD DOCUMENTS HAVE BEEN PREPARED BASED ON INFORMATION PROVIDED BY OTHERS. CTI ENVIRONMENTAL HAS REVIEWED THE INFORMATION SUBMITTED AND BELIEVES IT REFLECTS THE WORK AS CONSTRUCTED. HOWEVER, ALL PERSONS SHALL VERIFY INFORMATION TAKEN FROM THIS DRAWING.

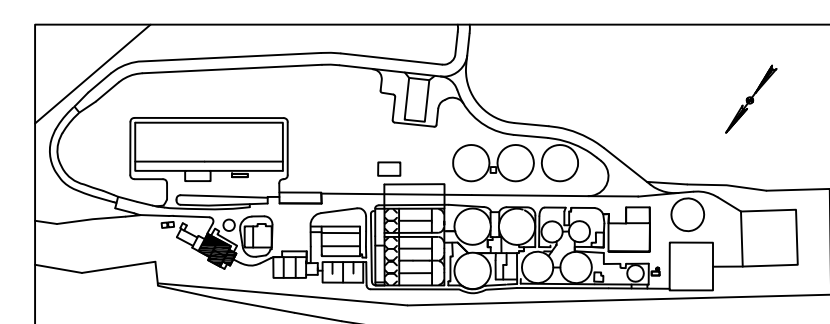

KEY PLAN

THIS DRAWING IS AN INSTRUMENT OF SERVICE OWNED BY CTI ENVIRONMENTAL, INC. WHICH SHALL BE DEEMED TO BE THE PROPERTY OF CTI ENVIRONMENTAL, INC. AND NO PART OF THIS DRAWING SHALL BE REPRODUCED, COPIED, OR TRANSMITTED IN ANY FORM OR BY ANY MEANS, WITHOUT THE WRITTEN CONSENT OF CTI ENVIRONMENTAL, INC. ANY UNAUTHORIZED REPRODUCTION OF THIS DRAWING IS PROHIBITED. THE ORIGINAL DRAWING SHALL BE KEPT IN THE OFFICE OF THE DESIGNER. A TRUE COPY OF THE ORIGINAL SHALL BE KEPT IN THE OFFICE OF THE DESIGNER.

DESIGNED BY		REVISIONS		DATE		BY	
RNF		DESCRIPTIONS		1/28		MGW	
SAT		RECORD DRAWING				WAD	
1							

CTI ENVIRONMENTAL, INC.
ENGINEERS IN WATER AND EARTH SCIENCES
UNIONTOWN, OHIO

CITY OF MASSILLON, OHIO
WWTP UPGRADE 2000

MECHANICAL BAR SCREEN AND GRIT CHAMBER LOWER DEMOLITION

JOB NO. E9031
DATE 08/13/01
SCALE AS NOTED
SHEET P18