



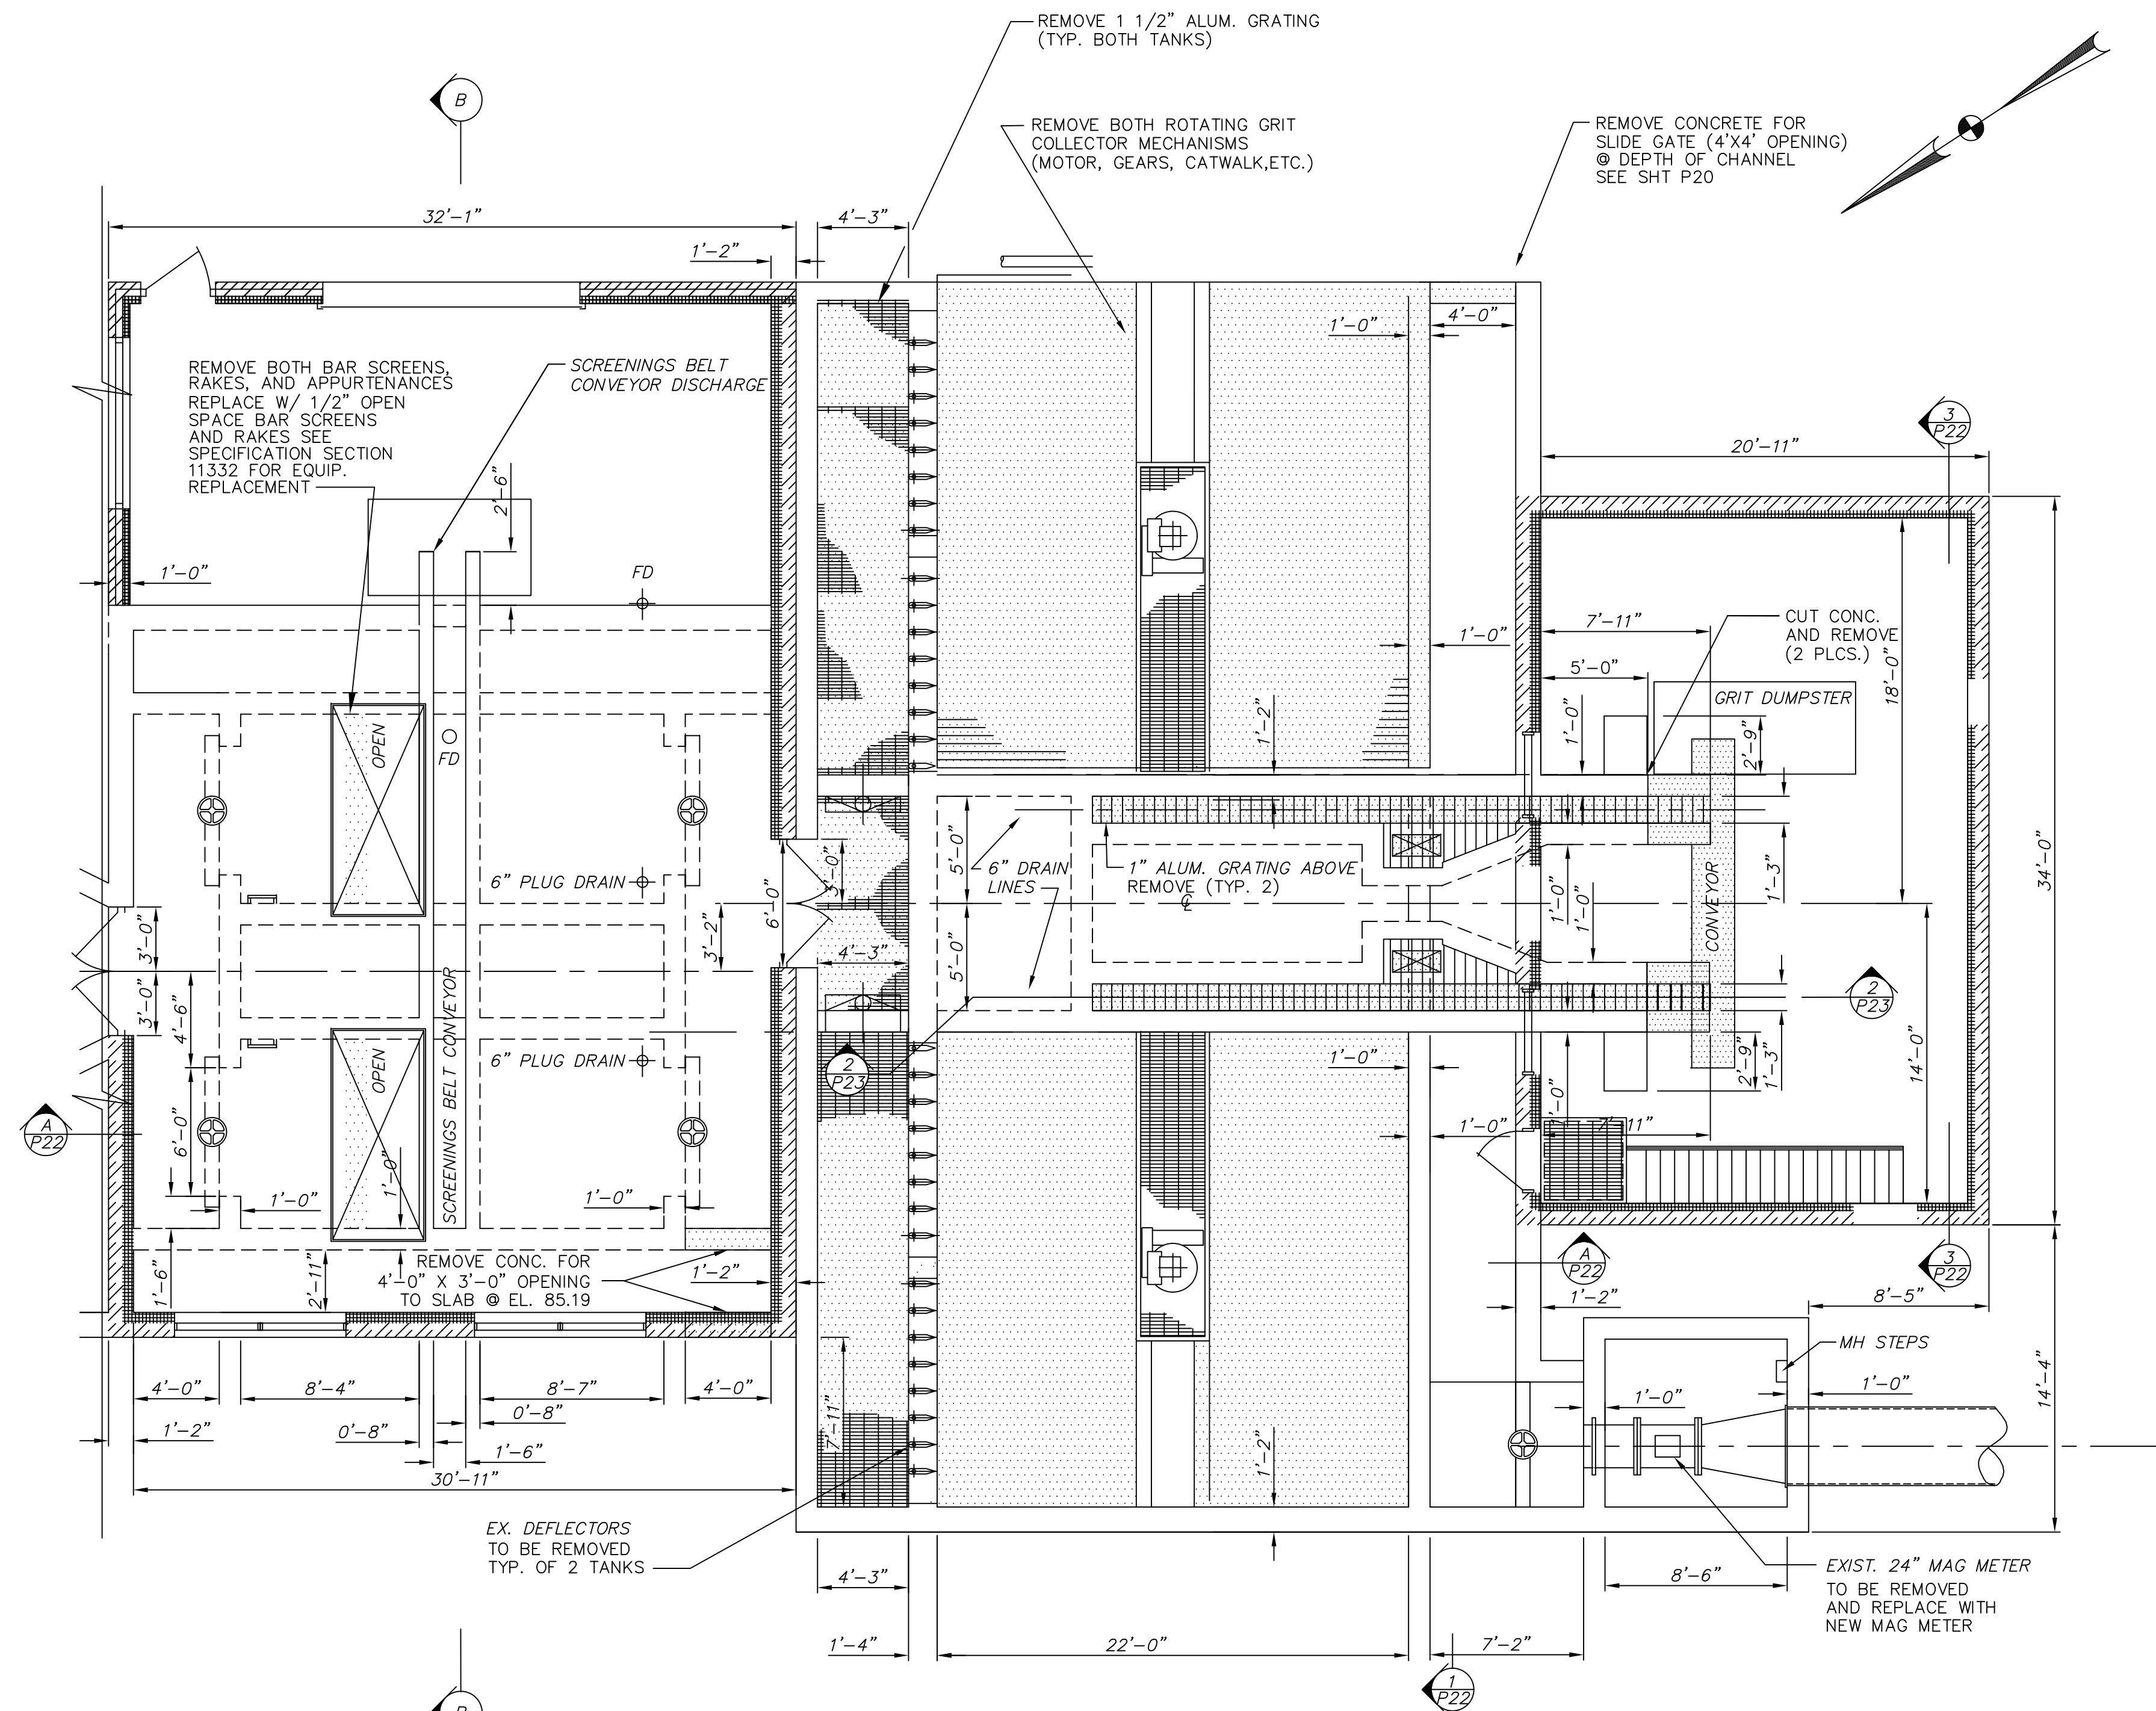


UPPER PLAN
SCALE: 3/16" = 1'-0"

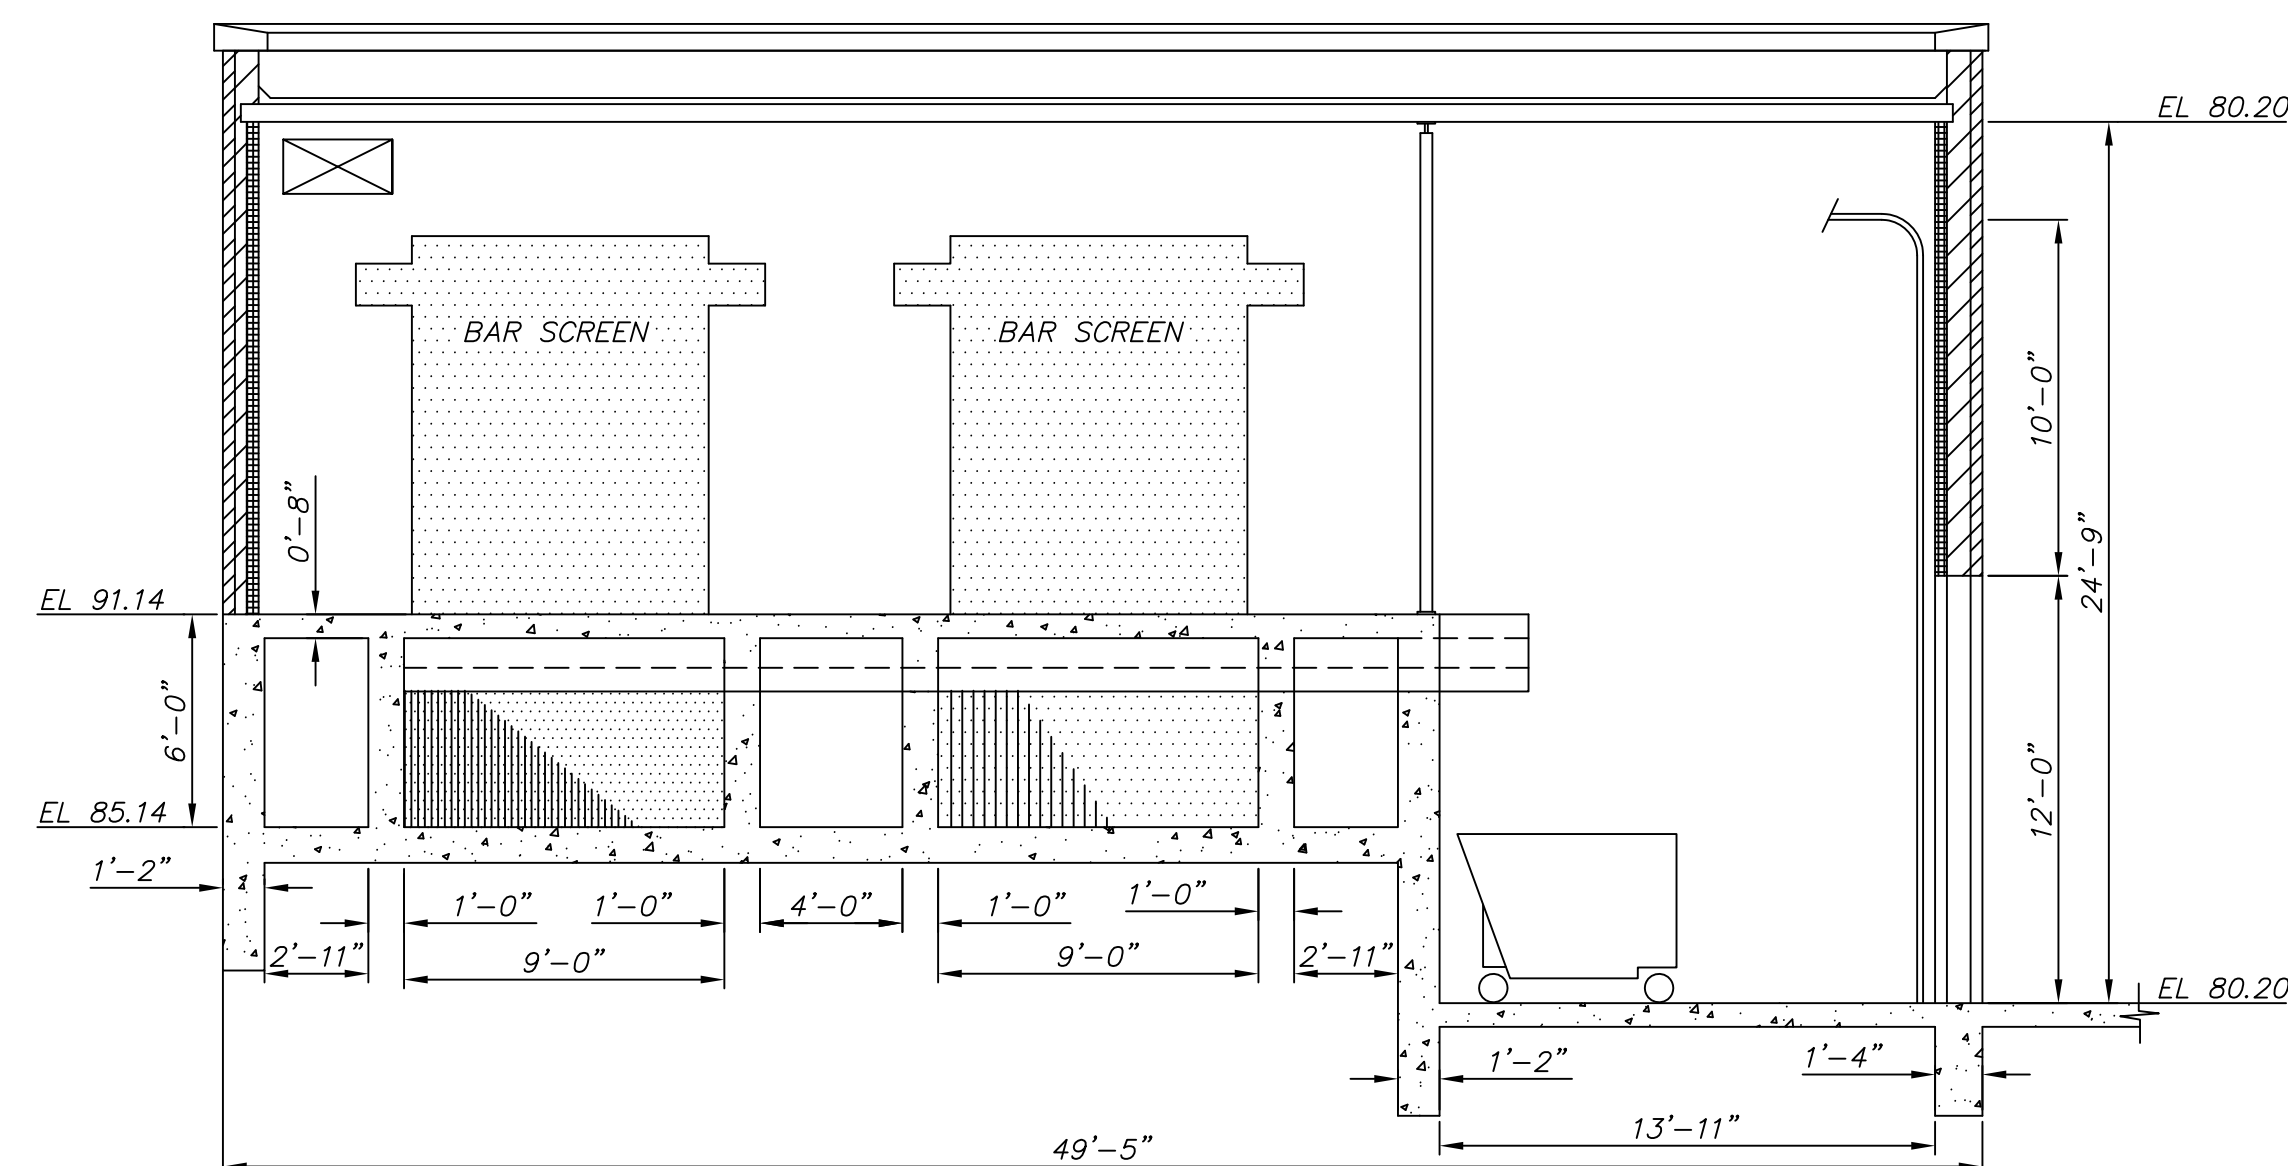

SECTION B-B
SCALE: 3/16" = 1'-0"

NOTE:
1. ITEMS FOR DEMOLITION (BOTH SIDES).

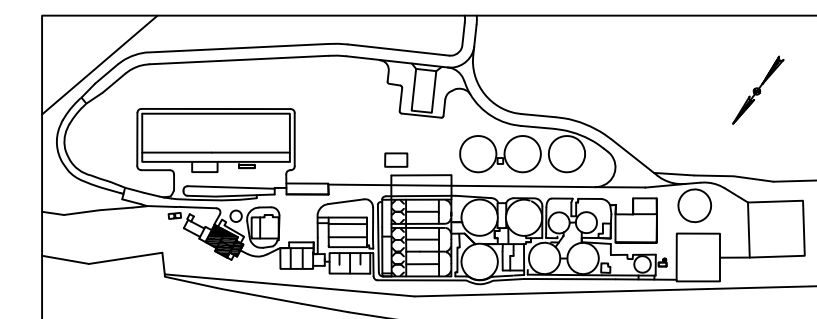

KEY PLAN

THESE RECORD DOCUMENTS HAVE BEEN PREPARED
BASED ON INFORMATION PROVIDED BY OTHERS. CTI
ENVIRONMENTAL HAS REVIEWED THE INFORMATION
SUBMITTED AND BELIEVES IT REFLECTS THE WORK AS
CONSTRUCTED. HOWEVER, ALL PERSONS SHALL
VERIFY INFORMATION TAKEN FROM THIS DRAWING.

THIS DRAWING IS AN INSTRUMENT OF SERVICE OWNED
BY CTI ENVIRONMENTAL, INC. WHICH SHALL BE
REPRODUCED OR TRANSMITTED IN ANY FORM OR
BY ANY MEANS, ELECTRONIC OR MECHANICAL,
INCLUDING PHOTOCOPYING, RECORDING, OR
ANY INFORMATION STORAGE AND RETRIEVAL
SYSTEM, WITHOUT THE WRITTEN CONSENT OF
CTI ENVIRONMENTAL, INC. ANY SUCH
REPRODUCTION OR TRANSMISSION WITHOUT
THE WRITTEN CONSENT OF CTI ENVIRONMENTAL, INC.
IS PROHIBITED. THIS DRAWING IS EXACT
ELECTRONIC COPIES OF THIS DRAWING ARE
NOT TO BE USED FOR CONSTRUCTION. THE
ORIGINAL OF THIS DRAWING IS TO BE KEPT
IN THE OFFICE OF THE DESIGNER. THE
DESIGNER SHALL BE RESPONSIBLE FOR THE
COPY AND THE SEALED ORIGINAL. THE SEALED ORIGINAL
SHALL COVER.

REVISIONS			
NO.	DESCRIPTIONS	DATE	BY
1	RECORD DRAWING	1/31	MGW
			WAD

DESIGNED BY RNF	DATE 1/31	BY MGW	WAD
DRAWN BY SAT			
CHECKED BY MGW			
APPROVED BY WAD			

JOB NO. E9031
DATE 07/06/01
SCALE AS NOTED
SHEET P19

CTI ENVIRONMENTAL, INC.
ENGINEERS IN WATER AND EARTH SCIENCES
UNIONTOWN, OHIO

CITY OF MASSILLON, OHIO
WWTP UPGRADE 2000

MECHANICAL BAR SCREEN AND GRIT CHAMBER UPPER DEMOLITION