

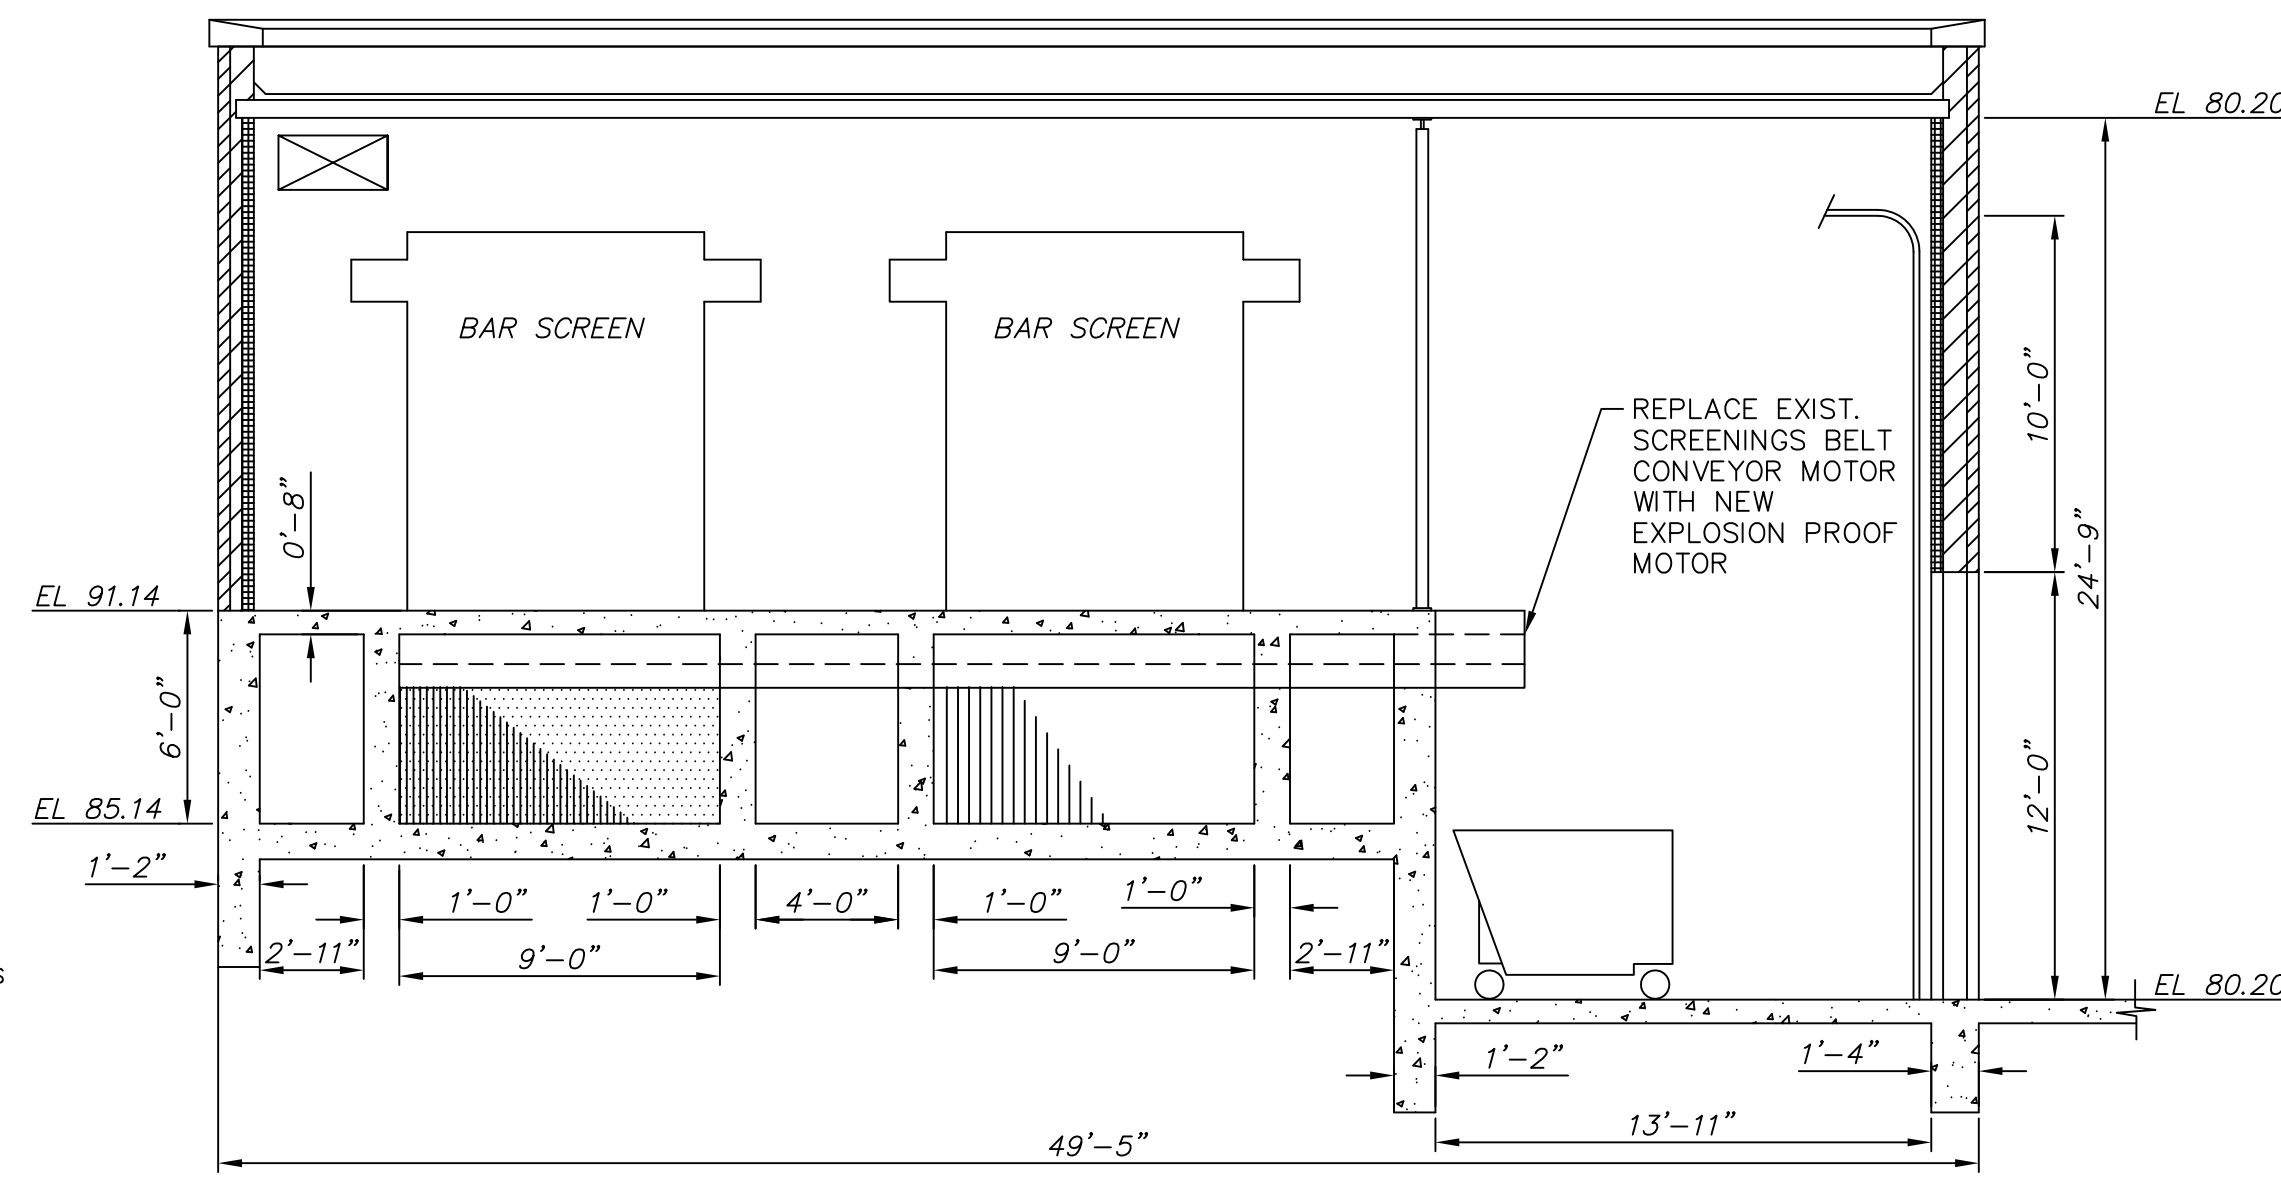


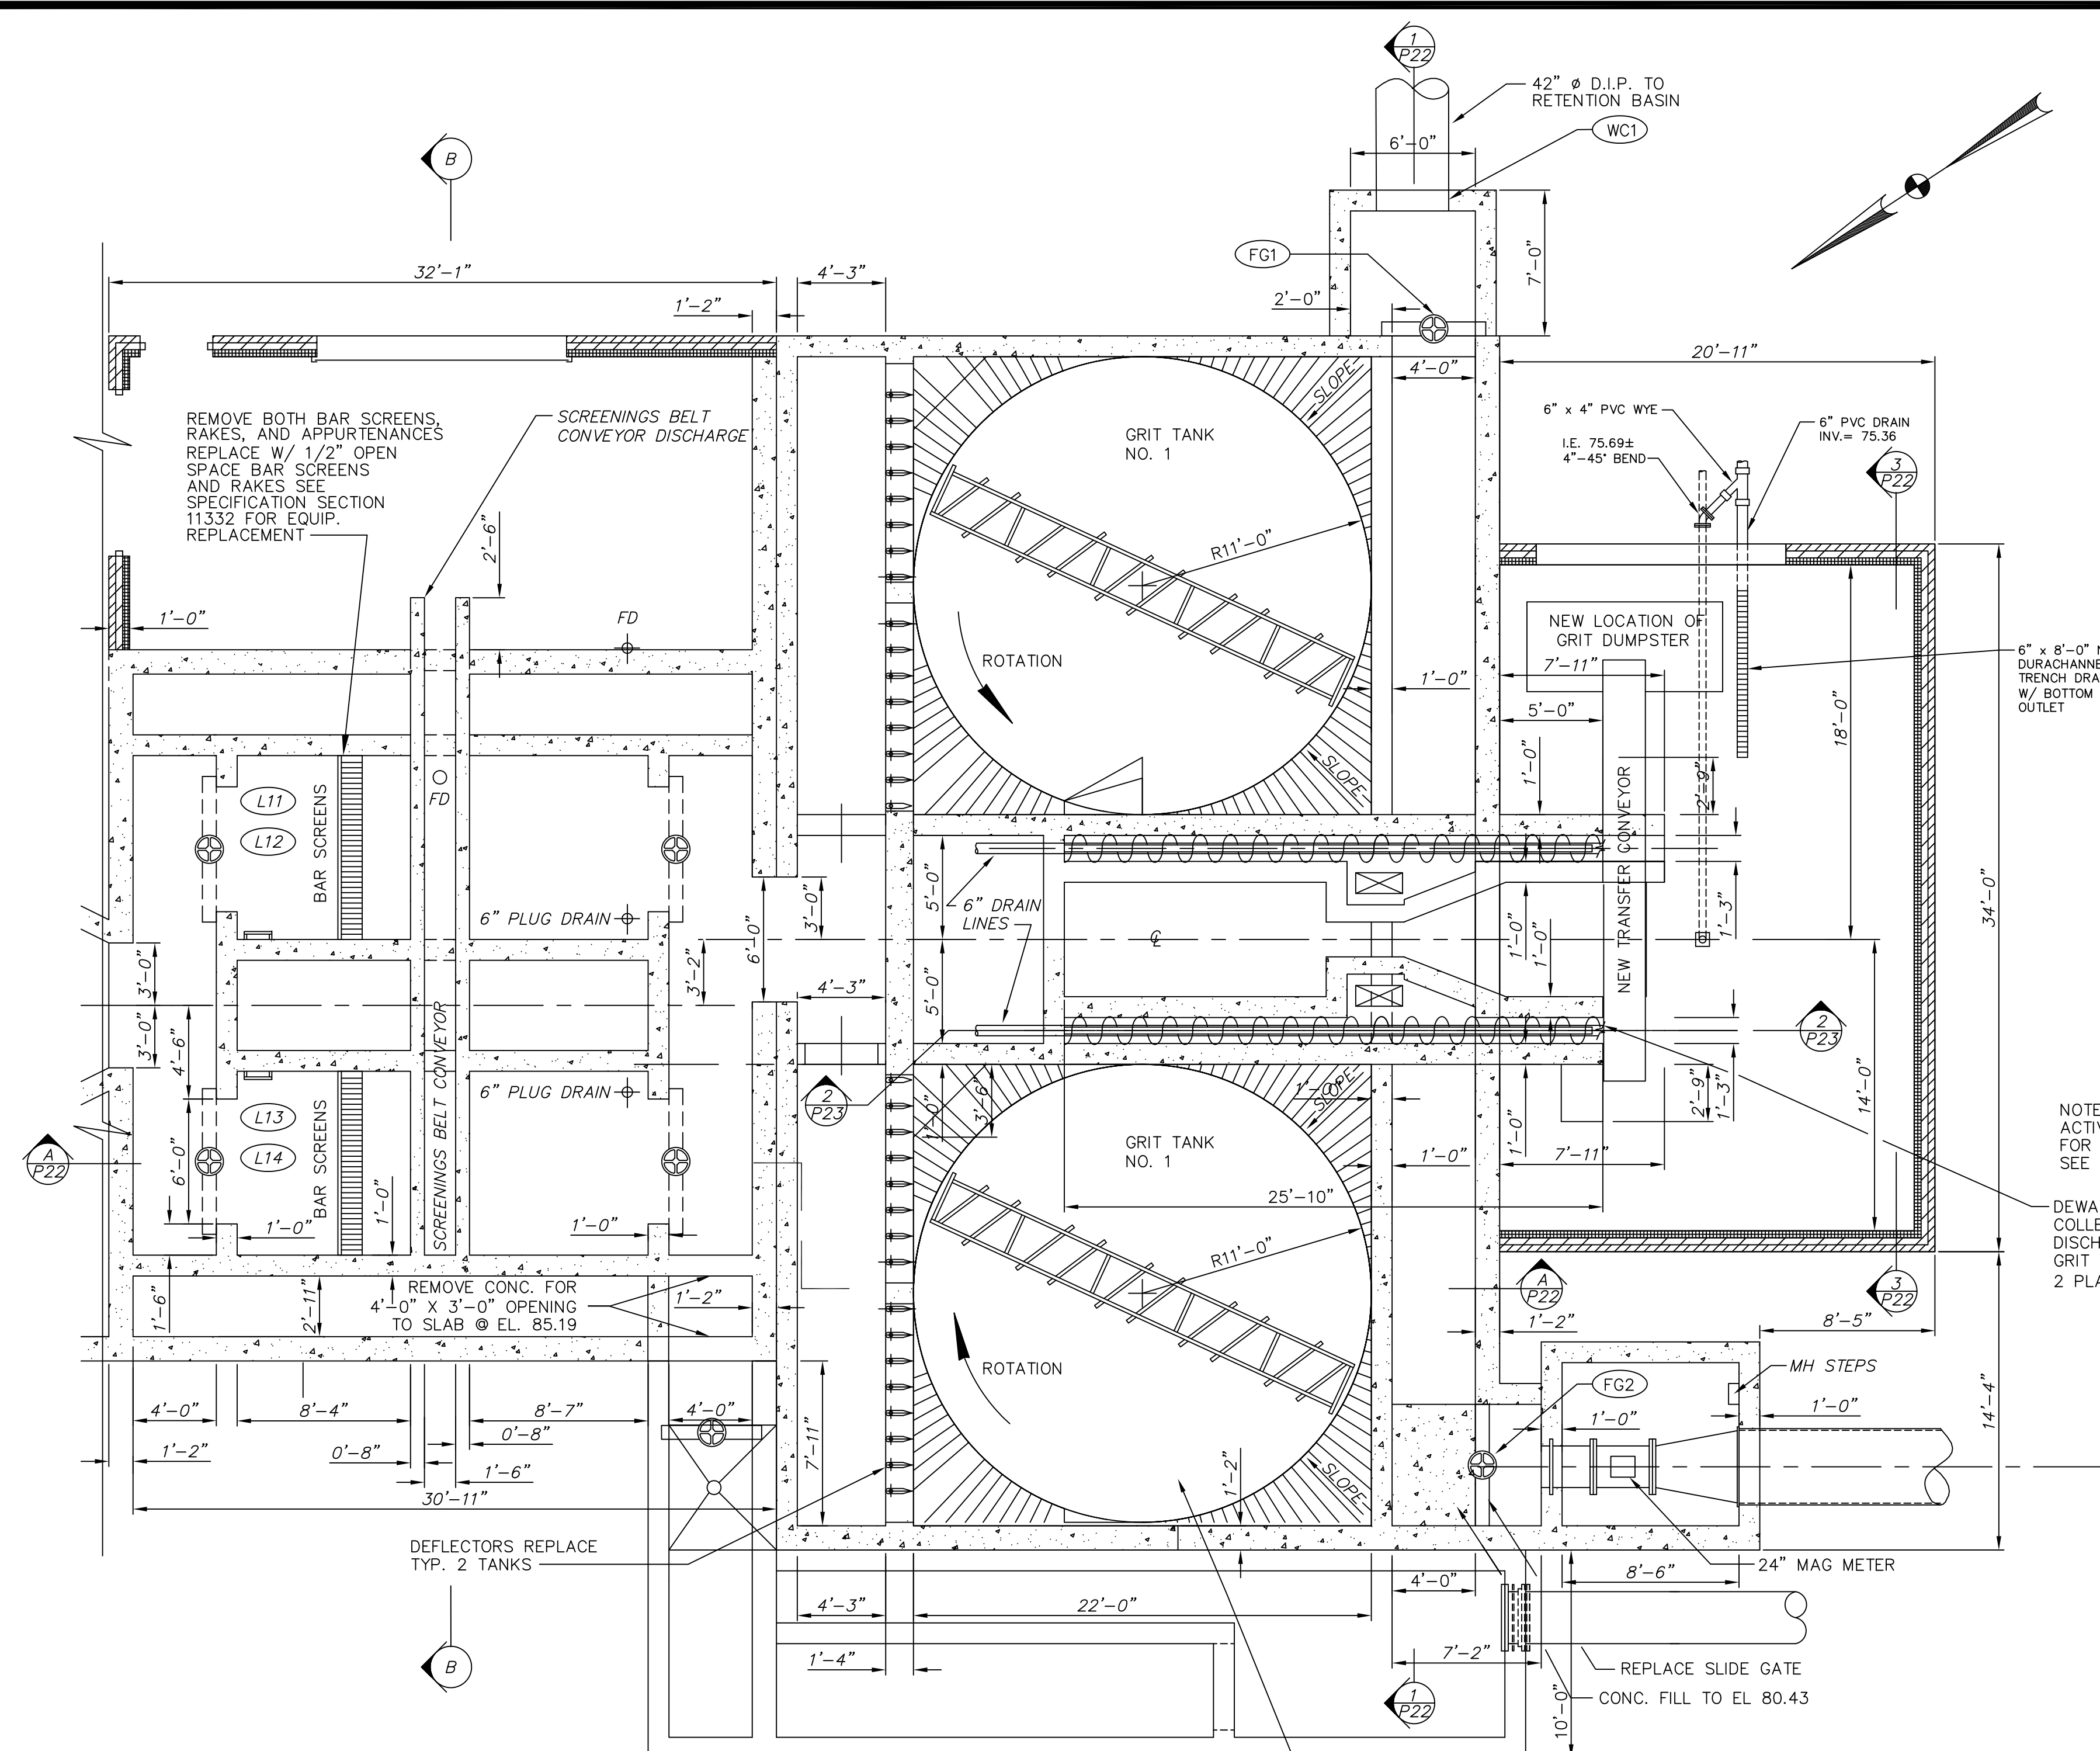


SECTION B
SCALE: 3/16" = 1'-0"

NOTE:
1. CONTRACTOR SHALL SURFACE PREP. AND PAINT ALL EXTERIOR AND INTERIOR EXIST. HANDRAIL IN THE SCREENINGS BLDG., GRIT BLDG. AND GRIT TANK AREAS SEE SPECIFICATION SECTION 09900


NOTE : TO SEE NEW ACTIVATED CARBON SYSTEM FOR HEADWORKS (GRIT BLDG.) SEE SHT. P24 THRU P26

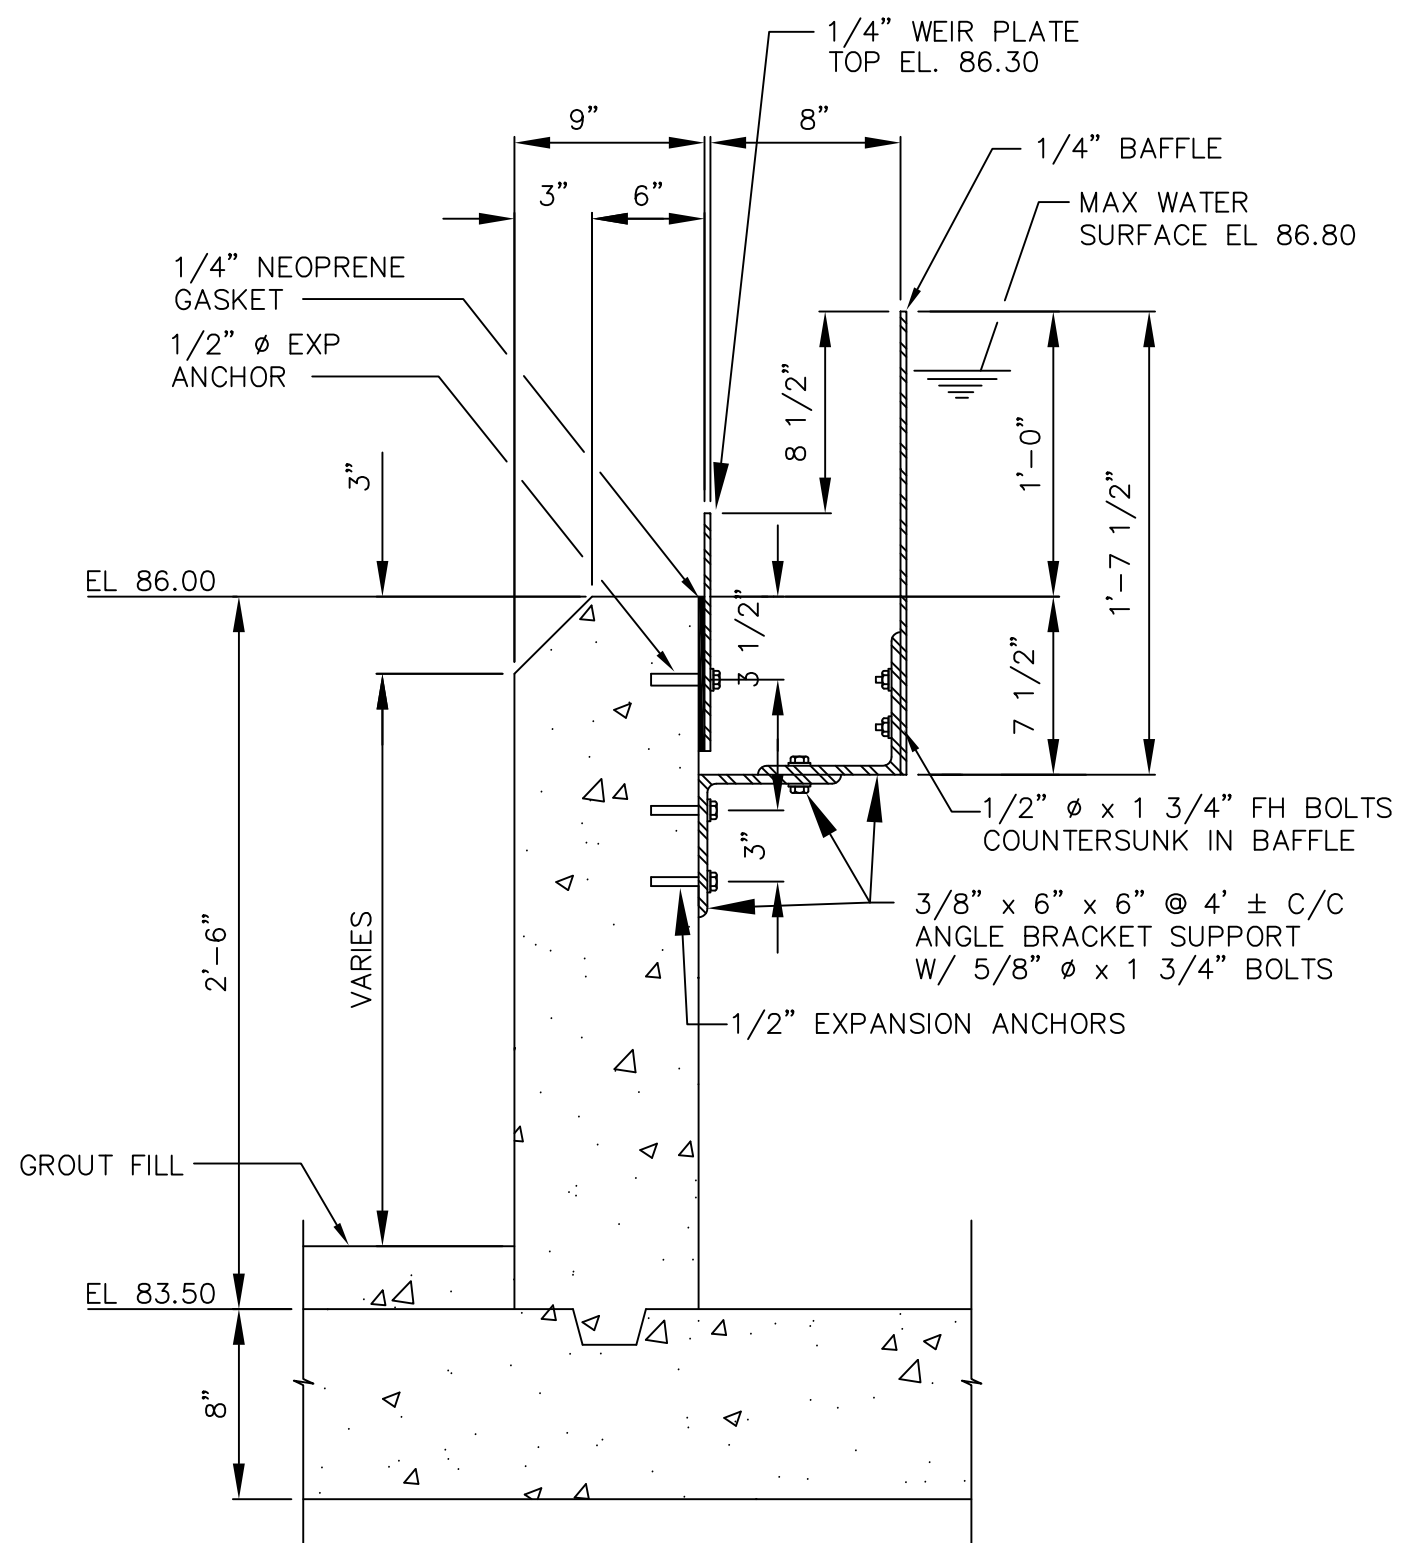

WEIR DETAIL FOR SECONDARY BYPASS
SCALE: 1/2" = 1'-0"

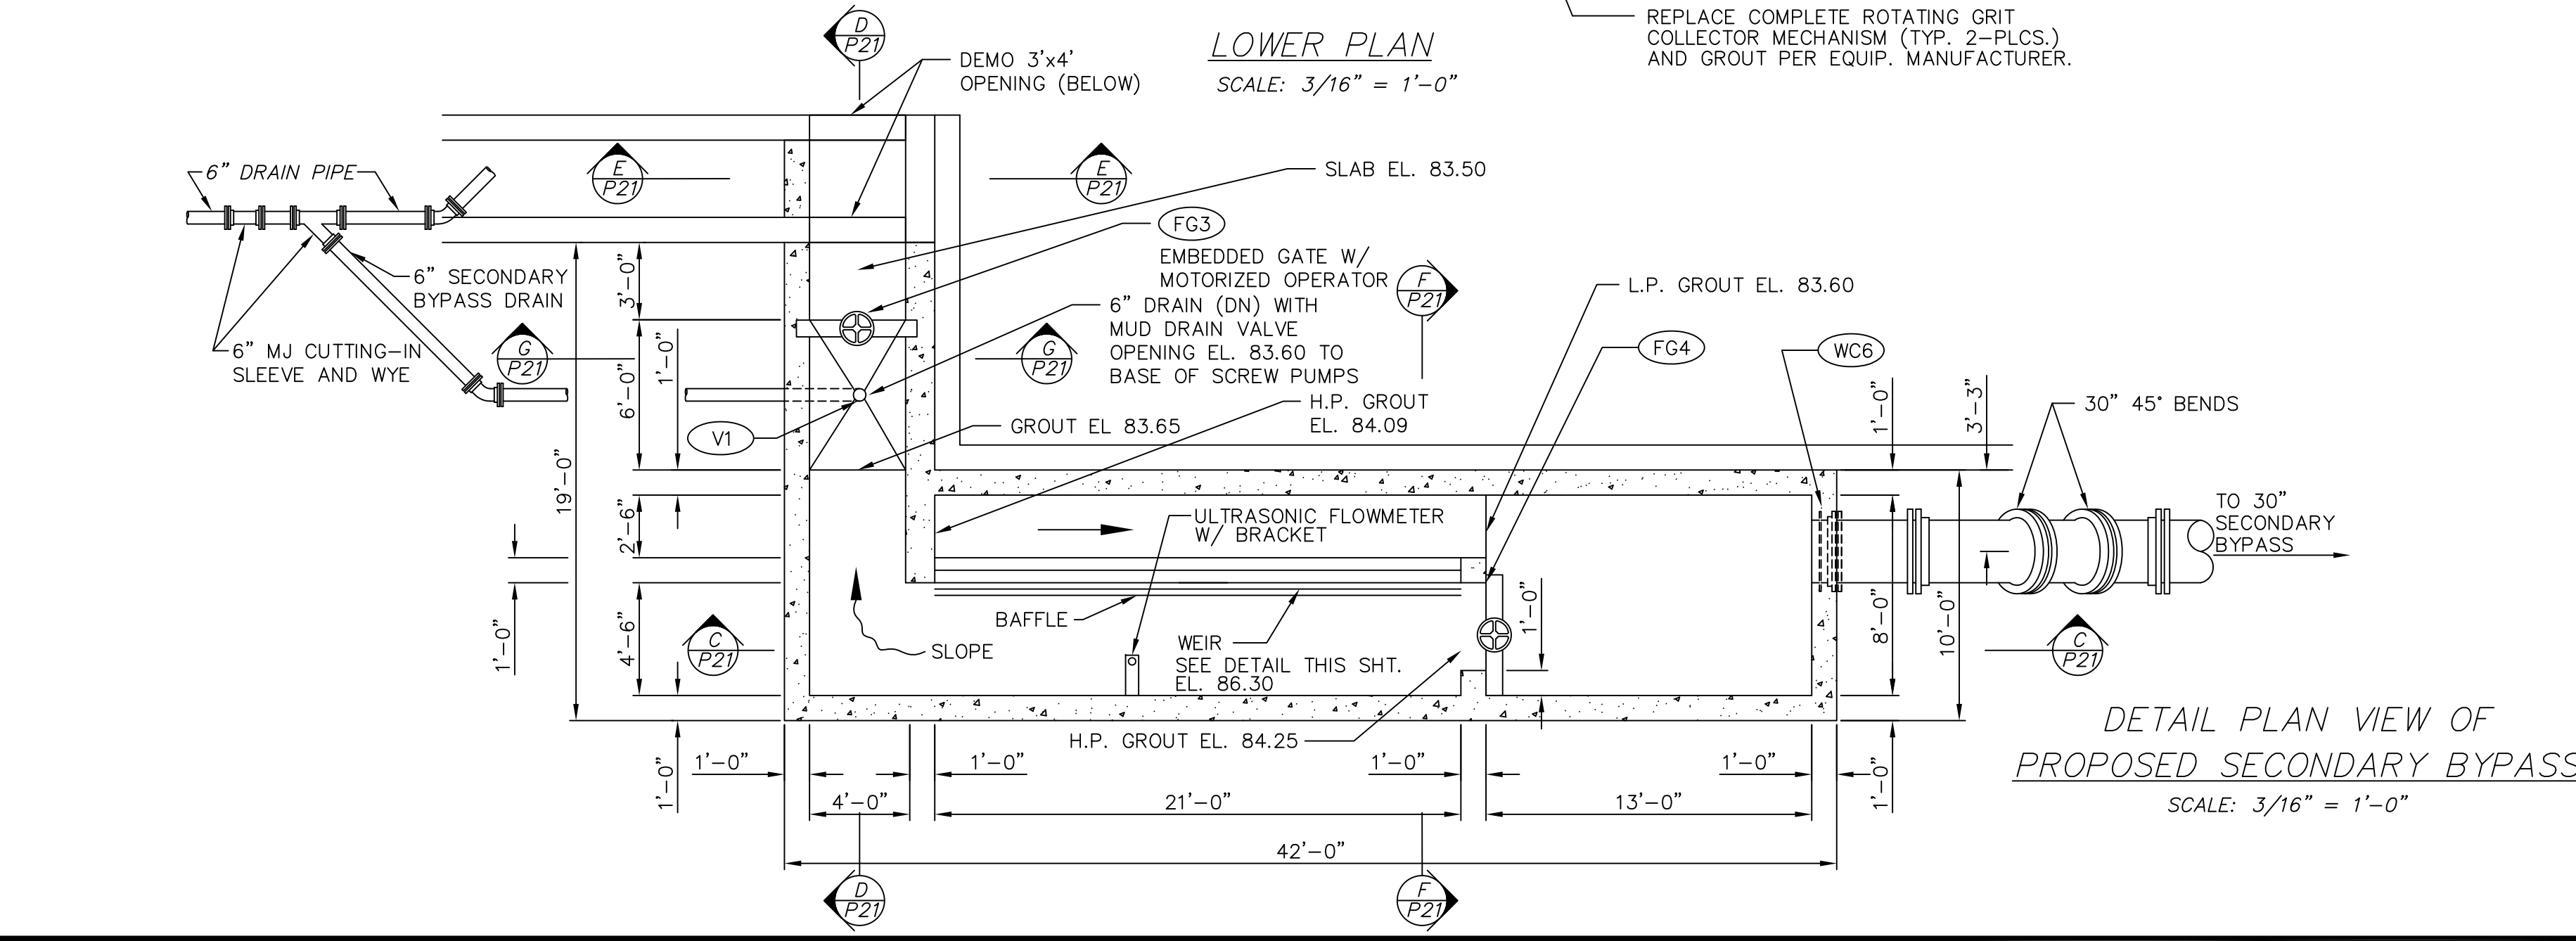

DETAIL PLAN VIEW OF PROPOSED SECONDARY BYPASS
SCALE: 3/16" = 1'-0"

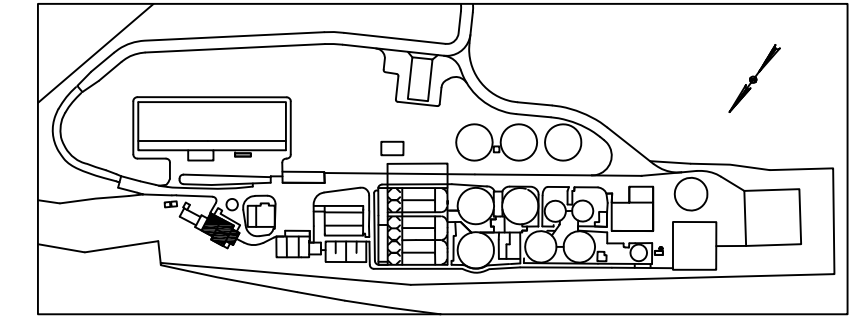

KEY PLAN

THESE RECORD DOCUMENTS HAVE BEEN PREPARED BASED ON INFORMATION PROVIDED BY OTHERS. CTI ENVIRONMENTAL HAS REVIEWED THE INFORMATION SUBMITTED AND BELIEVES IT REFLECTS THE WORK AS CONSTRUCTED. HOWEVER, ALL PERSONS SHALL VERIFY INFORMATION TAKEN FROM THIS DRAWING.

THIS DRAWING IS AN INSTRUMENT OF SERVICE OWNED BY CTI ENVIRONMENTAL, INC. WHICH SHALL BE RETURNED TO THE AUTHOR AND WHICH SHALL REMAIN THE PROPERTY OF THE AUTHOR. THIS DRAWING SHALL NOT BE REPRODUCED, COPIED, OR ADAPTED FOR ANY PURPOSE OR PROJECT WITHOUT PRIOR WRITTEN CONSENT OF CTI ENVIRONMENTAL, INC. ANY UNAUTHORIZED REPRODUCTION OR USE OF THIS DRAWING SHALL BE AT THE USER'S SOLE RISK. THE USER SHALL BE RESPONSIBLE FOR OBTAINING ALL NECESSARY PERMITS AND APPROVALS. THE USER SHALL BE RESPONSIBLE FOR OBTAINING ALL NECESSARY PERMITS AND APPROVALS. THE USER SHALL BE RESPONSIBLE FOR OBTAINING ALL NECESSARY PERMITS AND APPROVALS.

DESIGNED BY		REVISIONS		DATE		BY		APP'D	
NO.	DESCRIPTION	NO.	DESCRIPTION	DATE	BY	NO.	DESCRIPTION	DATE	BY
1	ADDENDUM NO. 1	1	ADDENDUM NO. 1	9/14	MGW	1	ADDENDUM NO. 1	9/14	MGW
2	ADDENDUM NO. 2	2	ADDENDUM NO. 2	9/28	MGW	2	ADDENDUM NO. 2	9/28	MGW
3	RECORD DRAWING	3	RECORD DRAWING	1/31	MGW	3	RECORD DRAWING	1/31	MGW

DRAWN BY		CHECKED BY		APPROVED BY	
SAT	MGW	MGW	MGW	WAD	WAD

ENVIRONMENTAL, INC.
ENGINEERS IN WATER AND EARTH SCIENCES
UNIONTOWN, OHIO

CITY OF MASSILLON, OHIO
WWTP UPGRADE 2000
MECHANICAL BAR SCREEN AND GRIT
CHAMBER MODIFICATIONS LOWER PROPOSED

JOB NO.
E9031
DATE
08/13/01
SCALE
AS NOTED
SHEET
P20