




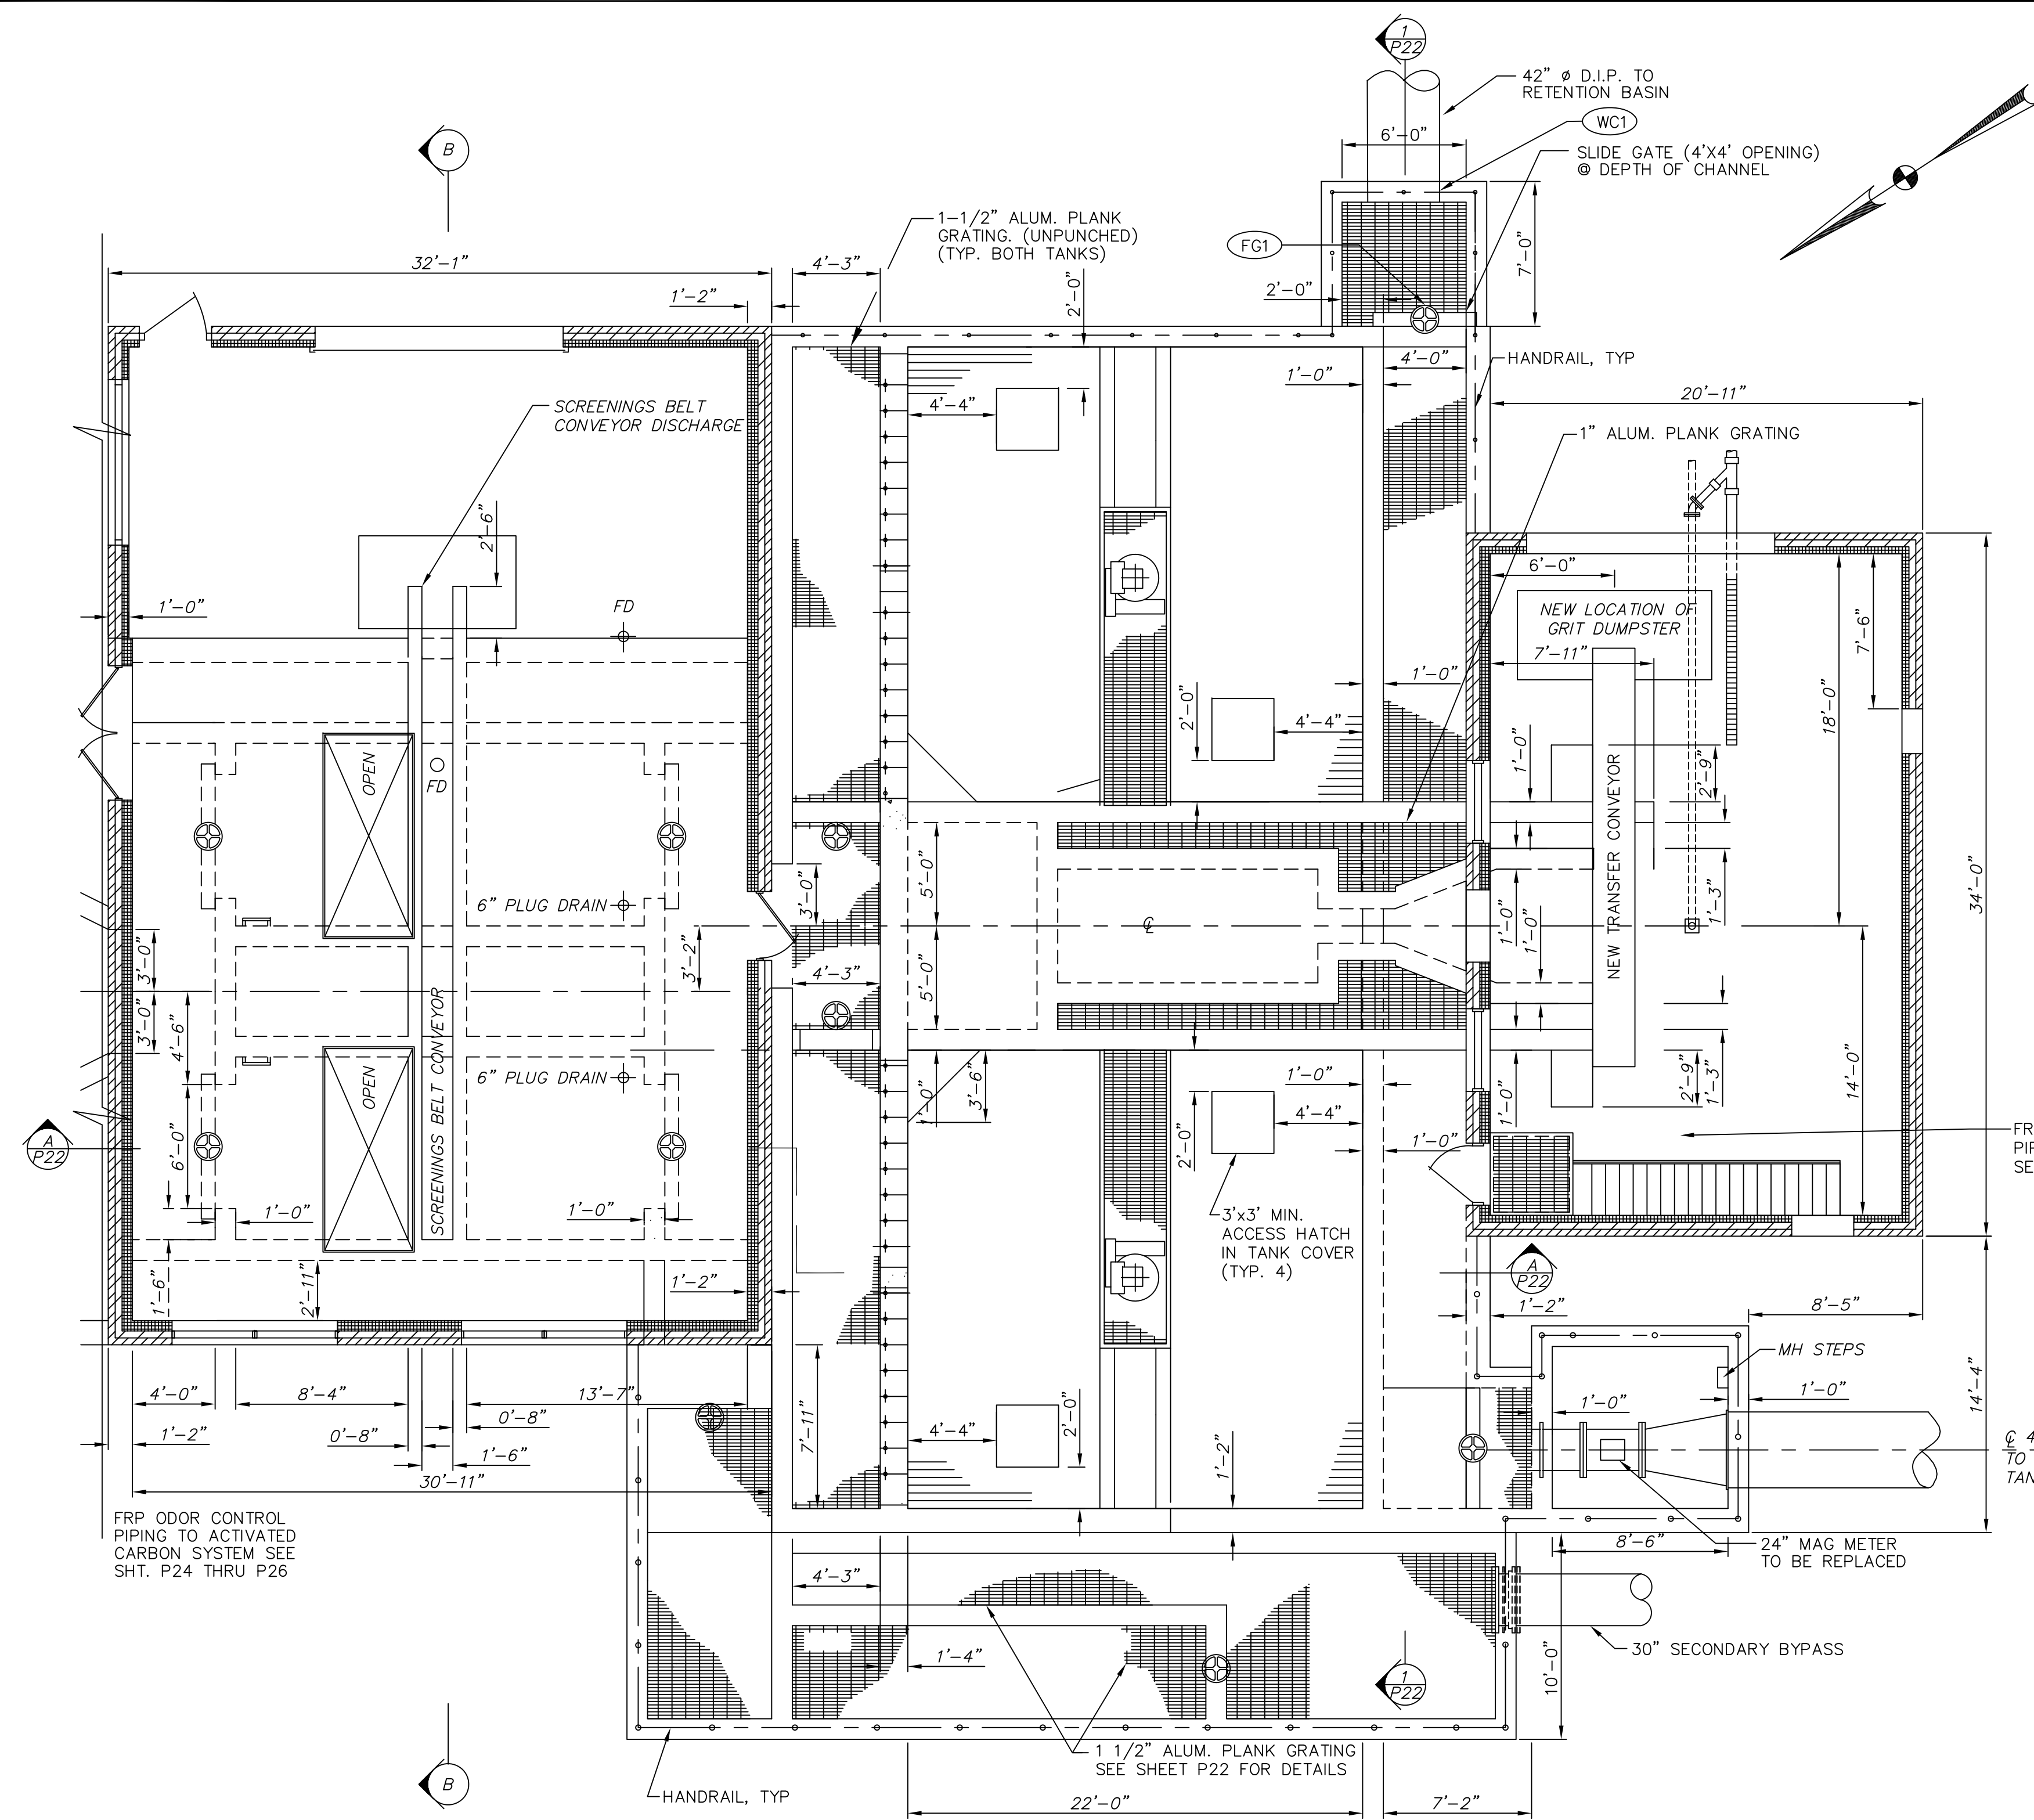


UPPER PLAN
SCALE: 3/16" = 1'-0"

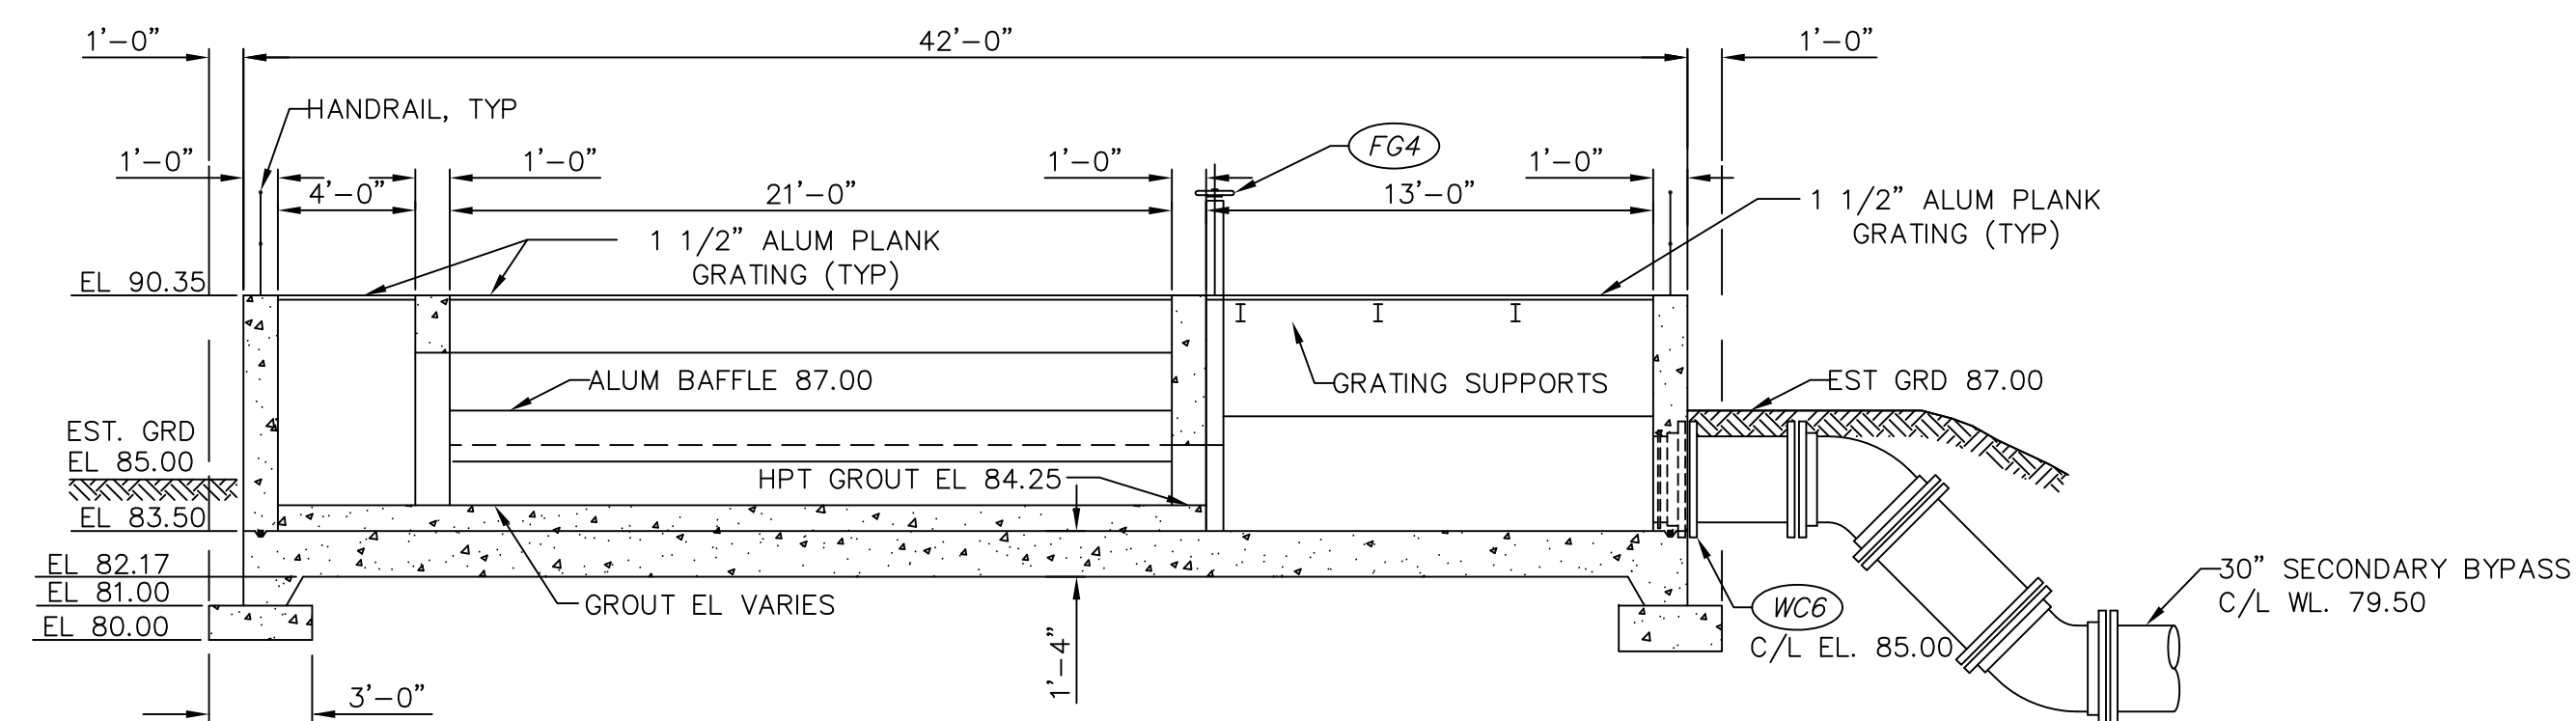

SECTION C
SCALE: 3/16" = 1'-0" P20

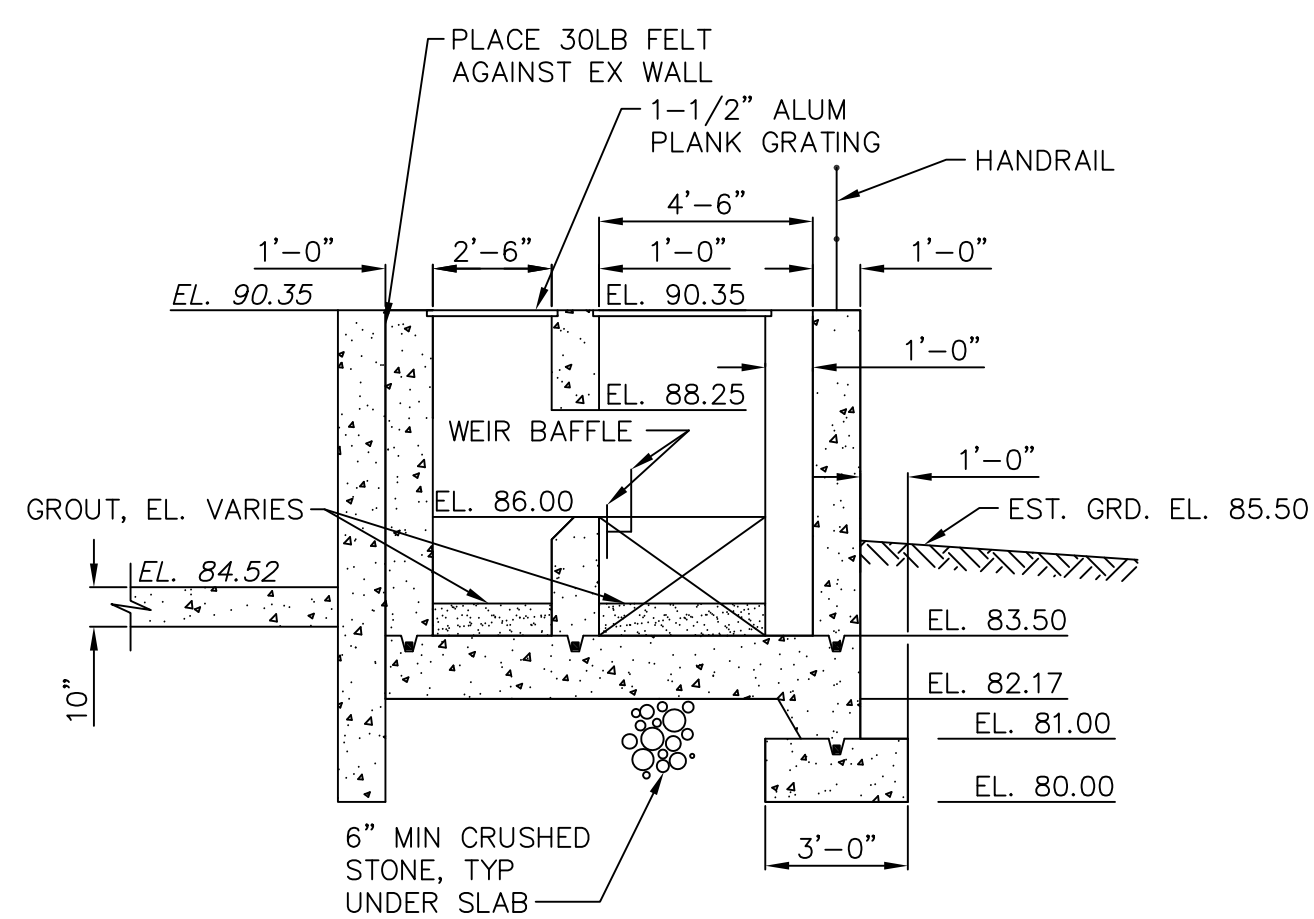


SECTION F
SCALE: 1/4" = 1'-0" P20

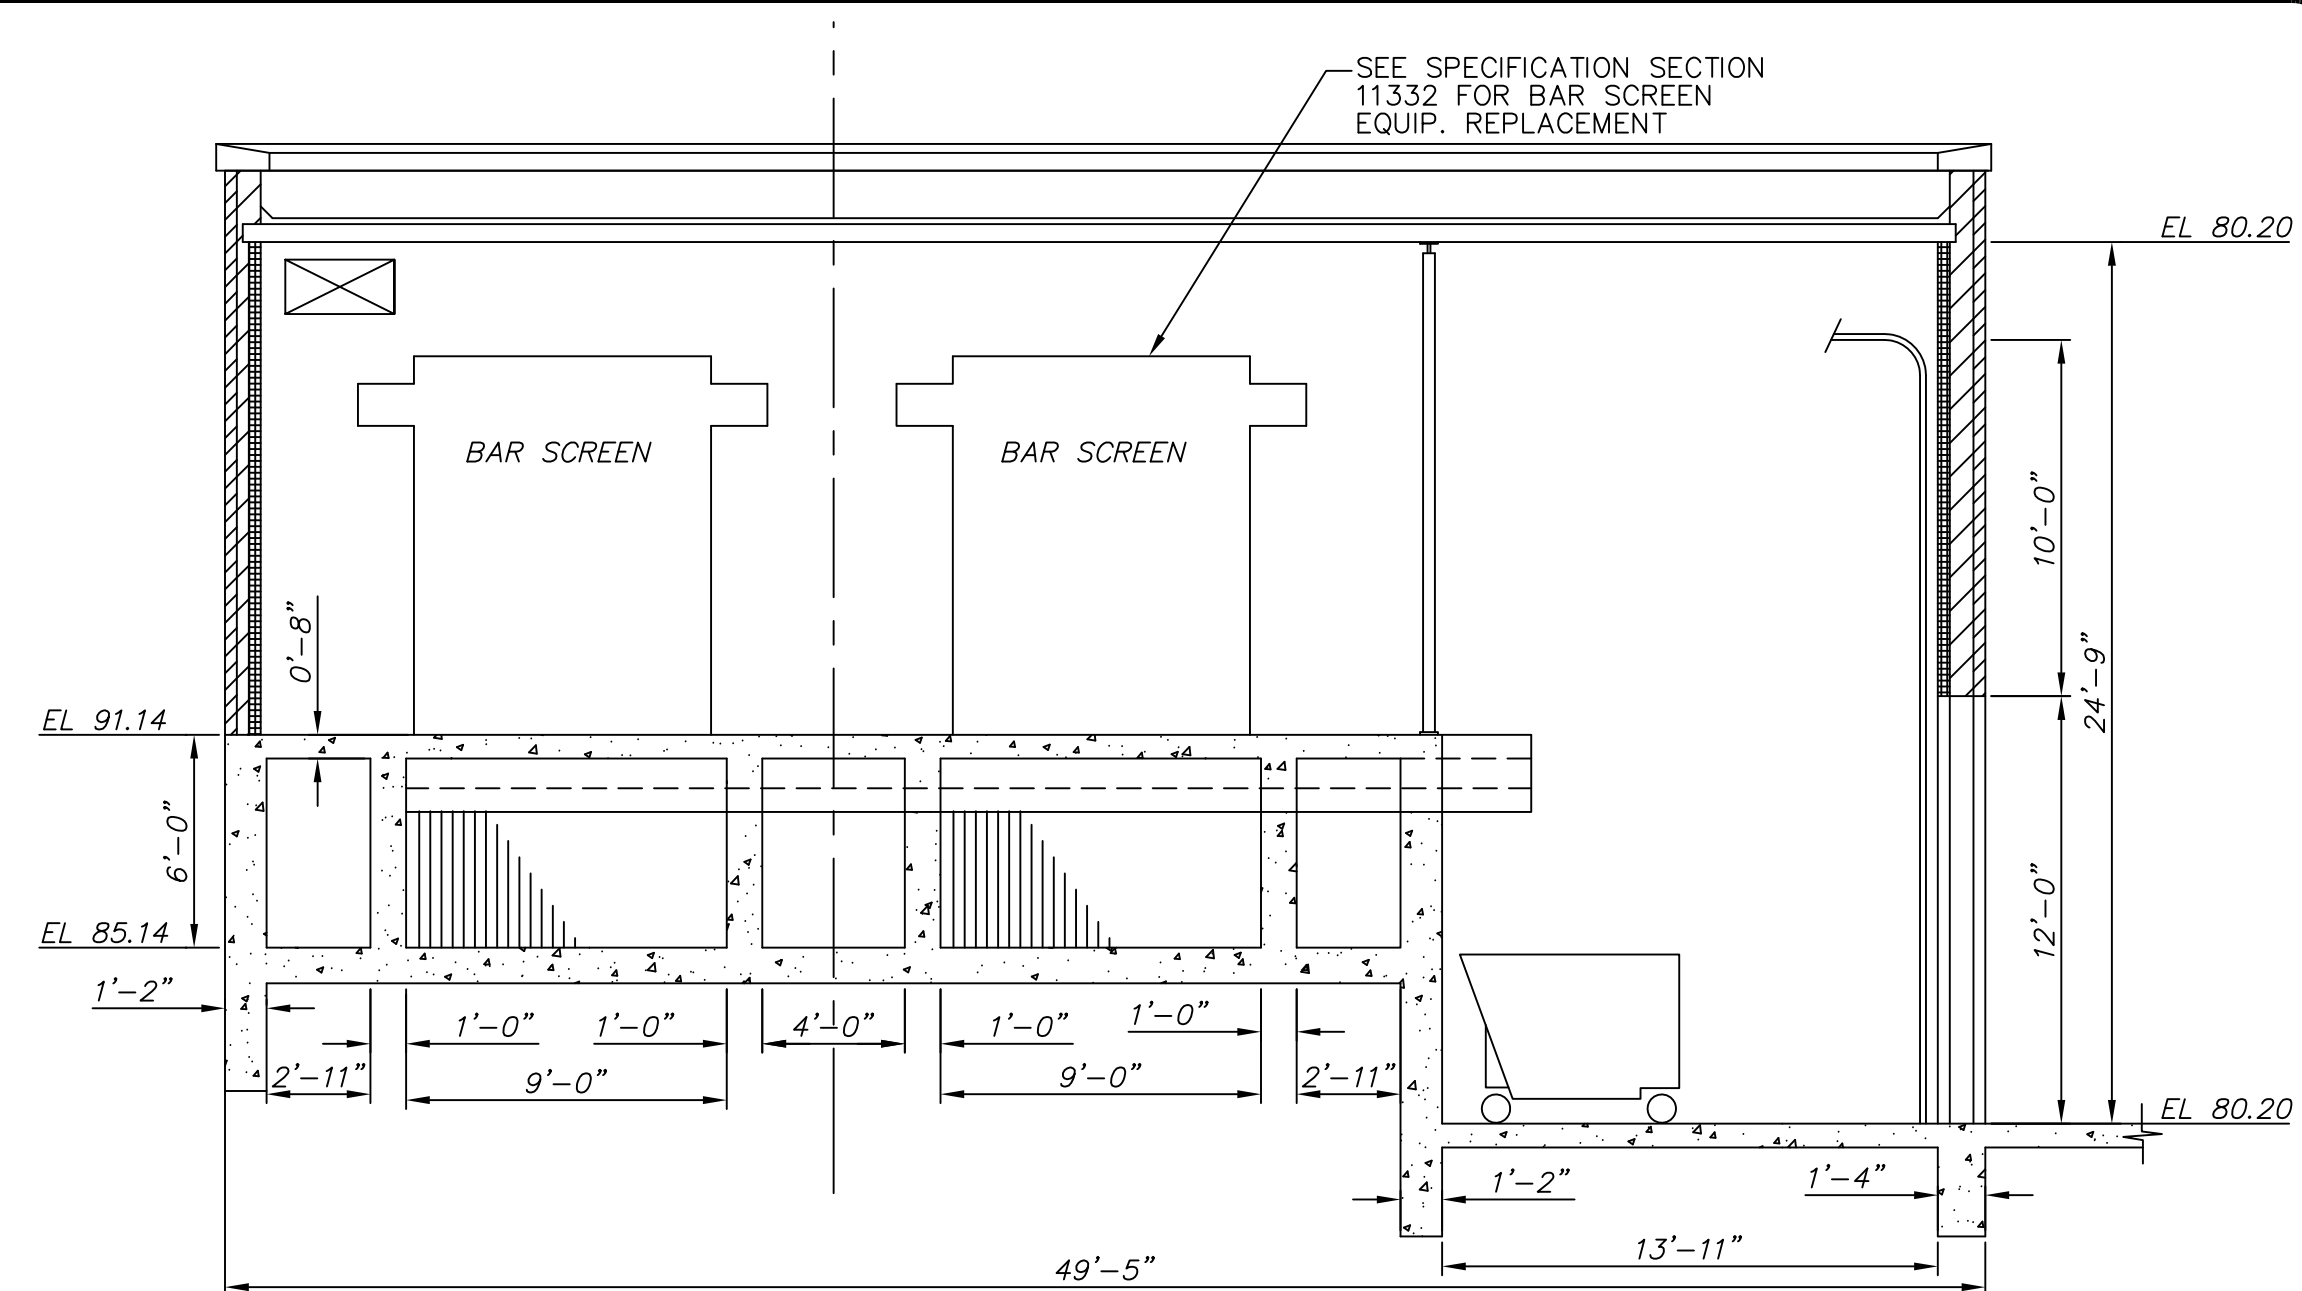


SECTION B
SCALE: 3/16" = 1'-0" P20


- NOTES:
- CONTRACTOR SHALL SURFACE PREP. AND PAINT ALL EXTERIOR AND INTERIOR EXIST. HANDRAIL IN THE SCREENINGS BLDG., GRIT BLDG. AND GRIT TANK AREAS SEE SPECIFICATION SECTION 09900
 - CONTRACTOR SHALL PROVIDE HANDRAIL AT PERIMETER WALLS FOR SECONDARY BYPASS. TERMINATE AT BRICK MASONRY FOR BAR SCREEN ROOM AND VAULT 24\"/>

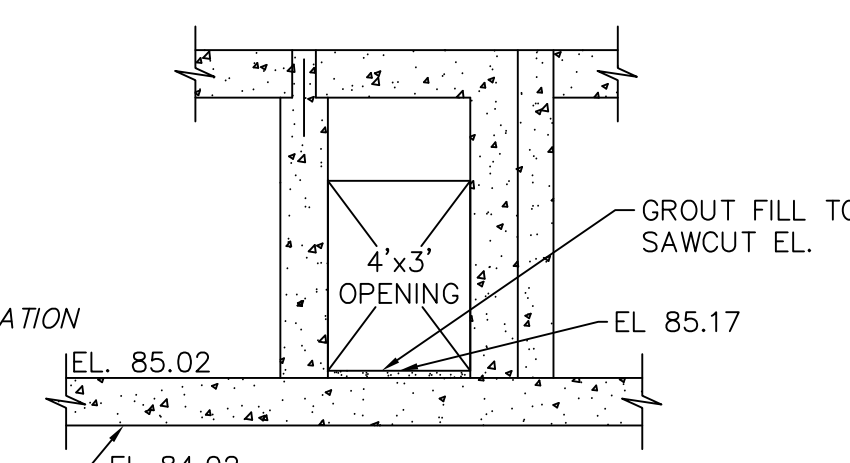


SECTION E
SCALE: 1/4" = 1'-0" P20

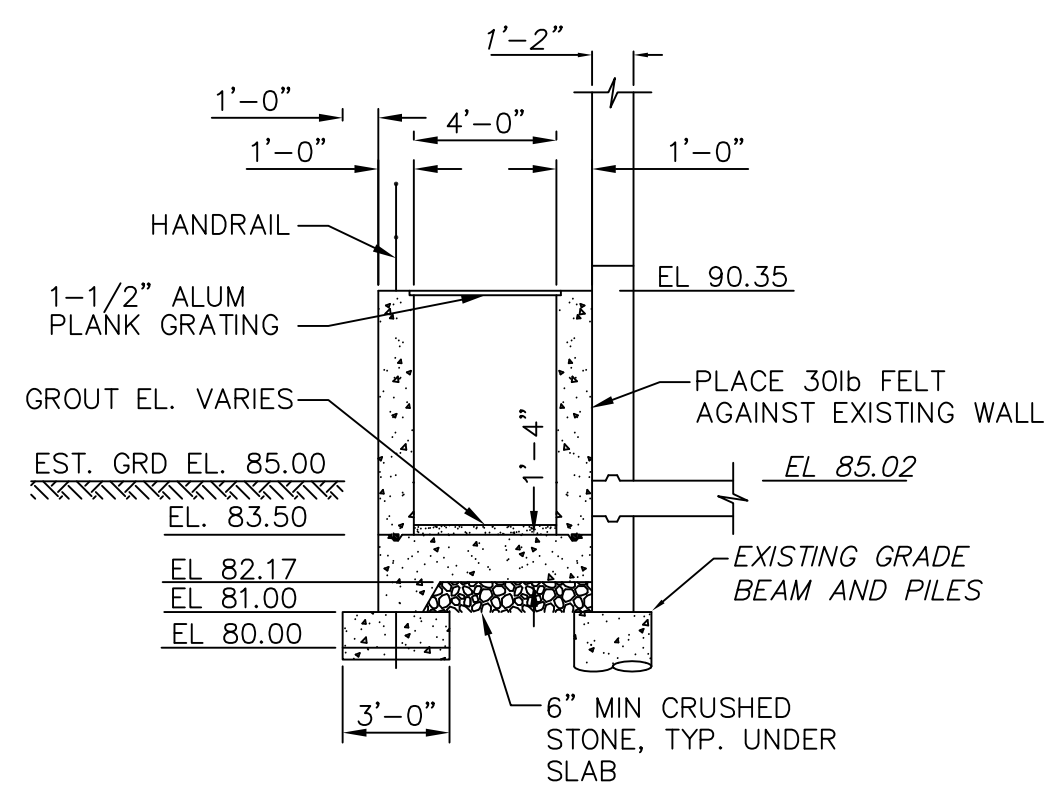

SECTION G
SCALE: 3/16" = 1'-0" P20

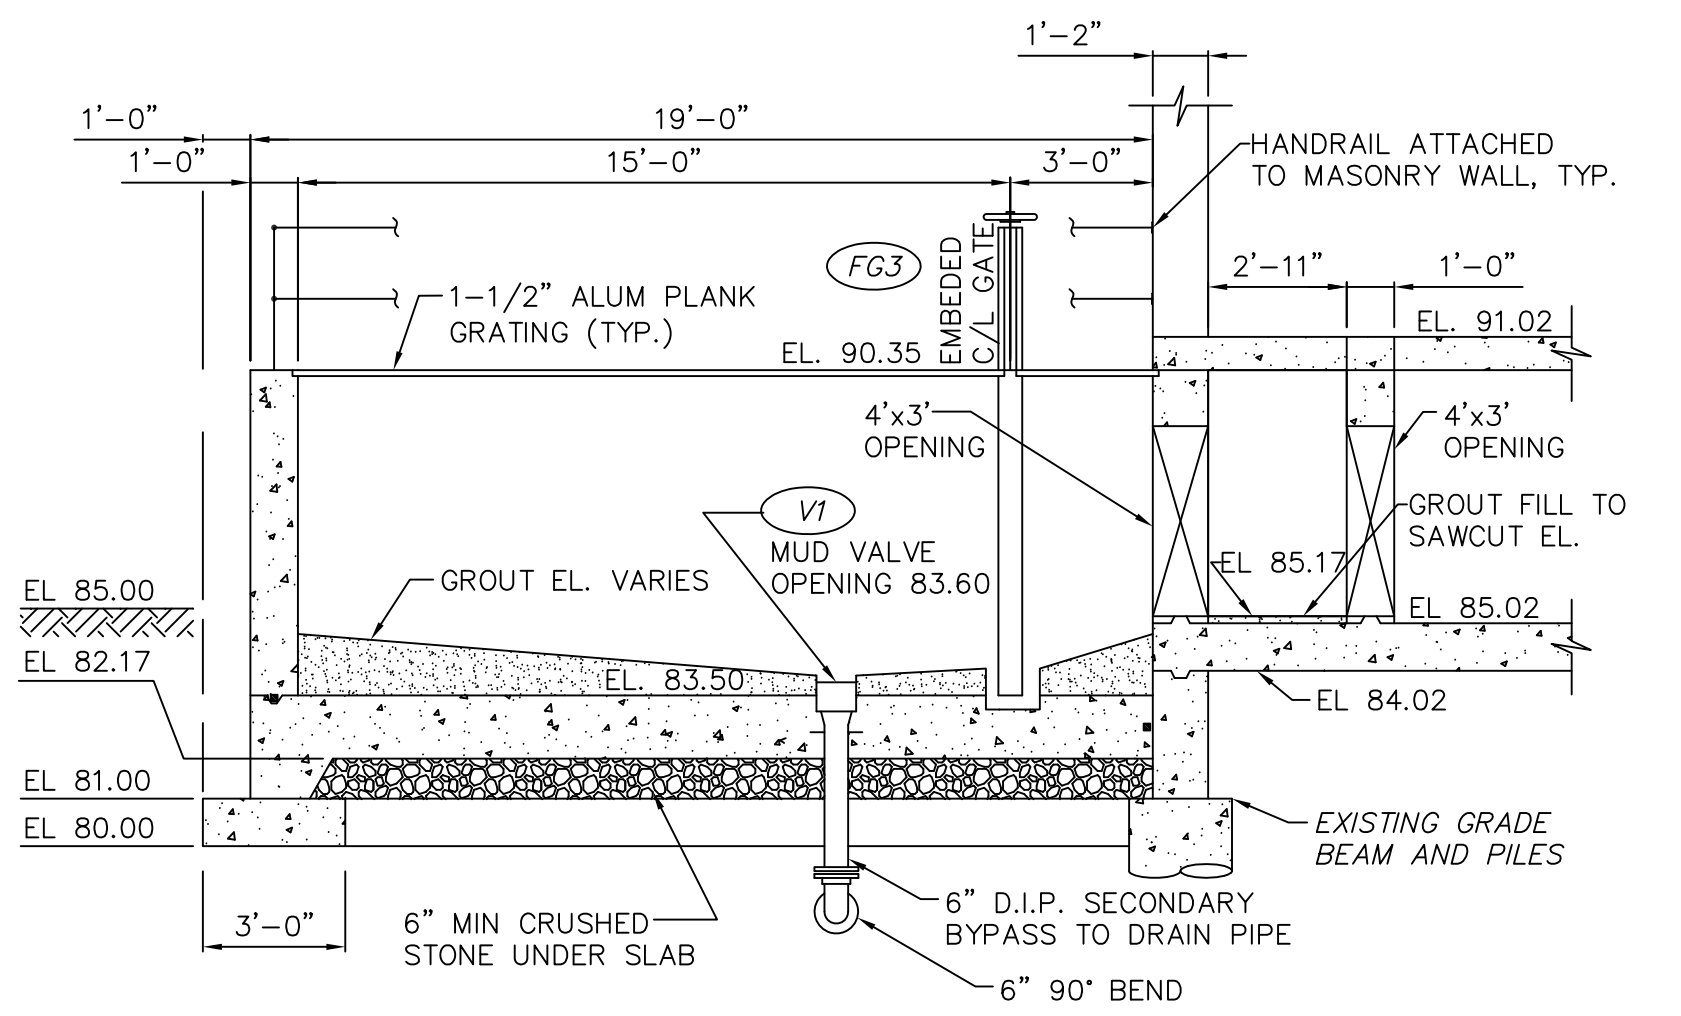

SECTION D
SCALE: 1/4" = 1'-0" P20

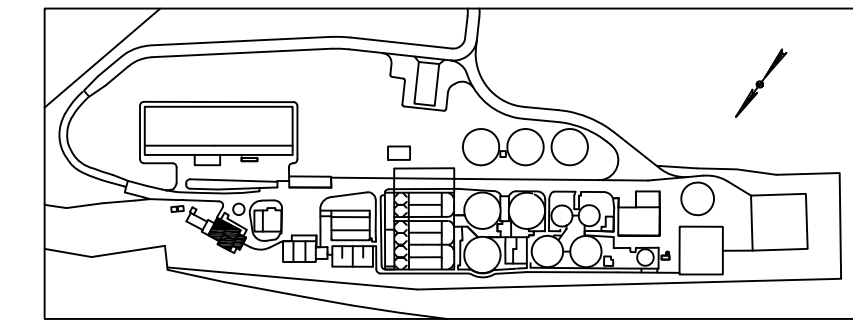

KEY PLAN

THIS DRAWING IS AN INSTRUMENT OF SERVICE OWNED BY CTI ENVIRONMENTAL, INC. WHICH SHALL BE DEEMED THE AUTHOR AND WHICH SHALL REMAIN THE PROPERTY OF CTI ENVIRONMENTAL, INC. IT IS TO BE USED ONLY FOR THE PROJECT AND SITE SPECIFICALLY IDENTIFIED HEREON. IT IS NOT TO BE REPRODUCED, COPIED, OR ANY OTHER PURPOSE OR PROJECT WITHOUT THE WRITTEN CONSENT OF CTI ENVIRONMENTAL, INC. THAT ELECTRONIC COPIES OF THIS DRAWING ARE EXACT DUPLICATES OF THE SEALED ORIGINAL DRAWING. THE ORIGINAL DRAWING SHALL BE KEPT IN THE PROJECT FILES OF THE CLIENT AND THE SEALED ORIGINAL SHALL GOVERN.

REVISIONS	DATE	BY	APP'D
RECORD DRAWING	2/1	MGW	WAD

DESIGNED BY	DRAWN BY	CHECKED BY	APPROVED BY
RNF	SAT	MGW	WAD

ENVIRONMENTAL, INC.
ENGINEERS IN WATER AND EARTH SCIENCES
UNIONTOWN, OHIO

CITY OF MASSILLON, OHIO
WWTP UPGRADE 2000
MECHANICAL BAR SCREEN AND GRIT CHAMBER UPPER PROPOSED GRIT TANK MODIFICATIONS

JOB NO. E9031
DATE 08/13/01
SCALE AS NOTED
SHEET P21

THESE RECORD DOCUMENTS HAVE BEEN PREPARED BASED ON INFORMATION PROVIDED BY OTHERS. CTI ENVIRONMENTAL HAS REVIEWED THE INFORMATION SUBMITTED AND BELIEVES IT REFLECTS THE WORK AS CONSTRUCTED. HOWEVER, ALL PERSONS SHALL VERIFY INFORMATION TAKEN FROM THIS DRAWING.