




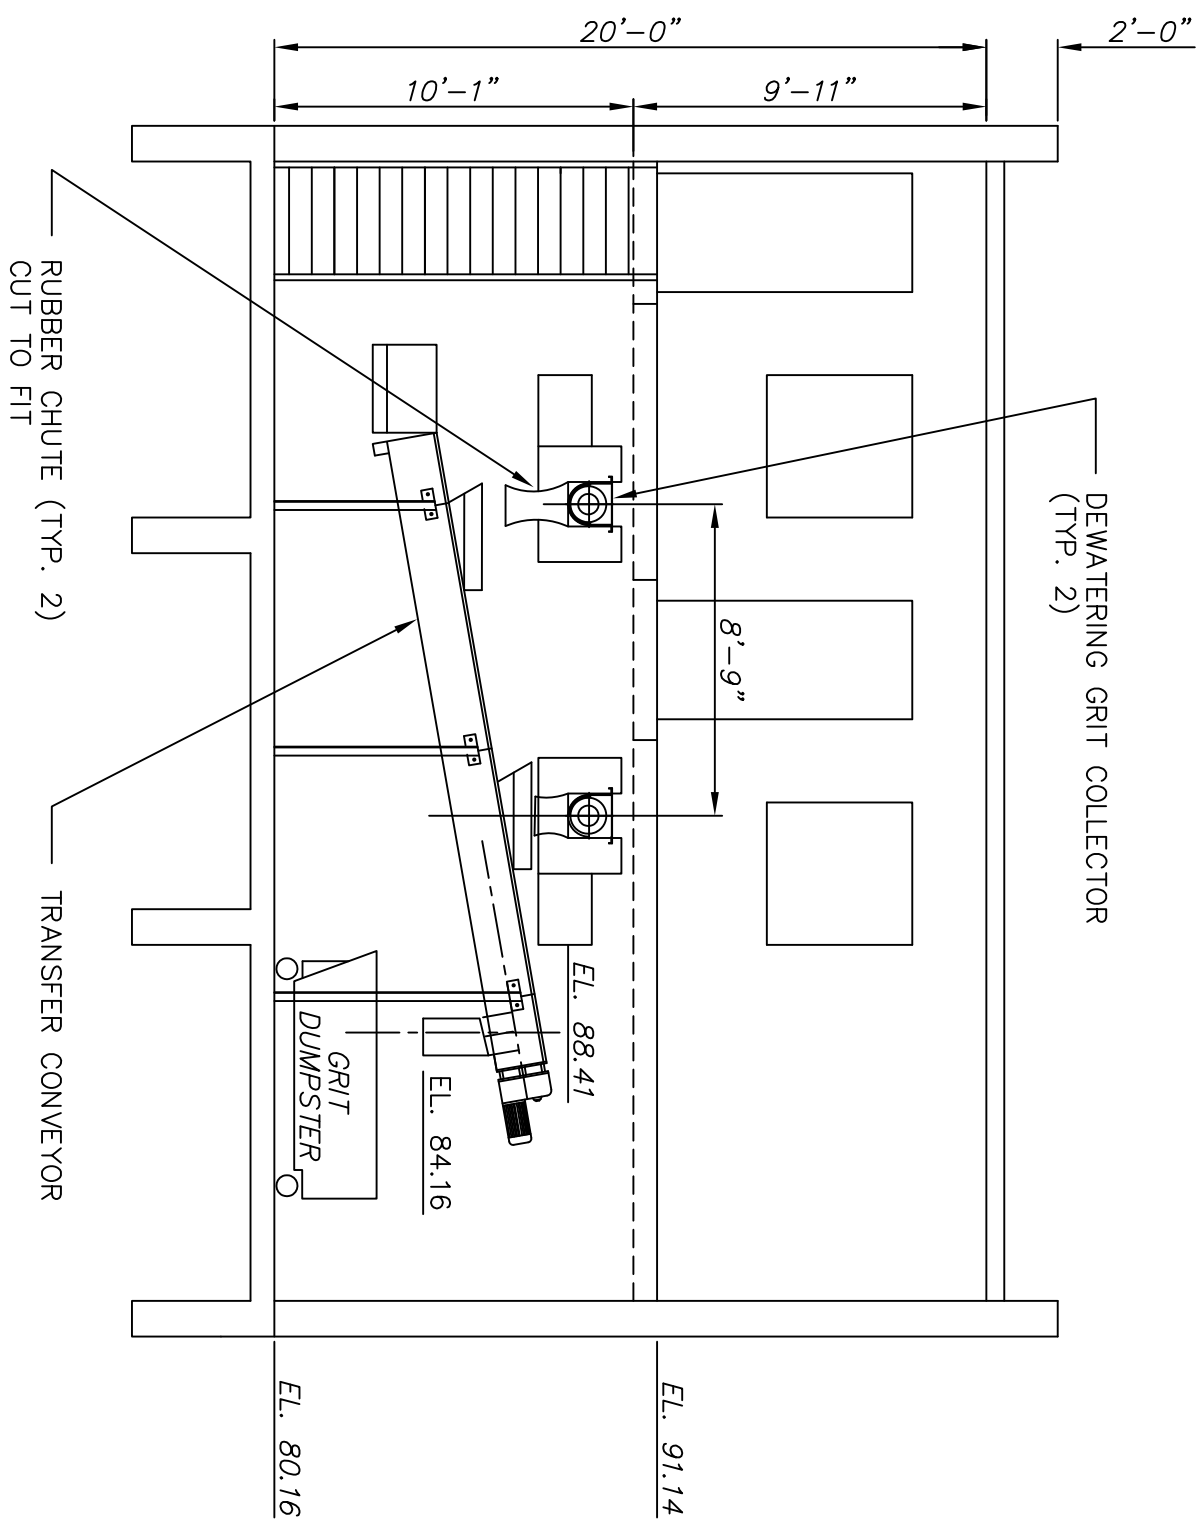


SECTION 3
SCALE : 3/16"=1'-0" P20

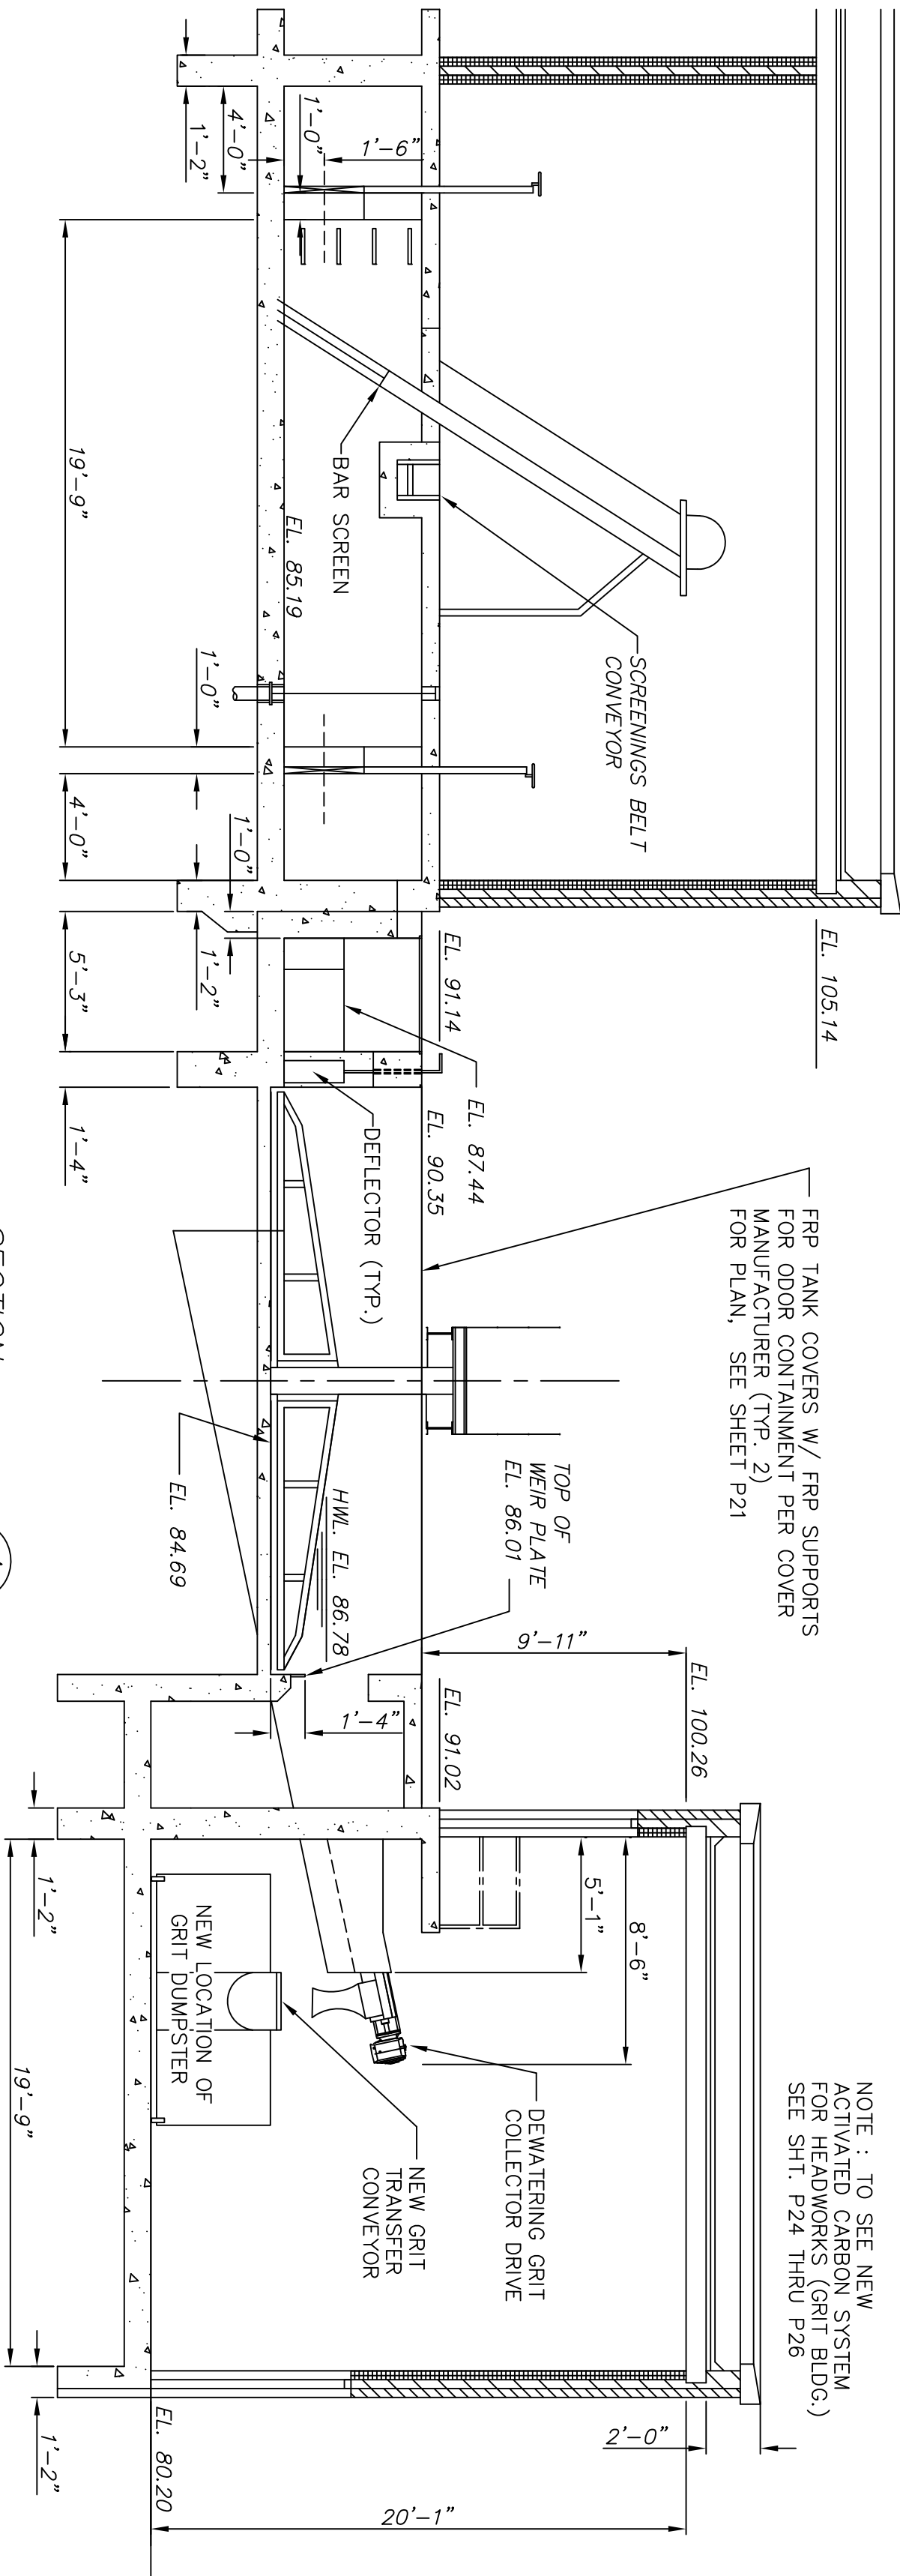


SECTION A
SCALE : 3/16"=1'-0" P20

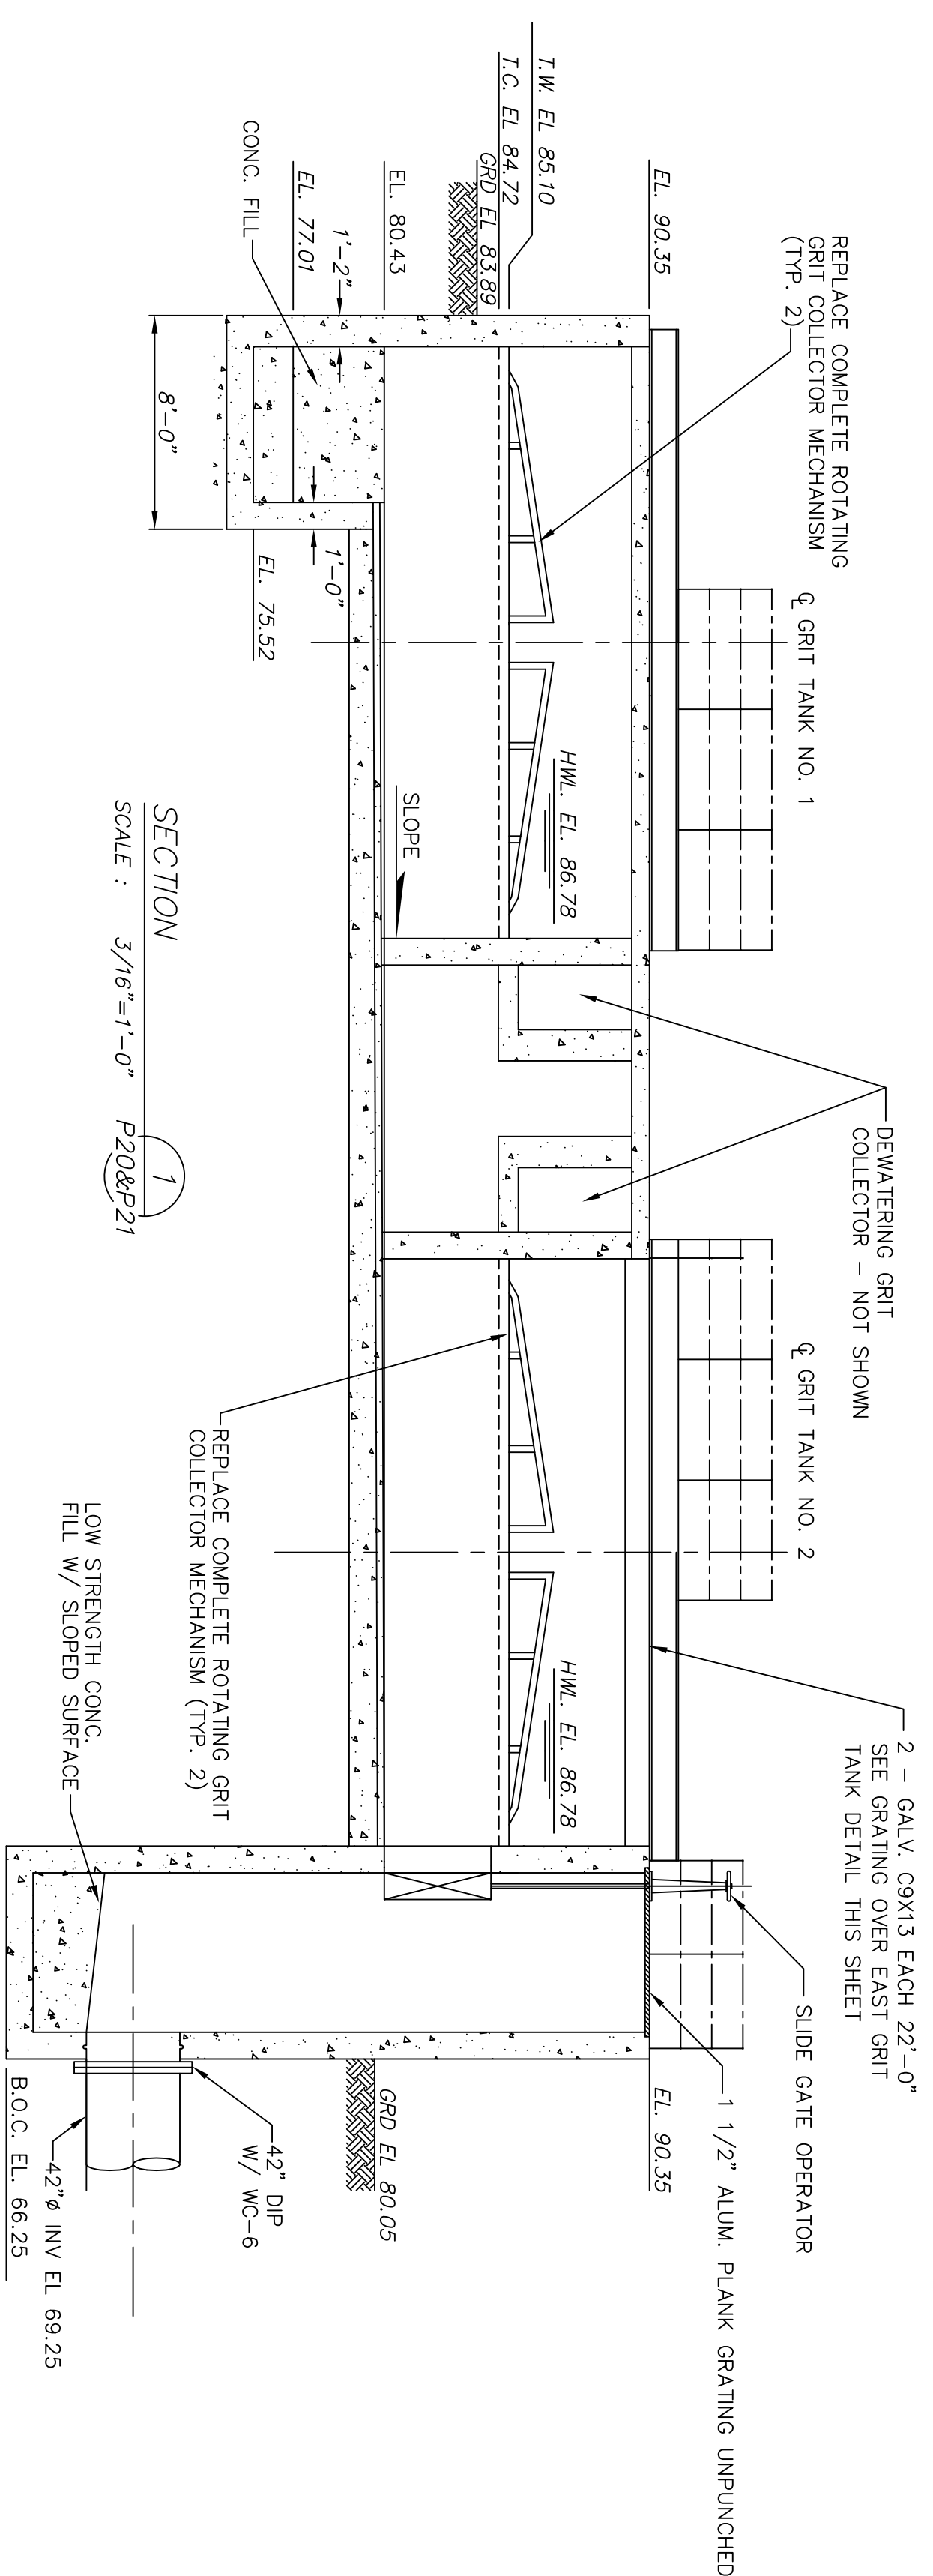

SECTION 1
SCALE : 3/16"=1'-0" P20

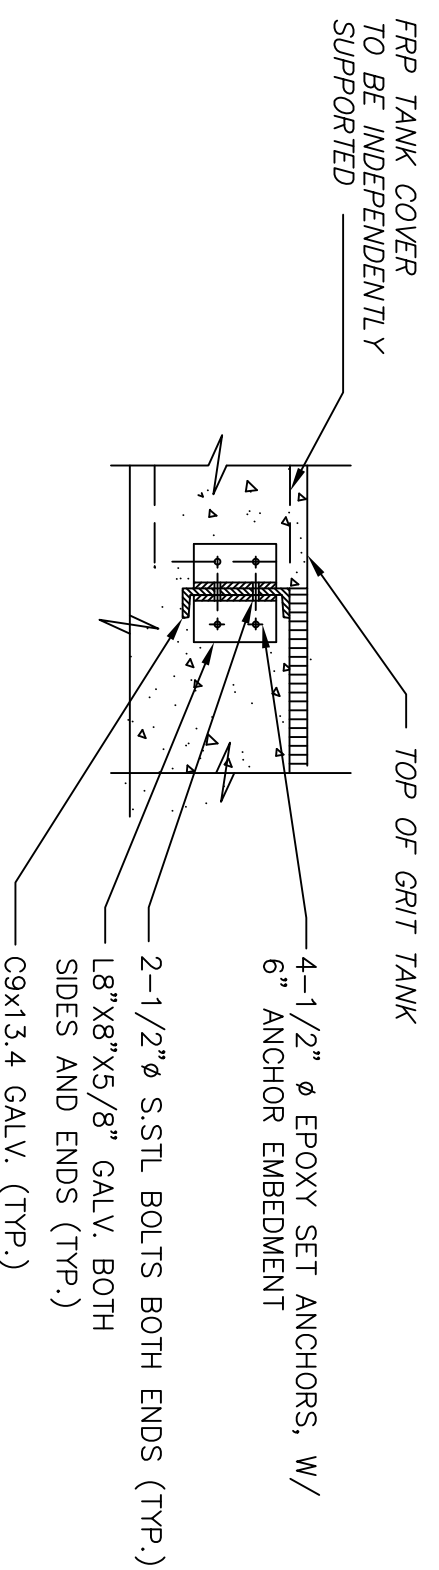


DETAIL 1
SCALE: NONE

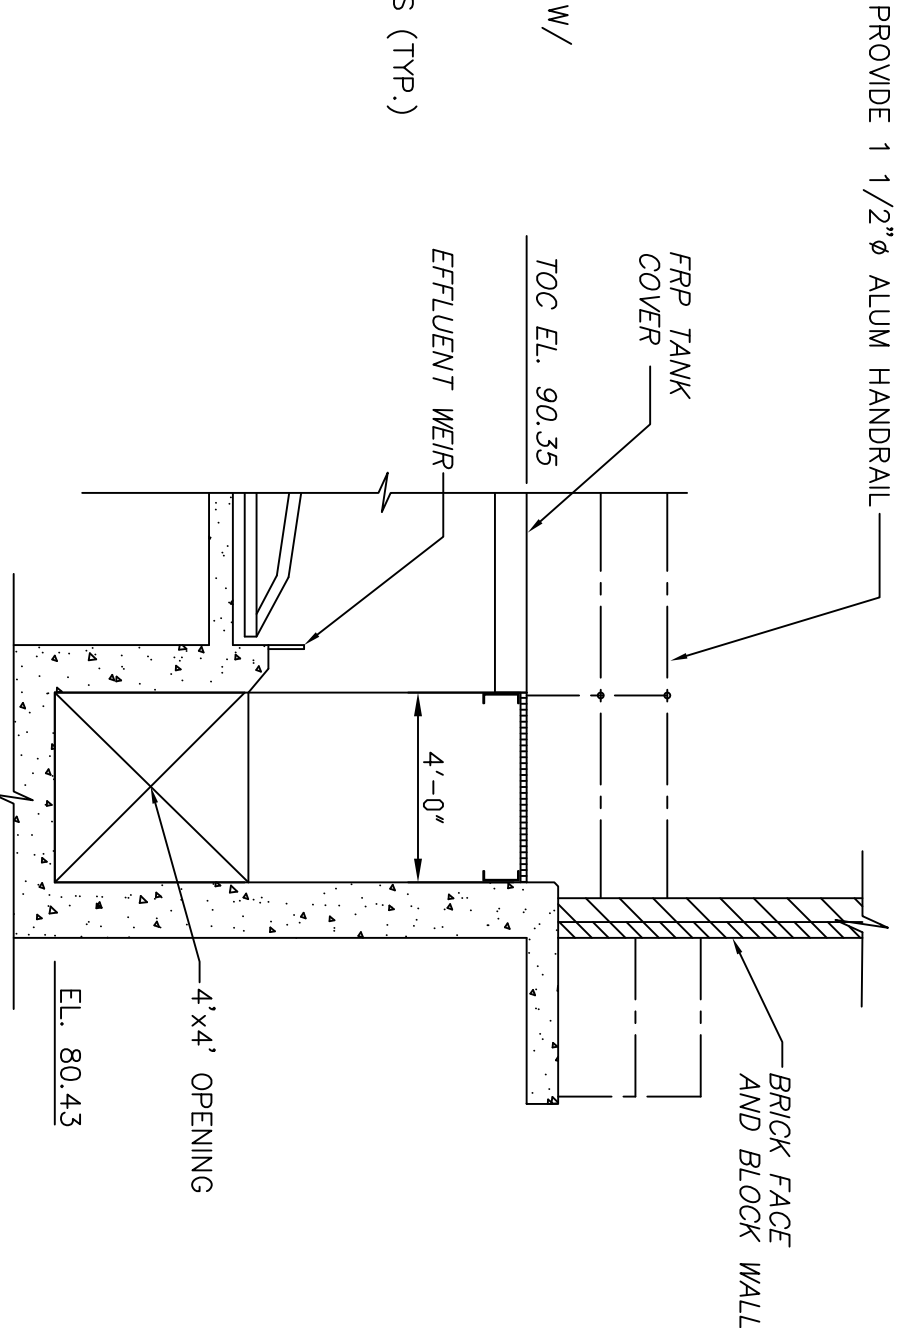

- NOTES:
1. REMOVE SECTION OF HANDRAIL AT EAST GRIT TANK
 2. THEN NEW ALUM HANDRAIL ONTO EXISTING HANDRAIL
 3. SET GRATING FLUSH WITH TOP OF GRIT TANK WALKWAY
 4. RELOCATE DOWNSPOUT AS NECESSARY

SECTION 4
SCALE: 1/4" = 1'-0"

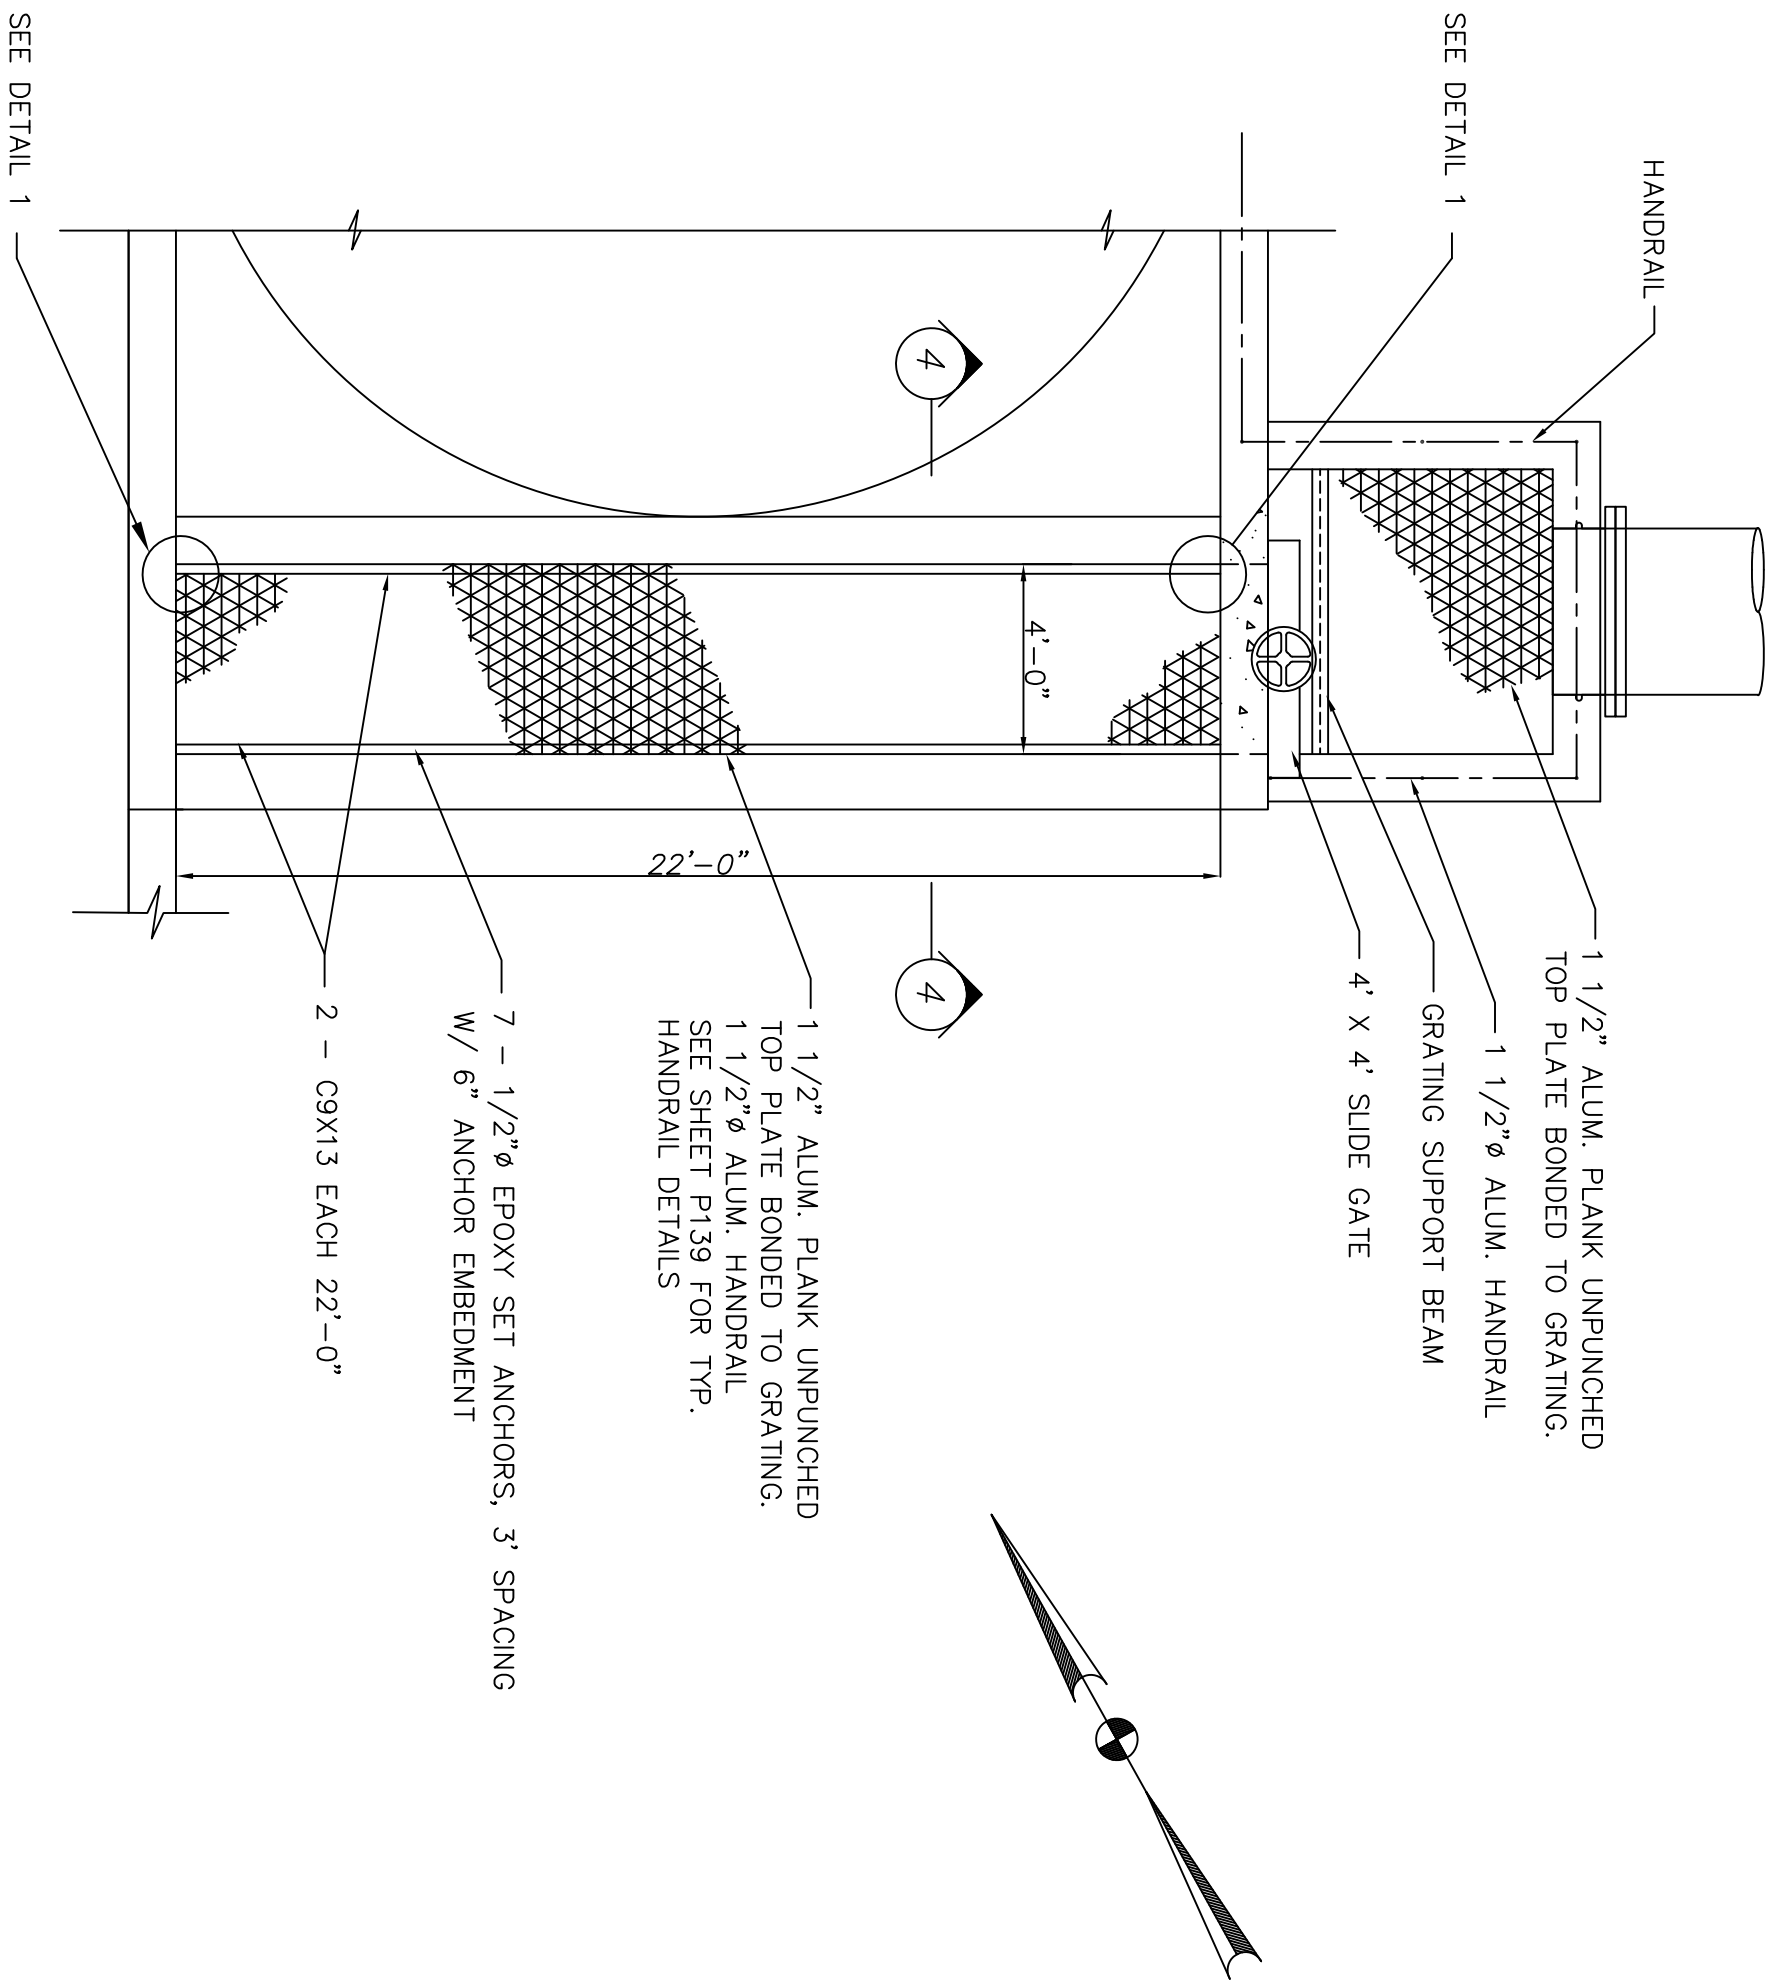

PLAN - GRATING OVER EAST GRIT TANK
SCALE 1/4" = 1'-0"

THESE RECORD DOCUMENTS HAVE BEEN PREPARED BASED ON INFORMATION PROVIDED BY OTHERS. CITI ENVIRONMENTAL HAS REVIEWED THE INFORMATION SUBMITTED AND BELIEVES IT REFLECTS THE WORK AS CONSTRUCTED. HOWEVER, ALL PERSONS SHALL VERIFY INFORMATION TAKEN FROM THIS DRAWING.



CITY OF MASSILLON, OHIO
WWTP UPGRADE 2000
MECHANICAL BAR SCREEN AND GRIT
CHAMBER DETAILS

DESIGNED BY	REVISIONS				
	NO.	DESCRIPTIONS	DATE	BY	APP'D
RNF	1	ADDENDUM NO. 3	9/28	MGW	WAD
	2	RECORD DRAWING	2/1	MGW	WAD
CHECKED BY					
APPROVED BY					

THIS DRAWING IS AN INSTRUMENT OF SERVICE OWNED BY CITI ENVIRONMENTAL, INC. WHICH SHALL BE DEEMED THE AUTHOR AND WHICH SHALL RETAIN ALL STATUTORY AND COMMON LAW RIGHTS, INCLUDING COPYRIGHTS. THIS DRAWING SHALL NOT BE SCANNED, COPIED, OR DISTRIBUTED TO OTHERS IN ANY FORM OR USED FOR ANY OTHER PURPOSE OR PROJECT WITHOUT PRIOR WRITTEN CONSENT OF CITI ENVIRONMENTAL, INC. CITI ENVIRONMENTAL, INC. CANNOT GUARANTEE THAT ELECTRONIC COPIES OF THIS DRAWING ARE EXACT DUPLICATES OF THE SEALED ORIGINAL DRAWING. IN THE EVENT OF A CONFLICT BETWEEN AN ELECTRONIC COPY AND THE SEALED ORIGINAL, THE SEALED ORIGINAL SHALL GOVERN.

JOB NO.	DATE
E9031	07/06/01
SCALE	SHEET
AS NOTED	P22