

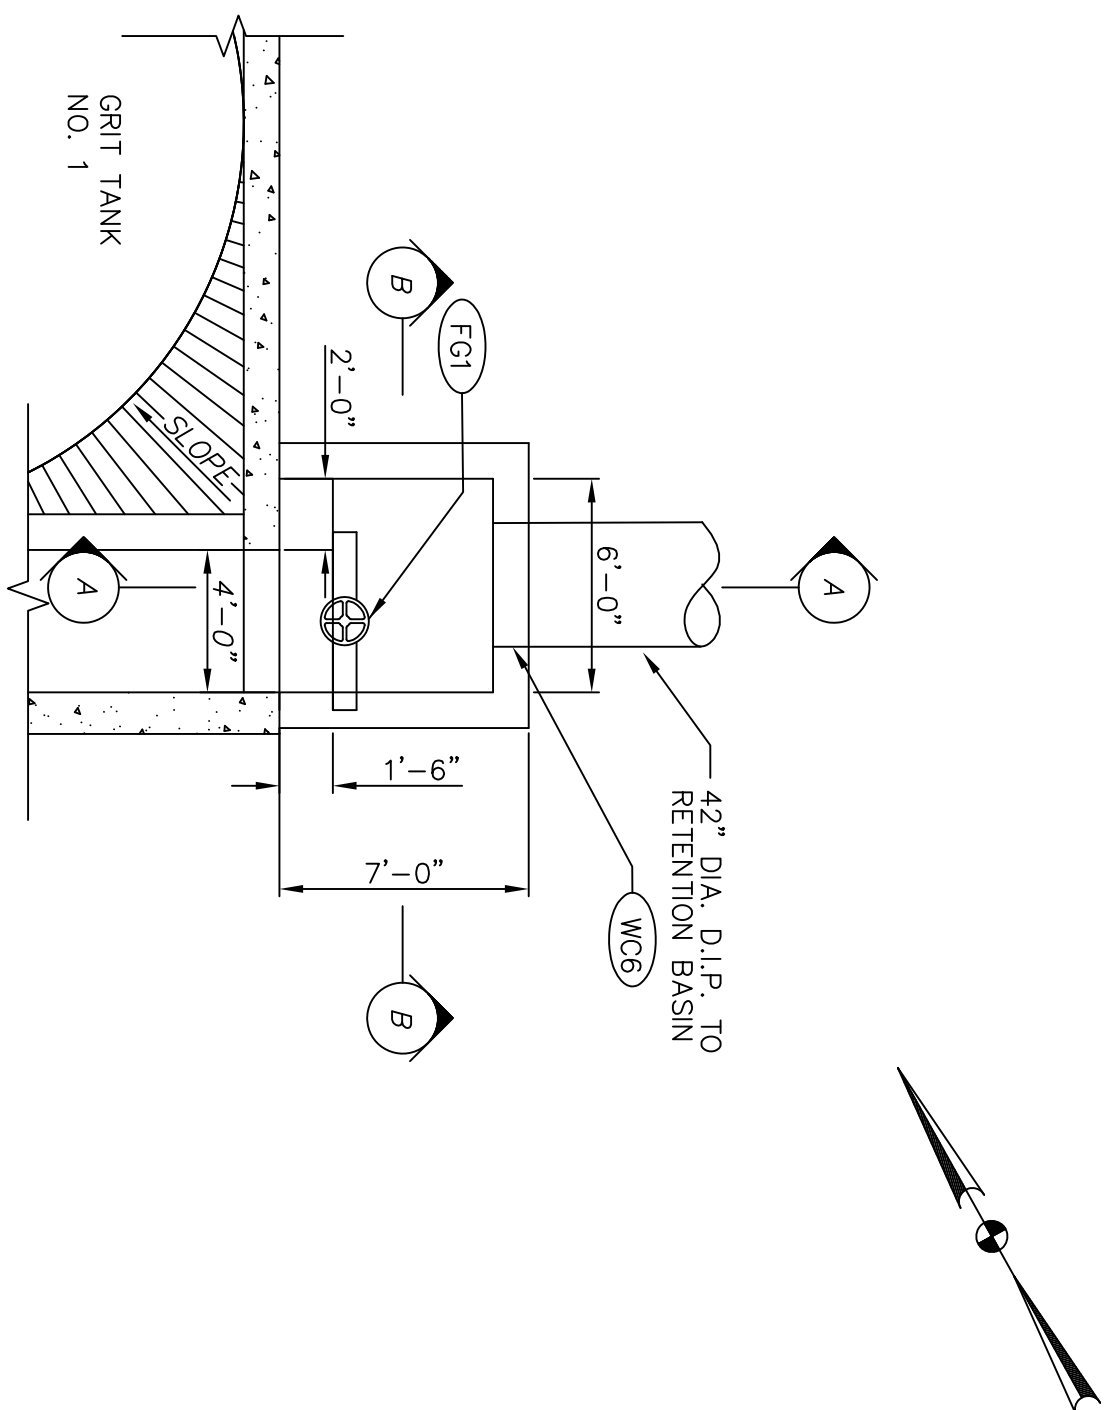
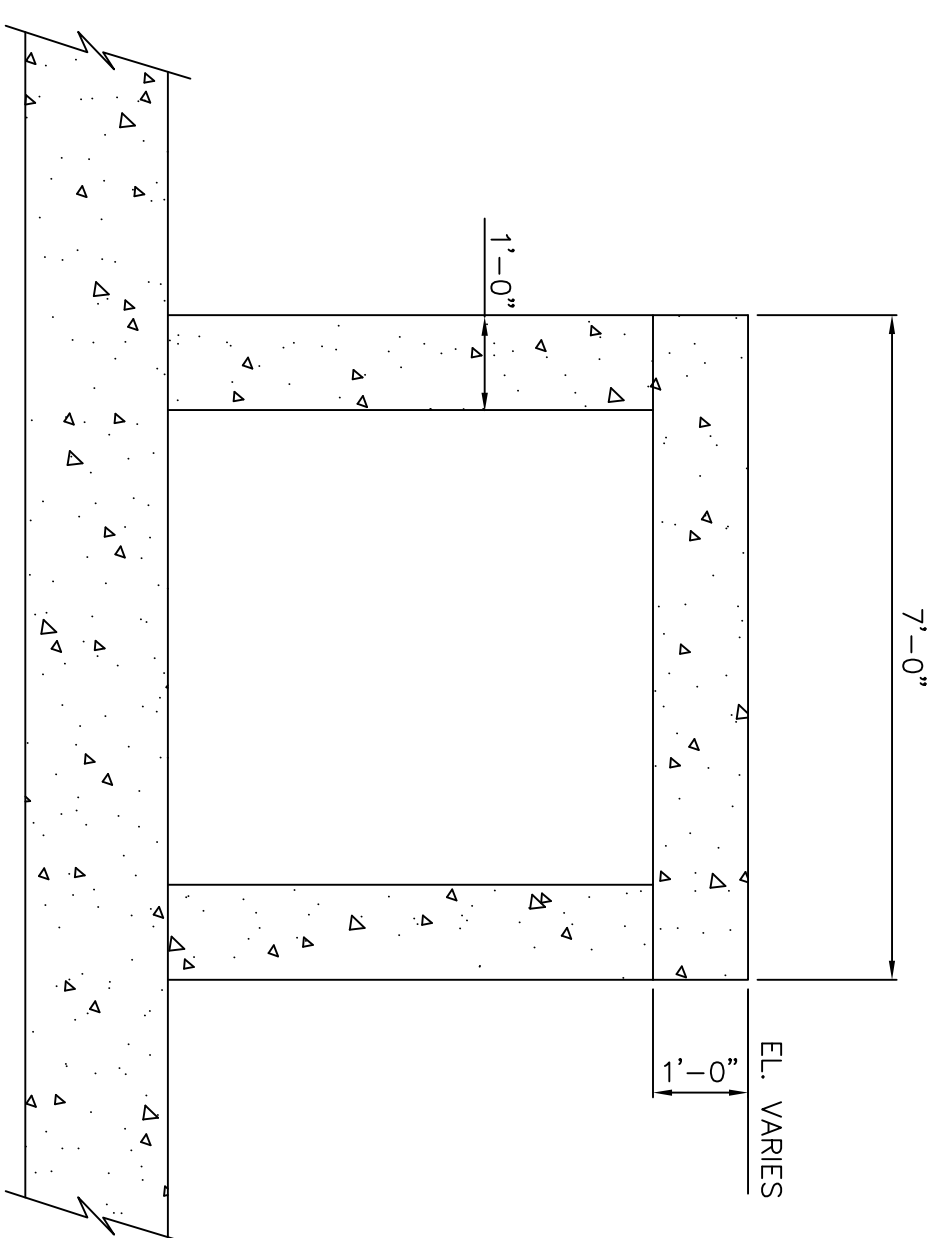


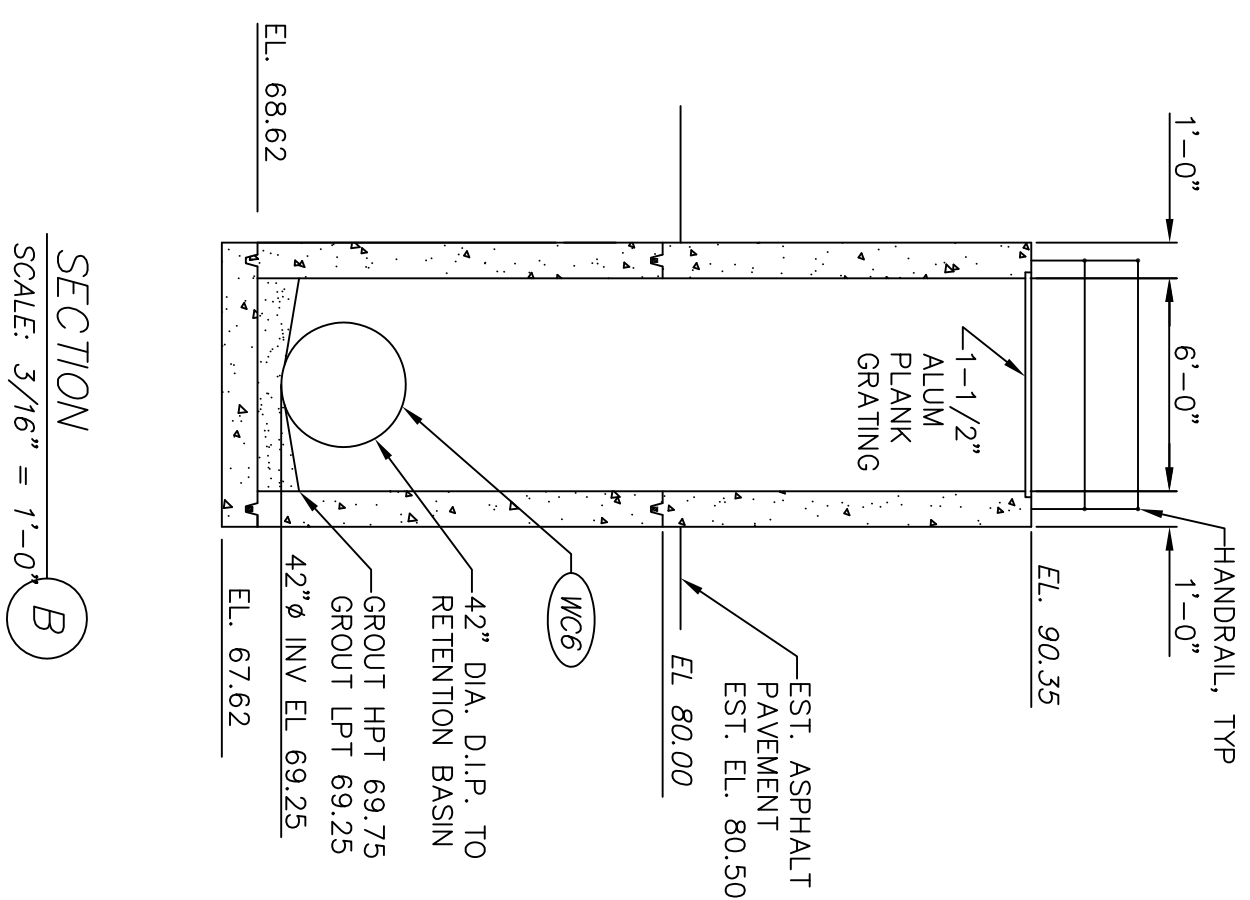

DETAIL PLAN VIEW OF OUTLET AT GRIT CHANNEL

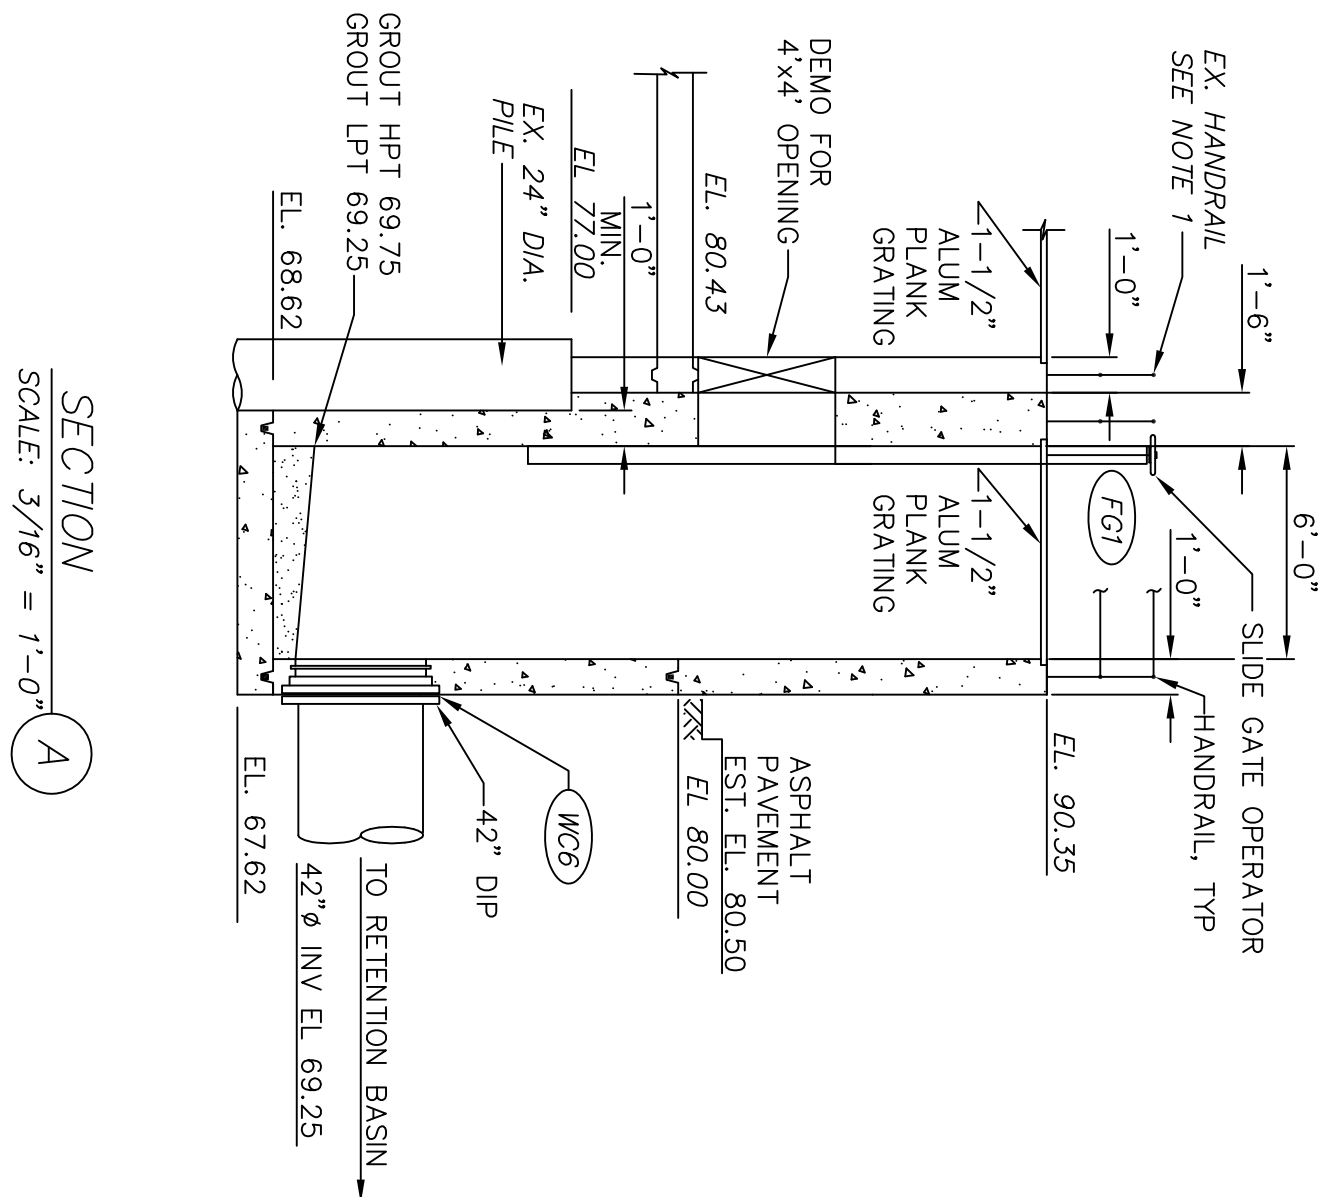

MOUNTING PEDESTAL SECTION
SCALE: 1/2" = 1'-0"

DESIGNED BY	REVISIONS				
RNF	NO.	DESCRIPTIONS	DATE	BY	APP'D
DRAWN BY	1	ADDENDUM NO. 3	9/28	MGW	WAD
RNF	2	RECORD DRAWING	2/10	MGW	WAD
CHECKED BY					
MGW					
APPROVED BY					
WAD					

THIS DRAWING IS AN INSTRUMENT OF SERVICE OWNED BY CTI ENVIRONMENTAL, INC. WHICH SHALL BE DEEMED THE AUTHOR AND WHICH SHALL RETAIN ALL STATUTORY AND COMMON LAW RIGHTS, INCLUDING COPYRIGHTS. THIS DRAWING SHALL NOT BE SCANNED, COPIED, OR REPRODUCED IN ANY FORM OR BY ANY MEANS FOR ANY OTHER PURPOSE OR PROJECT WITHOUT PRIOR WRITTEN CONSENT OF CTI ENVIRONMENTAL, INC. CTI ENVIRONMENTAL, INC. CANNOT GUARANTEE THAT ELECTRONIC COPIES OF THIS DRAWING ARE EXACT DUPLICATES OF THE SEALED ORIGINAL DRAWING. IN THE EVENT OF CONFLICT BETWEEN THE ELECTRONIC COPY AND THE SEALED ORIGINAL, THE SEALED ORIGINAL SHALL GOVERN.

ग

CITY OF MASSILLON, OHIO
WWTP UPGRADE 2000
MECHANICAL BAR SCREEN AND GRIT
CHAMBER DETAILS

THESE RECORD DOCUMENTS HAVE BEEN PREPARED BASED ON INFORMATION PROVIDED BY OTHERS. CTH ENVIRONMENTAL HAS REVIEWED THE INFORMATION SUBMITTED AND BELIEVES IT REFLECTS THE WORK CONSTRUCTED. HOWEVER, ALL PERSONS SHALL VERIFY INFORMATION TAKEN FROM THIS DRAWING.

JOB NO.
E9031
DATE
2/10/0
SCALE
S NOTED
SHEET
P22A