


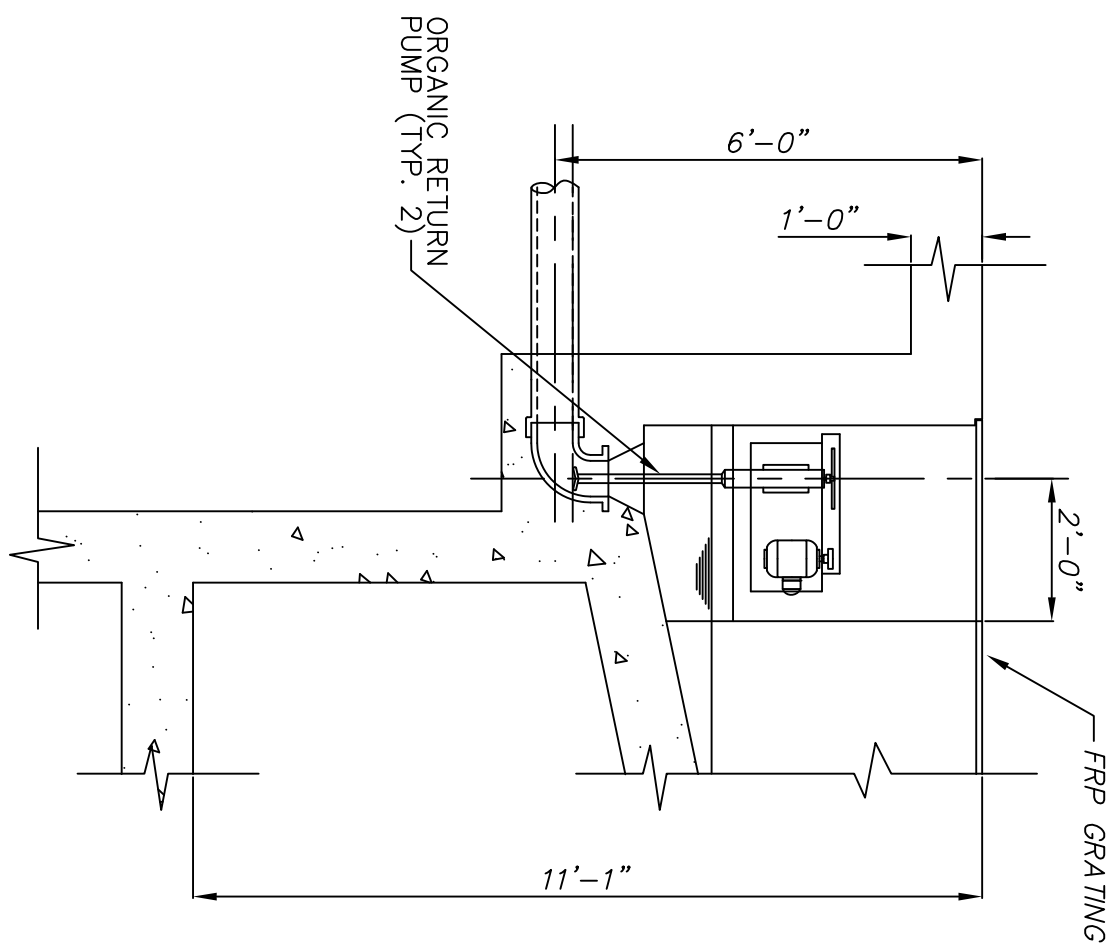


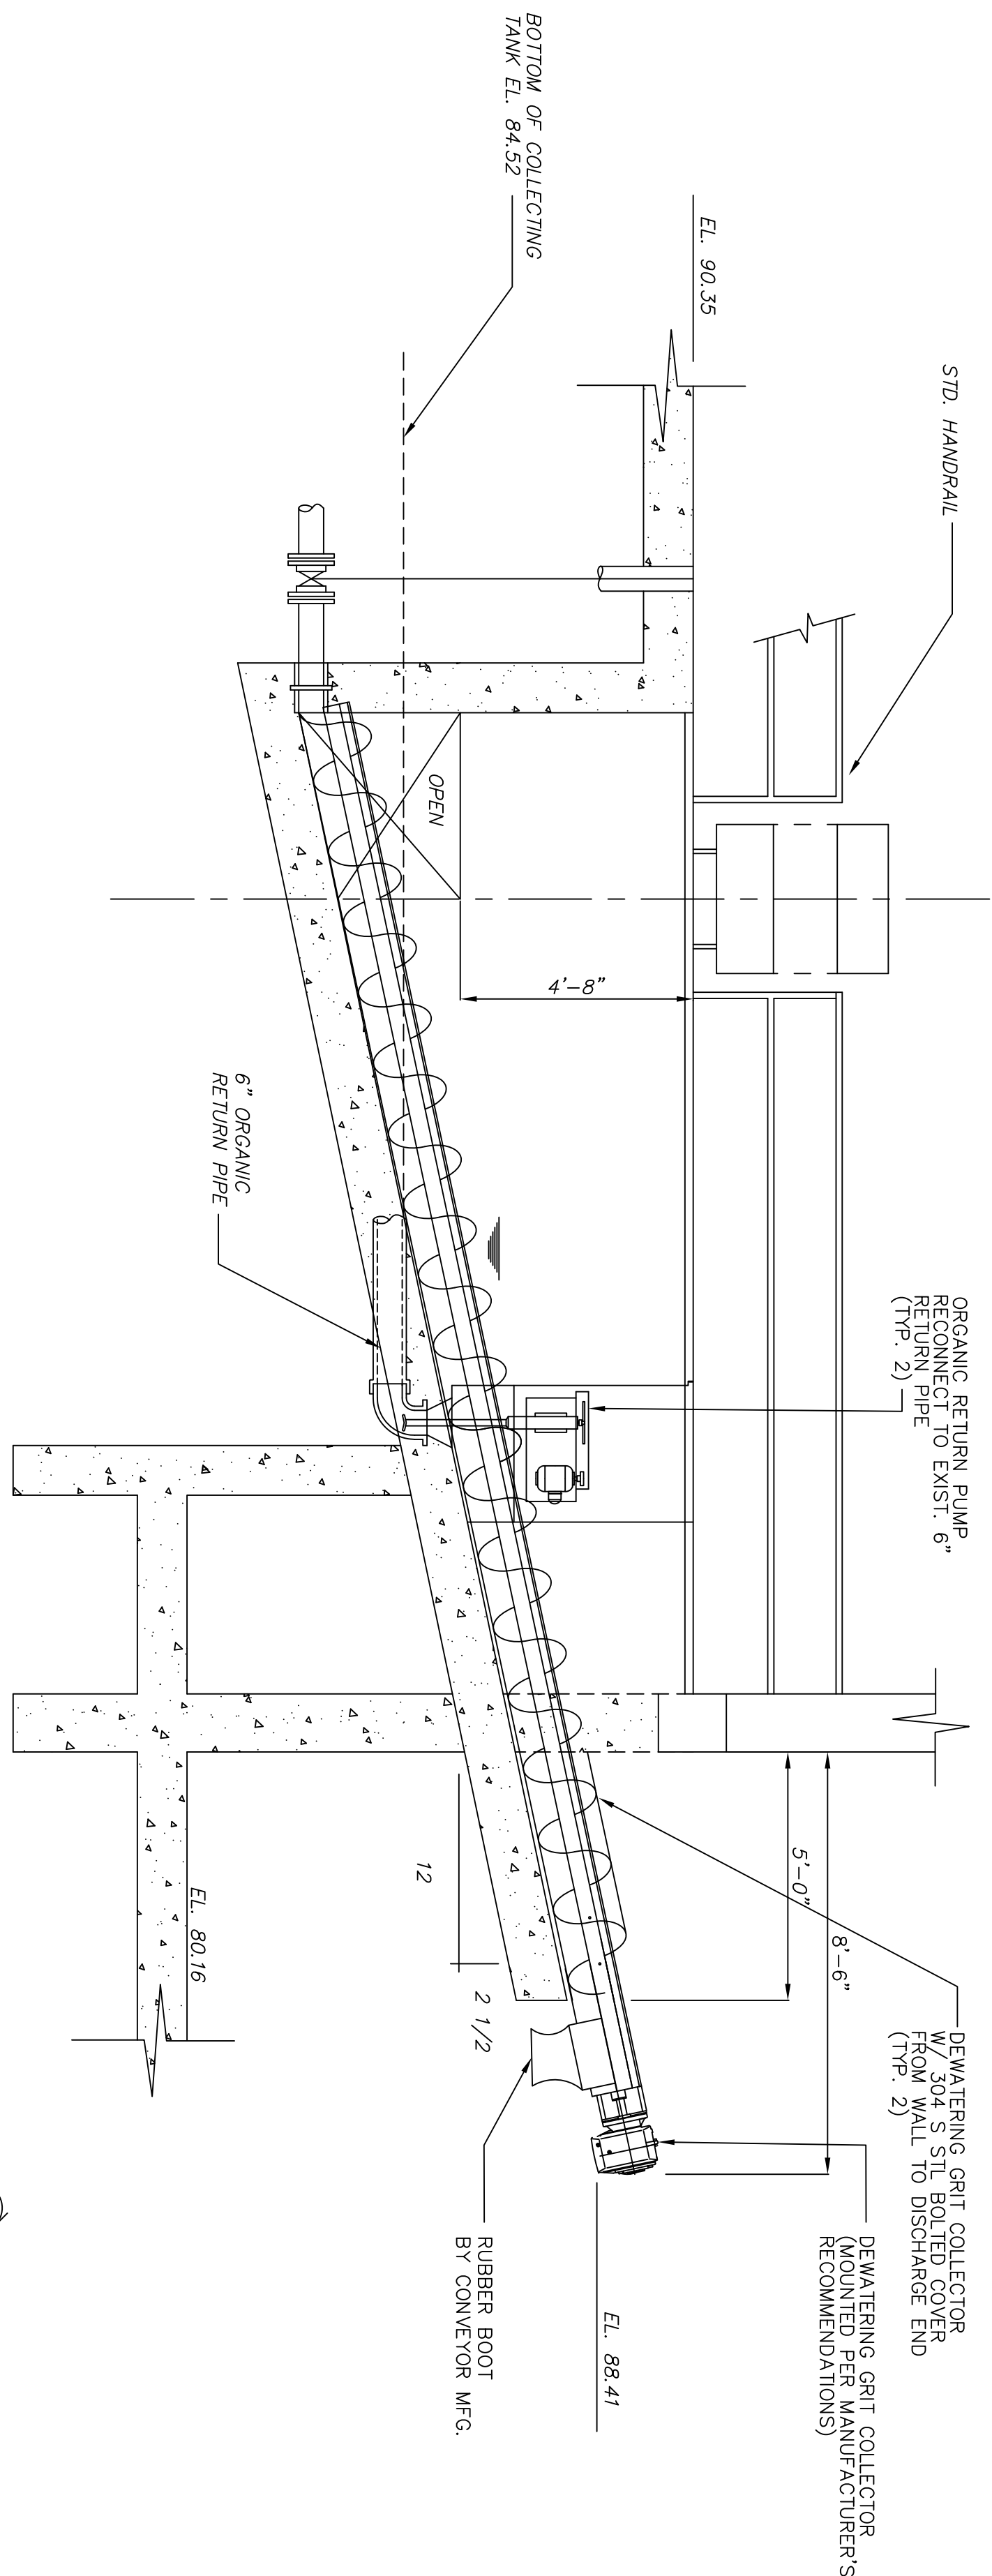


SECTION
SCALE : 3/8"=1'-0" (P19)

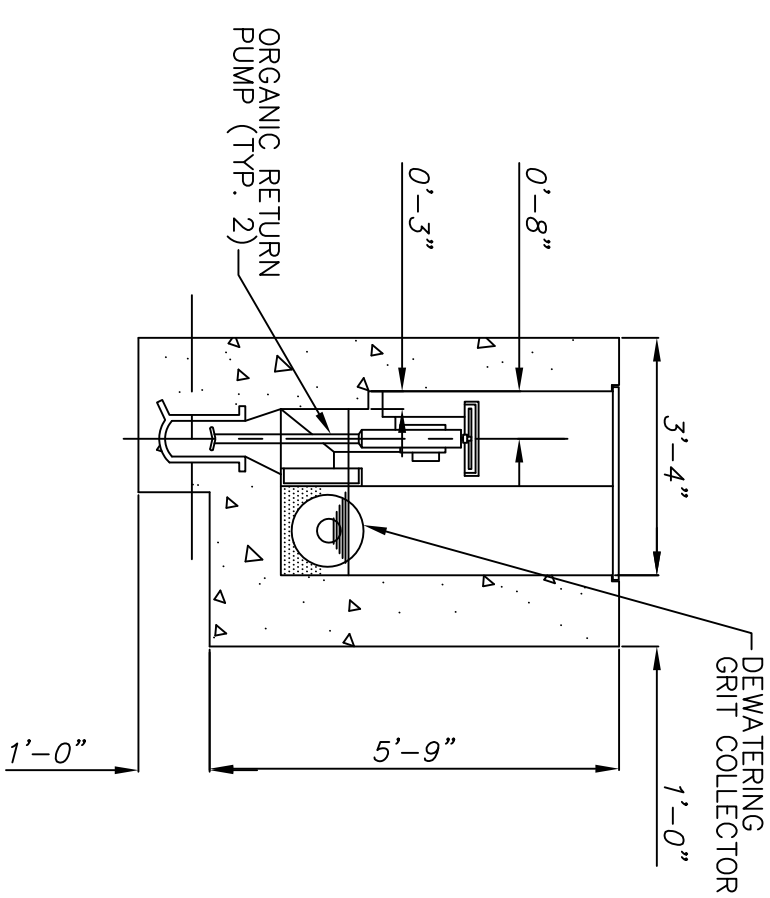


SECTION
SCALE : 3/8"=1'-0" (B)

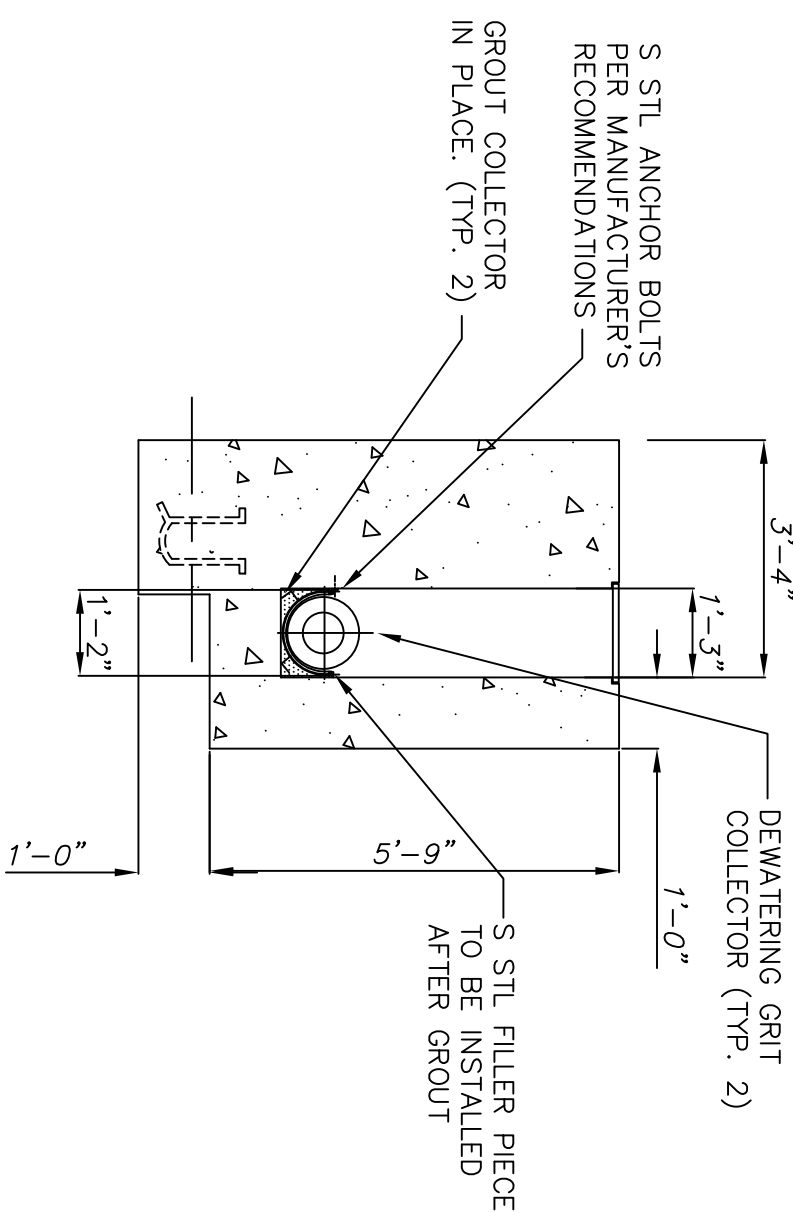

SECTION
SCALE : 3/8"=1'-0" (C)

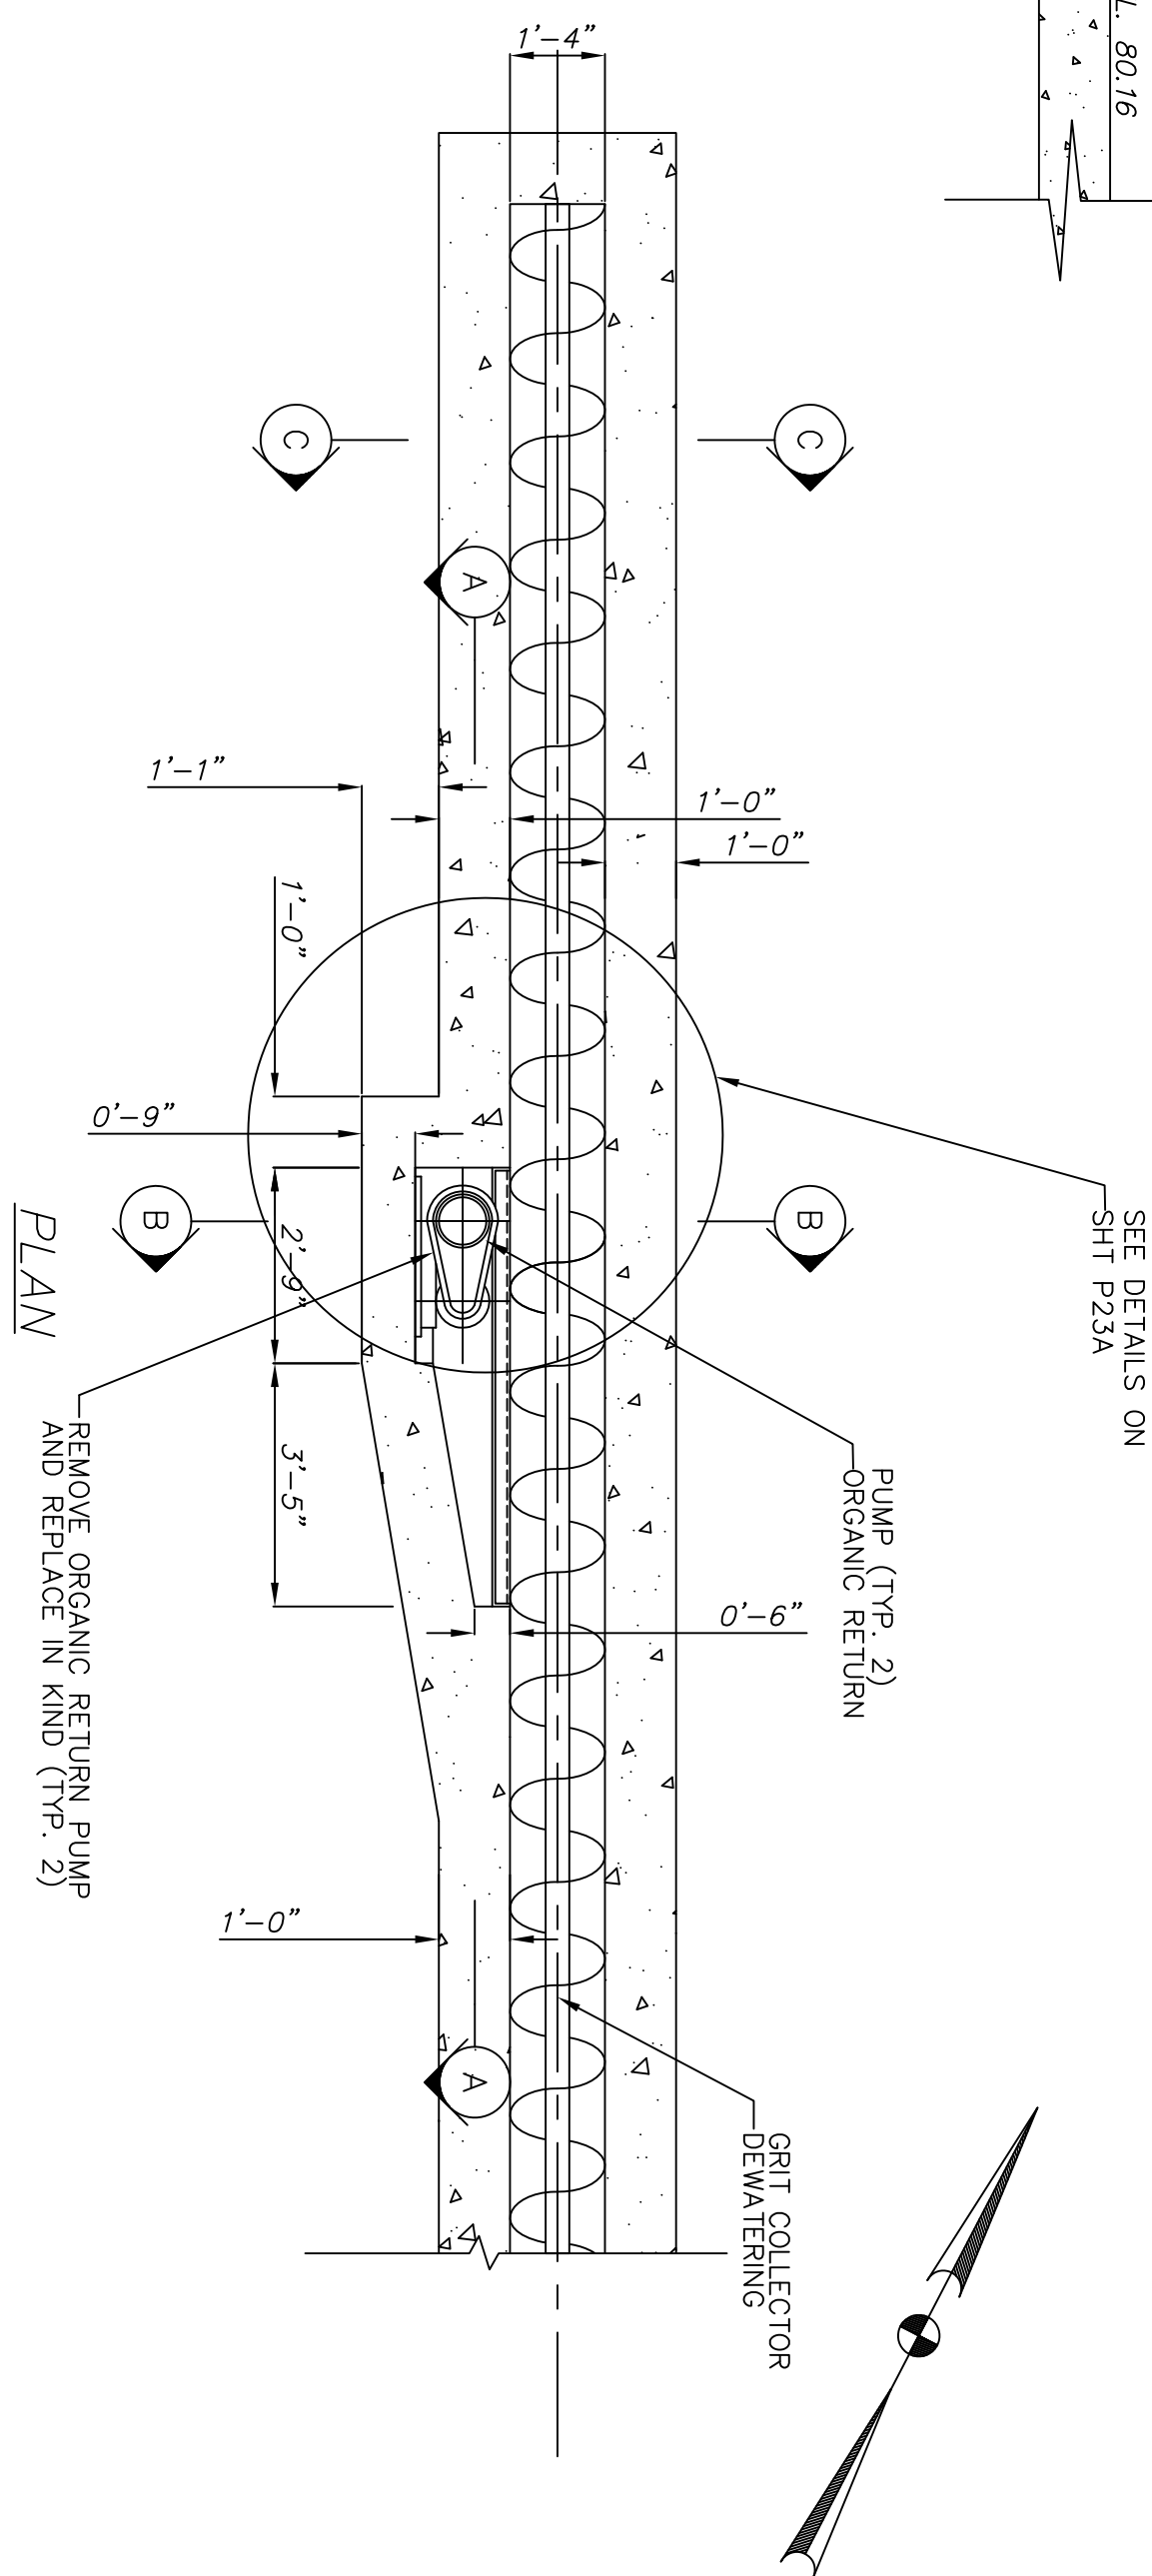

ORGANIC RETURN PUMP DETAIL FOR GRIT TANK NO. 1
SCALE: 3/8"=1'-0"

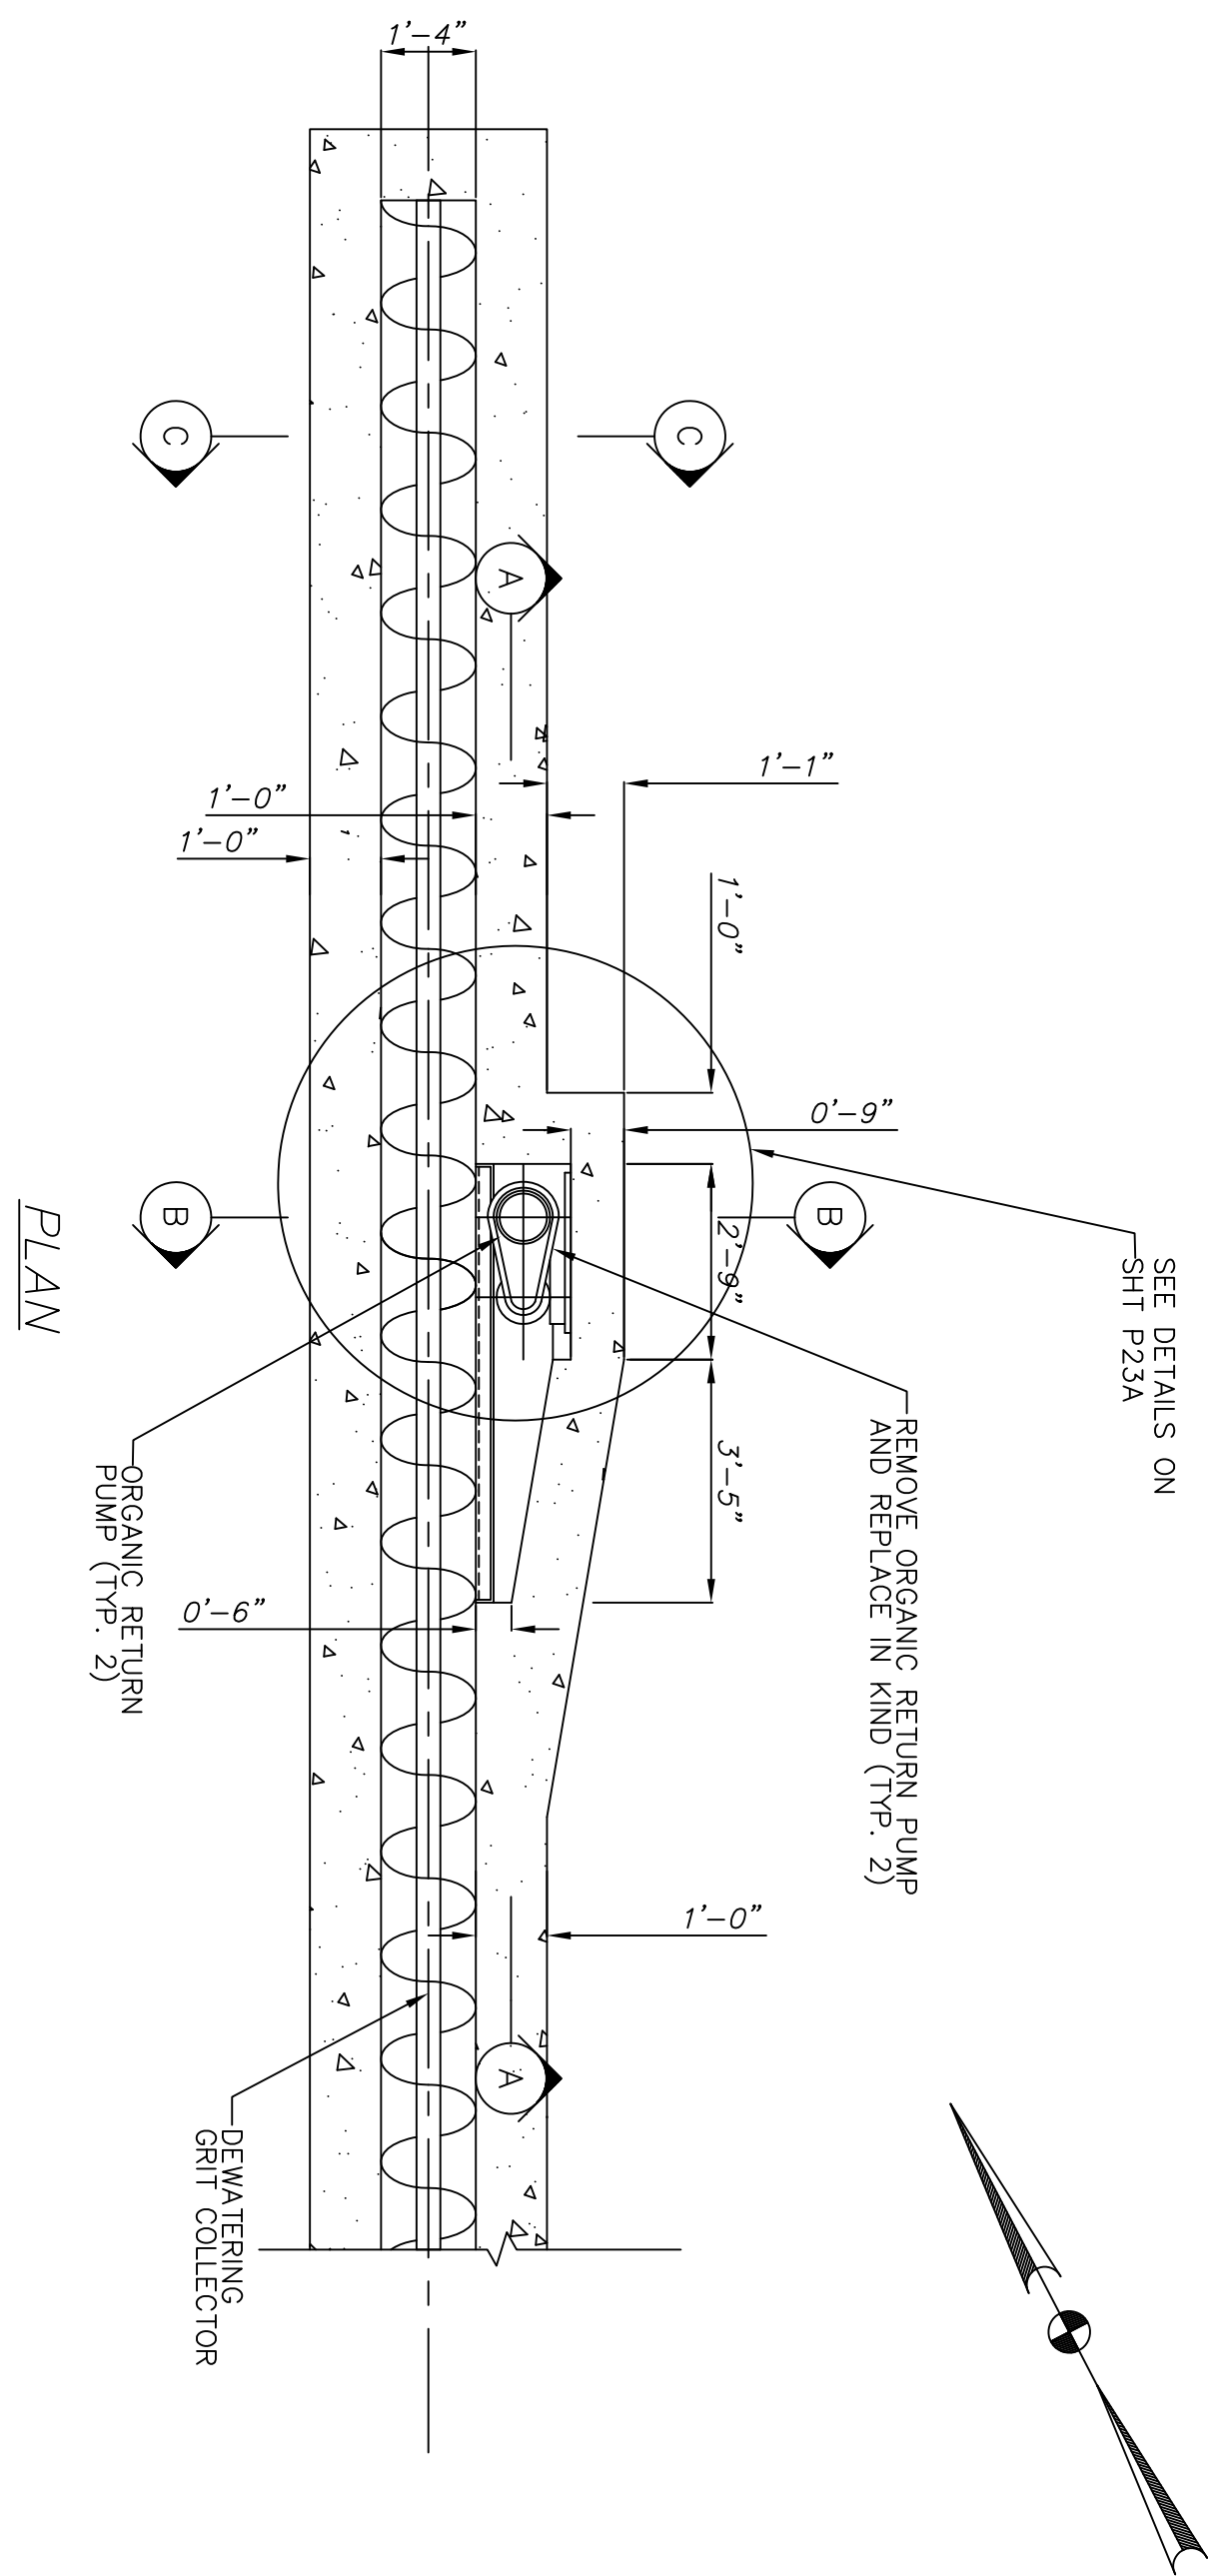

ORGANIC RETURN PUMP DETAIL FOR GRIT TANK NO. 2
SCALE: 3/8"=1'-0"

THIS DRAWING IS AN INSTRUMENT OF SERVICE OWNED BY CTI ENVIRONMENTAL, INC. WHICH SHALL BE DEEMED THE AUTHOR AND WHICH SHALL RETAIN ALL STATUTORY AND COMMON LAW RIGHTS, INCLUDING COPYRIGHTS. THIS DRAWING SHALL NOT BE SCANNED, COPIED, OR DISTRIBUTED TO OTHERS IN ANY FORM OR USED FOR ANY OTHER PURPOSE OR PROJECT WITHOUT PRIOR WRITTEN CONSENT OF CTI ENVIRONMENTAL, INC. CTI ENVIRONMENTAL, INC. CANNOT GUARANTEE THAT ELECTRONIC COPIES OF THIS DRAWING ARE EXACT DUPLICATES OF THE SEALED ORIGINAL DRAWING. IN THE EVENT OF A CONFLICT BETWEEN AN ELECTRONIC COPY AND THE SEALED ORIGINAL, THE SEALED ORIGINAL SHALL GOVERN.

DESIGNED BY	REVISIONS				
	NO.	DESCRIPTIONS	DATE	BY	APP'D
RNF					
DRAWN BY	1	RECORD DRAWING	2/8	MGW	WAD
SAT					
CHECKED BY					
MGW					
APPROVED BY					
WAD					



ENVIRONMENTAL, INC.
ENGINEERS IN WATER AND EARTH SCIENCES
UNIONTOWN, OHIO

CITY OF MASSILLON, OHIO
WWTP UPGRADE 2000
GRIT TANK CHAMBER SECTIONS AND DETAILS

JOB NO.
E9031
DATE
08/13/01
SCALE
AS NOTED
SHEET
P23