


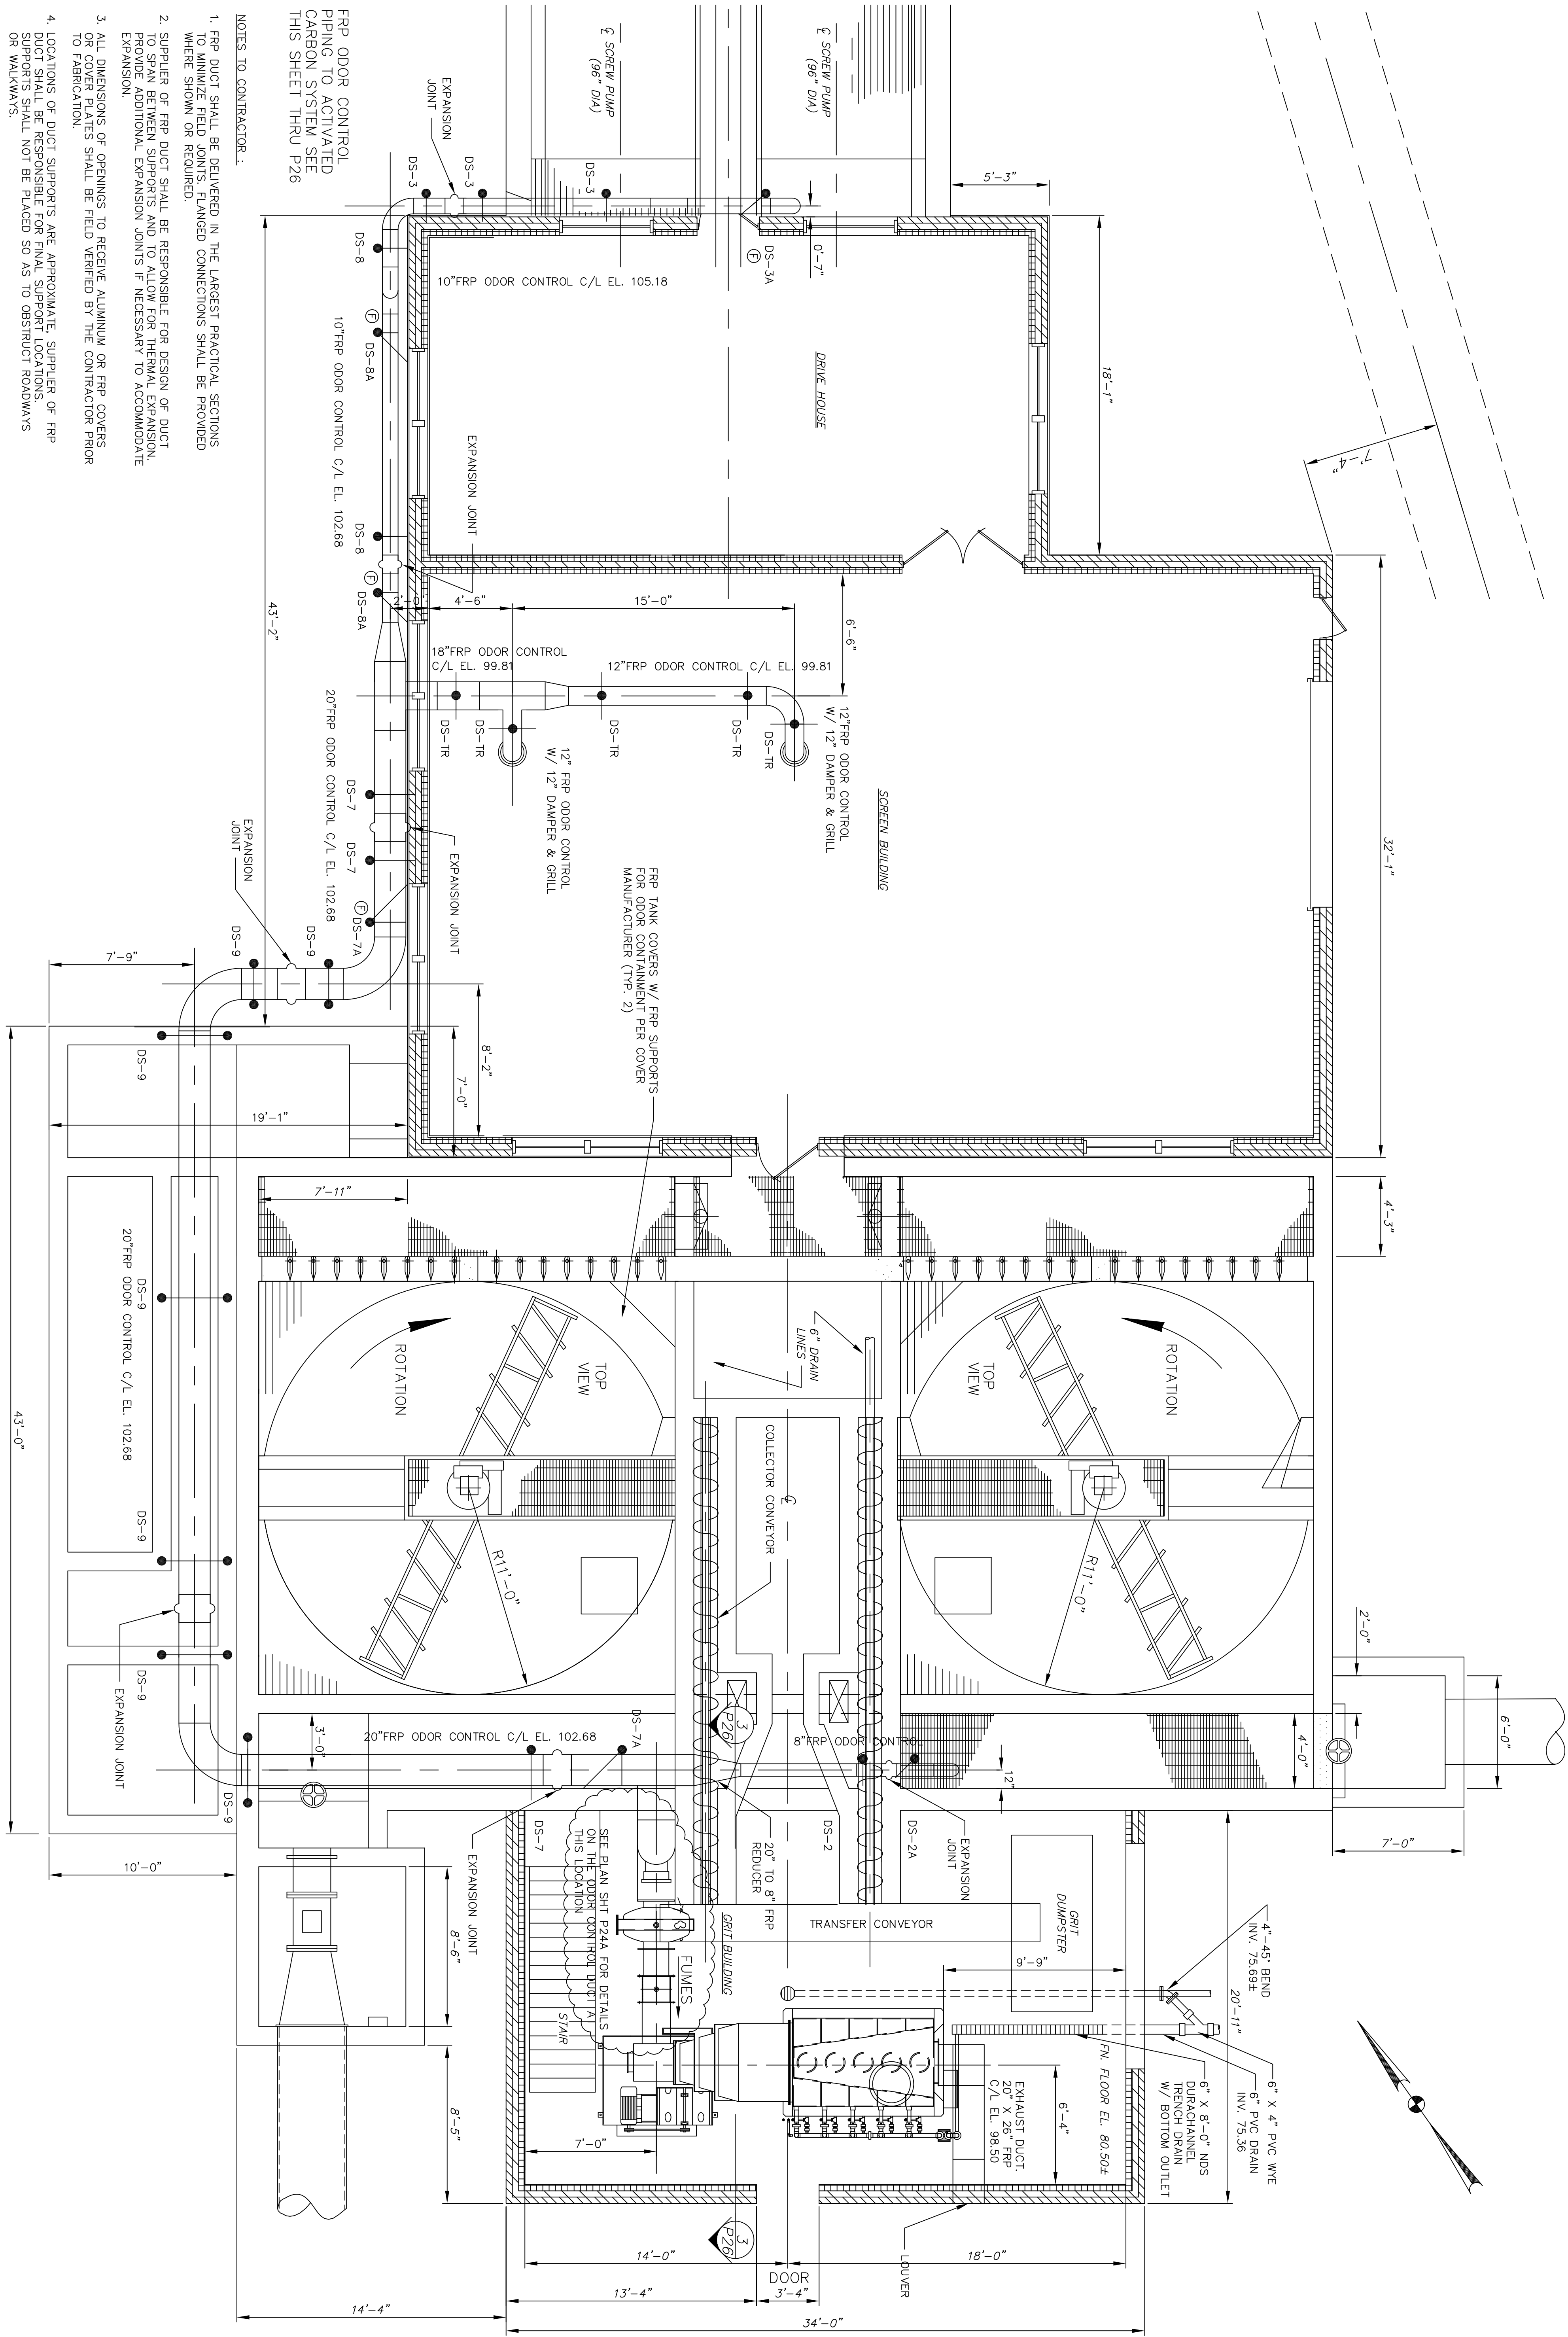

NOTES TO CONTRACTOR:

- FRP DUCT SHALL BE DELIVERED IN THE LARGEST PRACTICAL SECTIONS TO MINIMIZE FIELD JOINTS. FLANGED CONNECTIONS SHALL BE PROVIDED WHERE SHOWN OR REQUIRED.
- SUPPLIER OF FRP DUCT SHALL BE RESPONSIBLE FOR DESIGN OF DUCT TO SPAN BETWEEN SUPPORTS AND TO ALLOW FOR THERMAL EXPANSION. PROVIDE ADDITIONAL EXPANSION JOINTS IF NECESSARY TO ACCOMMODATE EXPANSION.
- ALL DIMENSIONS OF OPENINGS TO RECEIVE ALUMINUM OR FRP COVERS TO FABRICATION.
- LOCATIONS OF DUCT SUPPORTS ARE APPROXIMATE. SUPPLIER OF FRP DUCT SHALL BE RESPONSIBLE FOR FINAL SUPPORT LOCATIONS. SUPPORTS SHALL NOT BE PLACED SO AS TO OBSTRUCT ROADWAYS OR WALKWAYS.
- LOCATION OF ALL EXISTING PIPING AND EQUIPMENT ARE APPROXIMATE. CONTRACTOR SHALL OBTAIN PIPING AND EQUIPMENT PRIOR TO CONSTRUCTING NEW FRP DUCT CONNECTING LINES.
- AT FRP DUCT SUPPORT LOCATIONS WITH THE SYMBOL (F), FRP DUCT SHALL BE ANCHORED (FIXED) TO PREVENT LONGITUDINAL MOVEMENT USING BUILT-UP FRP DUCT COLLARS ON BOTH SIDES OF SUPPORT.
- FOR DUCT SUPPORT DETAILS (DS-...) SEE SHEET P141 & P142.
- CONTRACTOR SHALL FURNISH AND INSTALL FIXED LOUVER AT DISCHARGE OF ODOR EQUIPMENT.

THESE RECORD DOCUMENTS HAVE BEEN PREPARED BASED ON INFORMATION PROVIDED BY OTHERS. CTI ENVIRONMENTAL HAS REVIEWED THE INFORMATION SUBMITTED AND BELIEVES IT REFLECTS THE WORK AS CONSTRUCTED. HOWEVER, ALL PERSONS SHALL VERIFY INFORMATION TAKEN FROM THIS DRAWING.

JOB NO.	E9031
DATE	08/13/01
SCALE	1/4" = 1'-0"
SHEET	P24



ENVIRONMENTAL, INC.
ENGINEERS IN WATER AND EARTH SCIENCES
UNIONTOWN, OHIO

CITY OF MASSILLON, OHIO
WWTP UPGRADE 2000
ODOR CONTROL HEADWORKS – PLAN

DESIGNED BY	REVISIONS				
	NO.	DESCRIPTIONS	DATE	BY	APP'D
WAD	1	RECORD DRAWING	2/9	MGW	WAD
DRAWN BY	TGL				
CHECKED BY	WAD				
APPROVED BY	WAD				

THIS DRAWING IS AN INSTRUMENT OF SERVICE OWNED BY CTI ENVIRONMENTAL, INC. WHICH SHALL BE DEEMED BY THE AUTHOR AND WHICH SHALL RETAIN ALL STATUTORY AND COMMON LAW RIGHTS, INCLUDING COPYRIGHTS. THIS DRAWING SHALL NOT BE SCANNED, COPIED, OR DISTRIBUTED TO OTHERS IN ANY FORM OR USED FOR ANY OTHER PURPOSE OR PROJECT WITHOUT PRIOR WRITTEN CONSENT OF CTI ENVIRONMENTAL, INC. CTI ENVIRONMENTAL, INC. CANNOT GUARANTEE THAT ELECTRONIC COPIES OF THIS DRAWING ARE EXACT DUPLICATES OF THE SEALED ORIGINAL DRAWING. IN THE EVENT OF A CONFLICT BETWEEN AN ELECTRONIC COPY AND THE SEALED ORIGINAL, THE SEALED ORIGINAL SHALL GOVERN.