

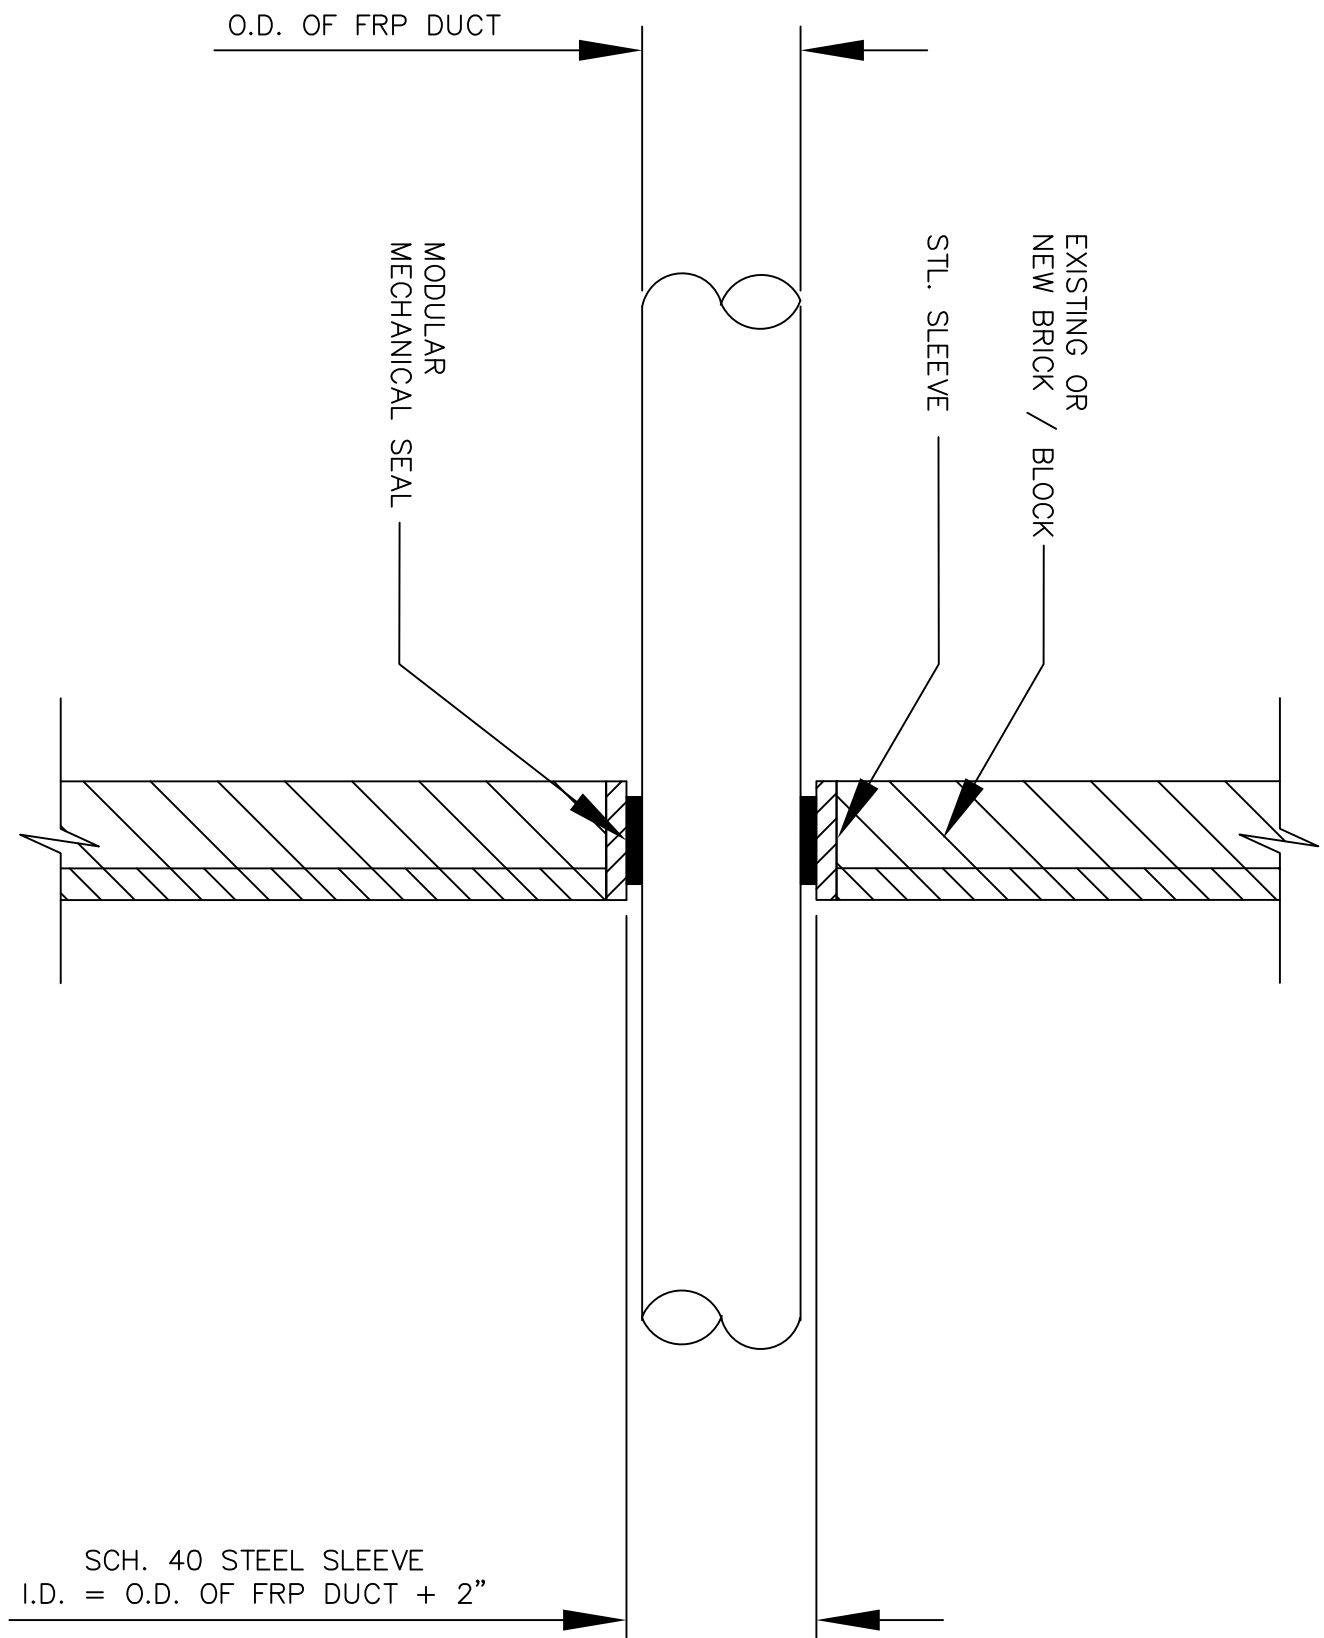


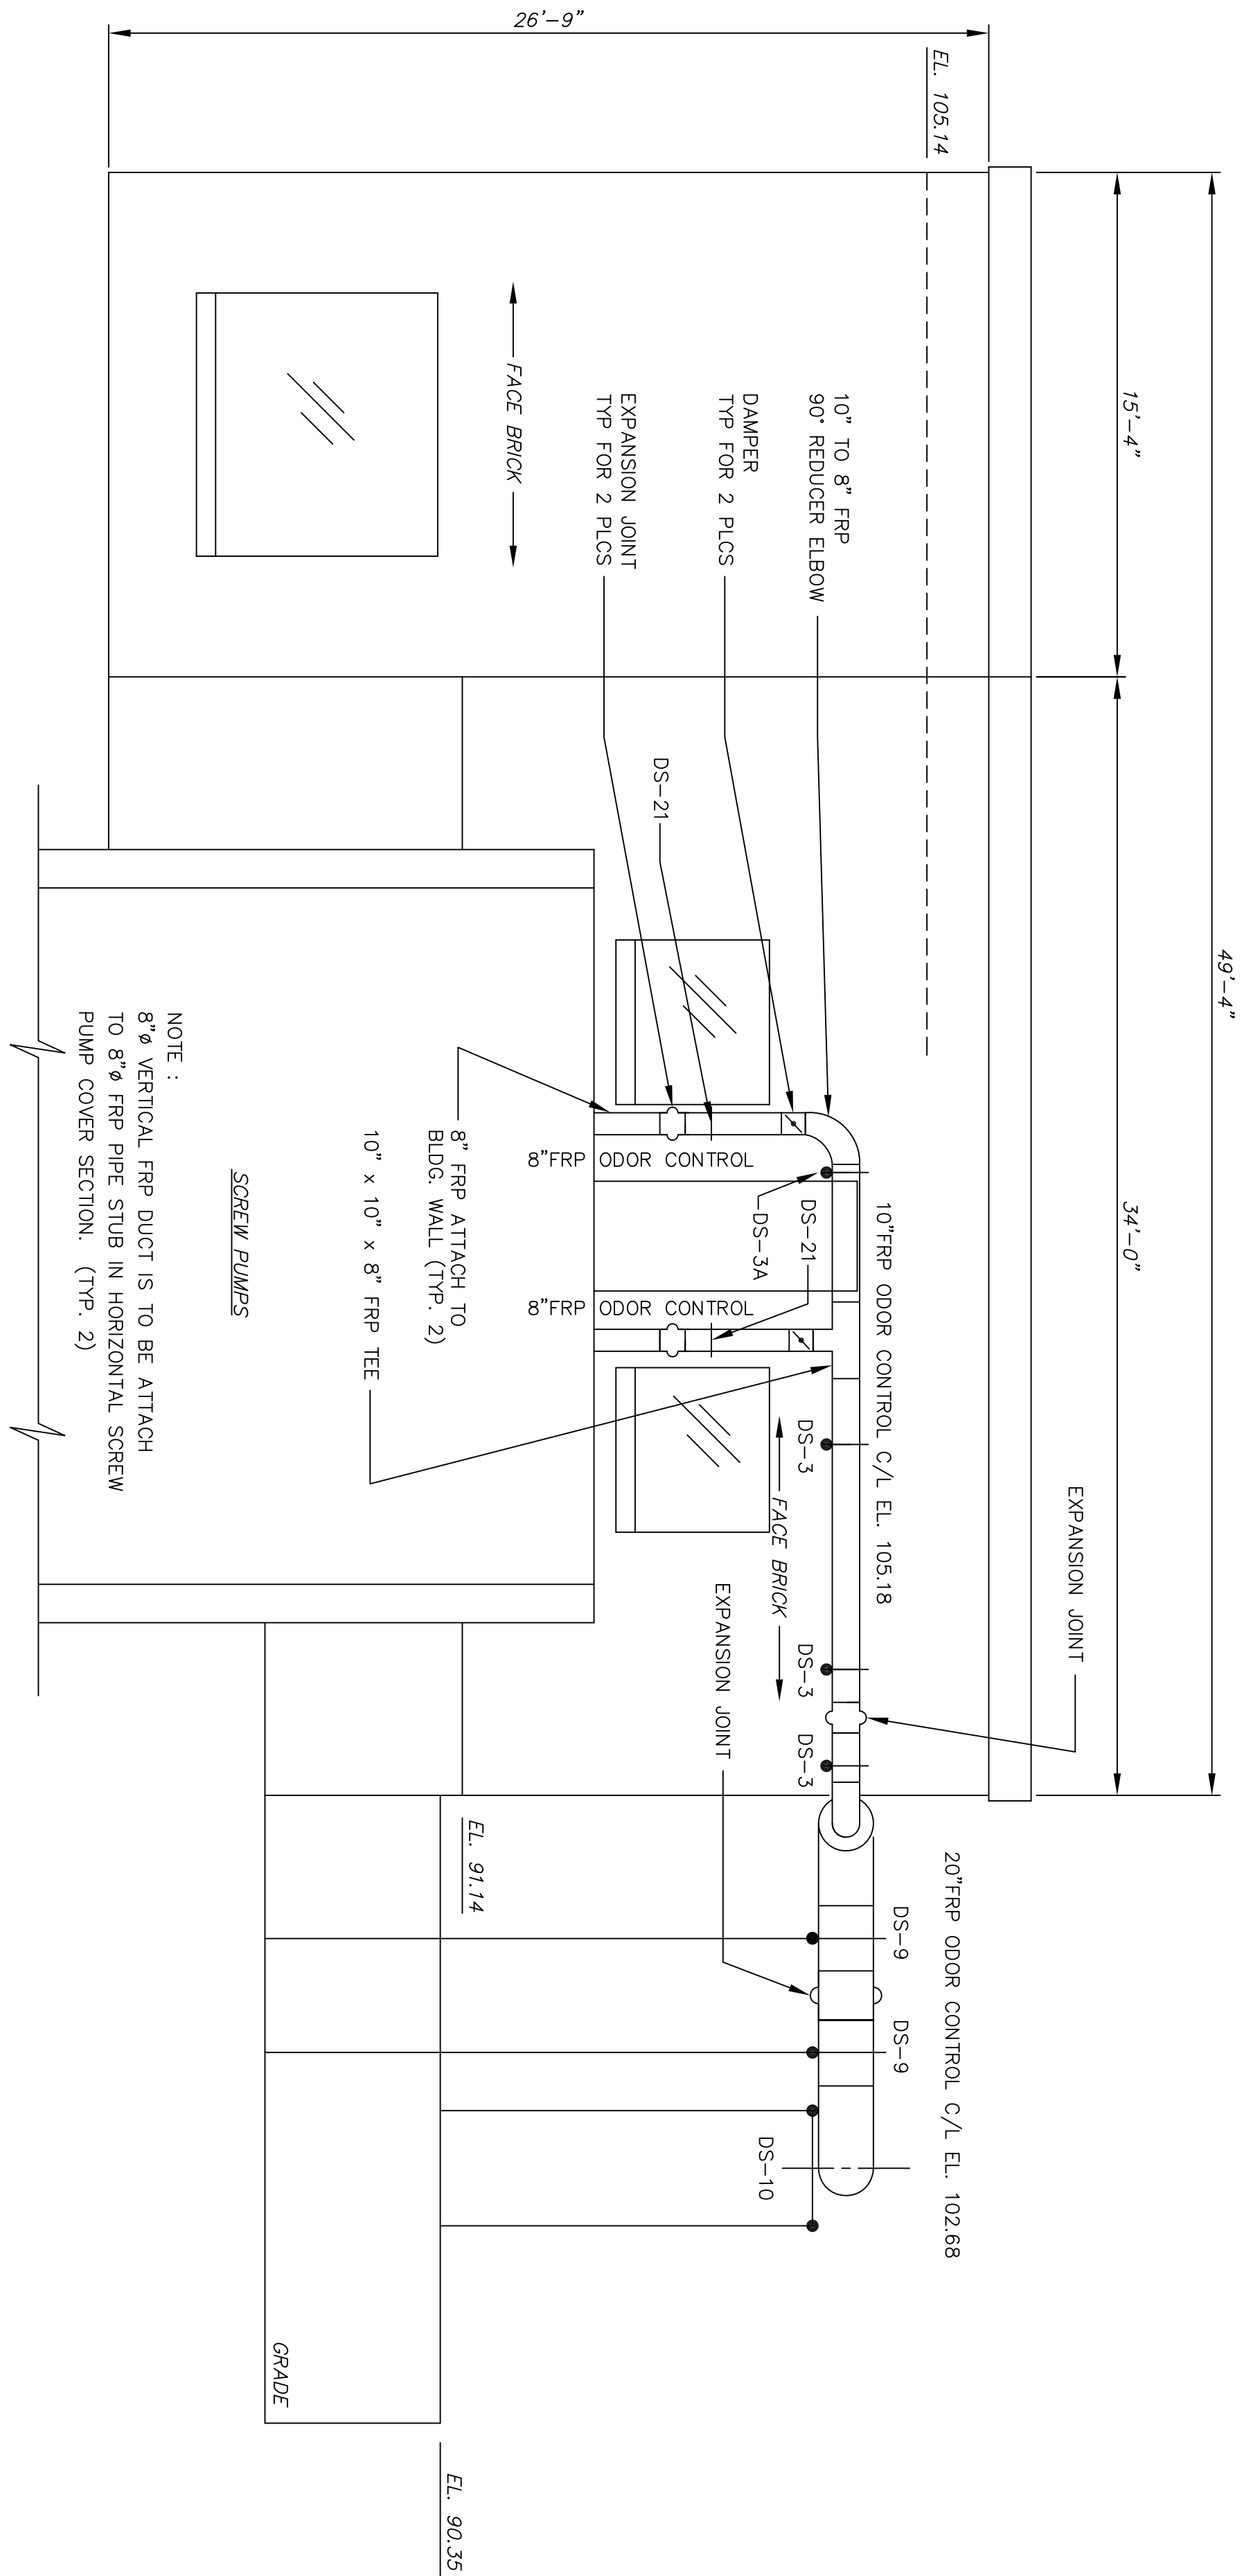


TYPICAL DUCT WALL
PENETRATION DETAIL
SCALE: 1/2" = 1'-0"

NORTH ELEVATION OF DRIVE HOUSE
SCALE: 1/4" = 1'-0"

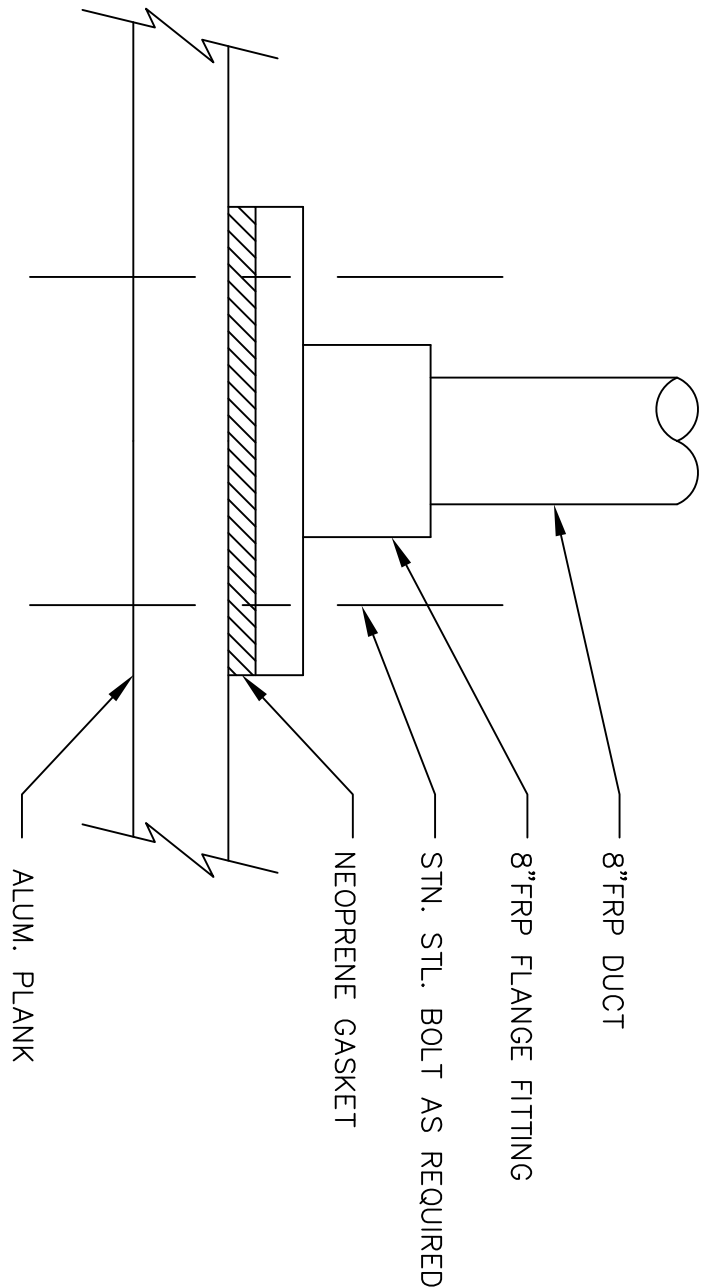

DUCT PENETRATION DETAIL
FOR GRIT TANK GRATING
NOT TO SCALE

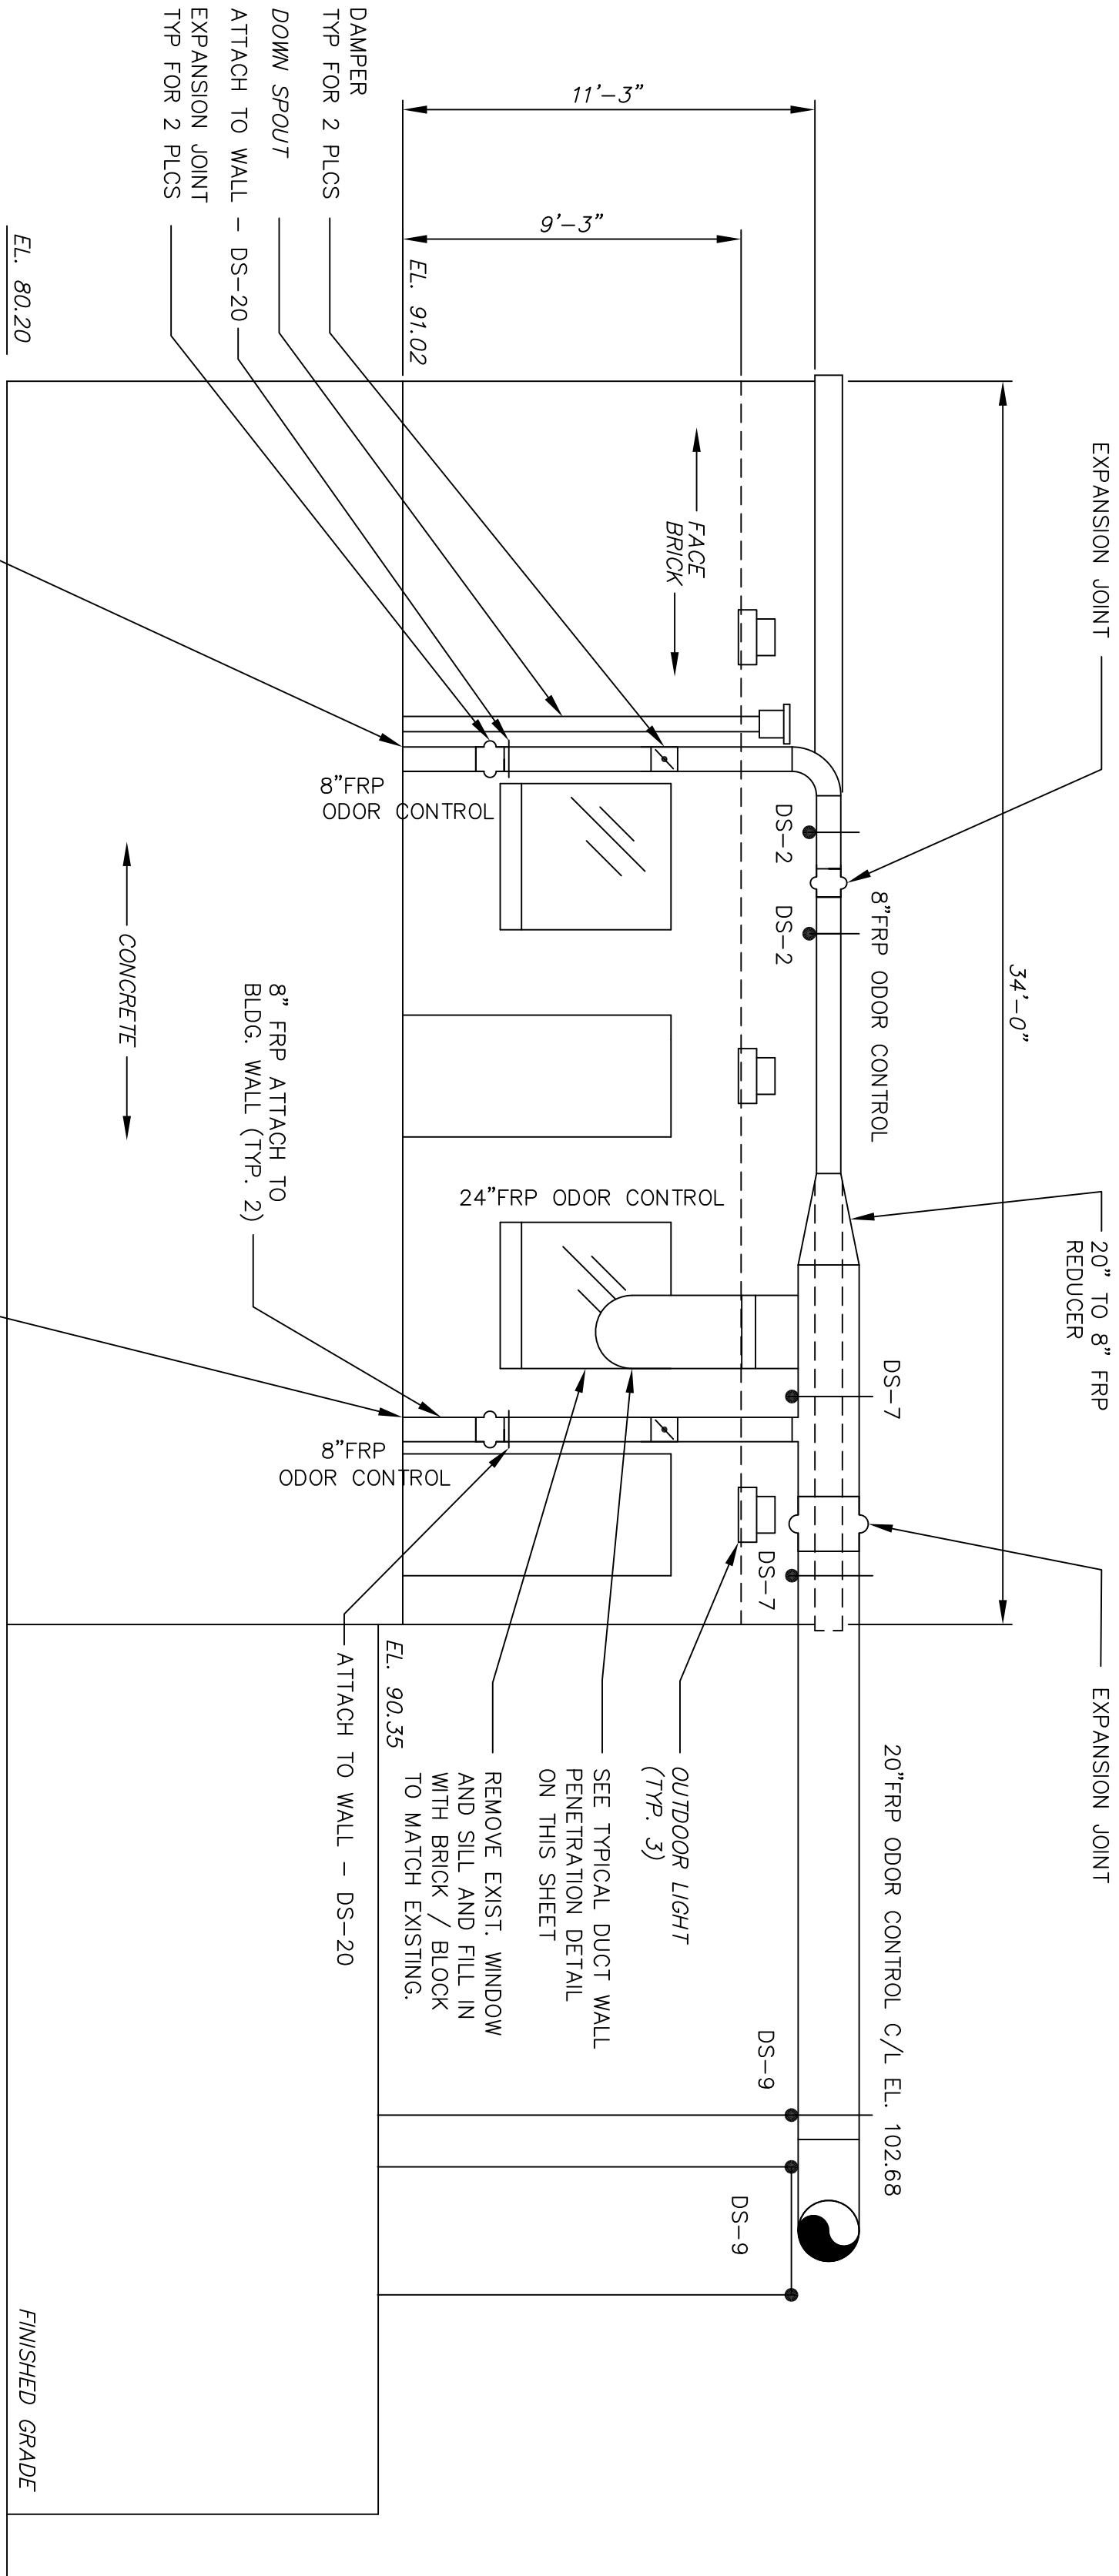

NORTH ELEVATION OF GRIT BUILDING
SCALE: 1/4" = 1'-0"

- NOTES TO CONTRACTOR :
1. FOR GENERAL ODOR CONTROL NOTES 1 THRU 6 SEE SHEET P24.
 2. FOR DUCT SUPPORT DETAILS (DS-1,DS-2,DS-3,DS-6,DS-9,DS-10) SEE SHEET P141 & P142.

THESE RECORD DOCUMENTS HAVE BEEN PREPARED BASED ON INFORMATION PROVIDED BY OTHERS. CTI ENVIRONMENTAL HAS REVIEWED THE INFORMATION SUBMITTED AND BELIEVES IT REFLECTS THE WORK AS CONSTRUCTED. HOWEVER, ALL PERSONS SHALL VERIFY INFORMATION TAKEN FROM THIS DRAWING.

THIS DRAWING IS AN INSTRUMENT OF SERVICE OWNED BY CTI ENVIRONMENTAL, INC. WHICH SHALL BE DEEMED THE AUTHOR AND WHICH SHALL RETAIN ALL STATUTORY AND COMMON LAW RIGHTS, INCLUDING COPYRIGHTS. THIS DRAWING SHALL NOT BE SCANNED, COPIED, OR DISTRIBUTED TO OTHERS IN ANY FORM OR USED FOR ANY OTHER PURPOSE OR PROJECT WITHOUT PRIOR WRITTEN CONSENT OF CTI ENVIRONMENTAL, INC. CTI ENVIRONMENTAL, INC. CANNOT GUARANTEE THAT ELECTRONIC COPIES OF THIS DRAWING ARE EXACT DUPLICATES OF THE SEALED ORIGINAL DRAWING. IN THE EVENT OF A CONFLICT BETWEEN AN ELECTRONIC COPY AND THE SEALED ORIGINAL, THE SEALED ORIGINAL SHALL GOVERN.

DESIGNED BY	REVISIONS					
	NO.	DESCRIPTIONS	DATE	BY	APP'D	
WAD	1	RECORD DRAWING	2/16	MGW	WAD	
DRAWN BY						
TGL						
CHECKED BY						
WAD						
APPROVED BY						
WAD						

ENVIRONMENTAL, INC.
ENGINEERS IN WATER AND EARTH SCIENCES
UNIONTOWN, OHIO

CITY OF MASSILLON, OHIO
WWTP UPGRADE 2000
ODOR CONTROL HEADWORKS – ELEVATIONS



JOB NO.
E9031

DATE
08/13/01

SCALE
AS NOTED

SHEET
P25