


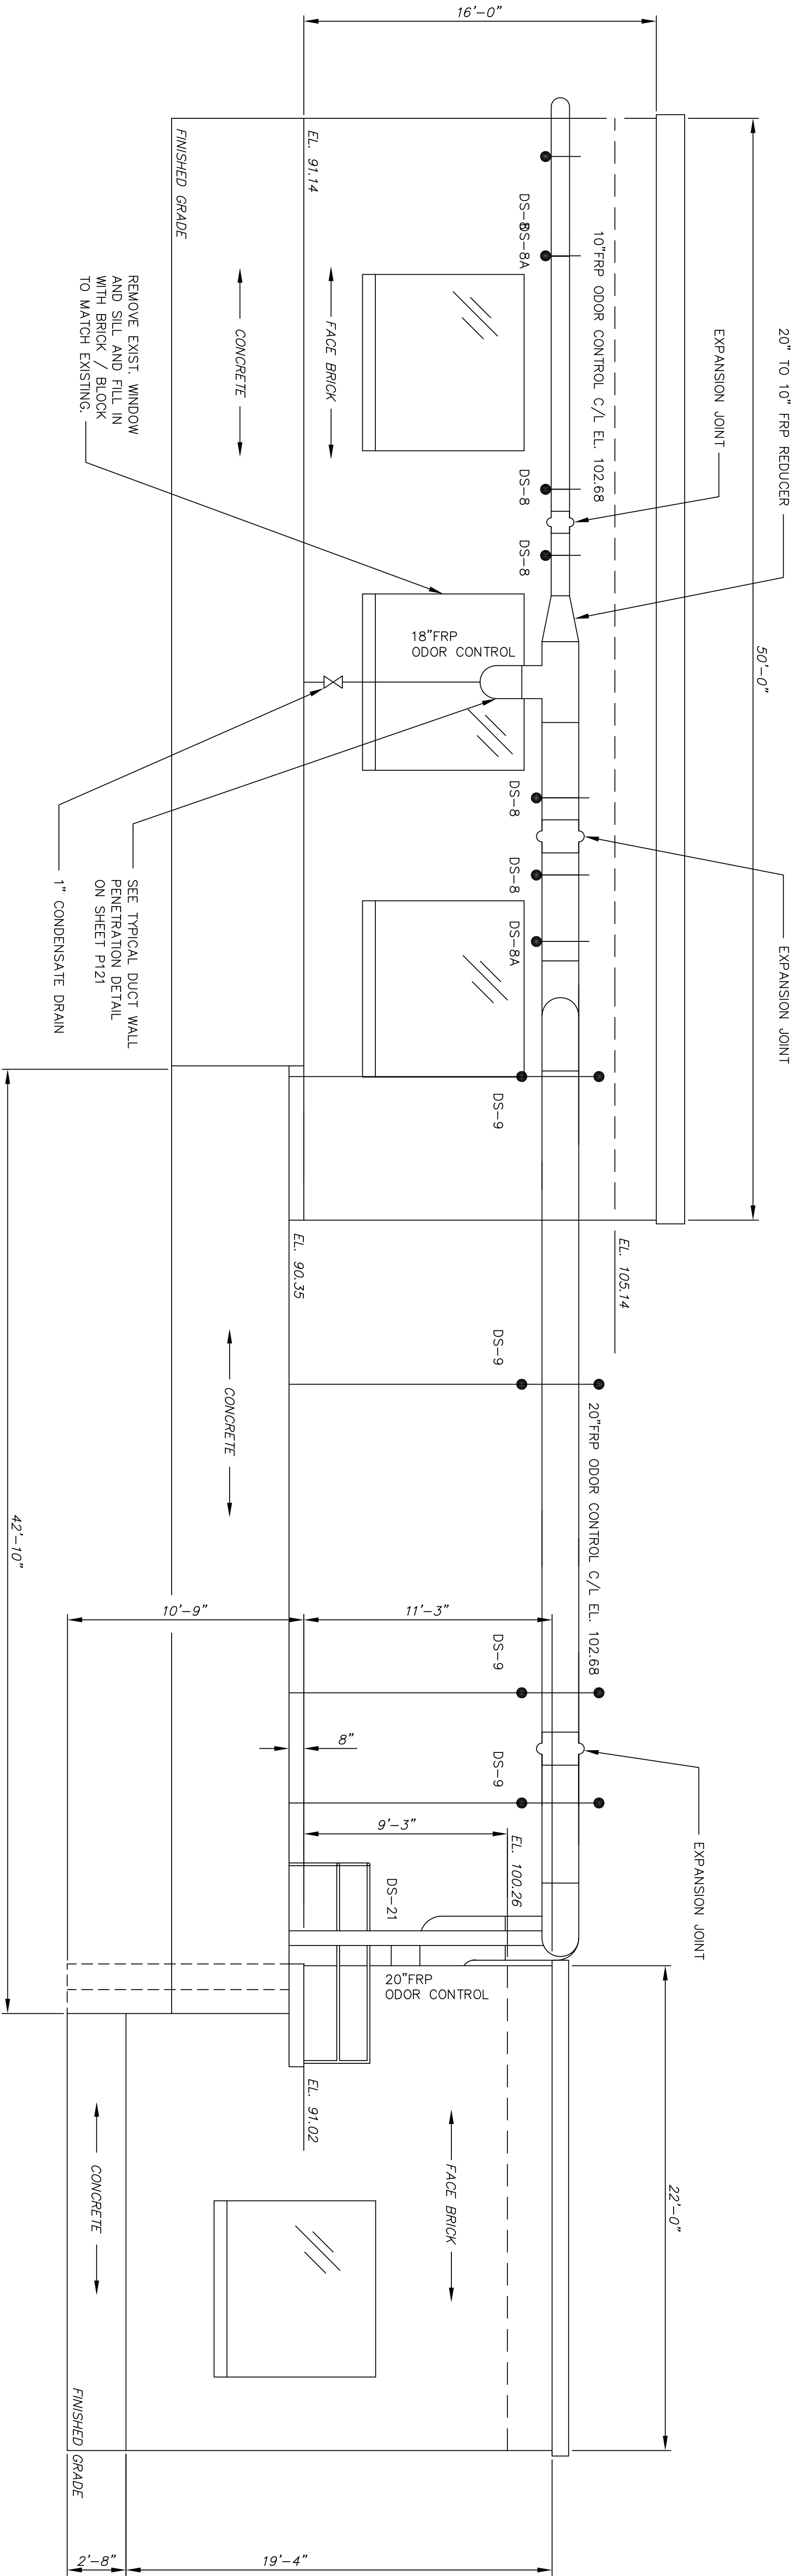


NOTES TO CONTRACTOR :

1. FOR GENERAL ODOR CONTROL NOTES 1 THRU 6 SEE SHEET P24
2. FOR DUCT SUPPORT DETAILS (DS-1,DS-1,DS-3,DS-6,DS-9,DS-10) SEE SHEETS P141 & P142.

WEST ELEVATION OF DRIVE HOUSE, SCREEN BUILDING, GRIT TANKS & GRIT BUILDING

SCALE: 1/4" = 1'-0"

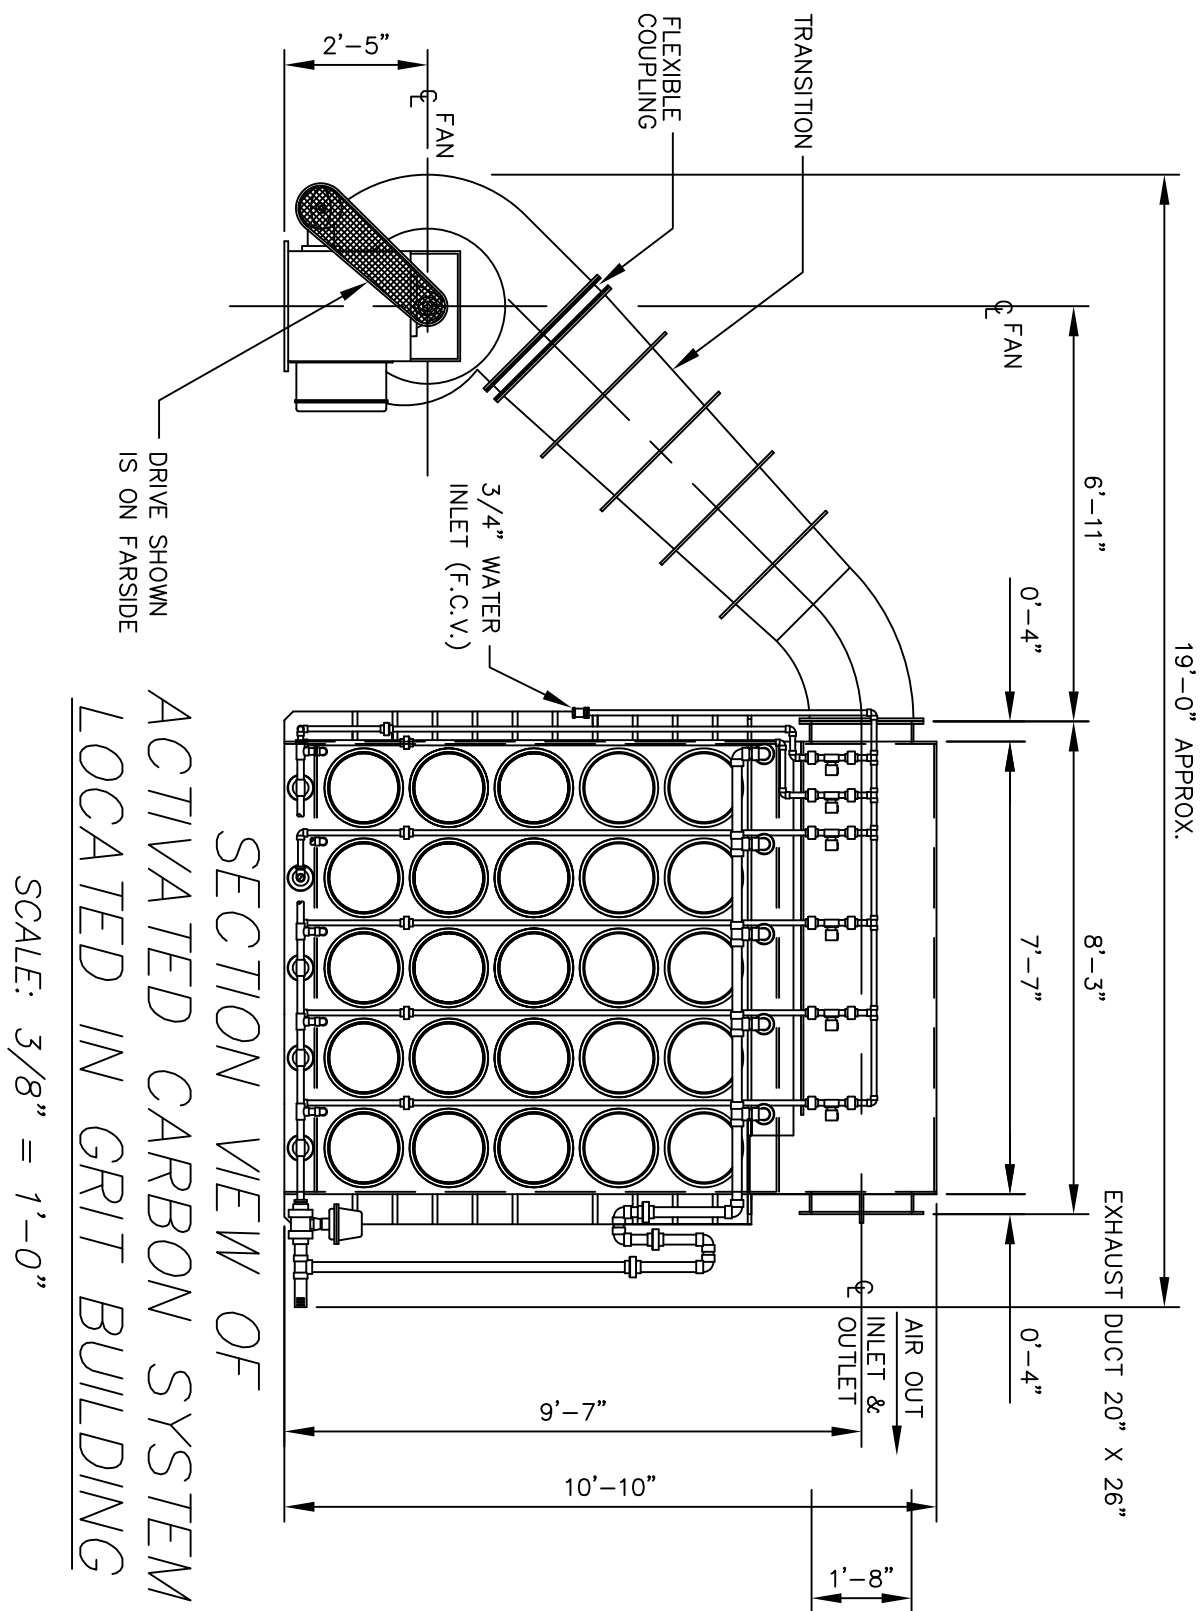

THIS DRAWING IS AN INSTRUMENT OF SERVICE OWNED BY CTI ENVIRONMENTAL, INC. WHICH SHALL BE DEEMED THE AUTHOR AND WHICH SHALL RETAIN ALL STATUTORY AND COMMON LAW RIGHTS, INCLUDING COPYRIGHTS. THIS DRAWING SHALL NOT BE SCANNED, COPIED, OR DISTRIBUTED TO OTHERS IN ANY FORM OR USED FOR ANY OTHER PURPOSE OR PROJECT WITHOUT PRIOR WRITTEN CONSENT OF CTI ENVIRONMENTAL, INC. CTI ENVIRONMENTAL, INC. CANNOT GUARANTEE THAT ELECTRONIC COPIES OF THIS DRAWING ARE EXACT DUPLICATES OF THE SEALED ORIGINAL DRAWING. IN THE EVENT OF A CONFLICT BETWEEN AN ELECTRONIC COPY AND THE SEALED ORIGINAL, THE SEALED ORIGINAL SHALL GOVERN.

REVISIONS					
NO.	DESCRIPTIONS	DATE	BY	APP'D	
1	RECORD DRAWING	2/10	MGW	WAD	

DESIGNED BY WAD	CHECKED BY WAD	APPROVED BY WAD
DRAWN BY TGL		



ENVIRONMENTAL, INC.
ENGINEERS IN WATER AND EARTH SCIENCES
UNIONTOWN, OHIO

CITY OF MASSILLON, OHIO
WWTP UPGRADE 2000
ODOR CONTROL HEADWORKS – ELEVATION

JOB NO. E9031	DATE 08/13/01	SCALE AS NOTED	SHEET P26
------------------	------------------	-------------------	--------------