


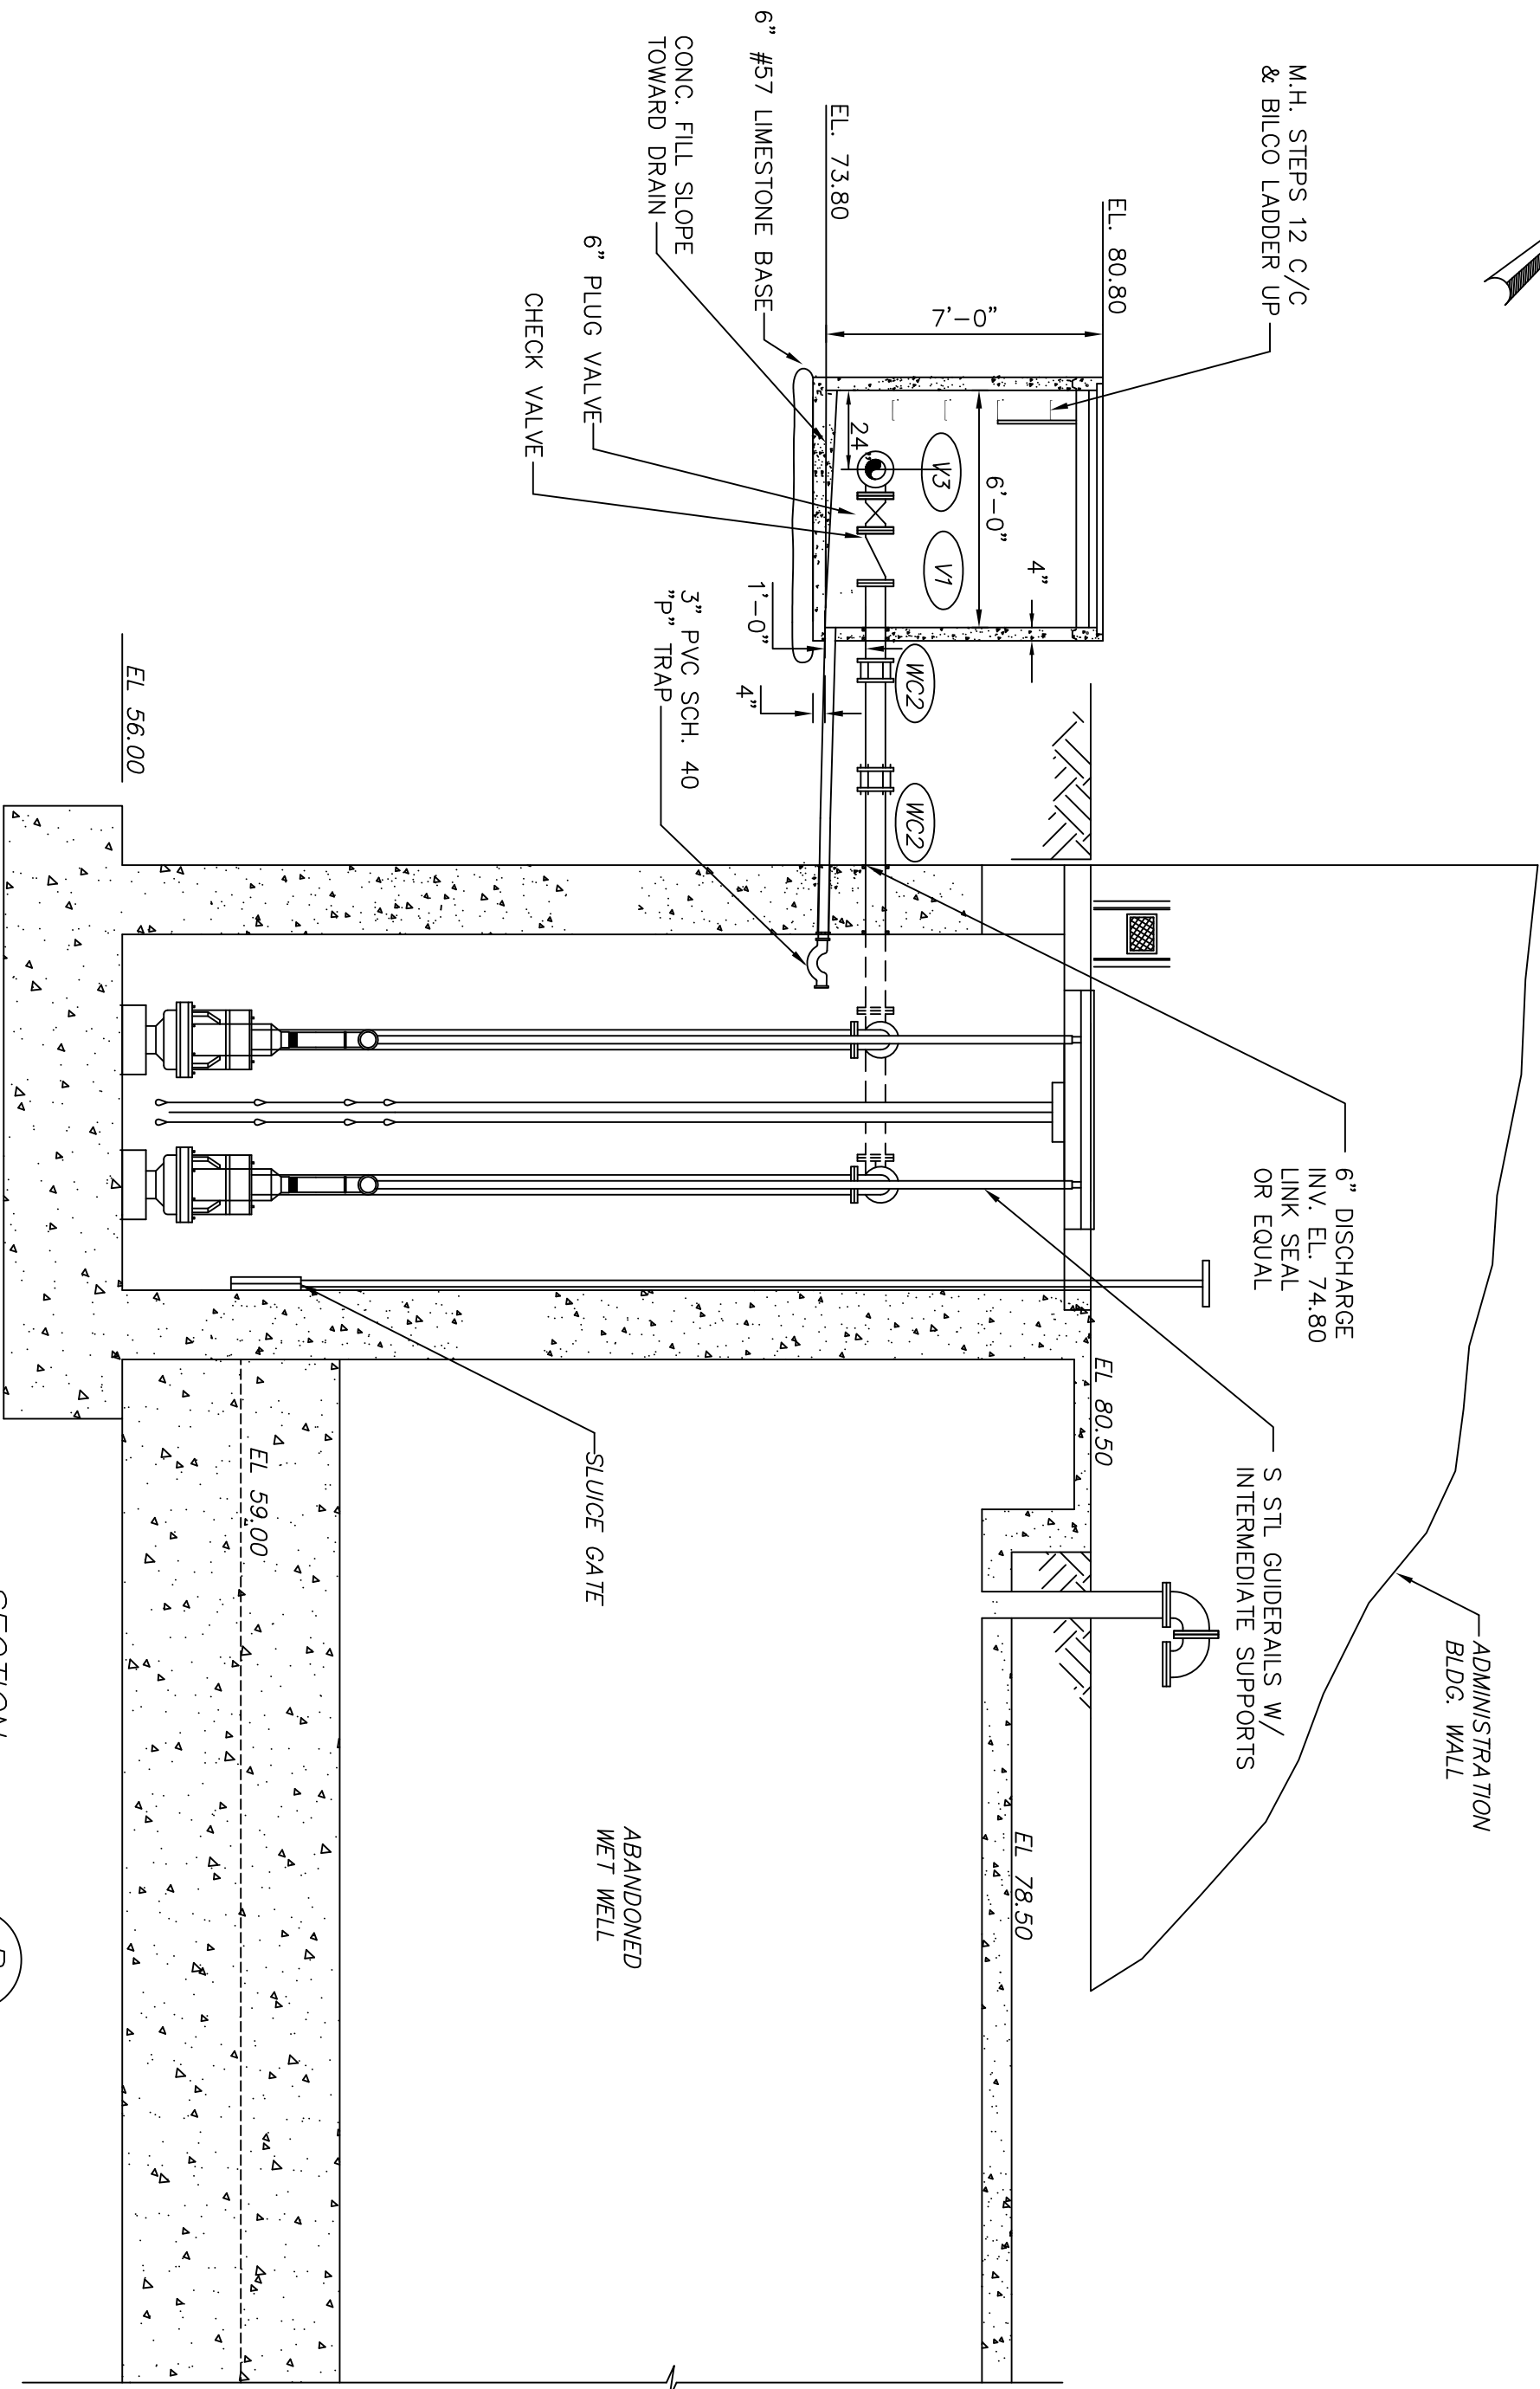


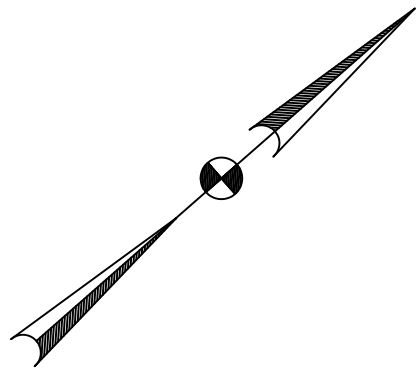


SECTION B
SCALE : 1/4"=1'-0"

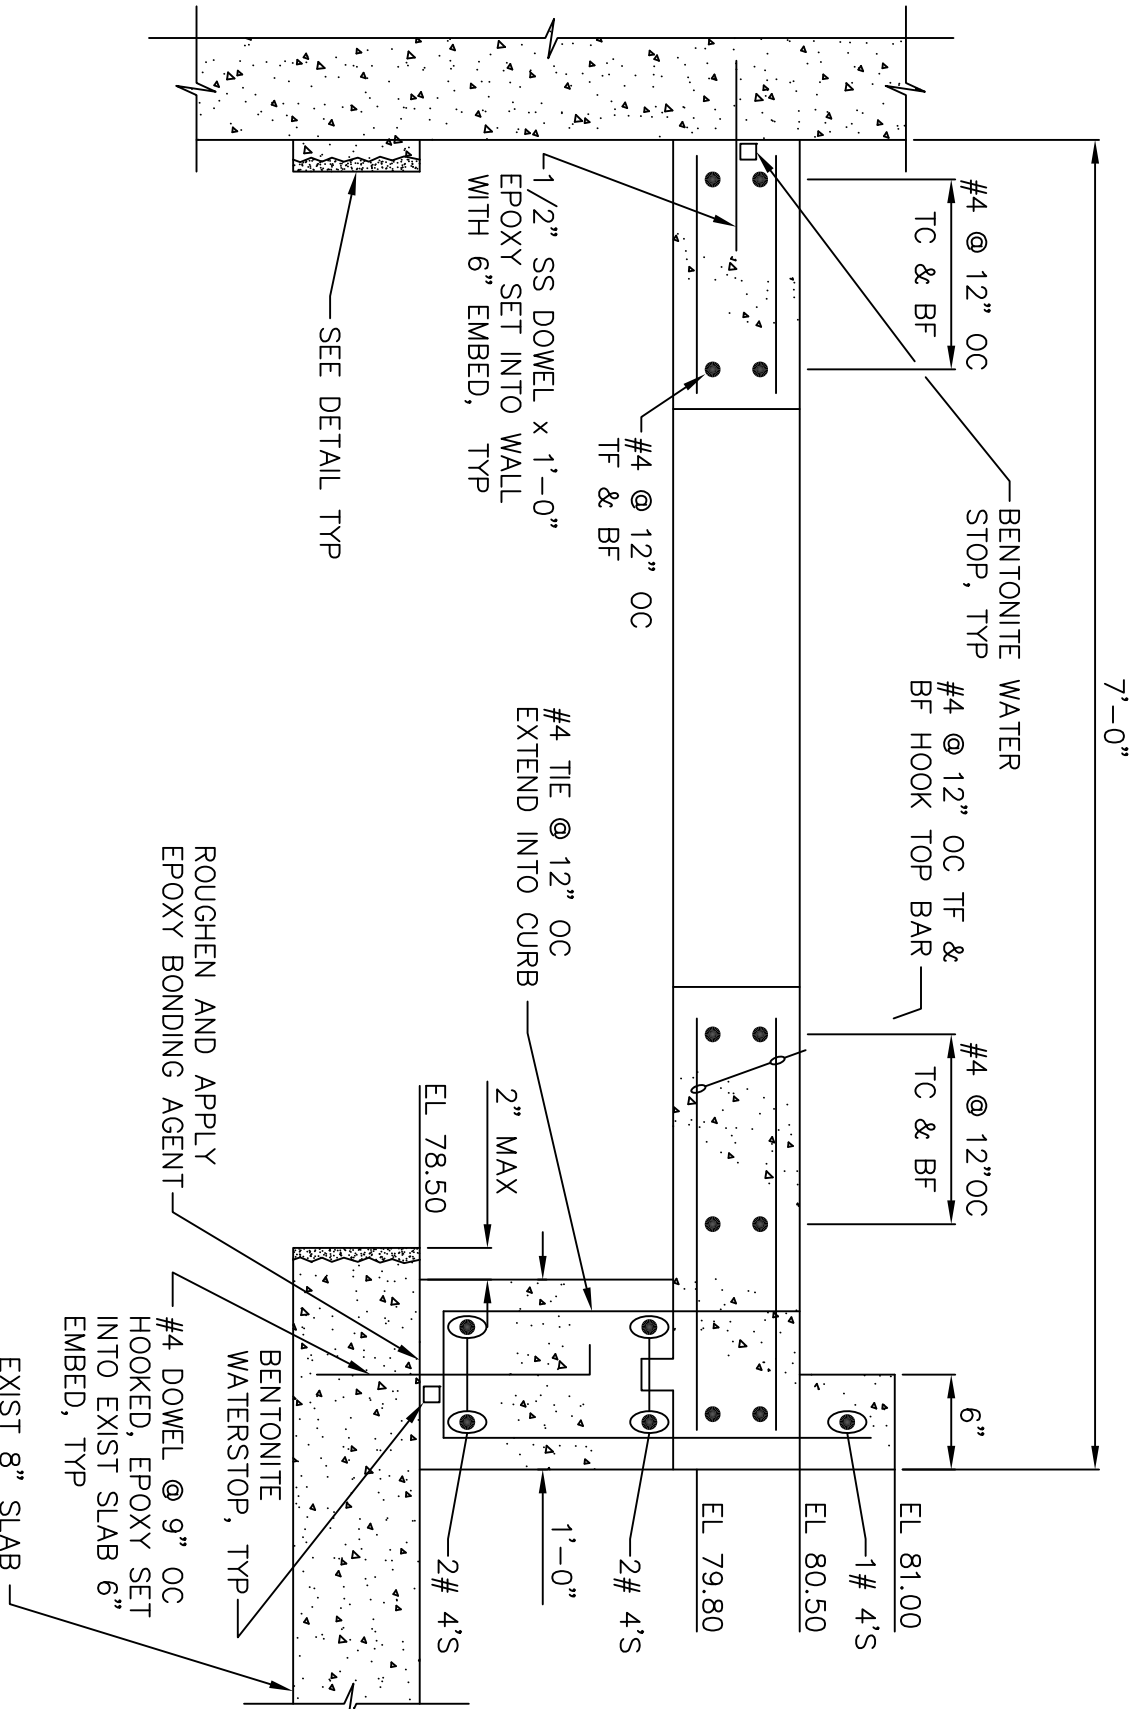



SECTION 2
SCALE : 1"=1'-0"

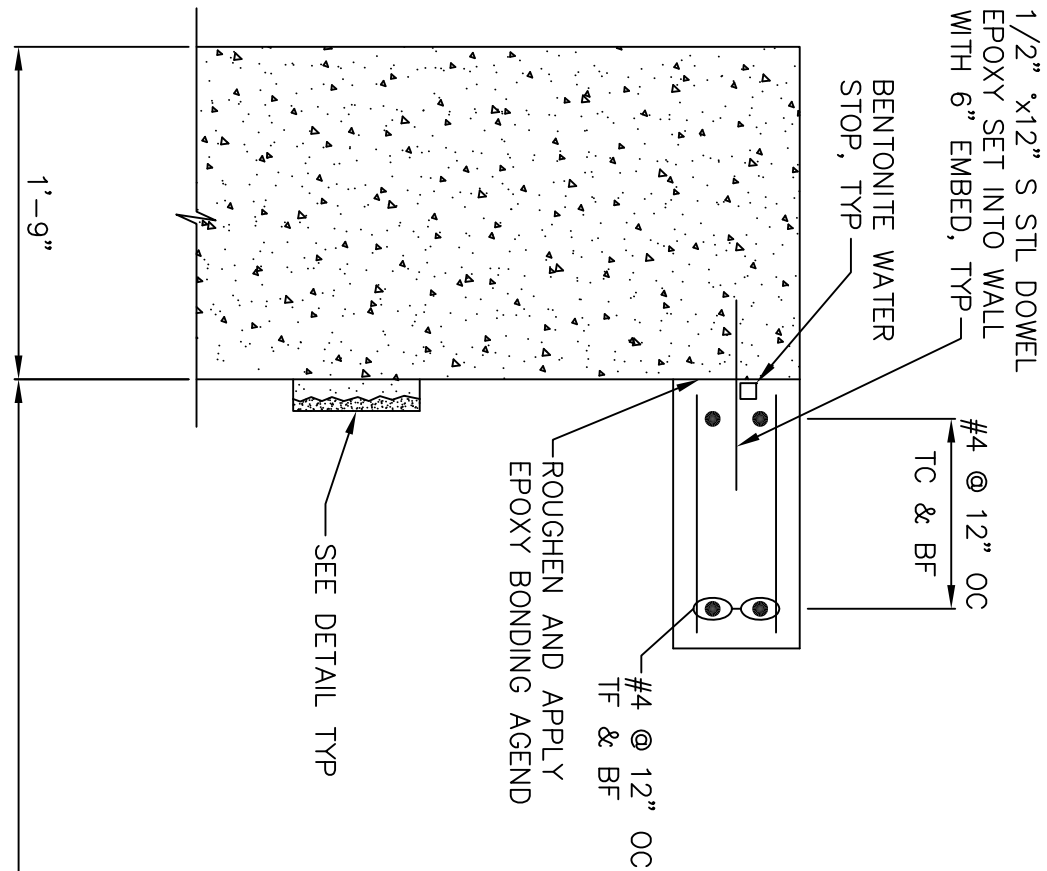

SECTION 3
SCALE : 1"=1'-0"

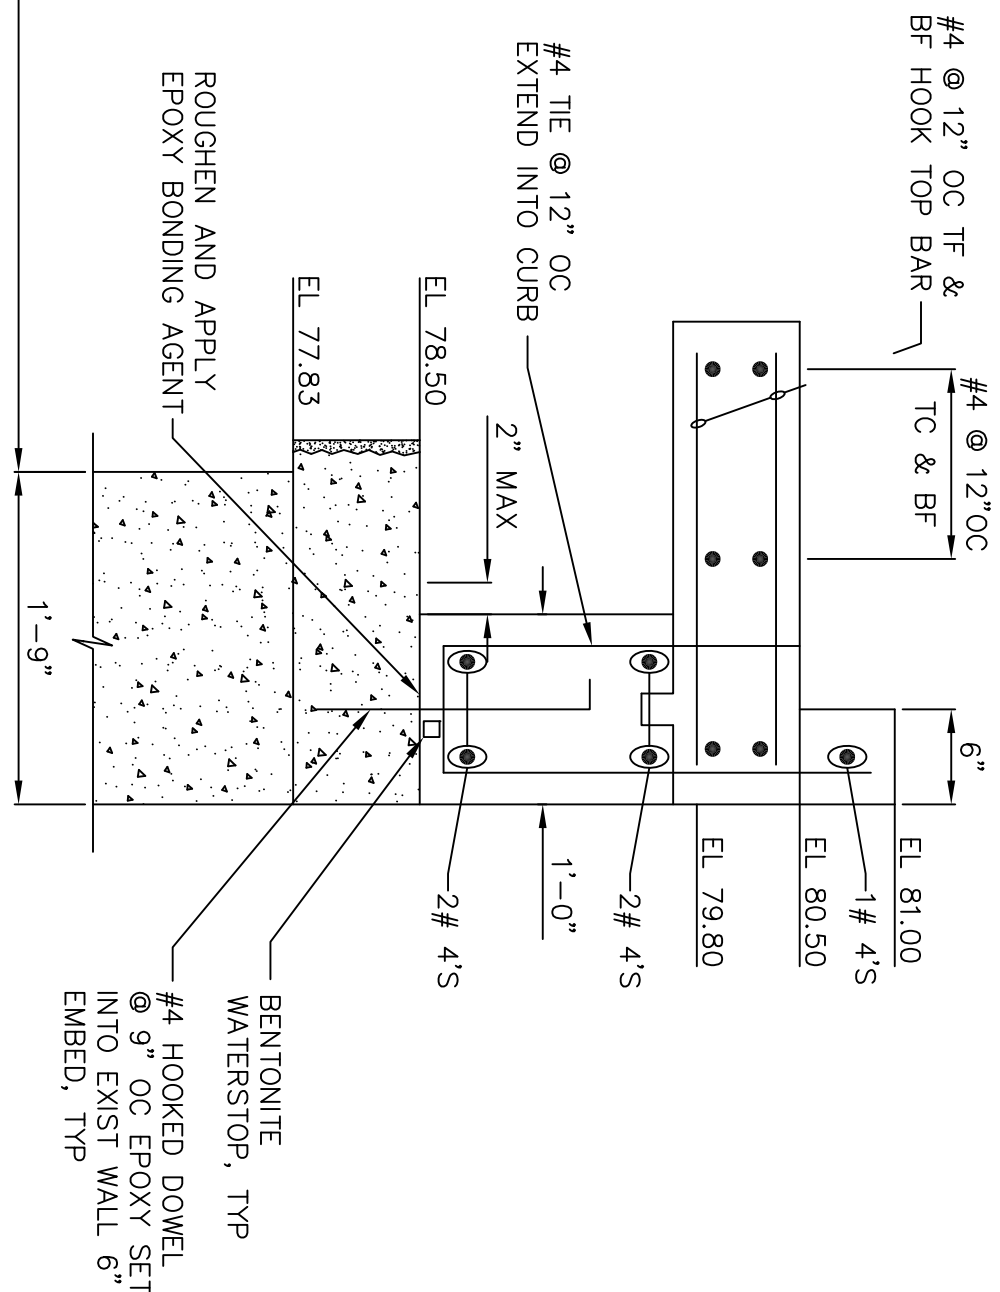

SECTION A
SCALE : 1/4"=1'-0"

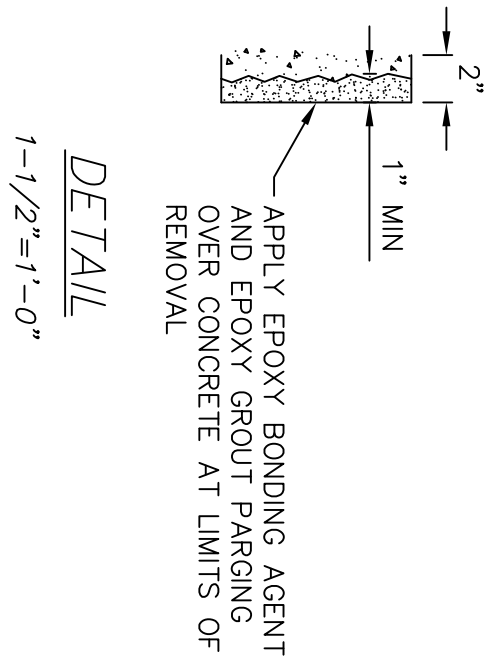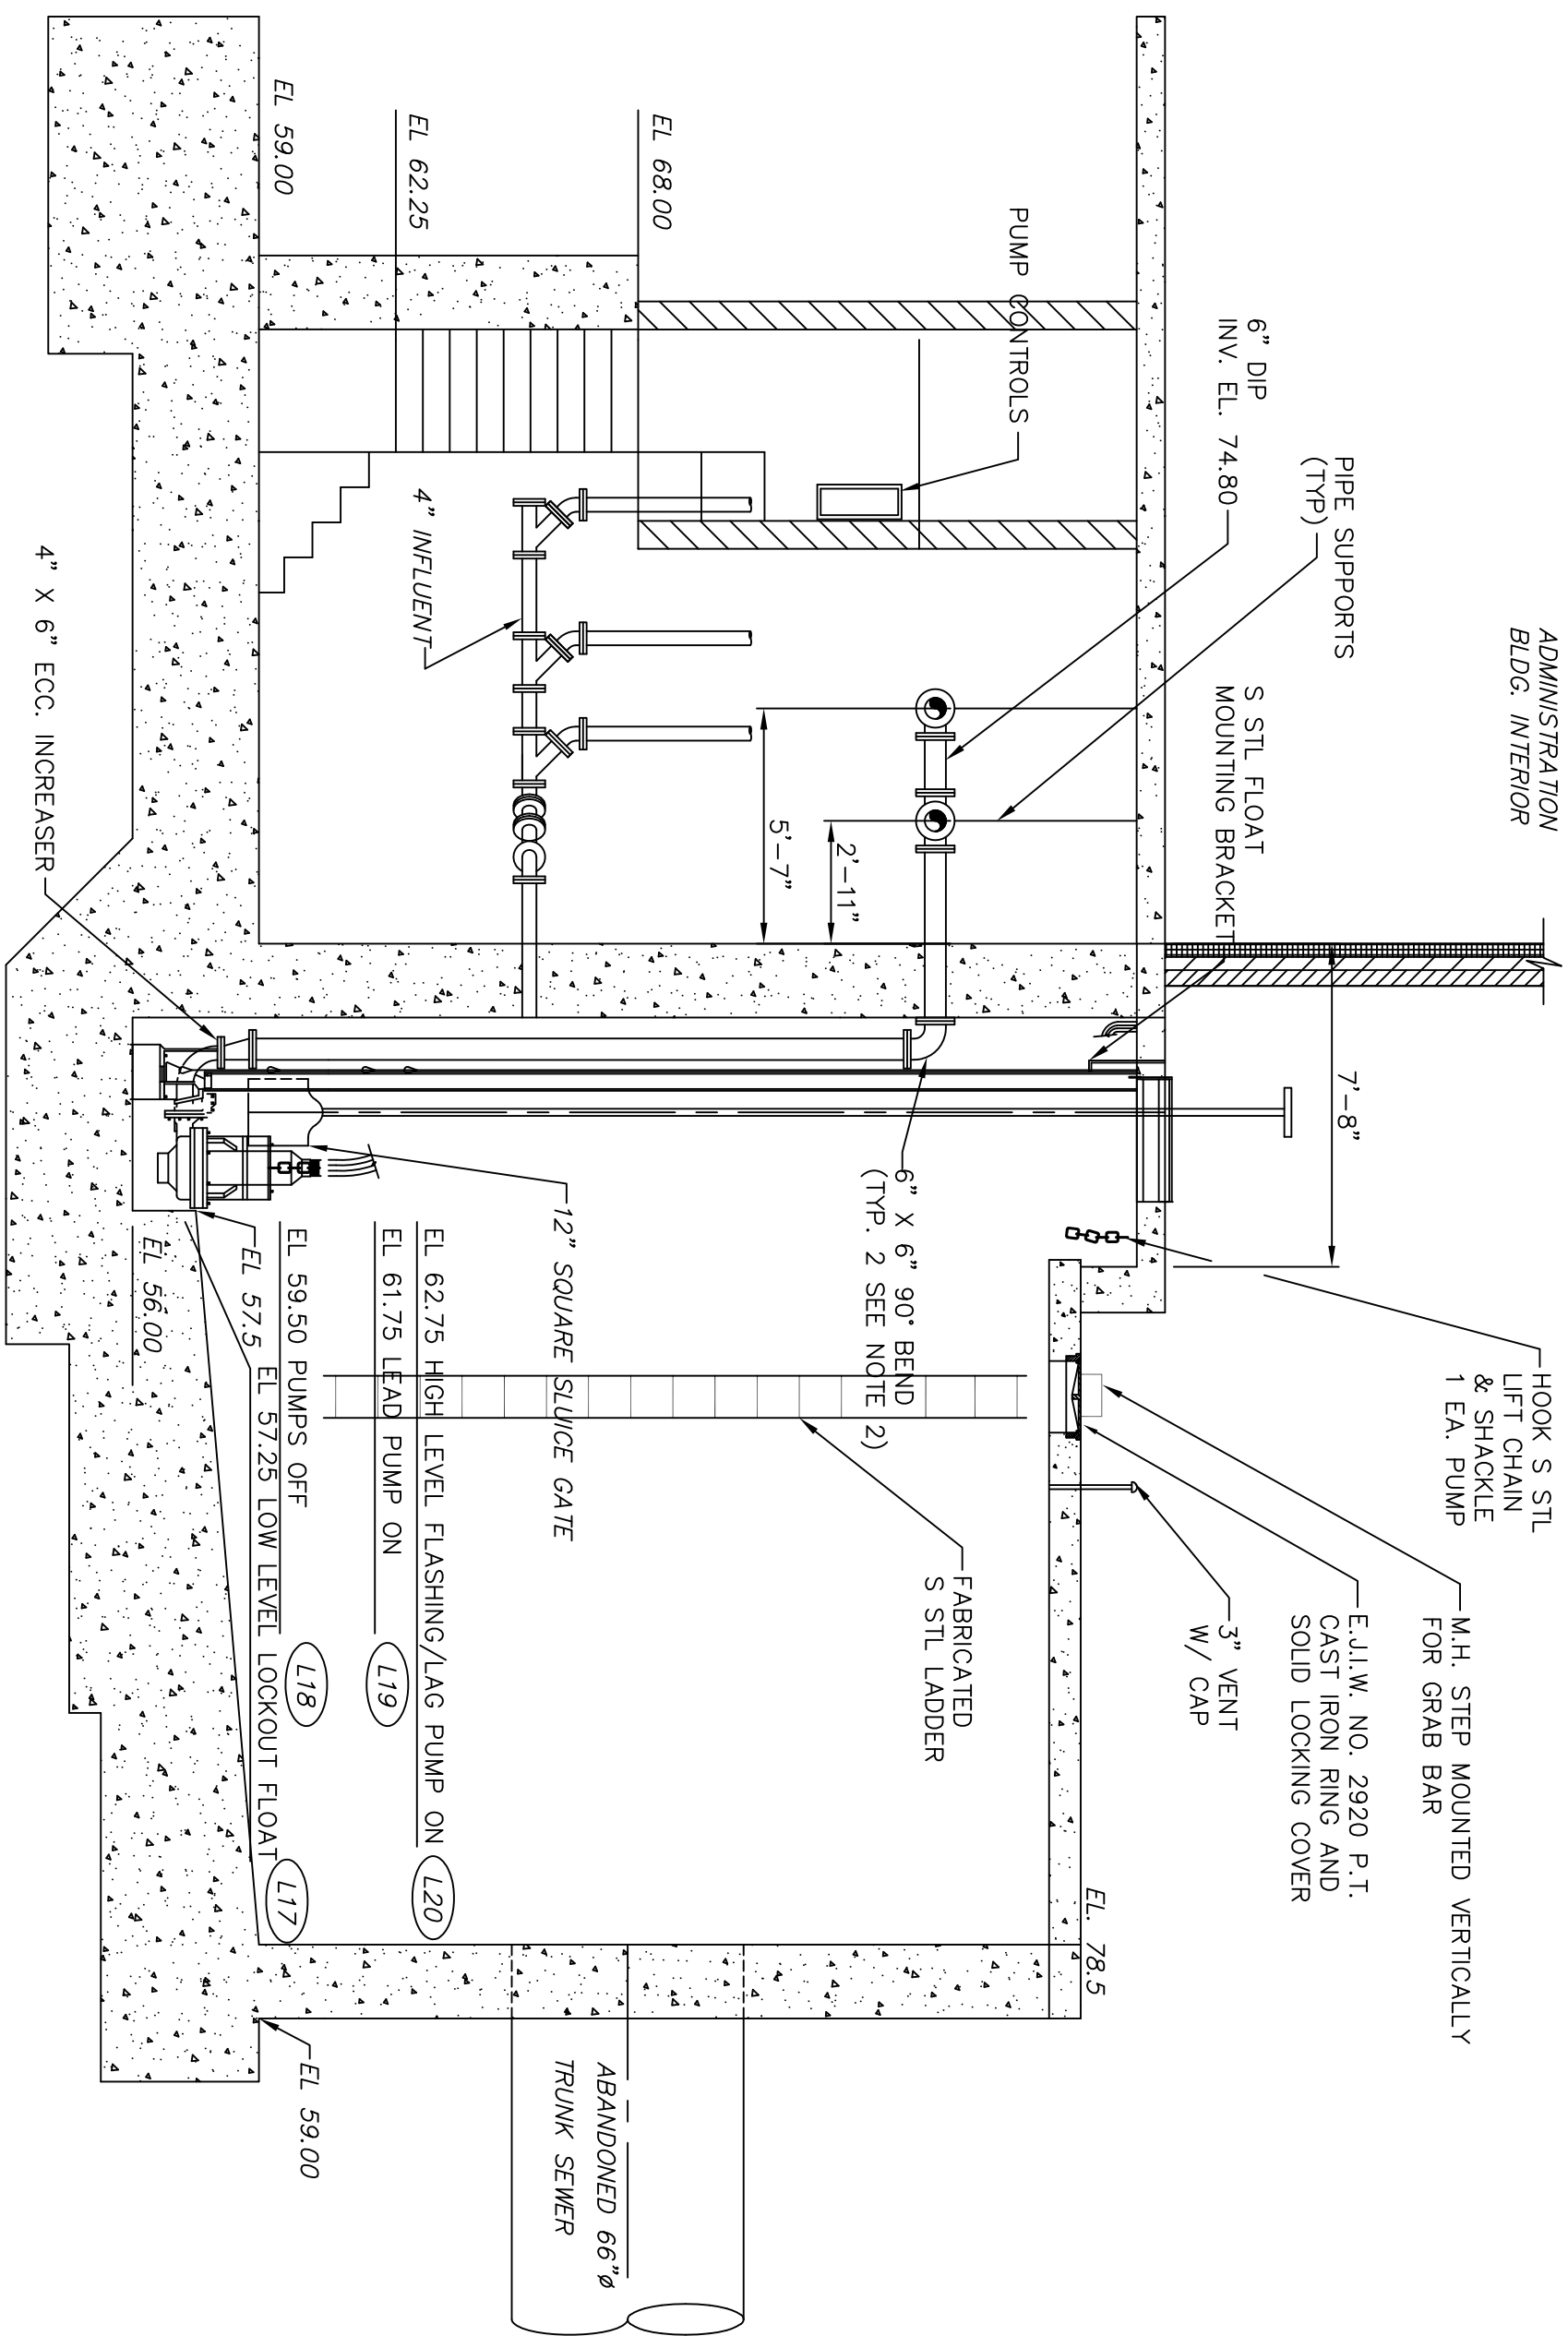

NOTES TO CONTRACTOR

1. CONTRACTOR TO VERIFY INCREASER SIZE REQUIRED BASED ON PUMP MANUFACTURER SELECTED.
2. ALL PIPE PENETRATIONS THROUGH WALLS OF THE WET WELL, VALVE VAULT, AND BLDG. WALL SHALL CONTAIN LINK SEAL OR EQUAL.



ENVIRONMENTAL, INC.
ENGINEERS IN WATER AND EARTH SCIENCES
UNIONTOWN, OHIO

CITY OF MASSILLON, OHIO
WWTP UPGRADE 2000
ADMINISTRATION BUILDING PUMP STATION
SECTIONS

DESIGNED BY	REVISIONS				
	NO.	DESCRIPTIONS	DATE	BY	APP'D
TMK	1	RECORD DRAWING	4/05	MGW	WAD
DRAWN BY	CRF				
CHECKED BY	RWR				
APPROVED BY	WAD				

THIS DRAWING IS AN INSTRUMENT OF SERVICE OWNED BY CTI ENVIRONMENTAL, INC. WHICH SHALL BE DEEMED THE AUTHOR AND WHICH SHALL RETAIN ALL STATUTORY AND COMMON LAW RIGHTS, INCLUDING COPYRIGHTS. THIS DRAWING SHALL NOT BE SCANNED, COPIED, OR DISTRIBUTED TO OTHERS IN ANY FORM OR USED FOR ANY OTHER PURPOSE OR PROJECT WITHOUT PRIOR WRITTEN CONSENT OF CTI ENVIRONMENTAL, INC. CTI ENVIRONMENTAL, INC. CANNOT GUARANTEE THAT ELECTRONIC COPIES OF THIS DRAWING ARE EXACT DUPLICATES OF THE SEALED ORIGINAL DRAWING. IN THE EVENT OF A CONFLICT BETWEEN AN ELECTRONIC COPY AND THE SEALED ORIGINAL, THE SEALED ORIGINAL SHALL GOVERN.

THESE RECORD DOCUMENTS HAVE BEEN PREPARED BASED ON INFORMATION PROVIDED BY OTHERS. CTI ENVIRONMENTAL HAS REVIEWED THE INFORMATION SUBMITTED AND BELIEVES IT REFLECTS THE WORK AS CONSTRUCTED. HOWEVER, ALL PERSONS SHALL VERIFY INFORMATION TAKEN FROM THIS DRAWING.

DWG NO.
E9031
DATE
08/13/01
SCALE
AS NOTED
SHEET
P35