
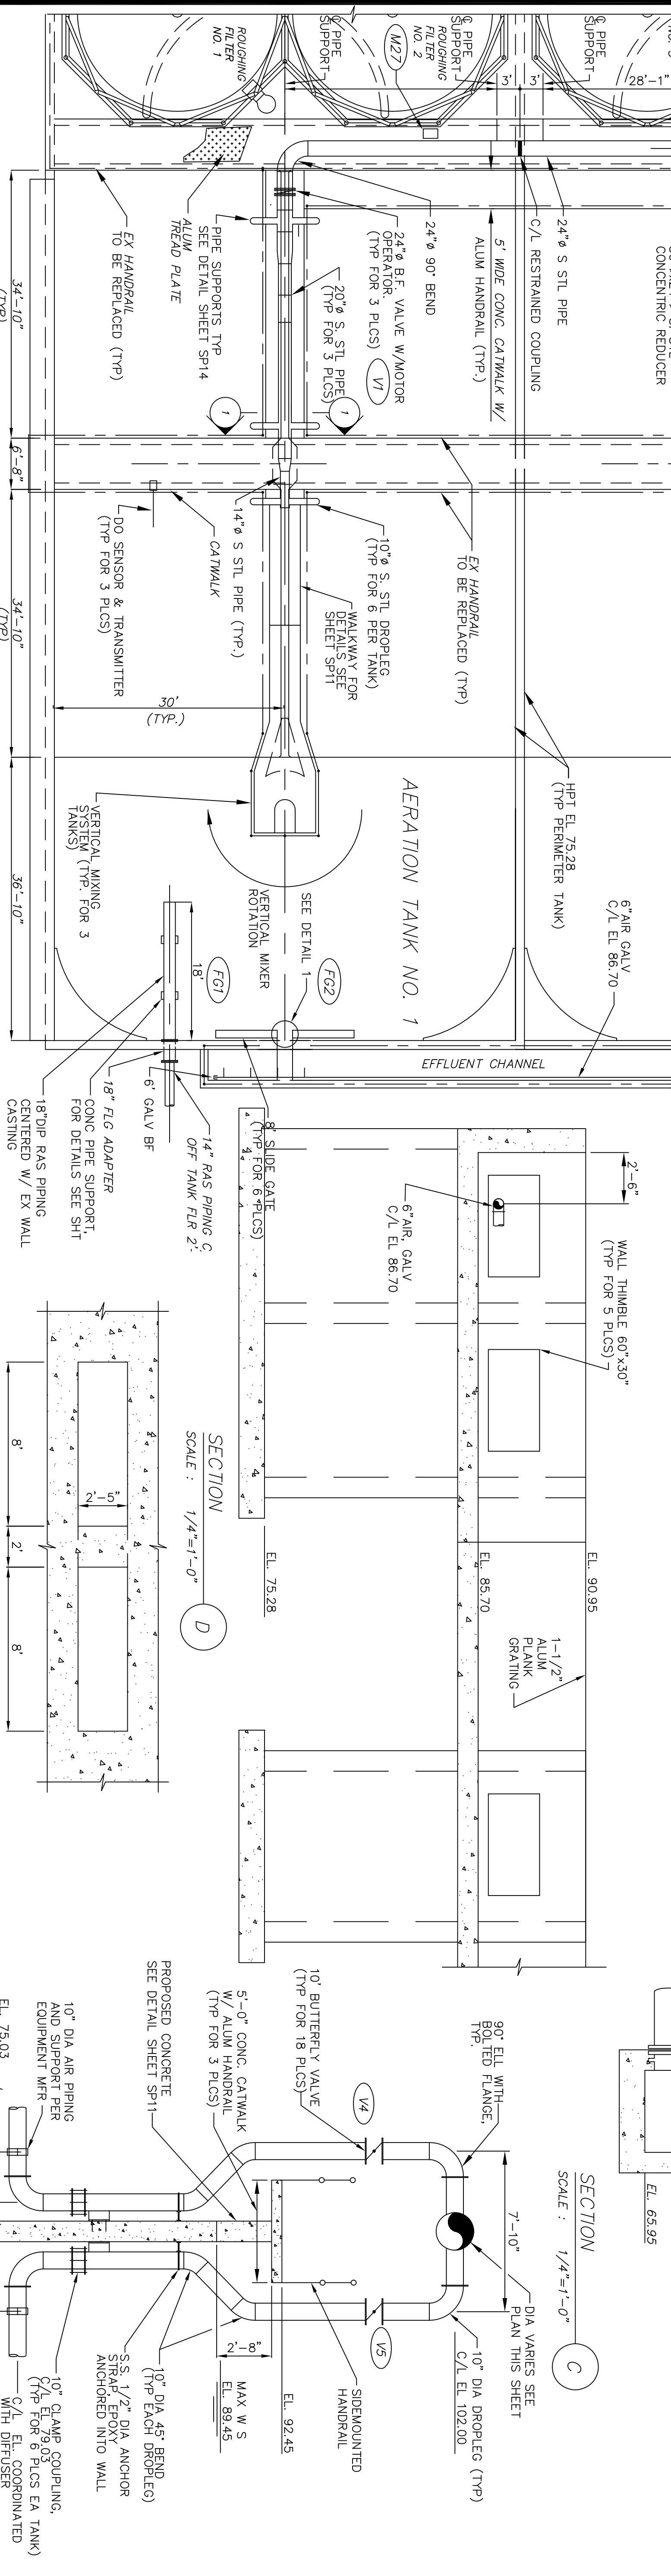
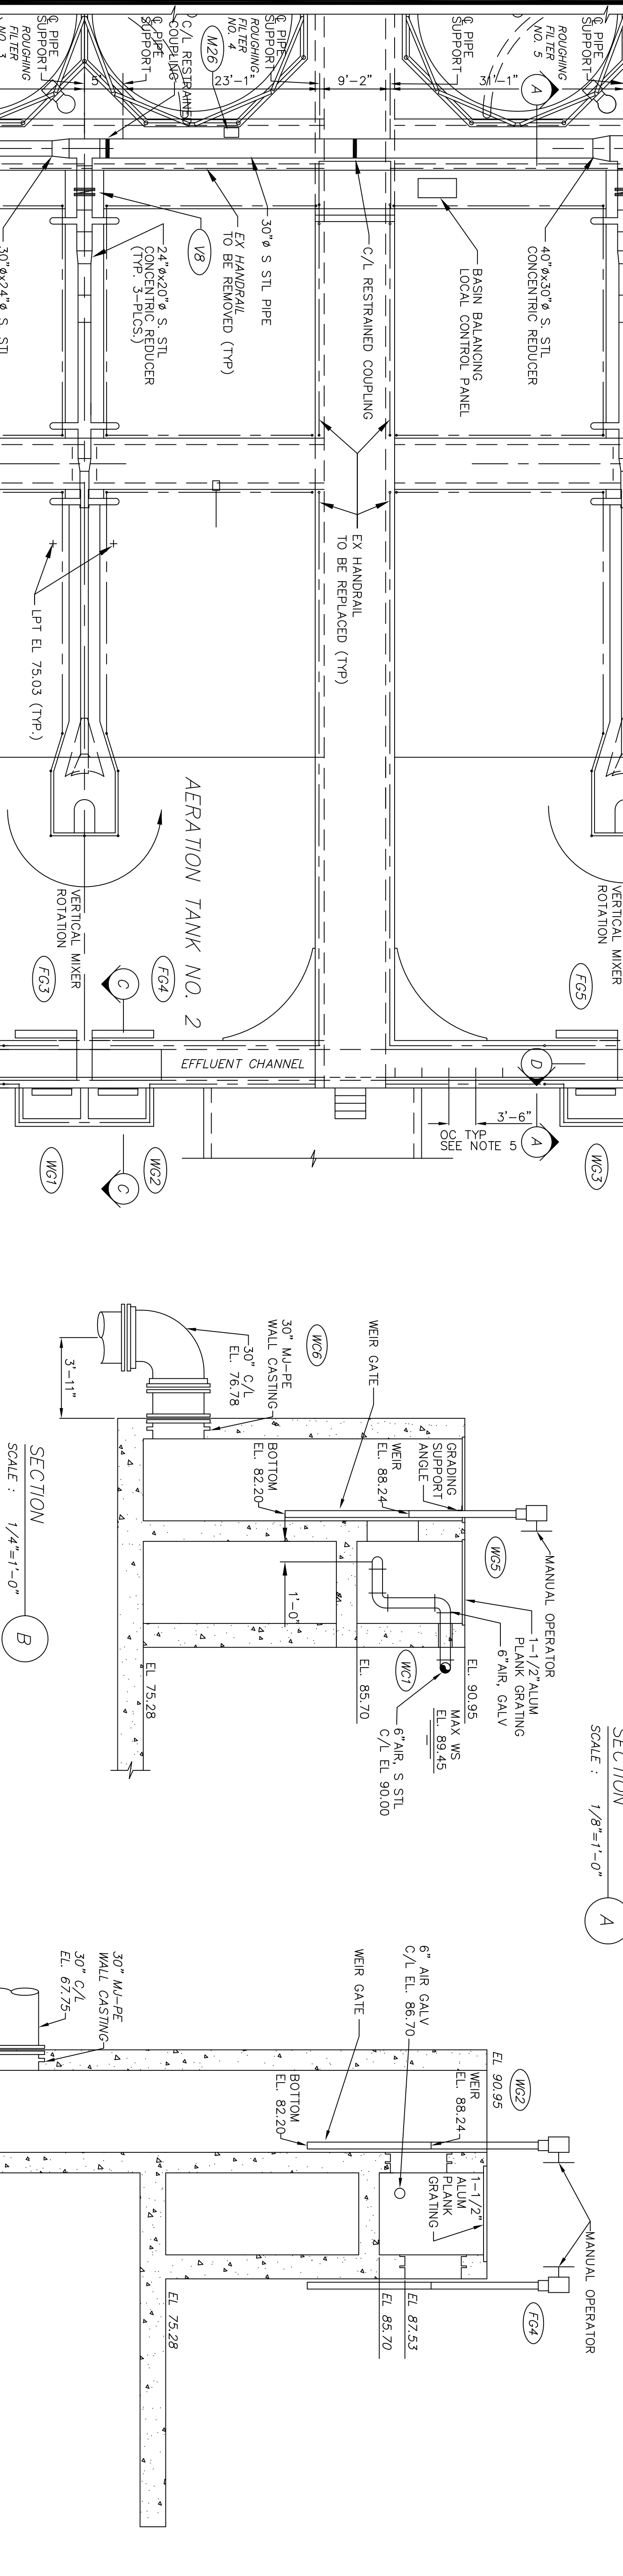


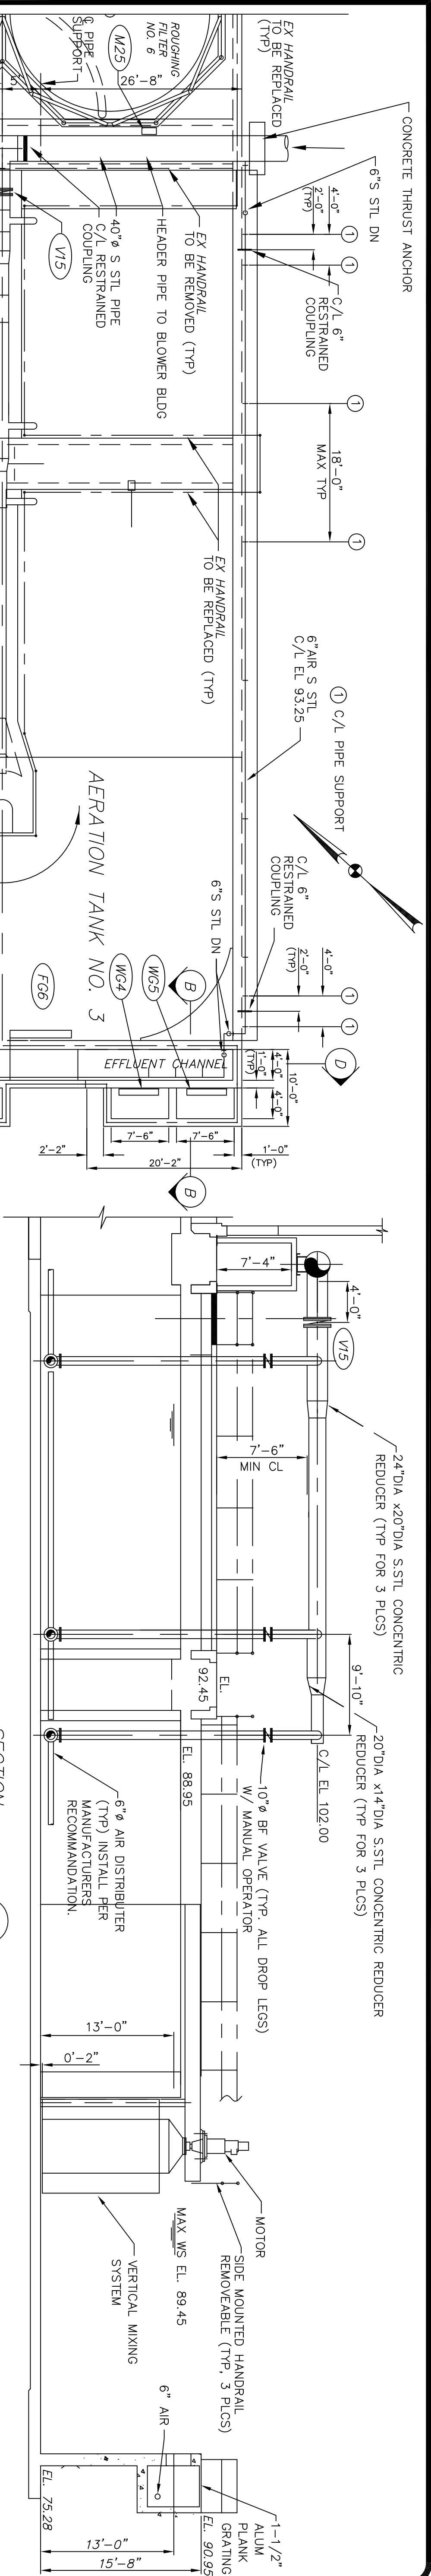

DESIGNED BY
MGW

DRAWN BY
SAT

CHECKED BY
MGW

APPROVED BY
WAD

REVISIONS					
NO.	DESCRIPTIONS	DATE	BY	APP'D	
1	ADDENDUM NO. 1	9/01	MGW	WAD	
2	RECORD DRAWING	2/10	MGW	WAD	

THIS DRAWING IS AN INSTRUMENT OF SERVICE OWNED BY CTE ENVIRONMENTAL, INC. WHICH SHALL BE DEEMED THE AUTHOR AND WHICH SHALL RETAIN ALL STATUTORY AND COMMON LAW RIGHTS, INCLUDING COPYRIGHTS. NO PART OF THIS DRAWING SHALL NOT BE SCANNED, COPIED, OR DISTRIBUTED TO OTHERS IN ANY FORM OR USED FOR ANY OTHER PURPOSES WITHOUT THE WRITTEN CONSENT OF CTE ENVIRONMENTAL, INC. CTE ENVIRONMENTAL, INC. CANNOT GUARANTEE THE ACCURACY OF THE INFORMATION CONTAINED HEREIN. ELECTRONIC COPIES OF THIS DRAWING ARE EXACT DUPLICATES OF THE SEALED ORIGINAL DRAWING. IN THE EVENT OF A CONFLICT BETWEEN AN ELECTRONIC COPY AND THE SEALED ORIGINAL, THE SEALED ORIGINAL SHALL GOVERN.

CITY OF MASSILLON, OHIO
WWTP UPGRADE 2000
AERATION TANK – PLAN AND SECTION



JOB NO.	DATE	SCALE	SHEET
E9031	08/13/01	AS NOTED	P43