


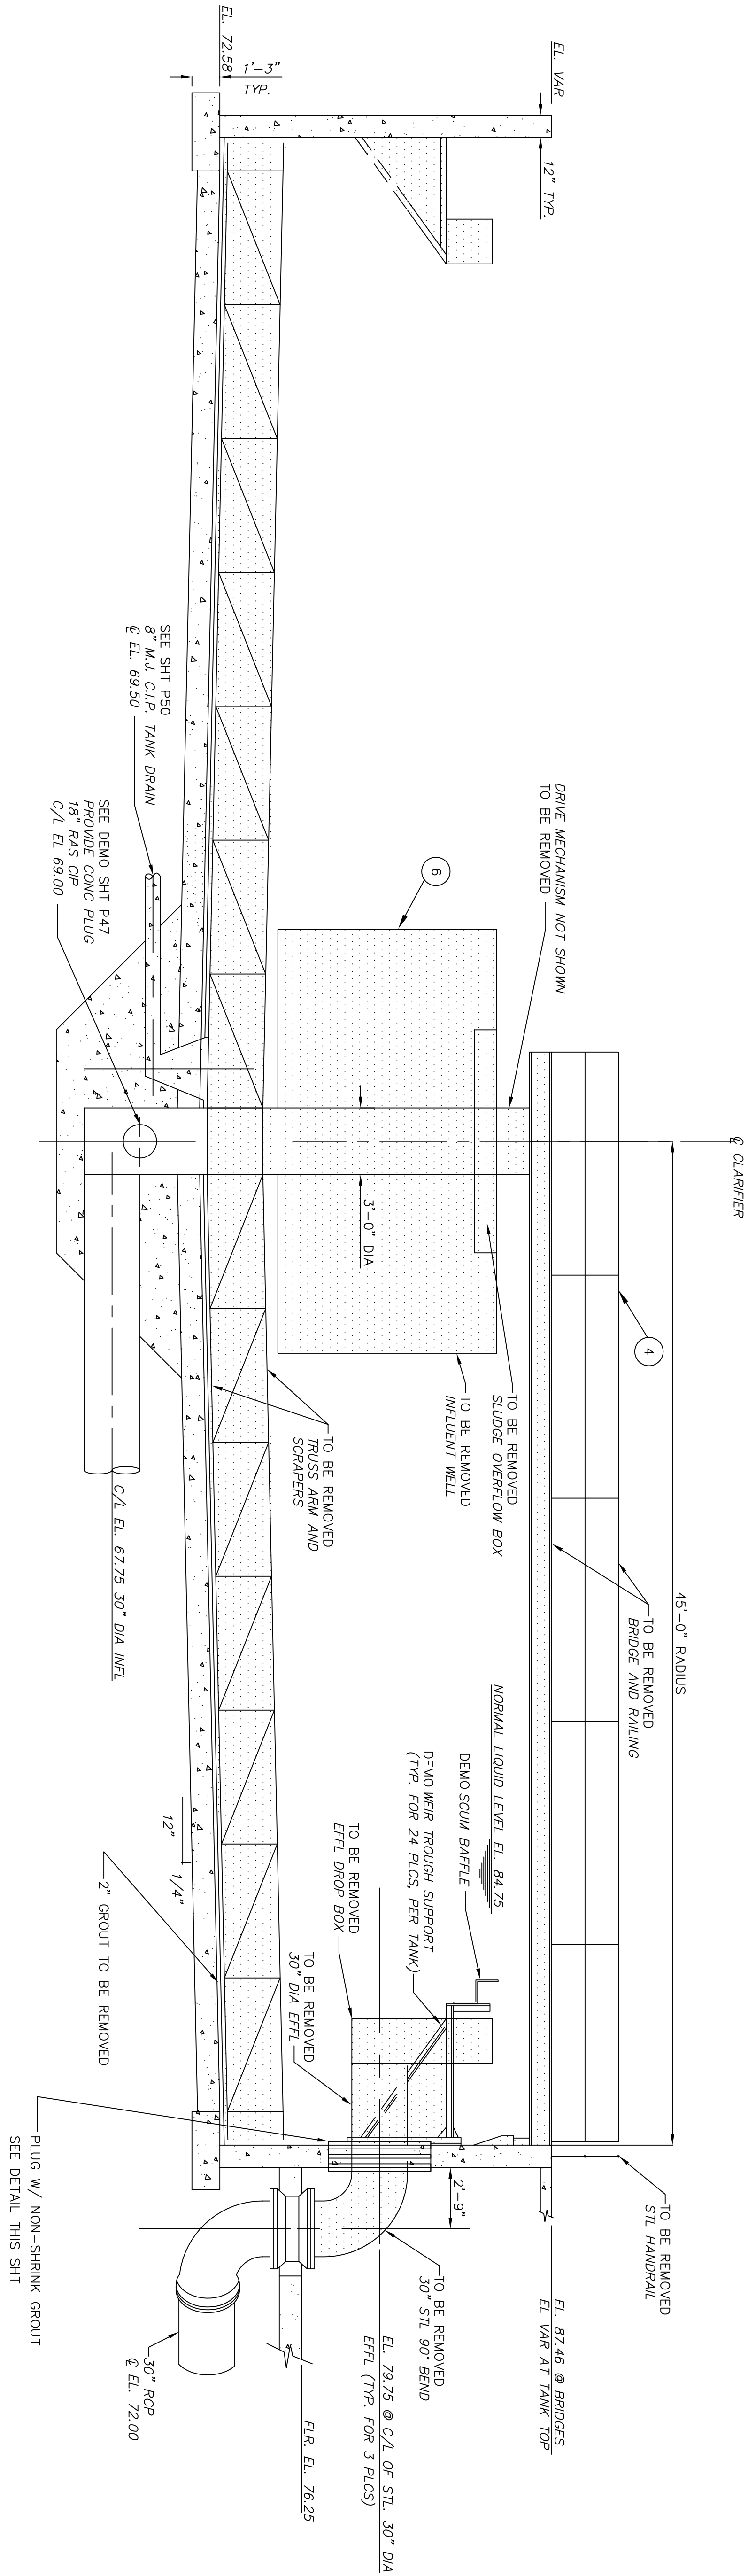

SECTION
SCALE : 1/4"=1'-0" A
P47

EXIST SECONDARY CLARIFIER No. 2 SECTION

SCALE: 1/4"=1'-0"

NOTES TO CONTRACTOR:

- ITEMS FOR DEMO
- EXIST STL SCUM BAFFLE AND SUPPORTS TO BE REMOVED
- EXIST FIBERGLASS EFFL. WEIRS, STL TROUGHS AND SUPPORTS
- EXIST STL WALKWAY AND HANDRAIL TO BE REMOVED.
- ENTIRE EXIST PAINTED STL HANDRAIL (TYP) TO BE REMOVED.
- EXIST INFL. FEED WELL, SLUDGE COLLECTION EQUIPMENT, CENTER COLUMN AND SCUM COLLECTION EQUIPMENT INCLUDING BEACH TO BE REMOVED.
- SECONDARY CLARIFIER DEMO WORK IS TYP FOR SECONDARY CLARIFIERS Nos. 1,2, AND 3.
- EXIST 2" GROUT SHALL BE REMOVED AT THE ENTIRE CLARIFIER SLAB CONCRETE SURFACE, ALL EXIST CLARIFIERS.
- SEE PIPING AND BRIDGE LAYOUT ON SHT P51.



ENVIRONMENTAL, INC.
ENGINEERS IN WATER AND EARTH SCIENCES
UNIONTOWN, OHIO

CITY OF MASSILLON, OHIO
WWTP UPGRADE 2000
EXISTING SECONDARY CLARIFIER DEMOLITION SECTION

DESIGNED BY MGW	REVISIONS				
	NO.	DESCRIPTIONS	DATE	BY	APP'D
DRAWN BY SAT	1	RECORD DRAWING	4/05	MGW	WAD
CHECKED BY MGW					
APPROVED BY WAD					

THIS DRAWING IS AN INSTRUMENT OF SERVICE OWNED BY CTI ENVIRONMENTAL, INC. WHICH SHALL BE DEEMED THE AUTHOR AND WHICH SHALL RETAIN ALL STATUTORY AND COMMON LAW RIGHTS, INCLUDING COPYRIGHTS. THIS DRAWING SHALL NOT BE SCANNED, COPIED, OR DISTRIBUTED TO OTHERS IN ANY FORM OR USED FOR ANY OTHER PURPOSE OR PROJECT WITHOUT PRIOR WRITTEN CONSENT OF CTI ENVIRONMENTAL, INC. CTI ENVIRONMENTAL, INC. CANNOT GUARANTEE THAT ELECTRONIC COPIES OF THIS DRAWING ARE EXACT DUPLICATES OF THE SEALED ORIGINAL DRAWING. IN THE EVENT OF A CONFLICT BETWEEN AN ELECTRONIC COPY AND THE SEALED ORIGINAL, THE SEALED ORIGINAL SHALL GOVERN.

SEALING OF EXISTING OPENINGS
SCALE 1-1/2" = 1'-0"

THESE RECORD DOCUMENTS HAVE BEEN PREPARED BASED ON INFORMATION PROVIDED BY OTHERS. CTI ENVIRONMENTAL HAS REVIEWED THE INFORMATION SUBMITTED AND BELIEVES IT REFLECTS THE WORK AS CONSTRUCTED. HOWEVER, ALL PERSONS SHALL VERIFY INFORMATION TAKEN FROM THIS DRAWING.

JOB NO.	E9031
DATE	08/13/01
SCALE	AS NOTED
SHEET	P48