

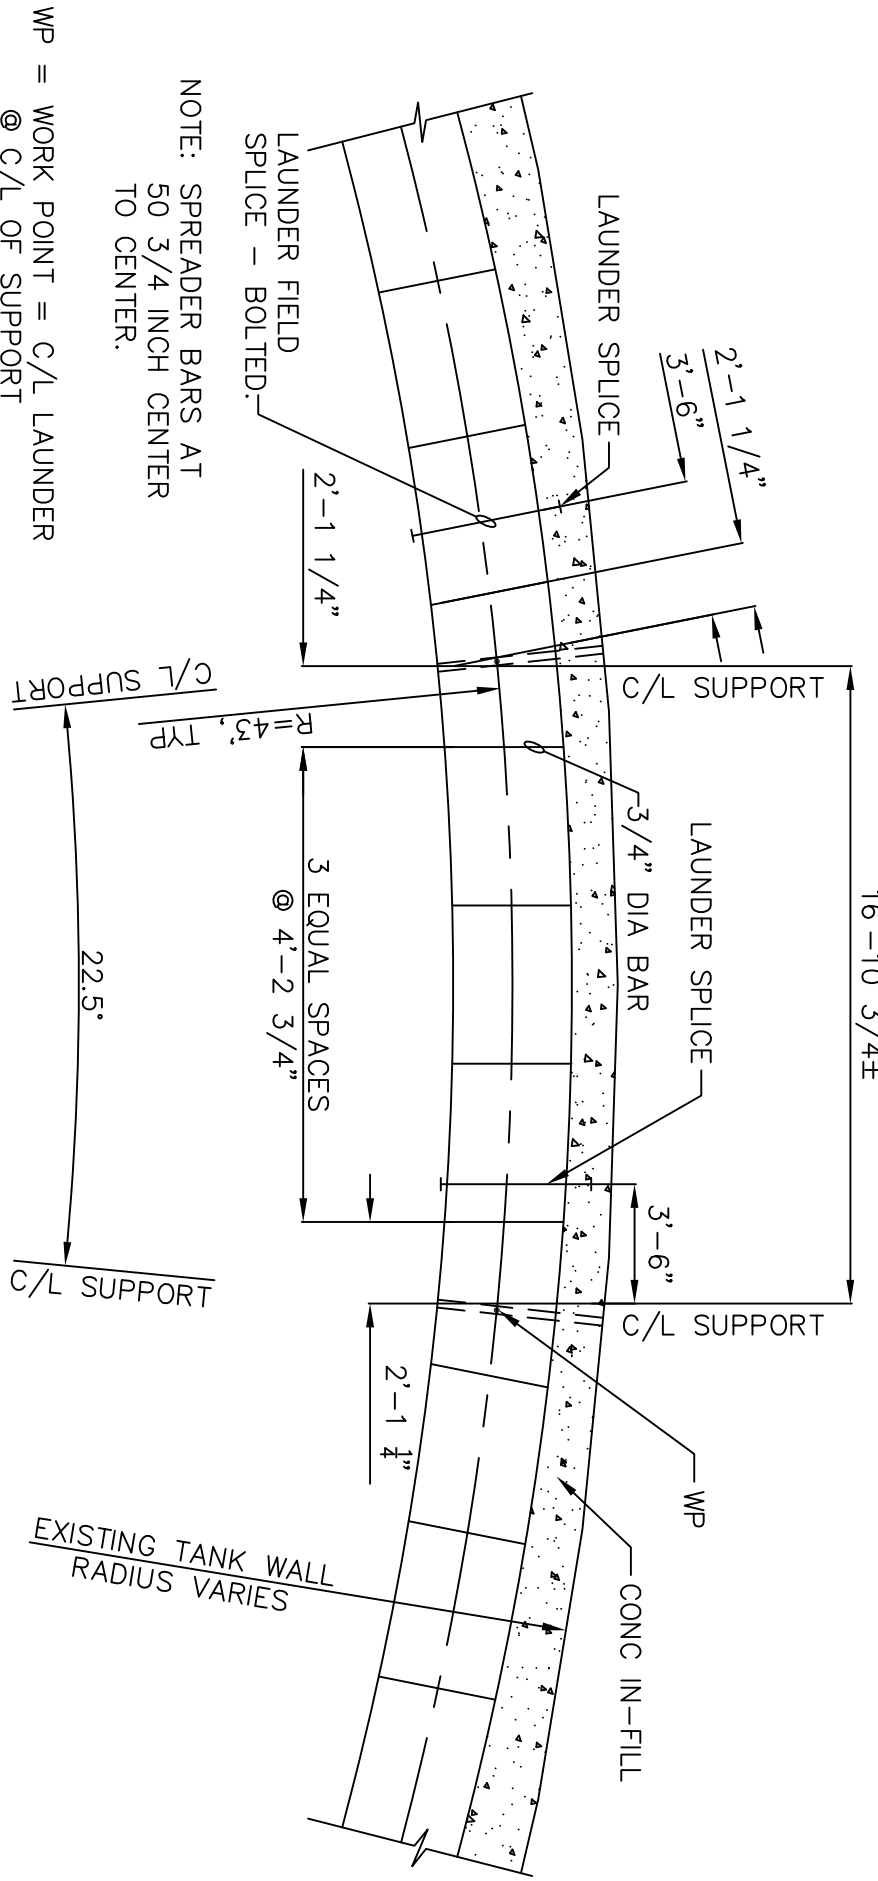


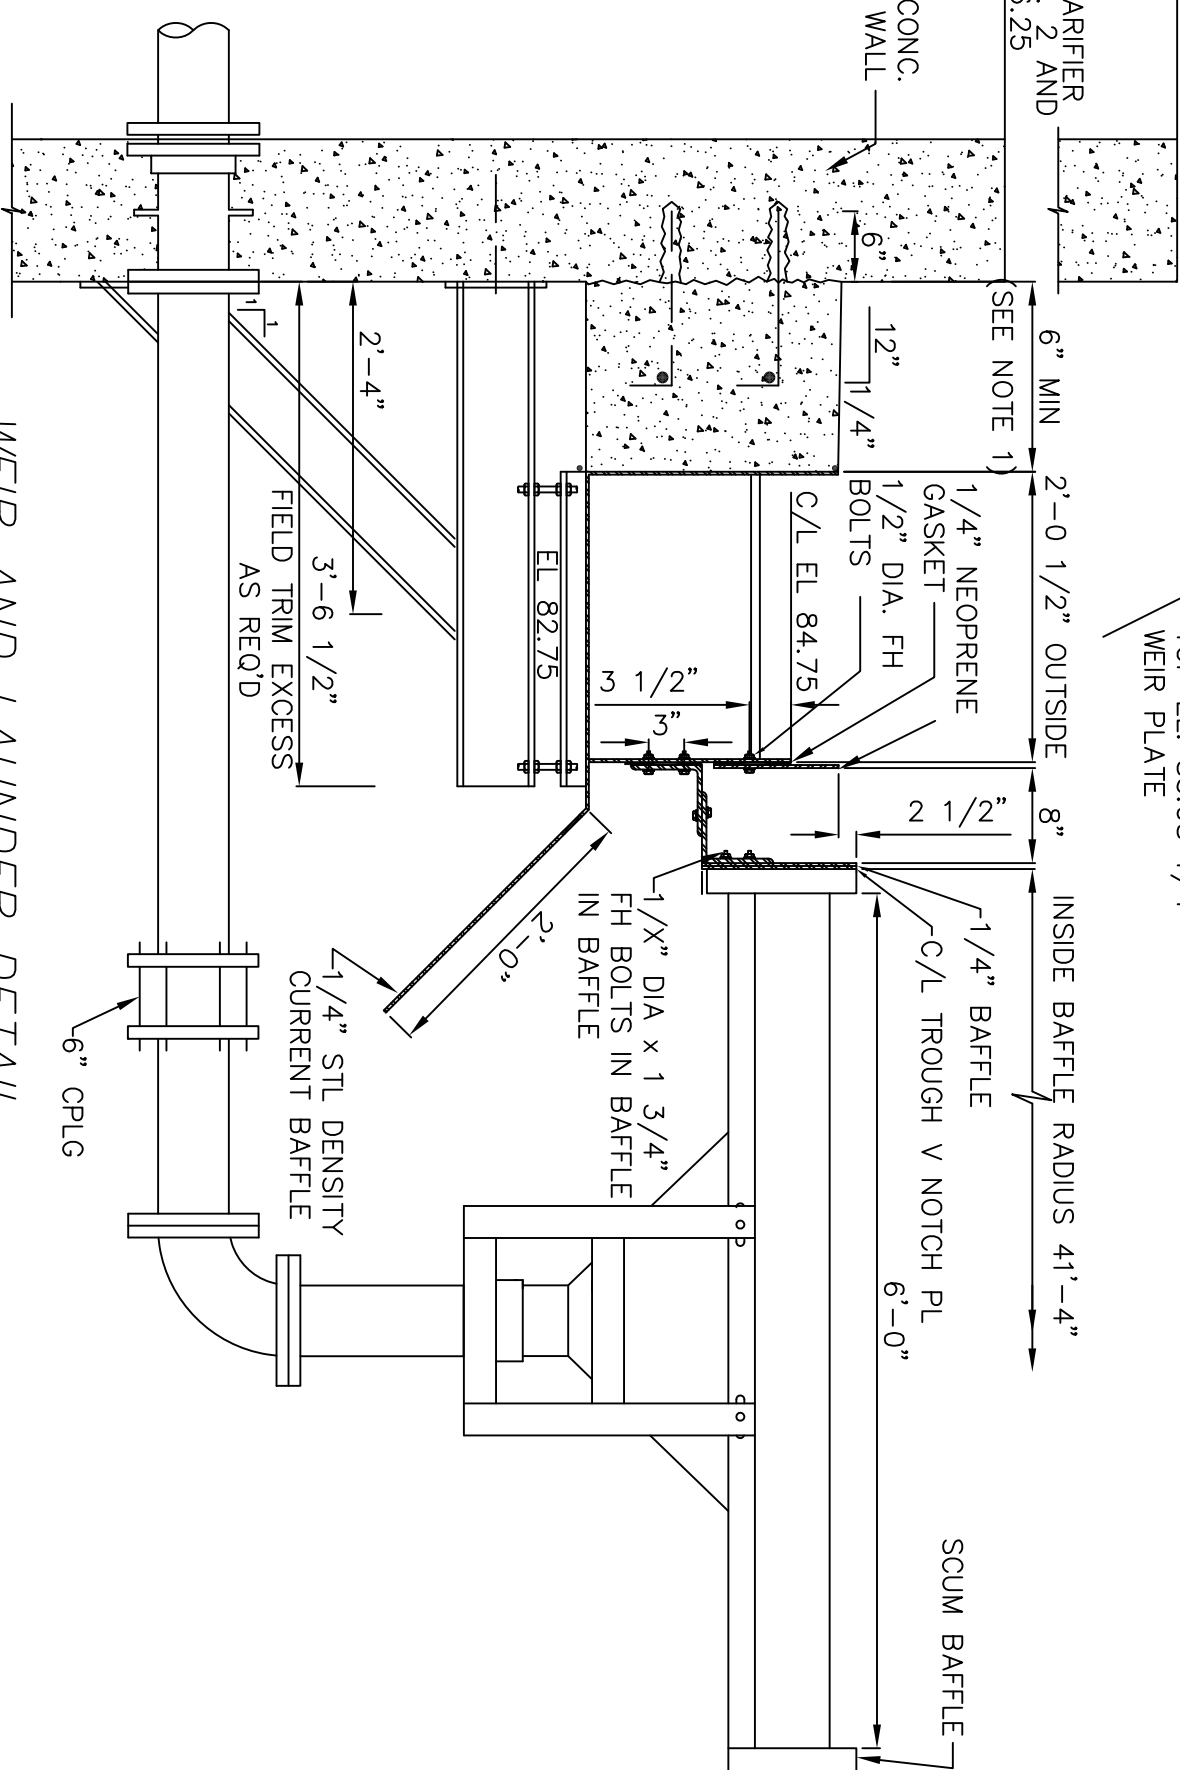

- NOTES TO CONTRACTOR:
1. ALL VALVES, BRACKETS AND OPERATORS TO BE REMOVED BY CONTRACTOR SHALL BE TURNED OVER TO THE CITY. CONTRACTOR SHALL SUPPLY AND INSTALL NEW BRACKETS, FITTINGS AND GASKETS FOR EACH VALVE.
 2. FOR WEIR TROUGH AND SCUM BAFFLE DETAILS, SEE SHT P54.
 3. PROPOSED HANDRAIL SHALL BE 1 1/2" ± GALVANIZED STEEL HANDRAIL FOR HANDRAIL DETAILS, SEE DETAIL SHEET P54
 4. SECONDARY CLARIFIER MODIFICATIONS ARE TYPICAL FOR SECONDARY CLARIFIER Nos. 1, 2, AND 3.
 5. LAUNDER COVER TO BE PROVIDED ABOVE LAUNDER AND DROP BOX FOR SECONDARY CLARIFIER Nos. 1, 2, AND 3.
 6. CIRCULAR LAUNDER SHOWN. CONTRACTOR SHALL COORDINATE WORK FOR CHANGES THAT MAY OCCUR DUE TO DIFFERENCES BETWEEN CIRCULAR LAUNDER AND SEGMENTAL LAUNDER.

THESE RECORD DOCUMENTS HAVE BEEN PREPARED BASED ON INFORMATION PROVIDED BY OTHERS. CTE ENVIRONMENTAL HAS REVIEWED THE INFORMATION SUBMITTED AND BELIEVES IT REFLECTS THE WORK AS CONSTRUCTED. HOWEVER, ALL PERSONS SHALL VERIFY INFORMATION TAKEN FROM THIS DRAWING.

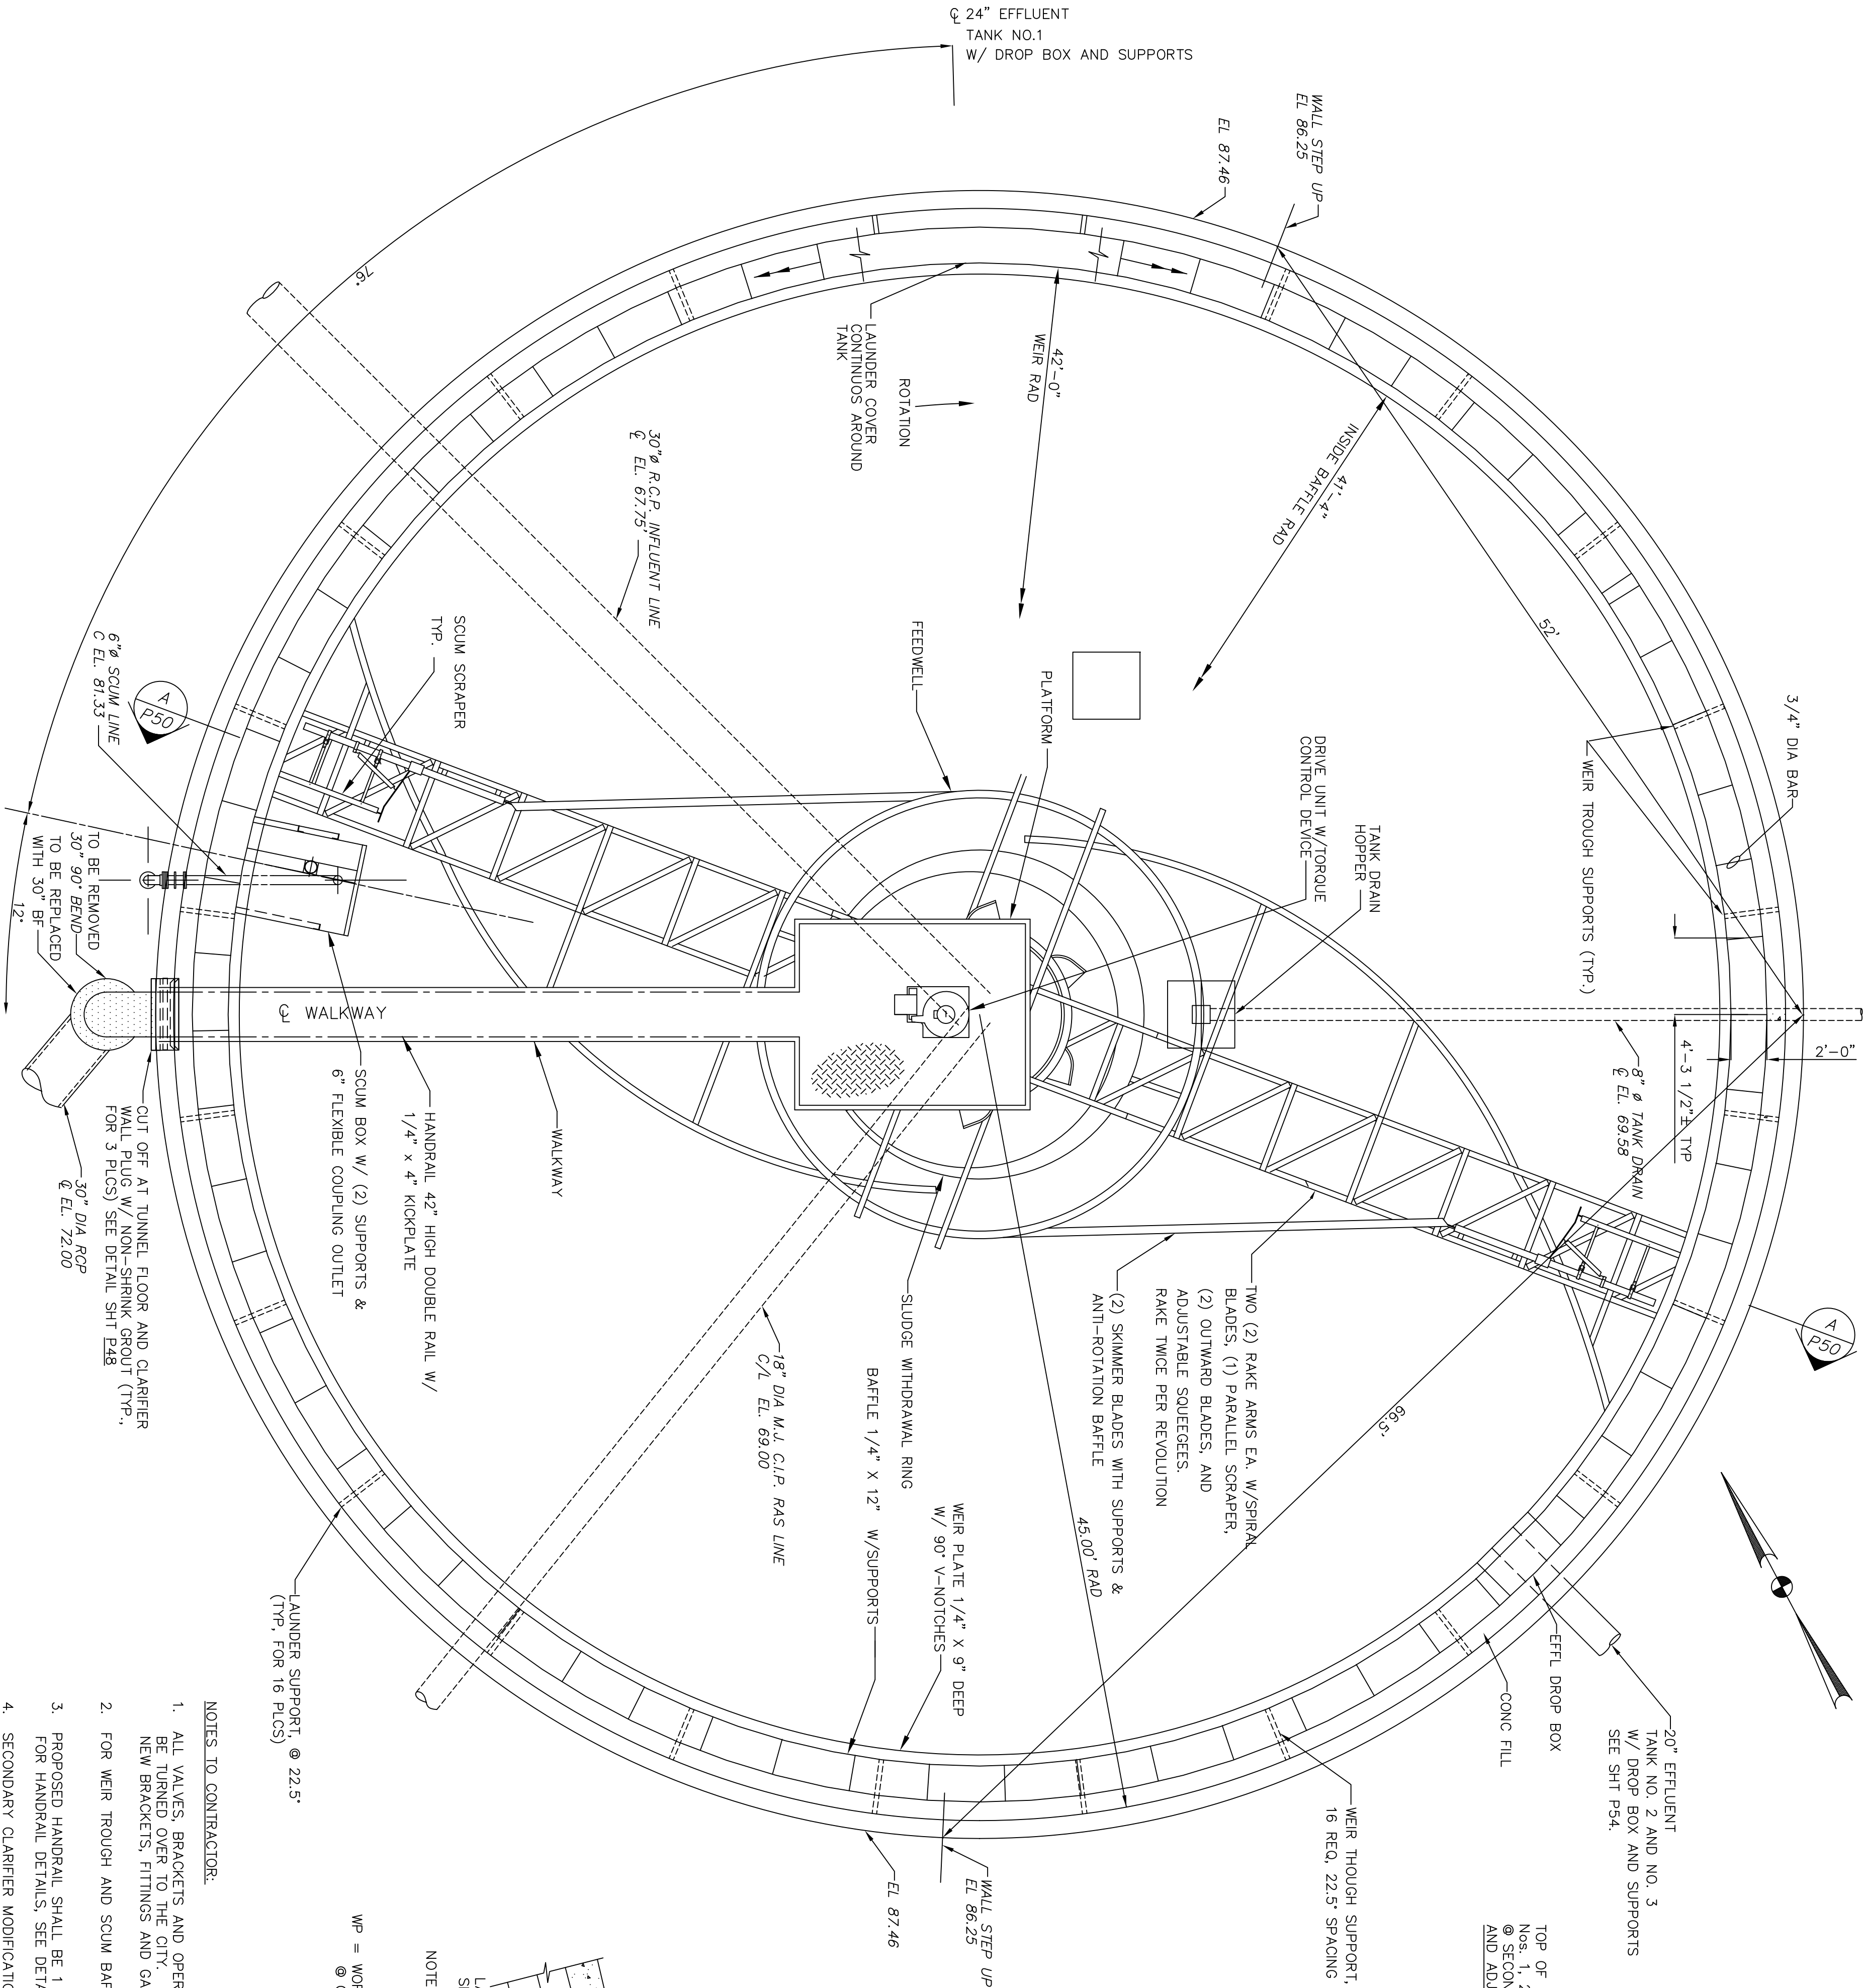

ENVIRONMENTAL, INC.
ENGINEERS IN WATER AND EARTH SCIENCES
UNIONTOWN, OHIO

CITY OF MASSILLON, OHIO
WWTP UPGRADE 2000
EXISTING SECONDARY CLARIFIER IMPROVEMENTS PLAN

DESIGNED BY	REVISIONS				
	NO.	DESCRIPTIONS	DATE	BY	APP'D
MGW	1	RECORD DRAWING	4/05	MGW	WAD
DRAWN BY					
ELR					
CHECKED BY					
MGW					
APPROVED BY					
WAD					

THIS DRAWING IS AN INSTRUMENT OF SERVICE OWNED BY CTE ENVIRONMENTAL, INC. WHICH SHALL BE DEEMED THE AUTHOR AND WHICH SHALL RETAIN ALL STATUTORY AND COMMON LAW RIGHTS, INCLUDING COPYRIGHTS. THIS DRAWING SHALL NOT BE SCANNED, COPIED, OR DISTRIBUTED TO OTHERS IN ANY FORM OR USED FOR ANY OTHER PURPOSE OR PROJECT WITHOUT PRIOR WRITTEN CONSENT OF CTE ENVIRONMENTAL, INC. CTE ENVIRONMENTAL, INC. CANNOT GUARANTEE THAT ELECTRONIC COPIES OF THIS DRAWING ARE EXACT DUPLICATES OF THE SEALED ORIGINAL DRAWING. IN THE EVENT OF A CONFLICT BETWEEN AN ELECTRONIC COPY AND THE SEALED ORIGINAL, THE SEALED ORIGINAL SHALL GOVERN.

SECONDARY CLARIFIER PLAN—TANK NO. 2

SCALE: 3/16"=1'-0"

SCALE: NTS

JOB NO.
E9031

DATE
08/13/01

SCALE
AS NOTED

SHEET
P49