

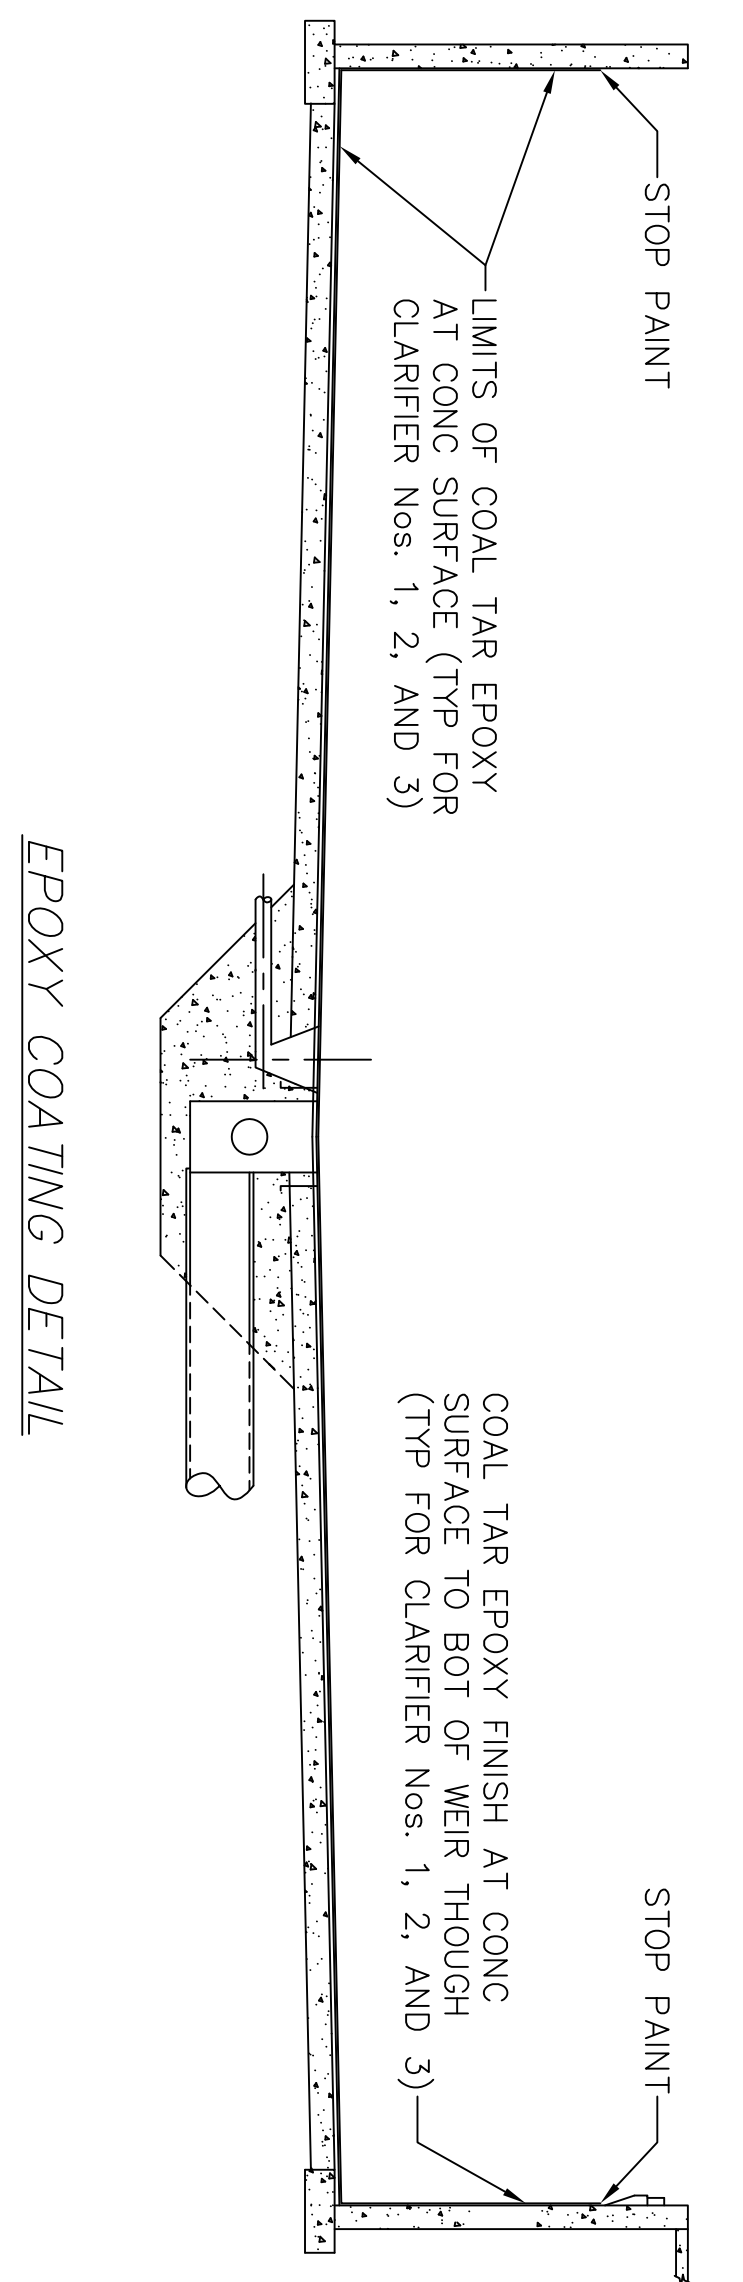


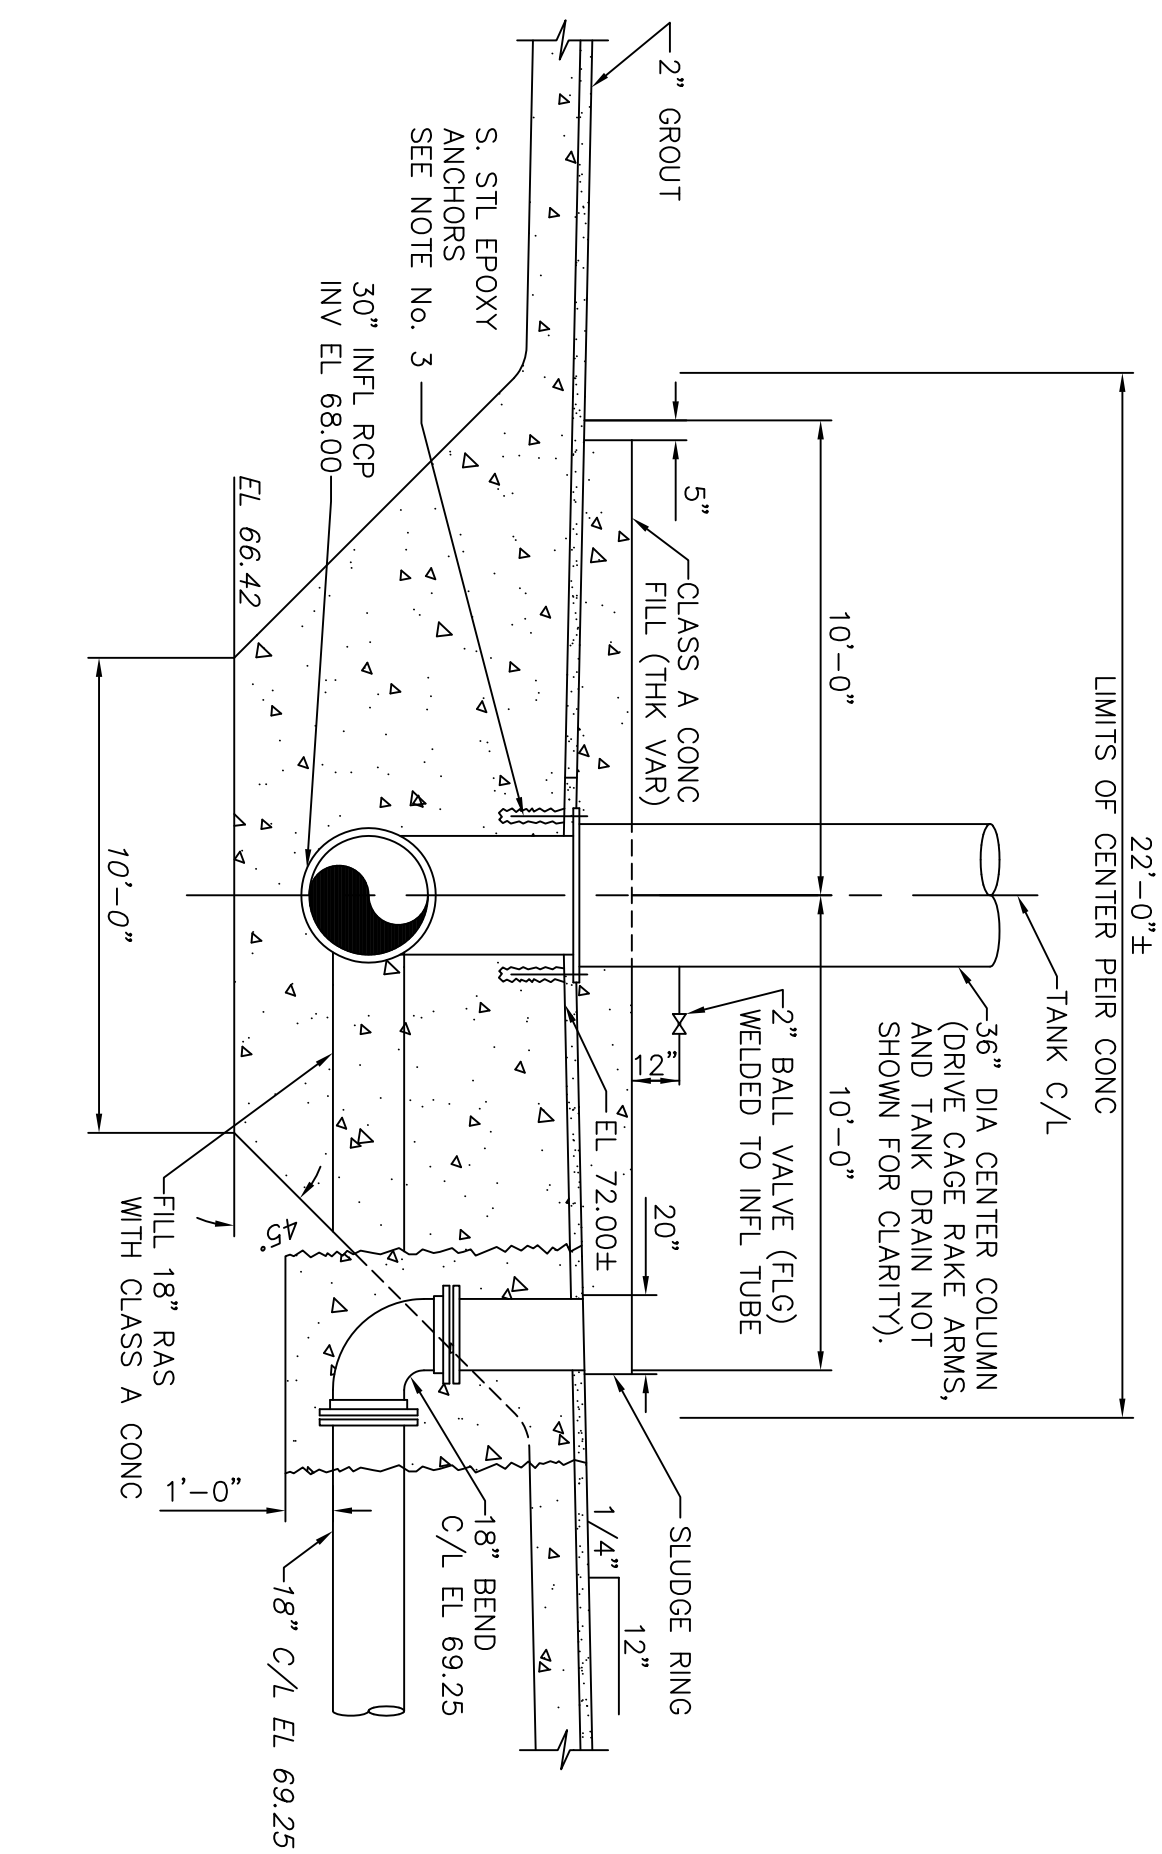

EPOXY COATING DETAIL

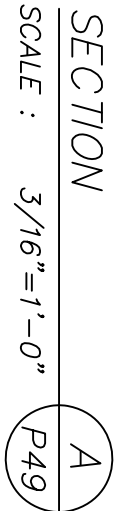

1. CONTRACTOR SHALL CLEAN AND PAINT ENTIRE INSIDE OF SECONDARY CLARIFIERS 1, 2, AND 3. FOR LIMITS SEE EPOXY COATING DETAIL THIS SHEET.
2. THE 24" DIA DIP EFFLUENT FROM TANK NO. 1 SHALL BE INSTALLED BY BORING UNDER THE EXISTING TUNNEL AREA AND STEEL ENCASEING THE 24" DIP. SEE DETAIL SHEET.
3. CONTRACTOR SHALL SUBMIT ANCHORAGE DETAILS AS RECOMMENDED BY THE CLARIFIER EQUIPMENT MANUFACTURER.

THESE RECORD DOCUMENTS HAVE BEEN PREPARED
BASED ON INFORMATION PROVIDED BY OTHERS. CFI
ENVIRONMENTAL HAS REVIEWED THE INFORMATION
SUBMITTED AND BELIEVES IT REFLECTS THE WORK
AS CONSTRUCTED. HOWEVER, ALL PERSONS SHALL
VERIFY INFORMATION TAKEN FROM THIS DRAWING.

DESIGNED BY	REVISIONS				
MGW	NO.	DESCRIPTIONS	DATE	BY	APP'D
DRAWN BY	1	RECORD DRAWING	4/05	MGW	WAD
ELR					
CHECKED BY					
MGW					
APPROVED BY					
WAD					

THIS DRAWING IS AN INSTRUMENT OF SERVICE OWNED BY CTE ENVIRONMENTAL, INC. WHICH SHALL BE DEEMED THE AUTHOR AND WHICH SHALL RETAIN ALL STATUTORY AND COMMON LAW RIGHTS, INCLUDING COPYRIGHTS. NO PART OF THIS DRAWING SHALL BE REPRODUCED, COPIED, OR DISTRIBUTED TO OTHERS IN ANY FORM OR USED FOR ANY OTHER PURPOSE OR PROJECT WITHOUT PRIOR WRITTEN CONSENT OF CTE ENVIRONMENTAL, INC. CTE ENVIRONMENTAL, INC. CANNOT GUARANTEE THAT ELECTRONIC COPIES OF THIS DRAWING ARE EXACT REPRODUCTIONS OF THE SEALED ORIGINAL. IN THE EVENT OF A CONFLICT BETWEEN AN ELECTRONIC COPY AND THE SEALED ORIGINAL, THE SEALED ORIGINAL SHALL GOVERN.

ENVIRONMENTAL, INC.
ENGINEERS IN WATER AND EARTH SCIENCES
UNIONTOWN, OHIO

CITY OF MASSILLON, OHIO
WWTP UPGRADE 2000
EXISTING SECONDARY CLARIFIER IMPROVEMENTS SECTION

JOB NO. E9031
DATE 08/13/01
SCALE AS NOTED
SHEET P50