



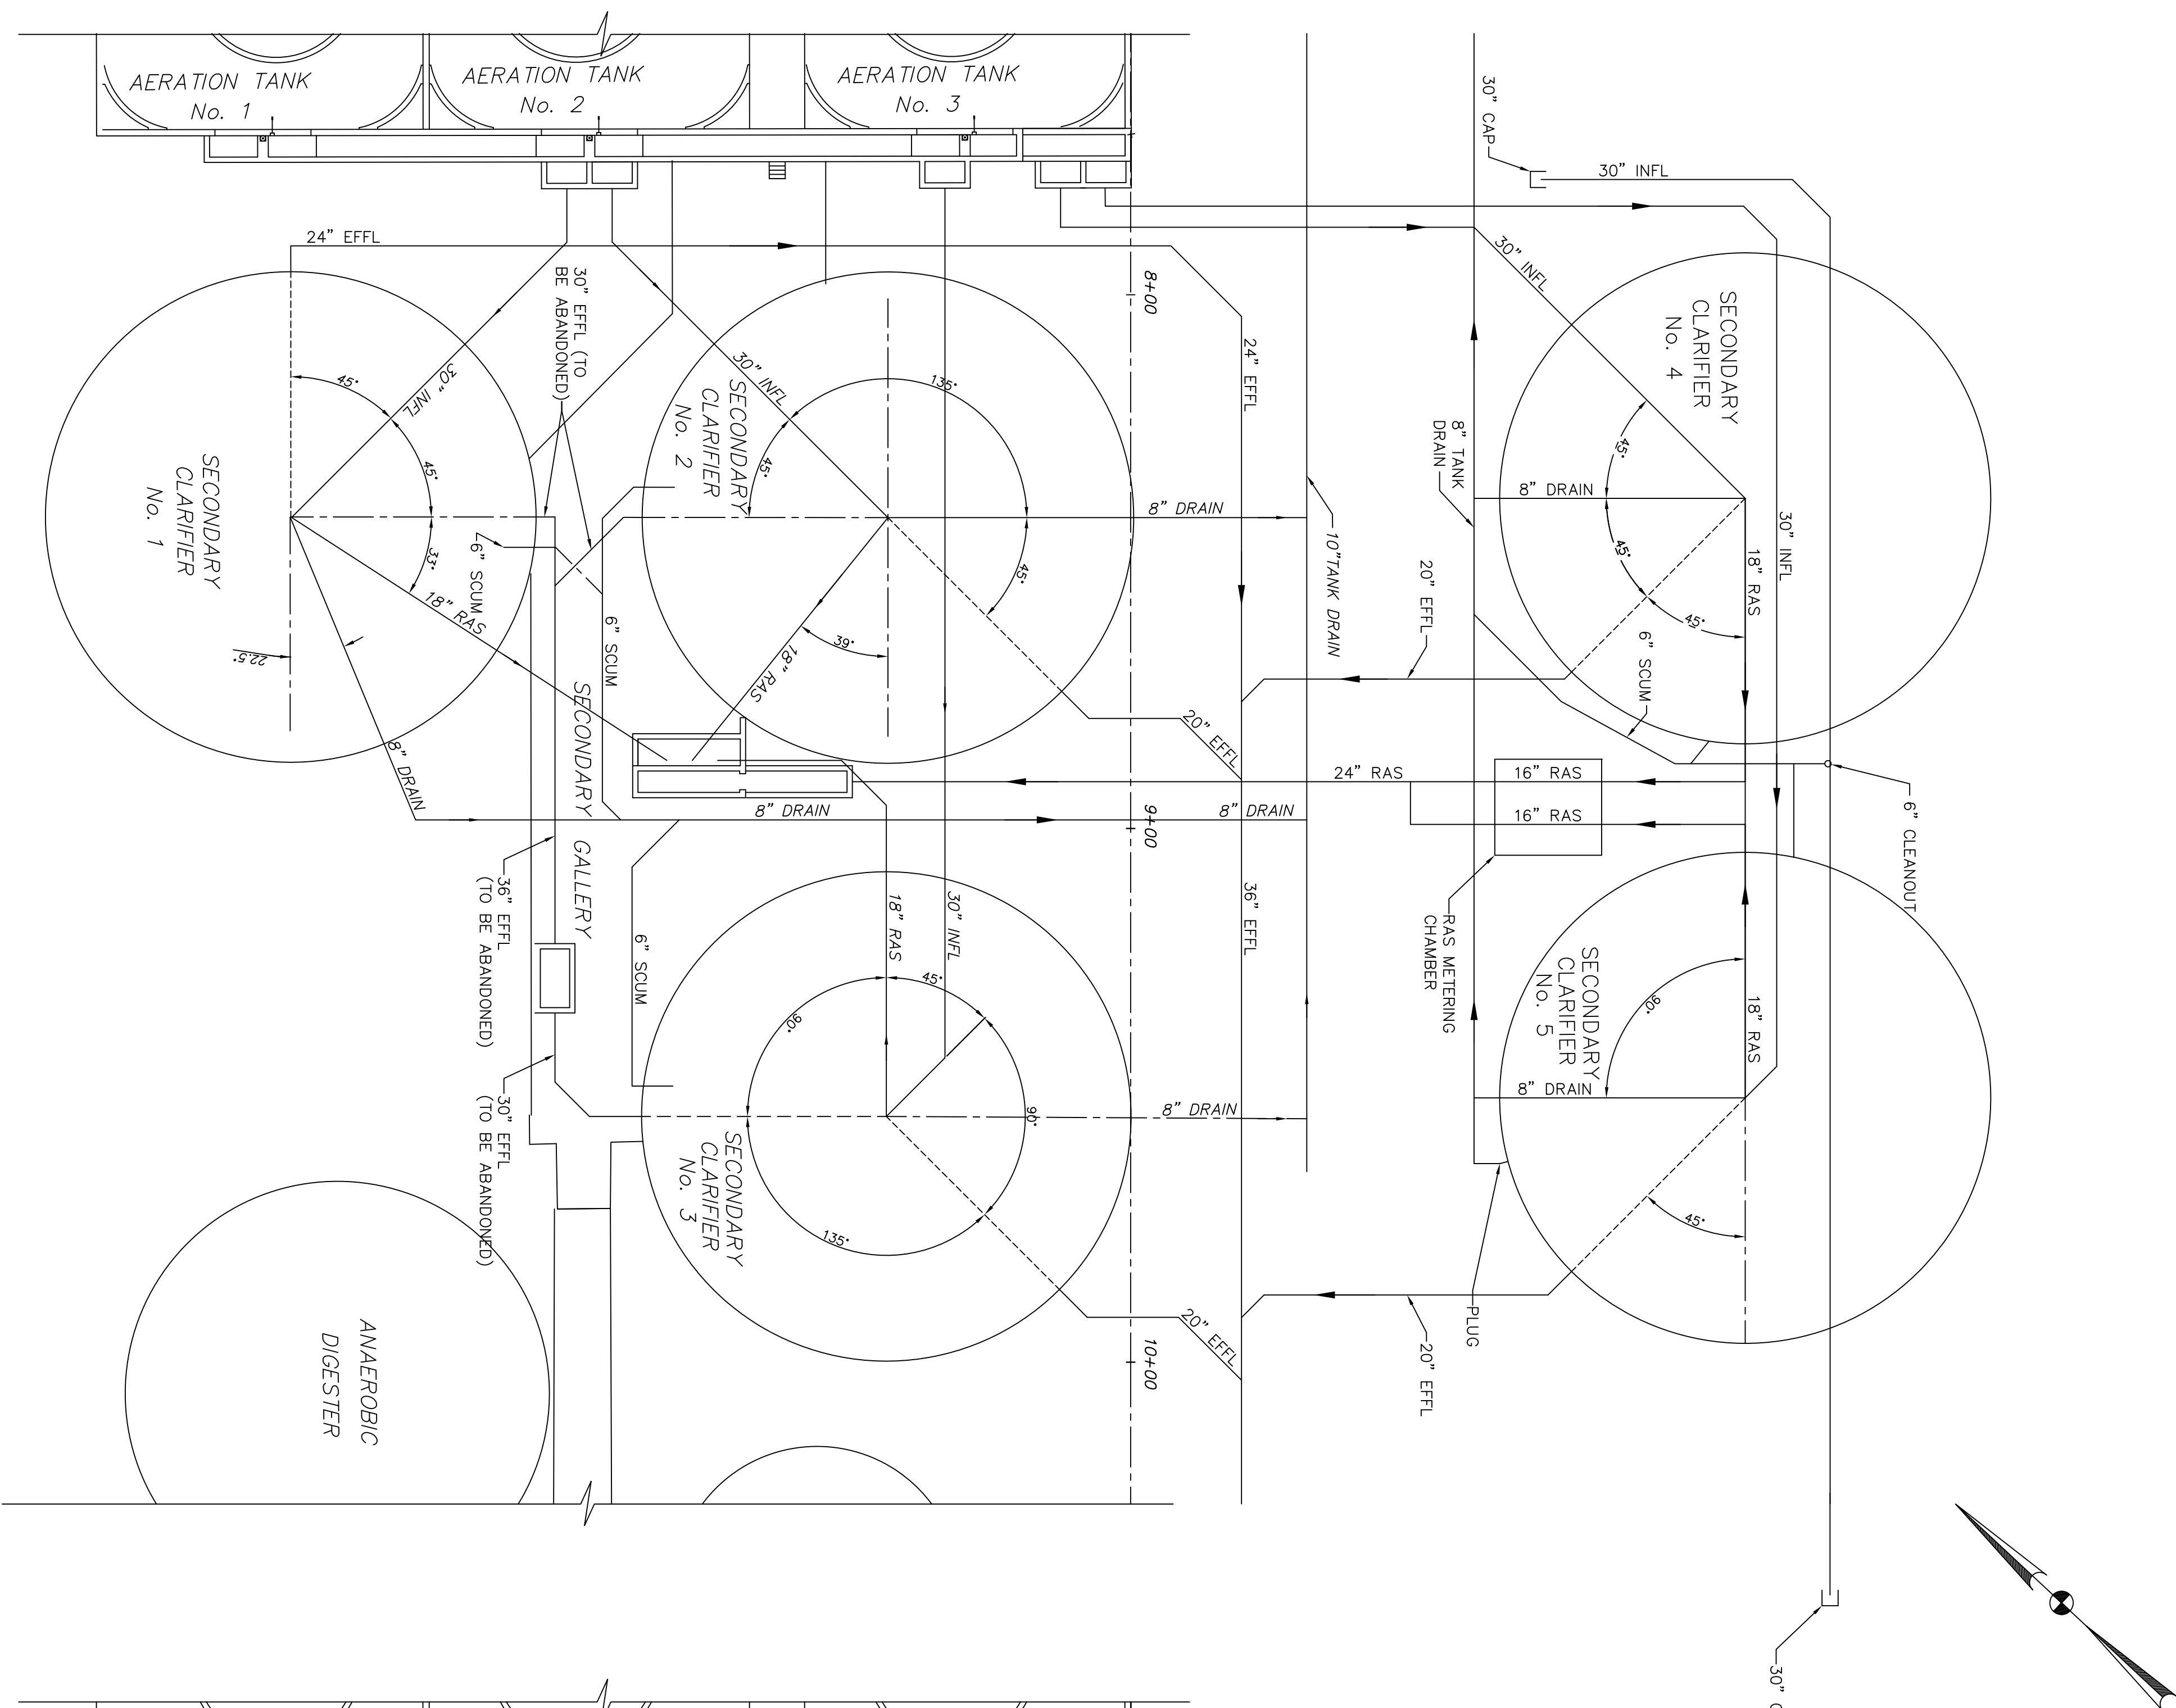


SECONDARY CLARIFIER PIPING LOCATION

SCALE 1"=20'

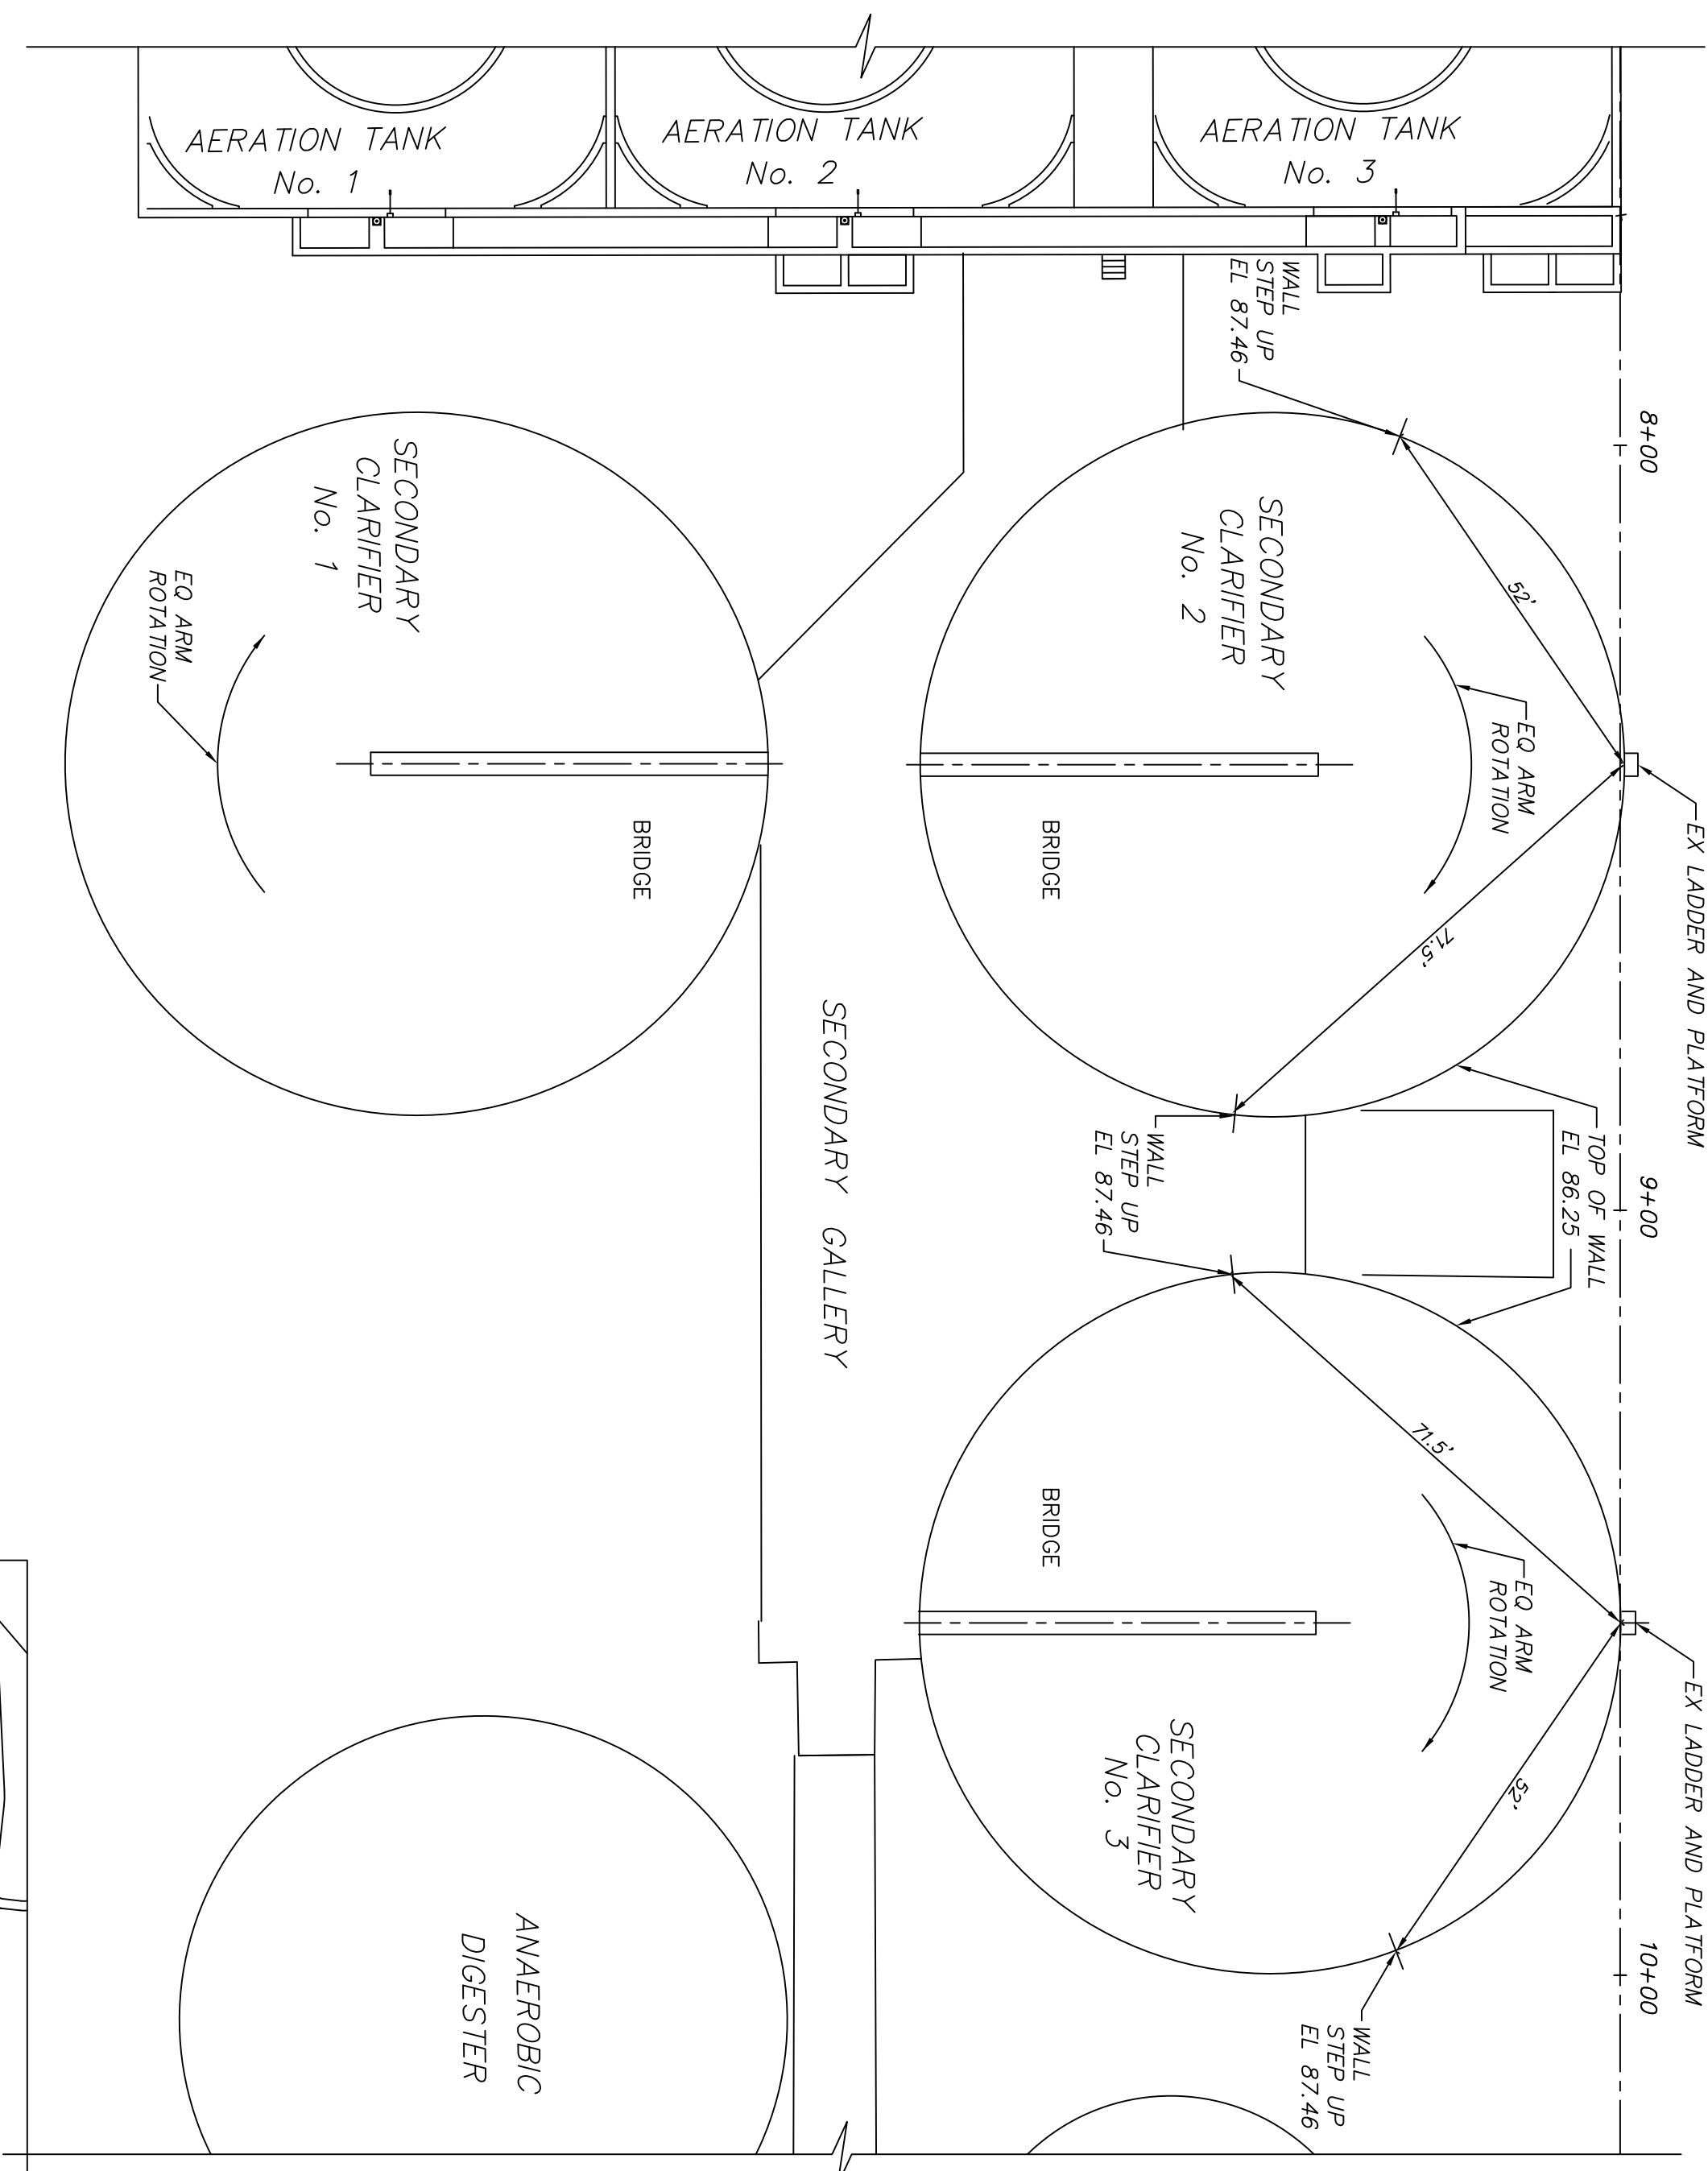

SECONDARY CLARIFIER BRIDGE LOCATION

SCALE 1"=20'

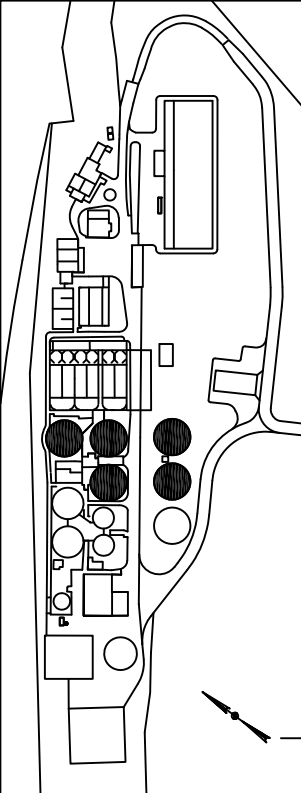

KEY PLAN

DESIGNED BY
MGW

DRAWN BY
SAT

CHECKED BY
MGW

APPROVED BY
WAD

REVISIONS				
NO.	DESCRIPTIONS	DATE	BY	APP'D
1	RECORD DRAWING	2/10	MGW	WAD

ENVIRONMENTAL, INC.
ENGINEERS IN WATER AND EARTH SCIENCES
UNIONTOWN, OHIO

CITY OF MASSILLON, OHIO

WWTP UPGRADE 2000

SECONDARY CLARIFIER PIPING AND BRIDGE LAYOUT

JOB NO.
E9031

DATE
08/13/01

SCALE
1"=20'

SHEET
P51

THIS DRAWING IS AN INSTRUMENT OF SERVICE OWNED BY CTI ENVIRONMENTAL, INC. WHICH SHALL BE DEEMED THE AUTHOR AND WHICH SHALL RETAIN ALL STATUTORY AND COMMON LAW RIGHTS, INCLUDING COPYRIGHTS. THIS DRAWING SHALL NOT BE SCANNED, COPIED, OR DISTRIBUTED TO OTHERS IN ANY FORM OR USED FOR ANY OTHER PURPOSE OR PROJECT WITHOUT PRIOR WRITTEN CONSENT OF CTI ENVIRONMENTAL, INC. CTI ENVIRONMENTAL, INC. CANNOT GUARANTEE THAT ELECTRONIC COPIES OF THIS DRAWING ARE EXACT DUPLICATES OF THE SEALED ORIGINAL DRAWING. IN THE EVENT OF A CONFLICT BETWEEN AN ELECTRONIC COPY AND THE SEALED ORIGINAL, THE SEALED ORIGINAL SHALL GOVERN.