




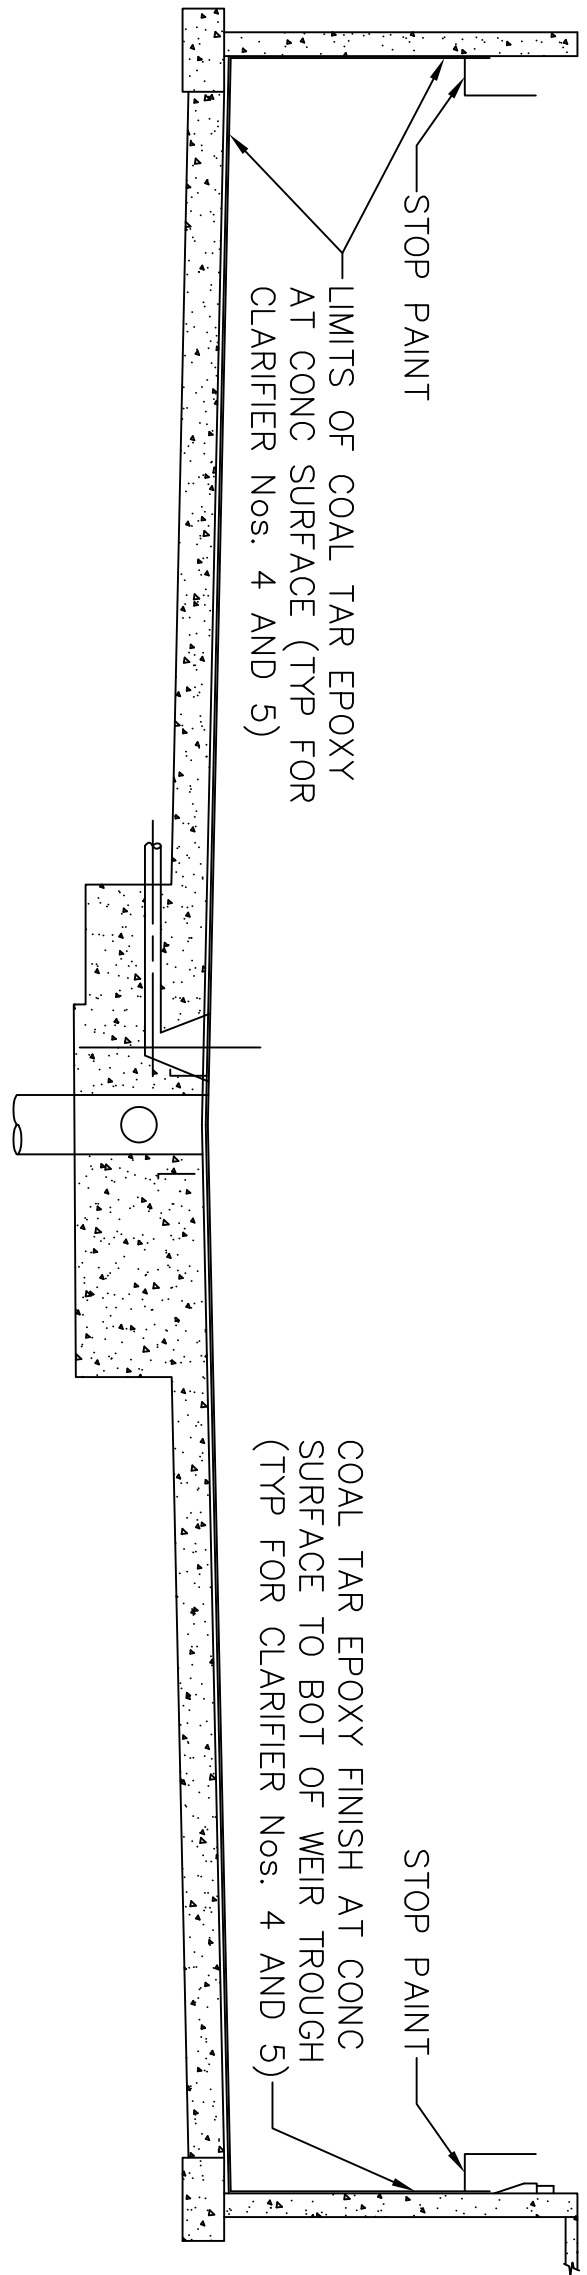



EPOXY COATING DETAIL  
SCALE: 1/8"=1'-0"

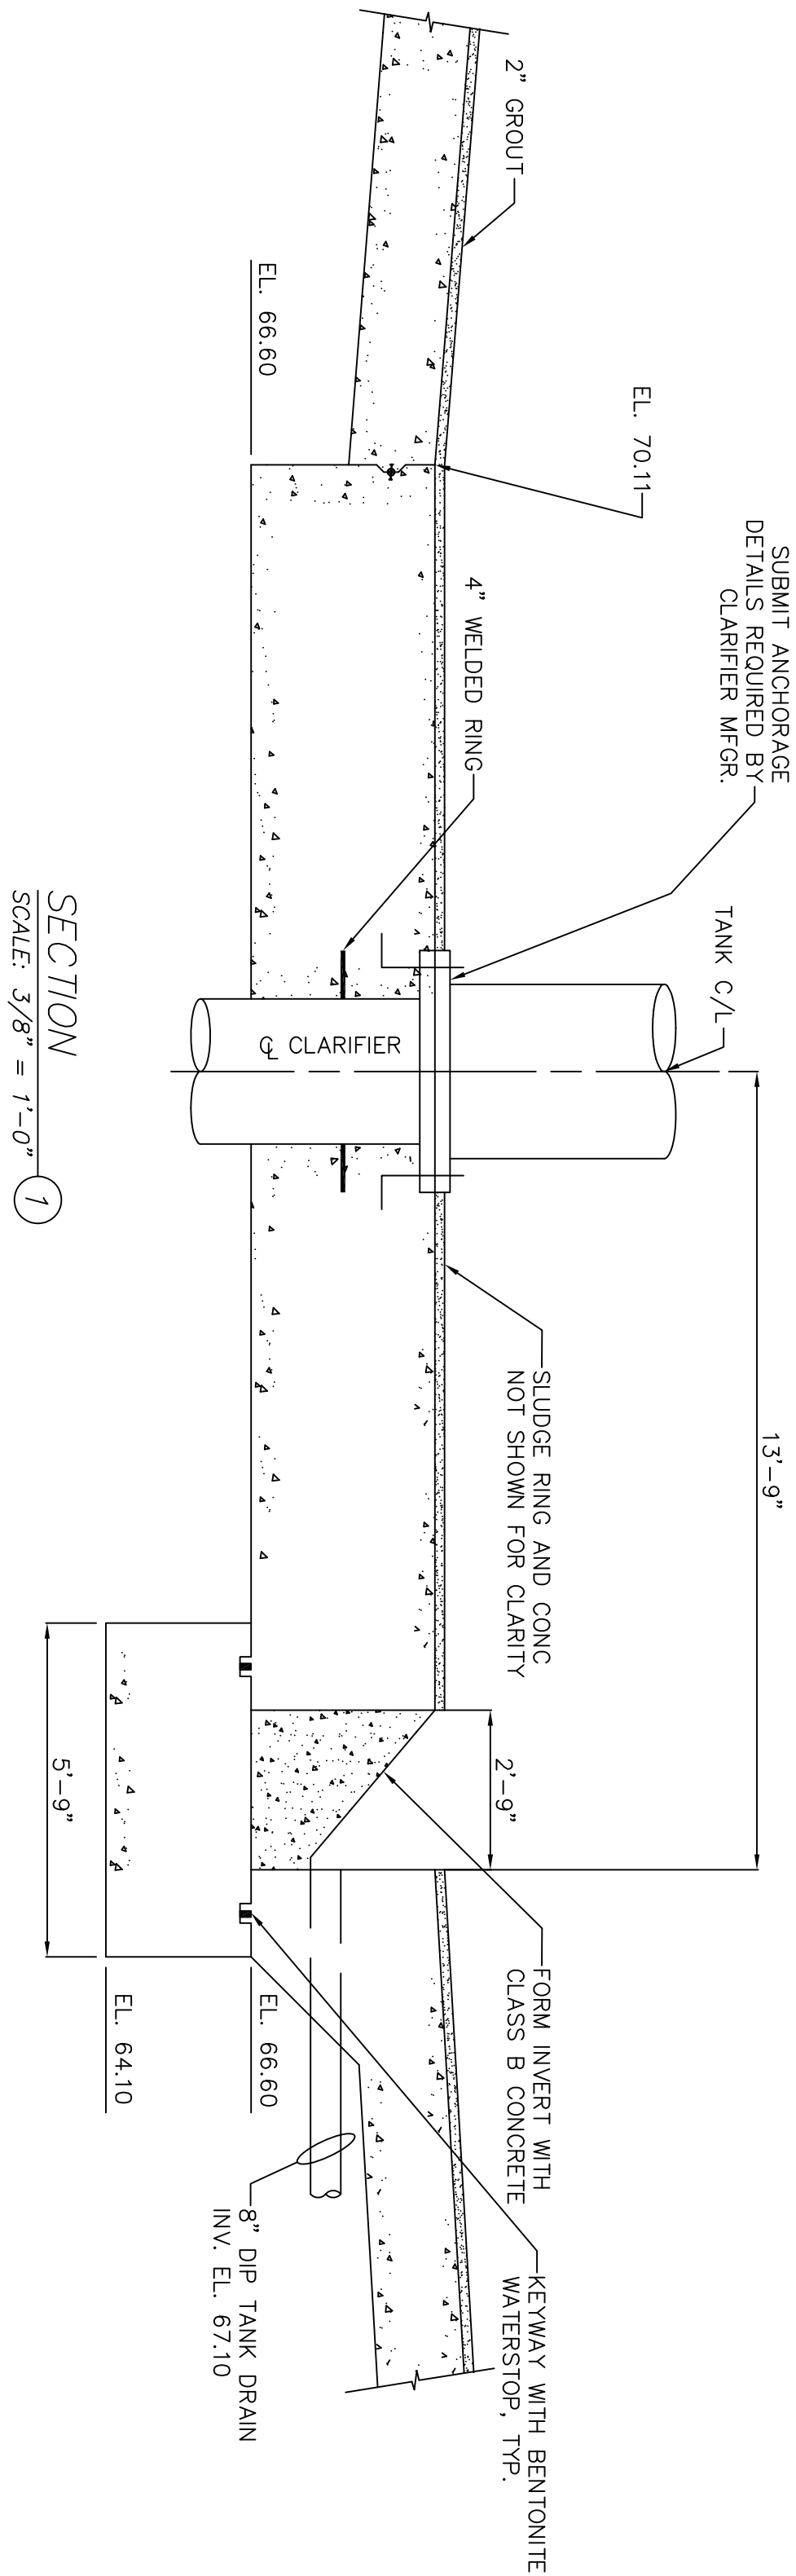


SECTION 1  
SCALE: 3/8"=1'-0"

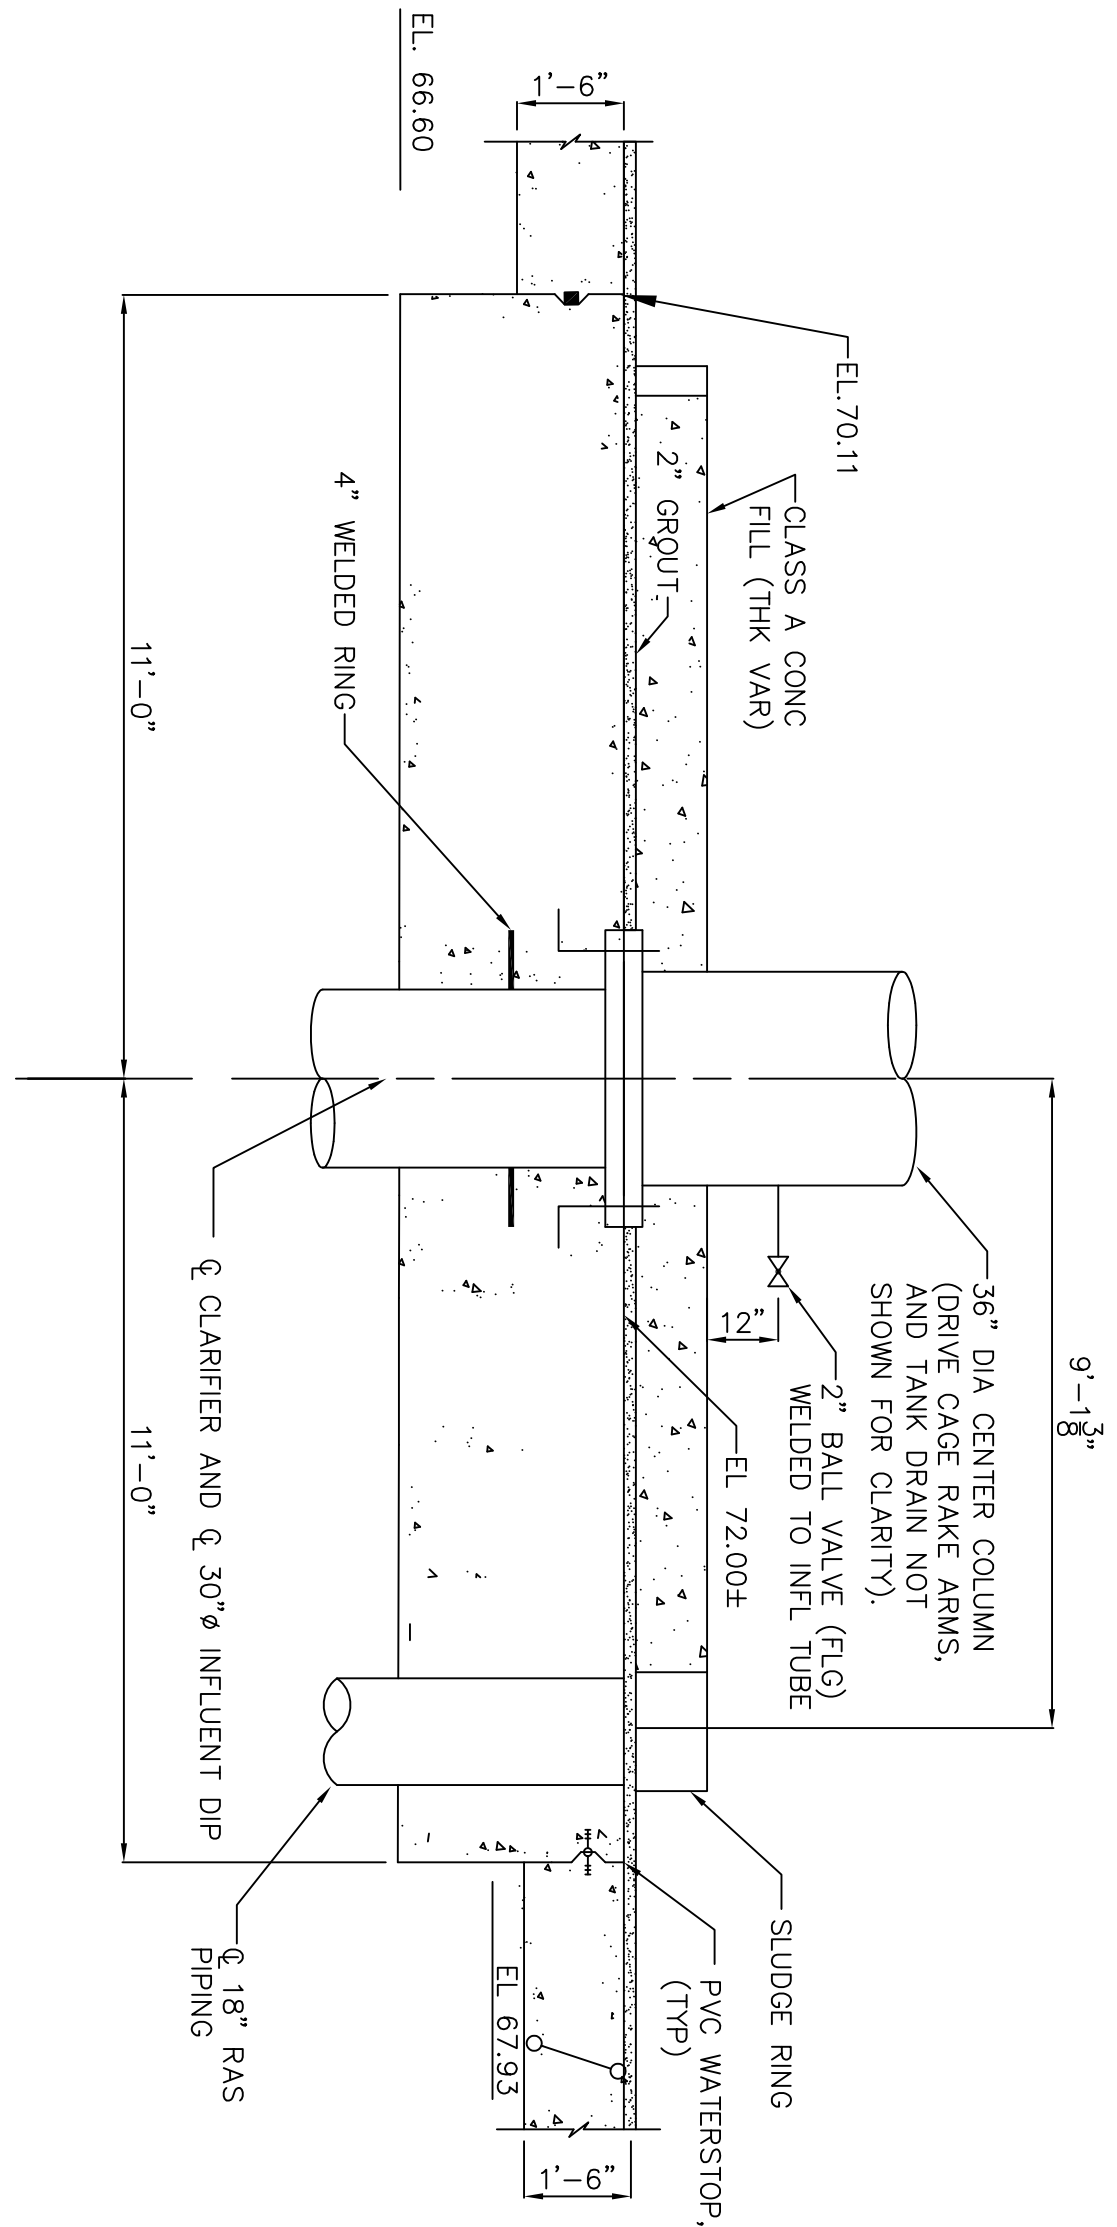

EFFLUENT LAUNDER DETAIL  
SCALE: NONE

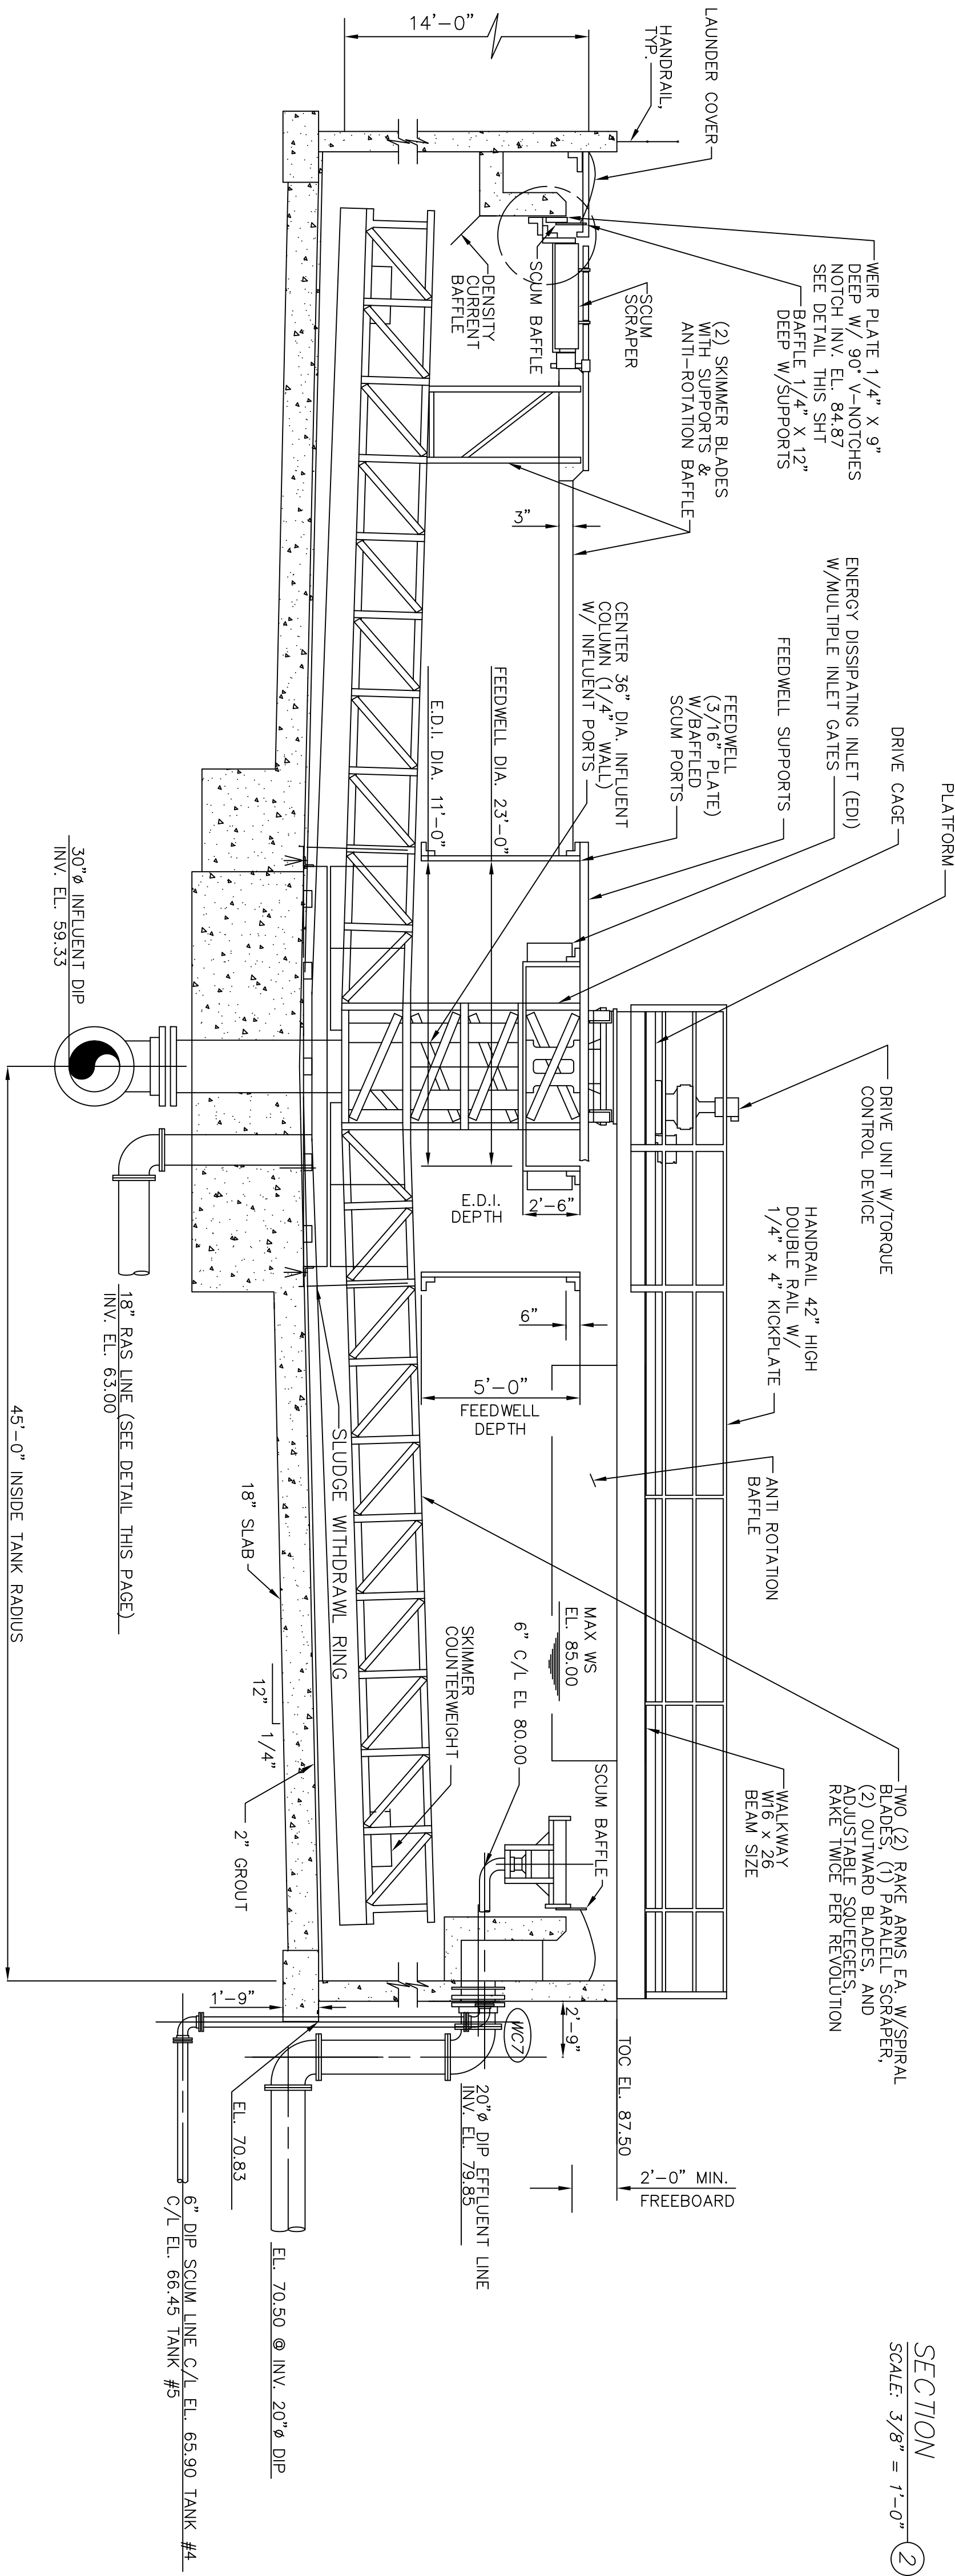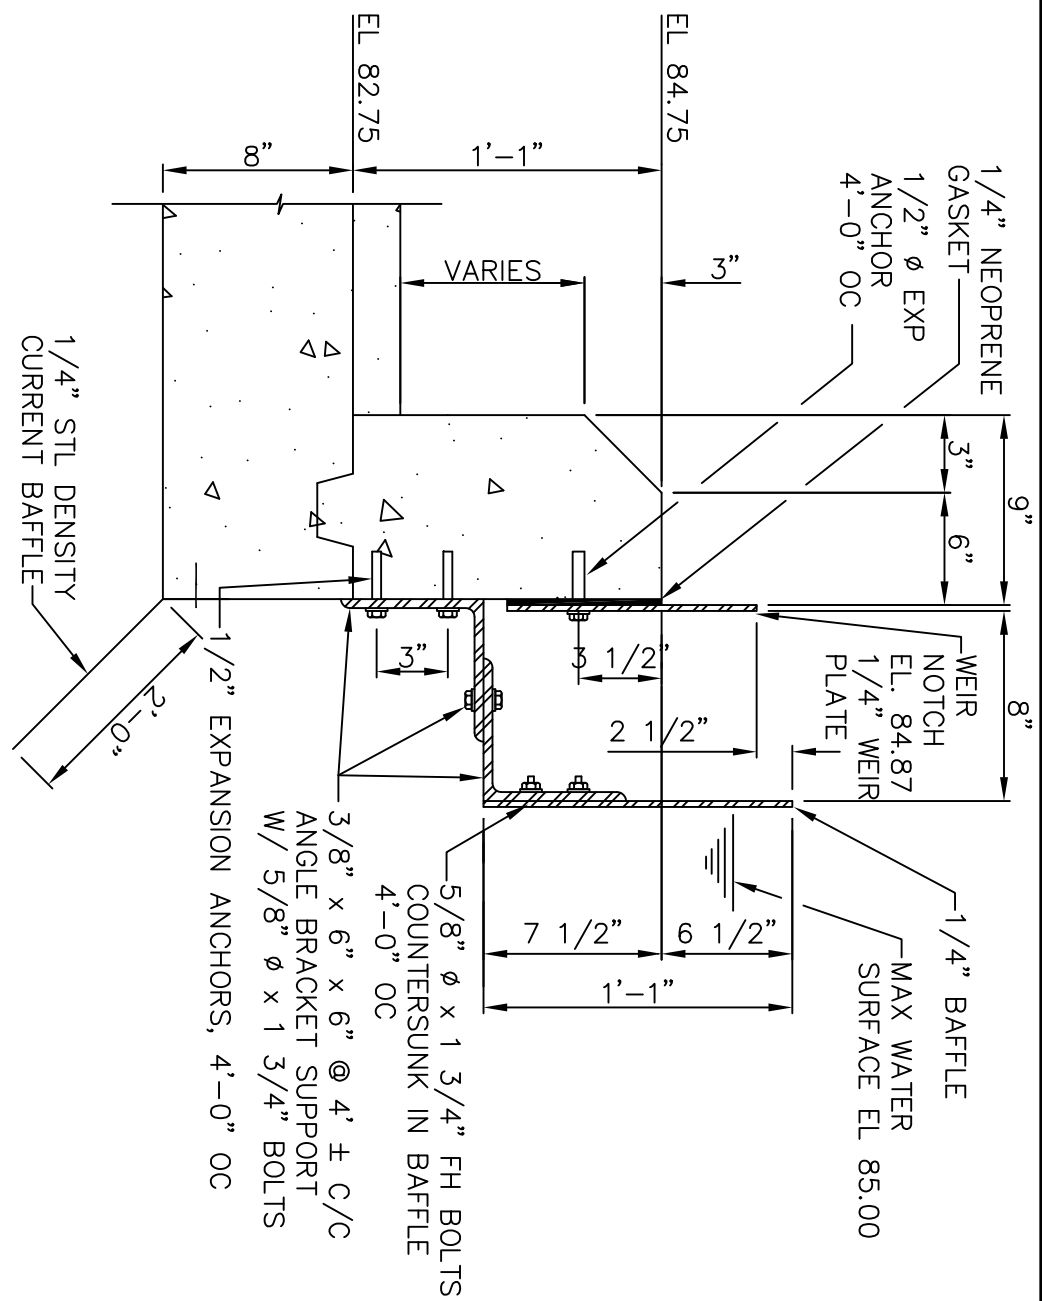

SECTION 2  
SCALE: 3/8"=1'-0"

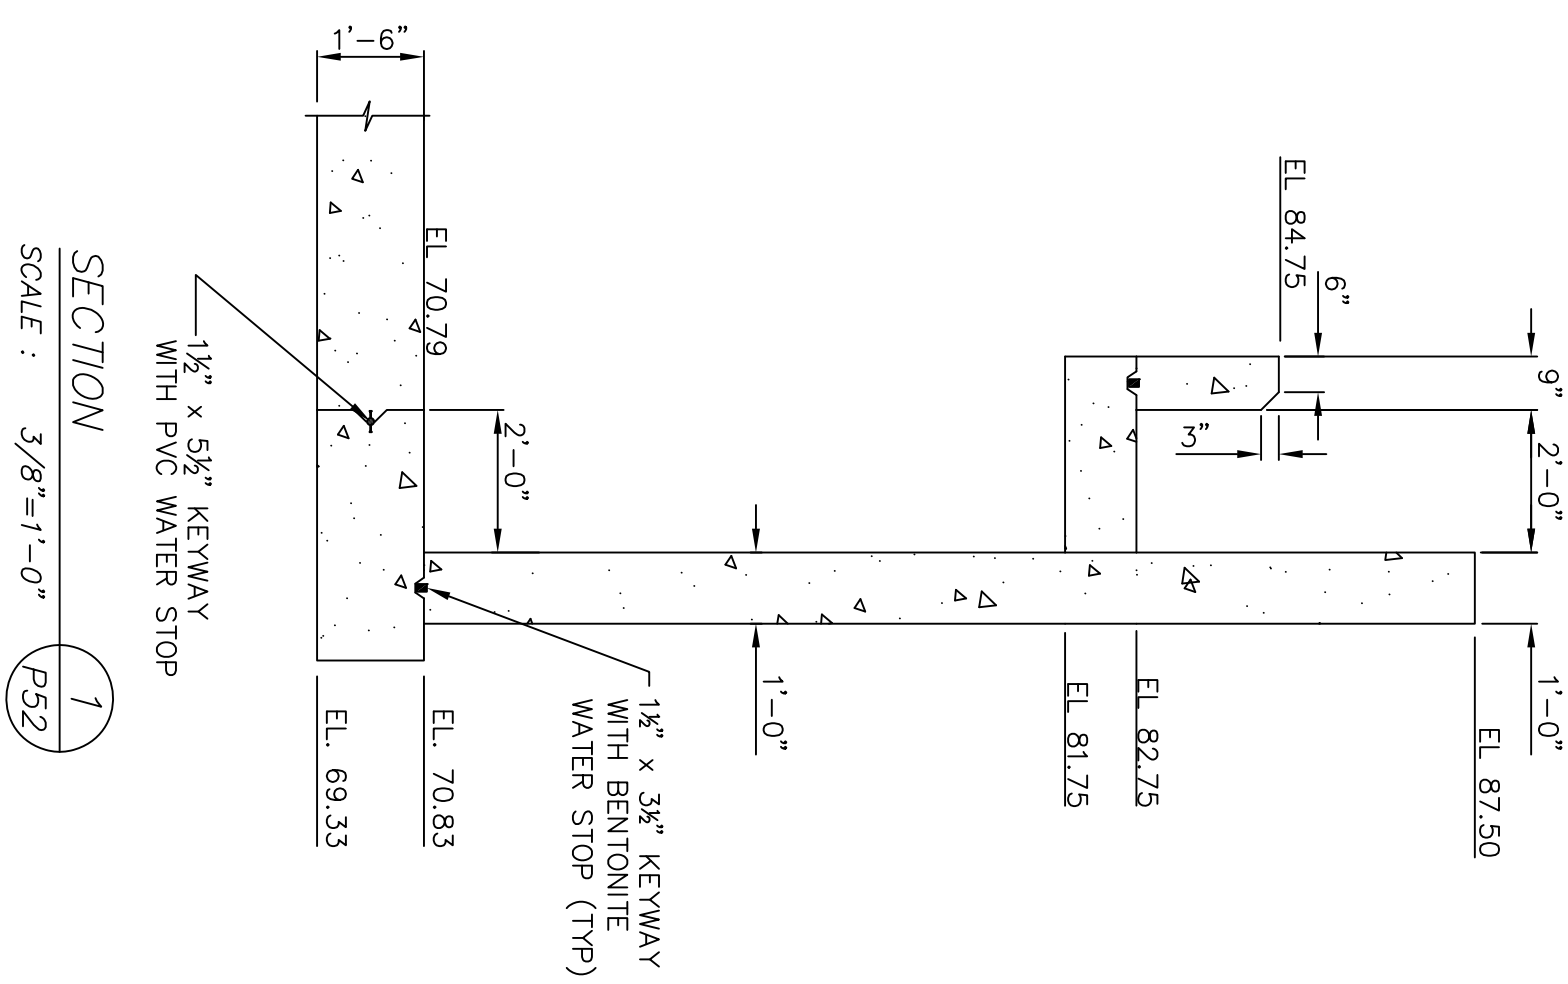

SECTION 1  
SCALE: 3/8"=1'-0"



ENVIRONMENTAL, INC.  
ENGINEERS IN WATER AND EARTH SCIENCES  
UNIONTOWN, OHIO

CITY OF MASSILLON, OHIO  
WWTP UPGRADE 2000  
SECONDARY CLAIRIFIER Nos 4 AND 5 – SECTION

| DESIGNED BY | REVISIONS |                |      |     |       |
|-------------|-----------|----------------|------|-----|-------|
|             | NO.       | DESCRIPTIONS   | DATE | BY  | APP'D |
| MGW         | 1         | ADDENDUM NO. 1 | 9/14 | MGW | WAD   |
|             | 2         | ADDENDUM NO. 3 | 9/28 | MGW | WAD   |
| SAT         | 3         | RECORD DRAWING | 4/05 | MGW | WAD   |
|             |           |                |      |     |       |
| CHECKED BY  |           |                |      |     |       |
| MGW         |           |                |      |     |       |
| APPROVED BY |           |                |      |     |       |
| WAD         |           |                |      |     |       |

THIS DRAWING IS AN INSTRUMENT OF SERVICE OWNED BY CITI ENVIRONMENTAL, INC. WHICH SHALL BE DEEMED THE AUTHOR AND WHICH SHALL RETAIN ALL STATUTORY AND COMMON LAW RIGHTS, INCLUDING COPYRIGHT. THIS DRAWING SHALL NOT BE SCANNED, COPIED, OR DISTRIBUTED TO OTHERS IN ANY FORM OR USED FOR ANY OTHER PURPOSE OR PROJECT WITHOUT PRIOR WRITTEN CONSENT OF CITI ENVIRONMENTAL, INC. CITI ENVIRONMENTAL, INC. CANNOT GUARANTEE THAT ELECTRONIC COPIES OF THIS DRAWING ARE EXACT DUPLICATES OF THE SEALED ORIGINAL DRAWING. IN THE EVENT OF A CONFLICT BETWEEN AN ELECTRONIC COPY AND THE SEALED ORIGINAL, THE SEALED ORIGINAL SHALL GOVERN.

THESE RECORD DOCUMENTS HAVE BEEN PREPARED BASED ON INFORMATION PROVIDED BY OTHERS. CITI ENVIRONMENTAL HAS REVIEWED THE INFORMATION SUBMITTED AND BELIEVES IT REFLECTS THE WORK AS CONSTRUCTED. HOWEVER, ALL PERSONS SHALL VERIFY INFORMATION TAKEN FROM THIS DRAWING.

|       |          |
|-------|----------|
| DATE  | 08/13/01 |
| SCALE | AS NOTED |
| SHEET | P53      |