
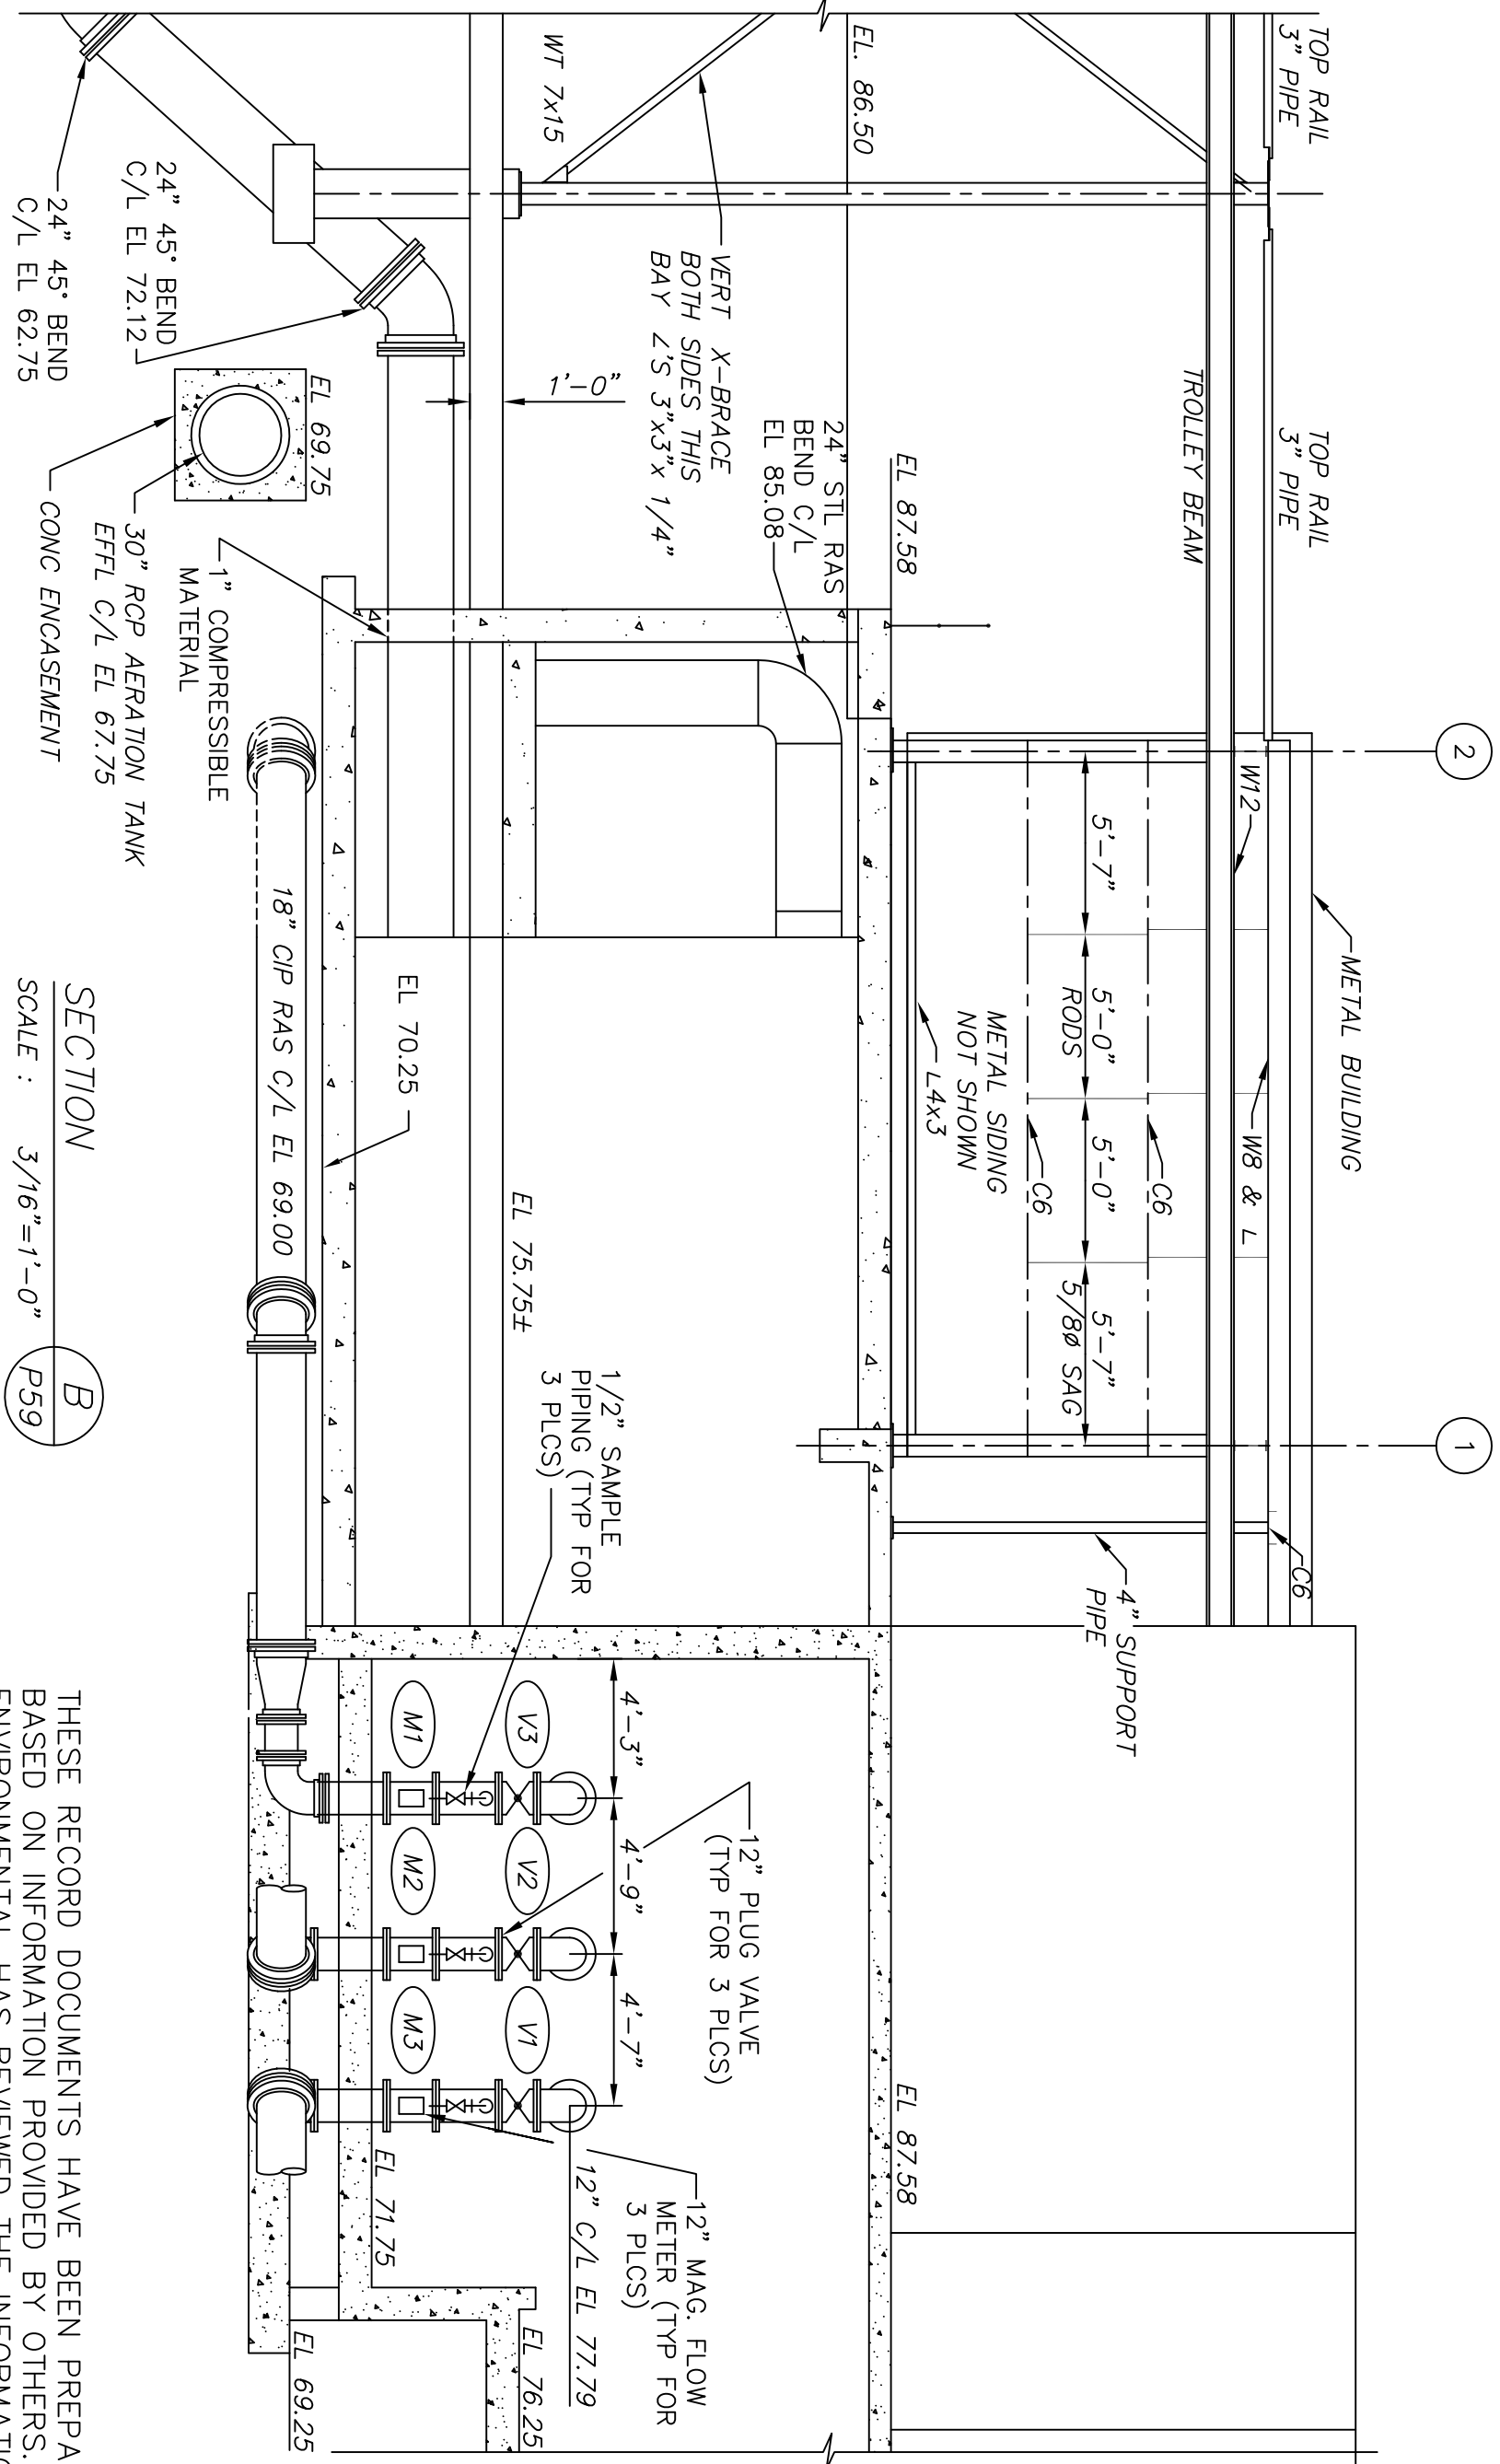
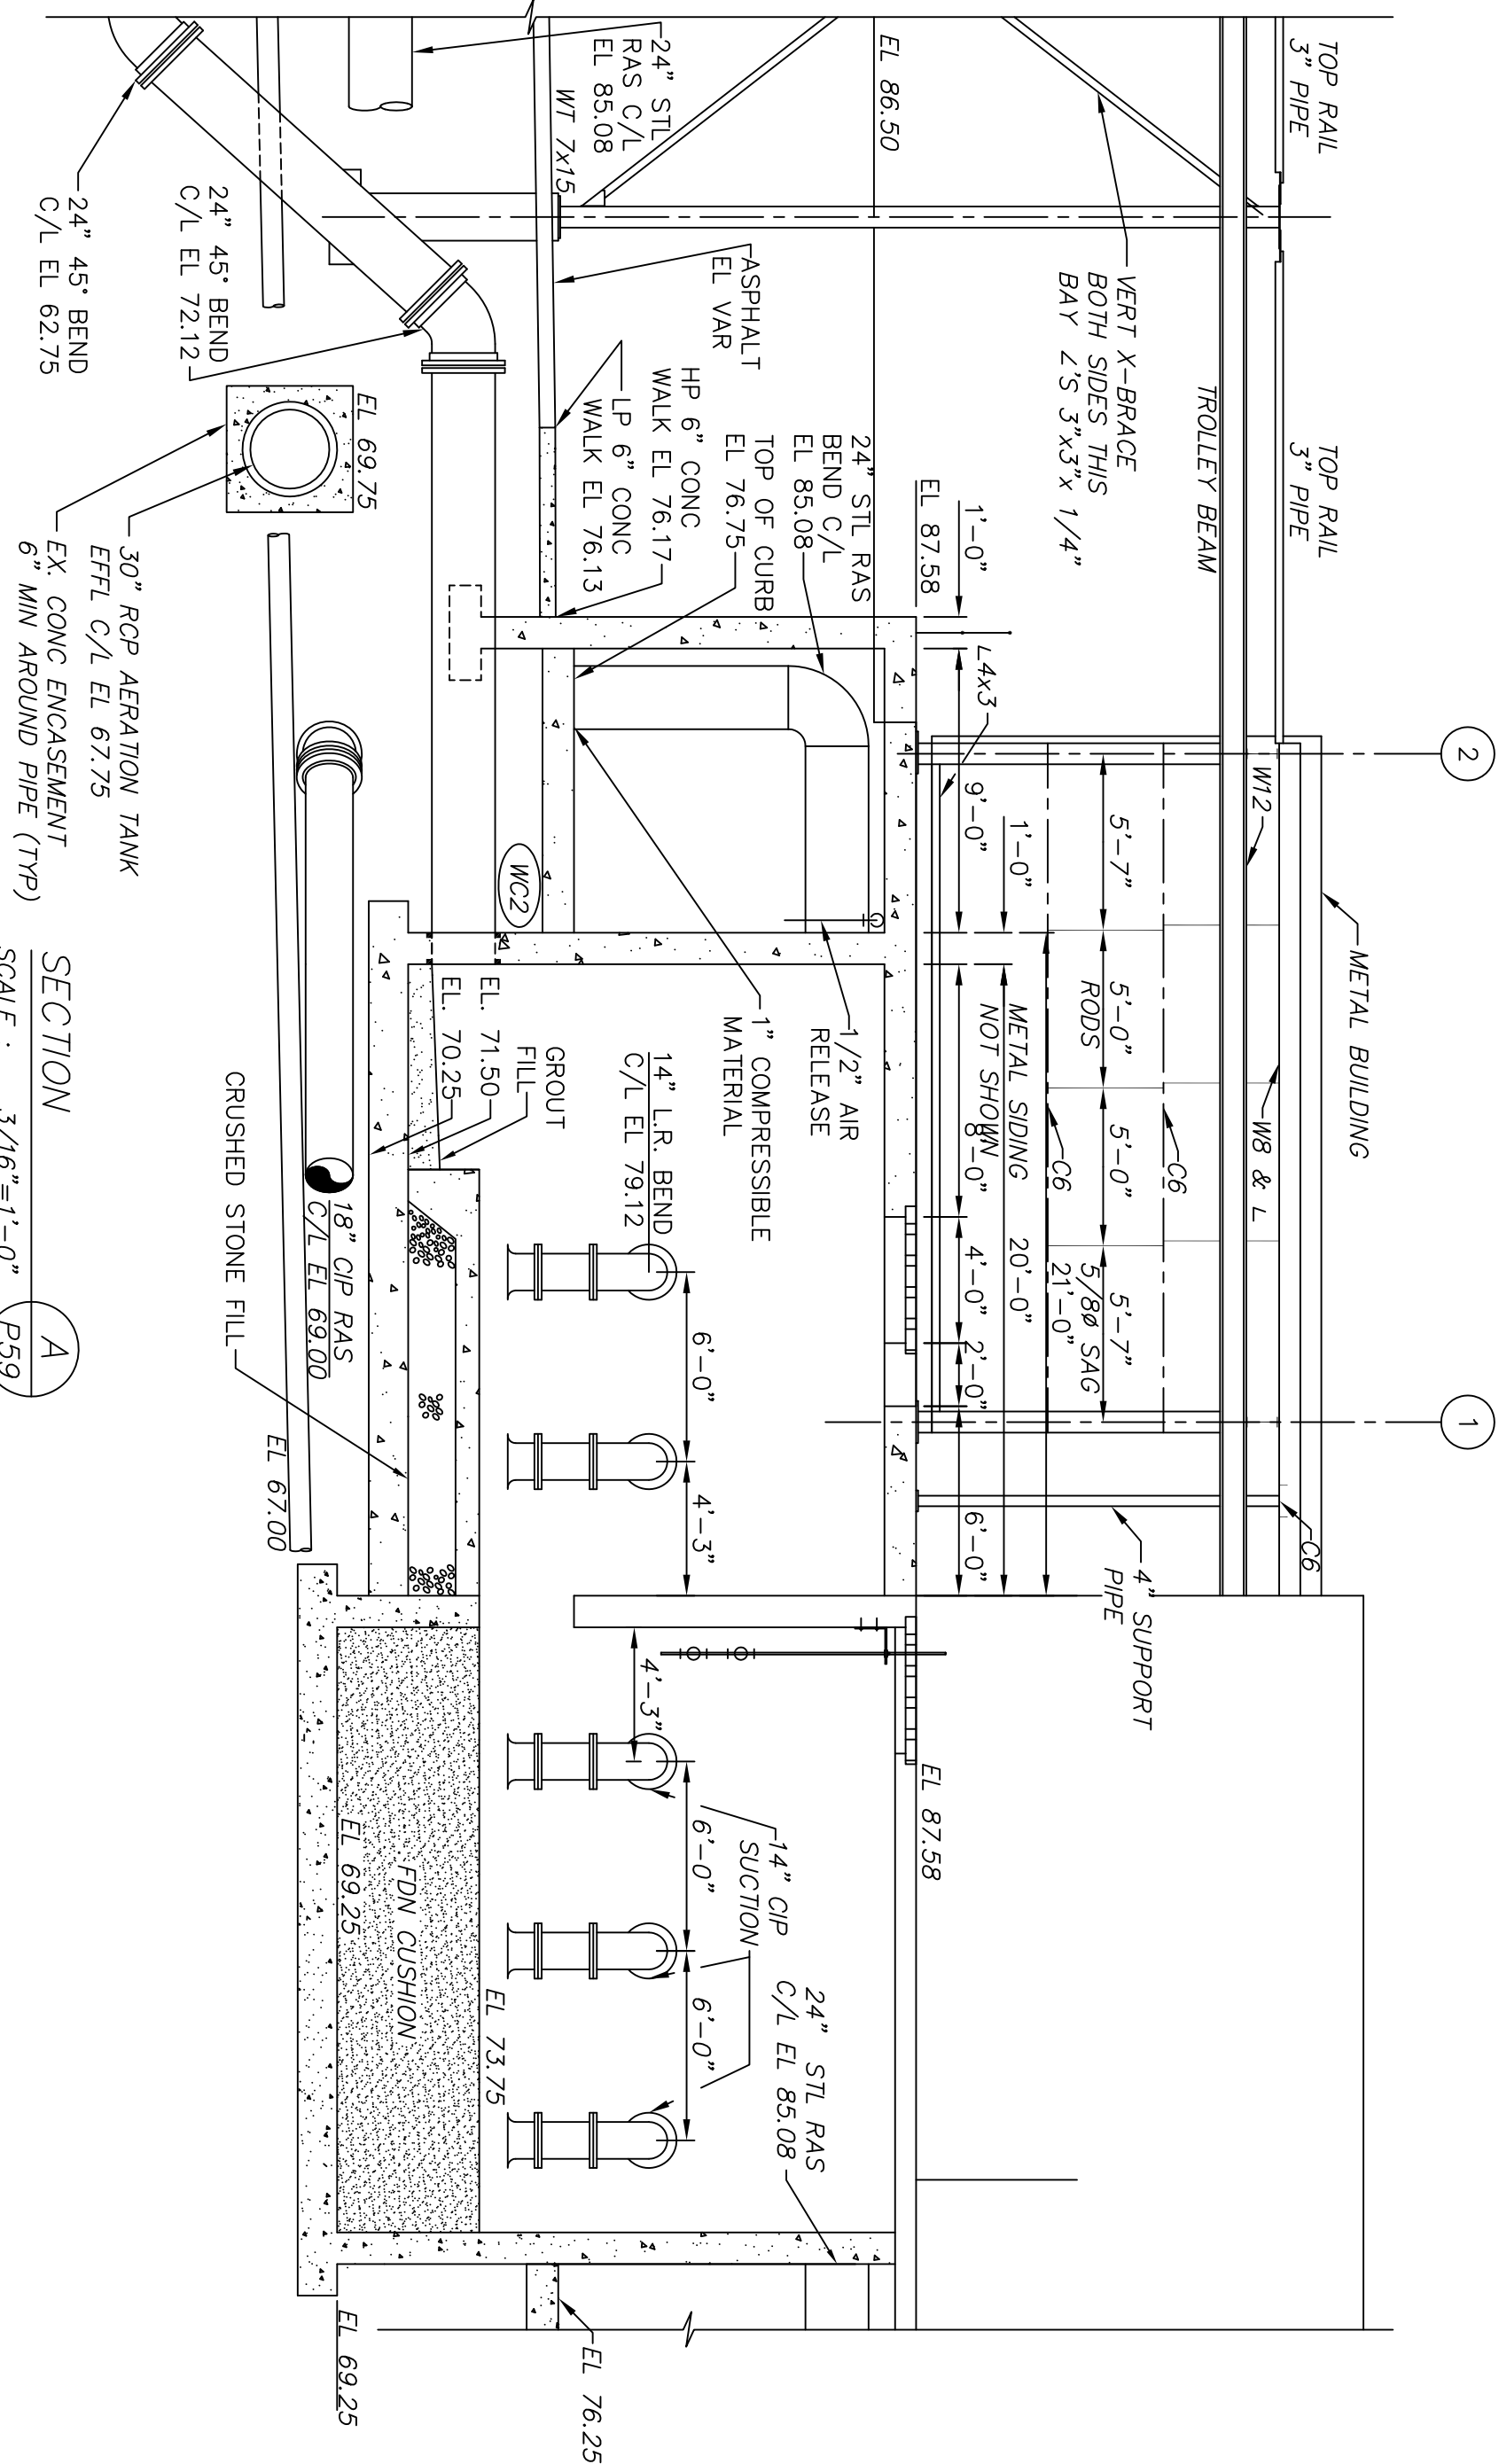
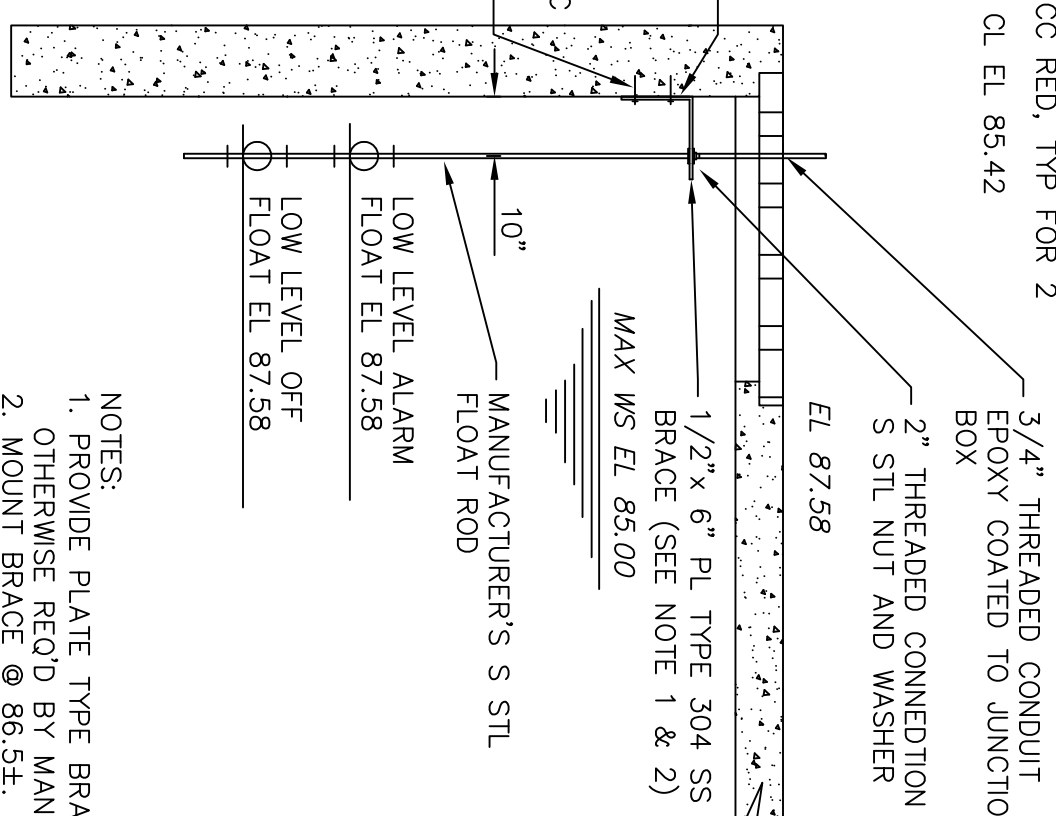
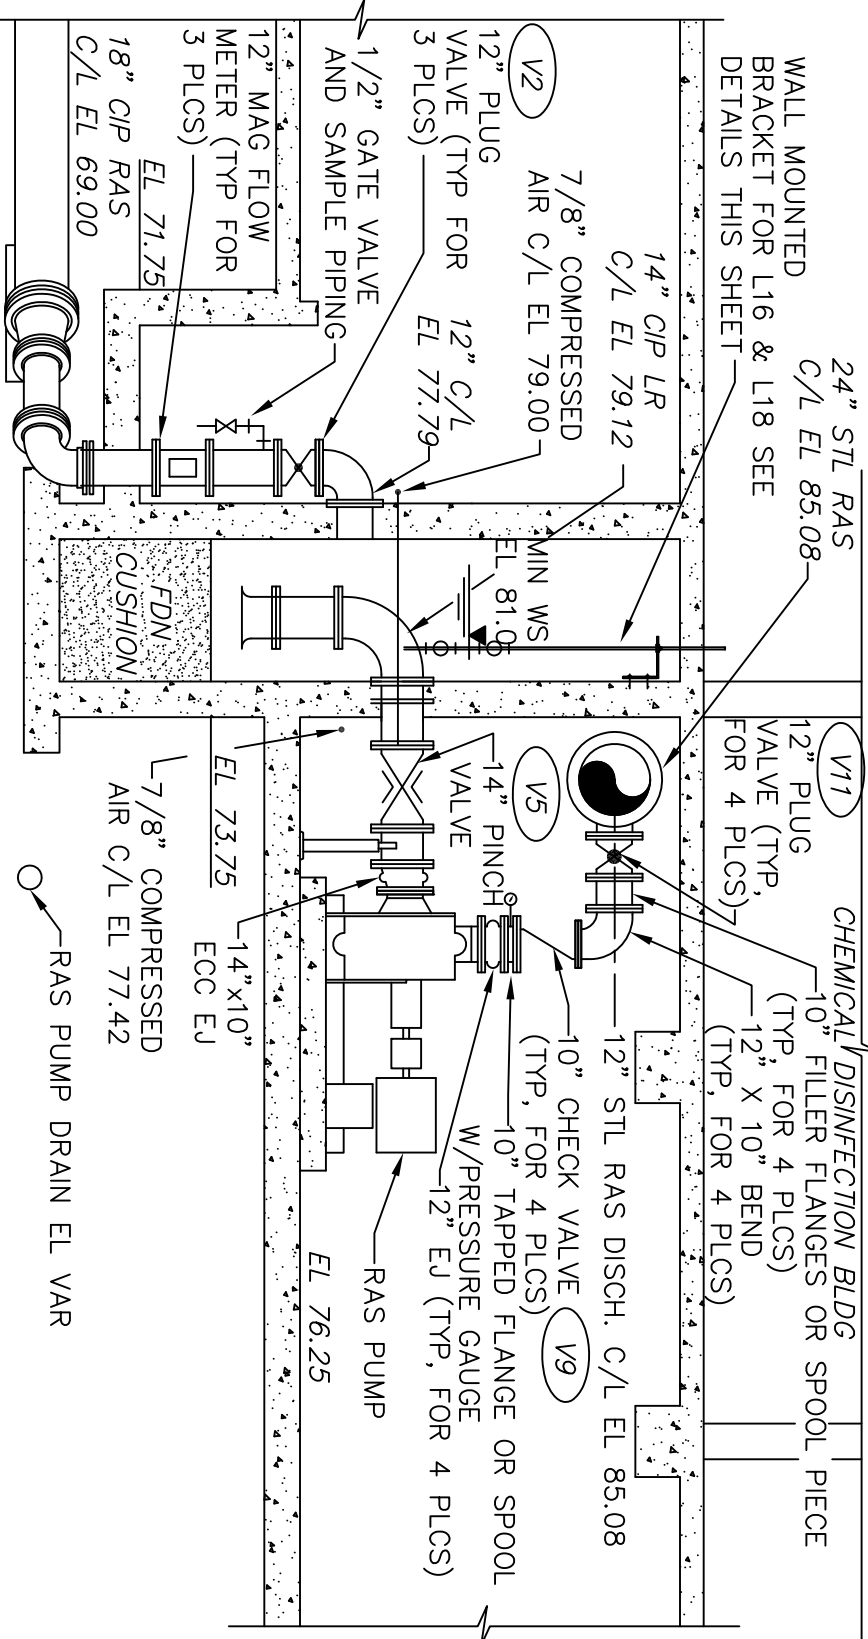


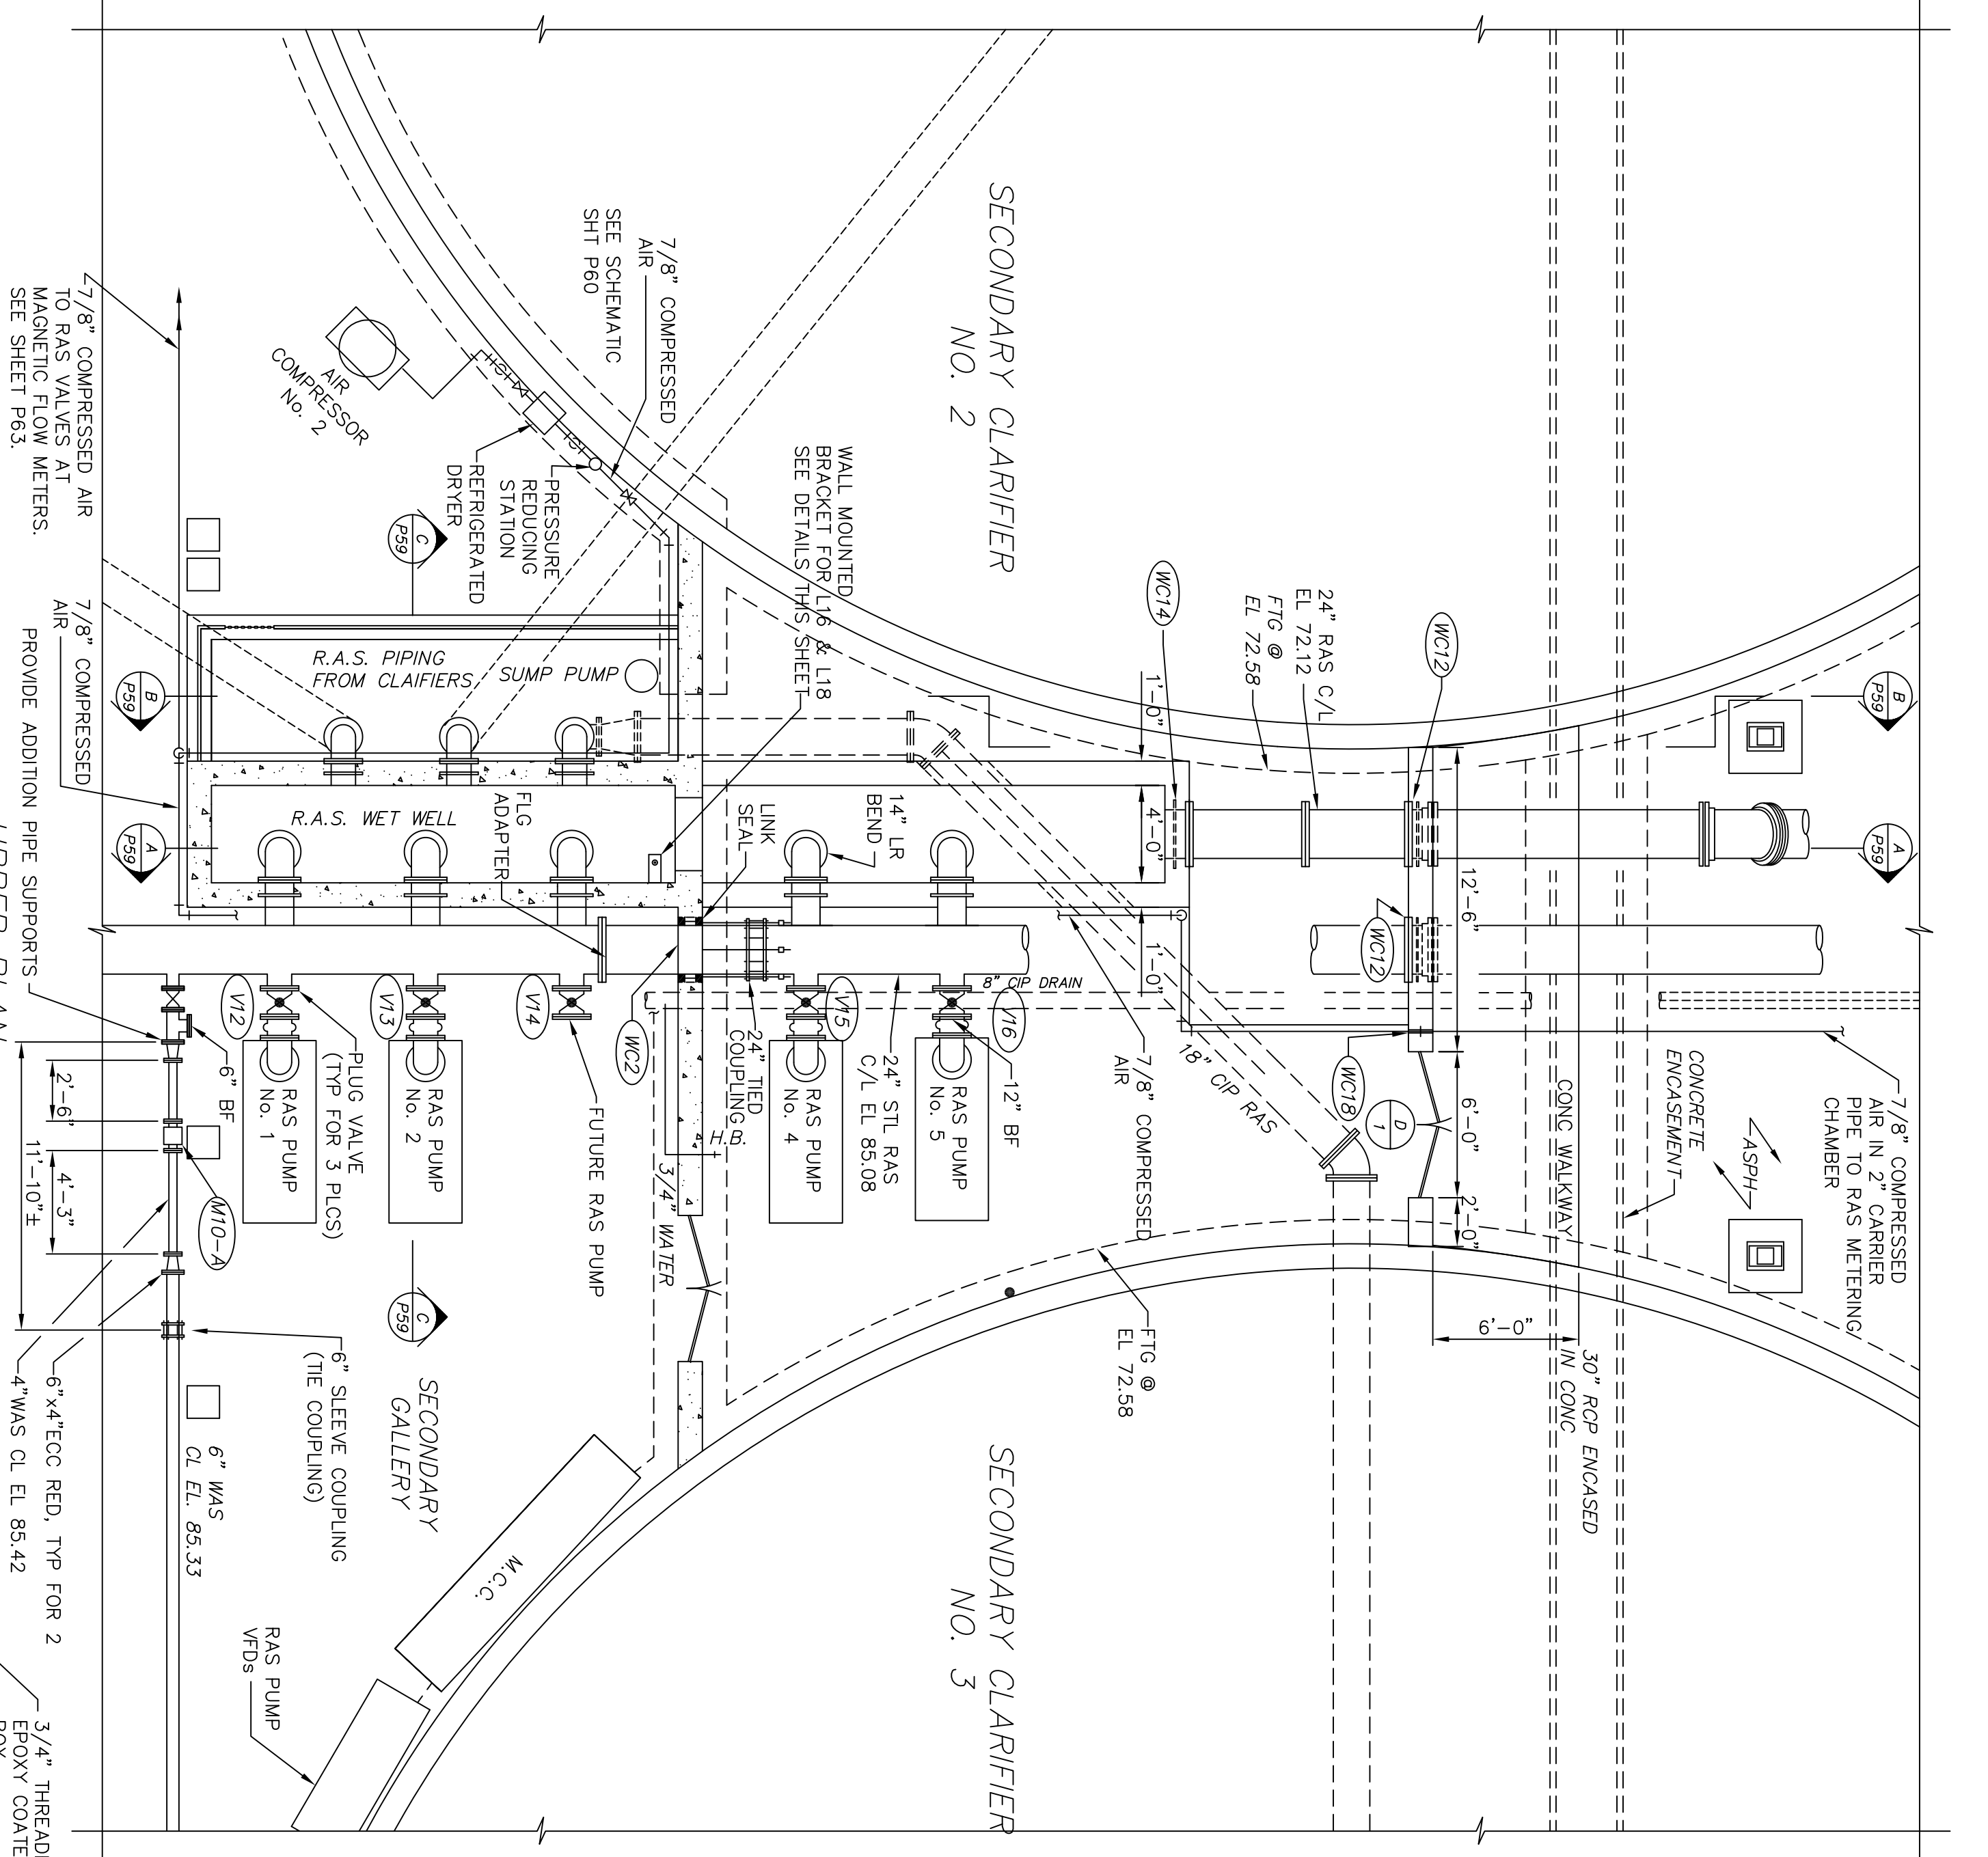

ENVIRONMENTAL, INC.
ENGINEERS IN WATER AND EARTH SCIENCES
UNIONTOWN, OHIO

CITY OF MASSILLON, OHIO
WWTP UPGRADE 2000
RAS PUMP PLANS AND SECTIONS

DESIGNED BY	REVISIONS				
	NO.	DESCRIPTIONS	DATE	BY	APP'D
MGW	1	RECORD DRAWING	1/27	MGW	WAD
DRAWN BY					
SAT					
CHECKED BY					
MGW					
APPROVED BY					
WAD					


THIS DRAWING IS AN INSTRUMENT OF SERVICE OWNED BY CTI ENVIRONMENTAL, INC. WHICH SHALL BE DEEMED THE AUTHOR AND WHICH SHALL RETAIN ALL STATUTORY AND COMMON LAW RIGHTS, INCLUDING COPYRIGHTS. THIS DRAWING SHALL NOT BE SCANNED, COPIED, OR DISTRIBUTED TO OTHERS IN ANY FORM OR USED FOR ANY OTHER PURPOSE OR PROJECT WITHOUT PRIOR WRITTEN CONSENT OF CTI ENVIRONMENTAL, INC. CTI ENVIRONMENTAL, INC. CANNOT GUARANTEE THAT ELECTRONIC COPIES OF THIS DRAWING ARE EXACT DUPLICATES OF THE SEALED ORIGINAL DRAWING. IN THE EVENT OF A CONFLICT BETWEEN AN ELECTRONIC COPY AND THE SEALED ORIGINAL, THE SEALED ORIGINAL SHALL GOVERN.

NOTES:
1. PROVIDE 4" DIA STL PIPE WITH GRADE AT
14" RAS SUCTION PIPE.
2. PROVIDE STL PIPE FOR RAS DISCHARGE
PIPING FLANGED OR MECHANICAL GROOVE
CONNECTIONS.

SECTION
SCALE : 3/16"=1'-0"
P59

FLOAT MOUNTING DETAIL
SCALE: 3/8"=1'-0"


ITEMS FOR DEMOLITION

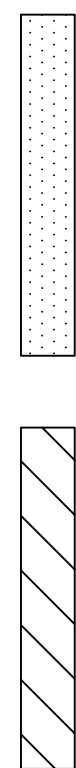

SECTION
SCALE : 3/16"=1'-0"
P59

THESE RECORD DOCUMENTS HAVE BEEN PREPARED
BASED ON INFORMATION PROVIDED BY OTHERS. CTI
ENVIRONMENTAL HAS REVIEWED THE INFORMATION
SUBMITTED AND BELIEVES IT REFLECTS THE WORK AS
CONSTRUCTED. HOWEVER, ALL PERSONS SHALL
VERIFY INFORMATION TAKEN FROM THIS DRAWING.

KEY PLAN

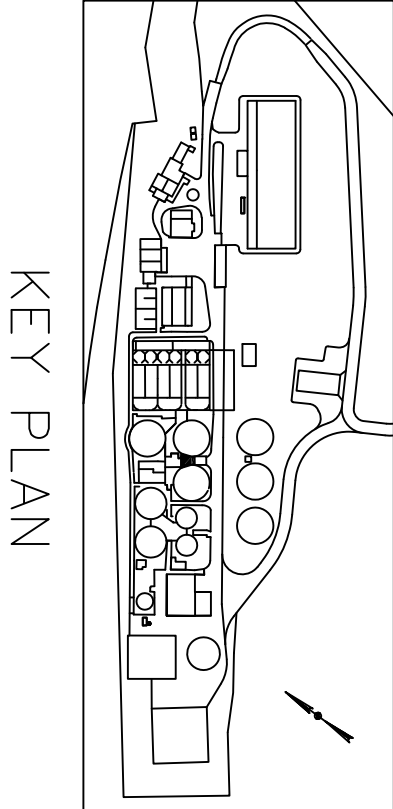

JOB NO. E9031
DATE 08/13/01
SCALE AS NOTED
SHEET P59