



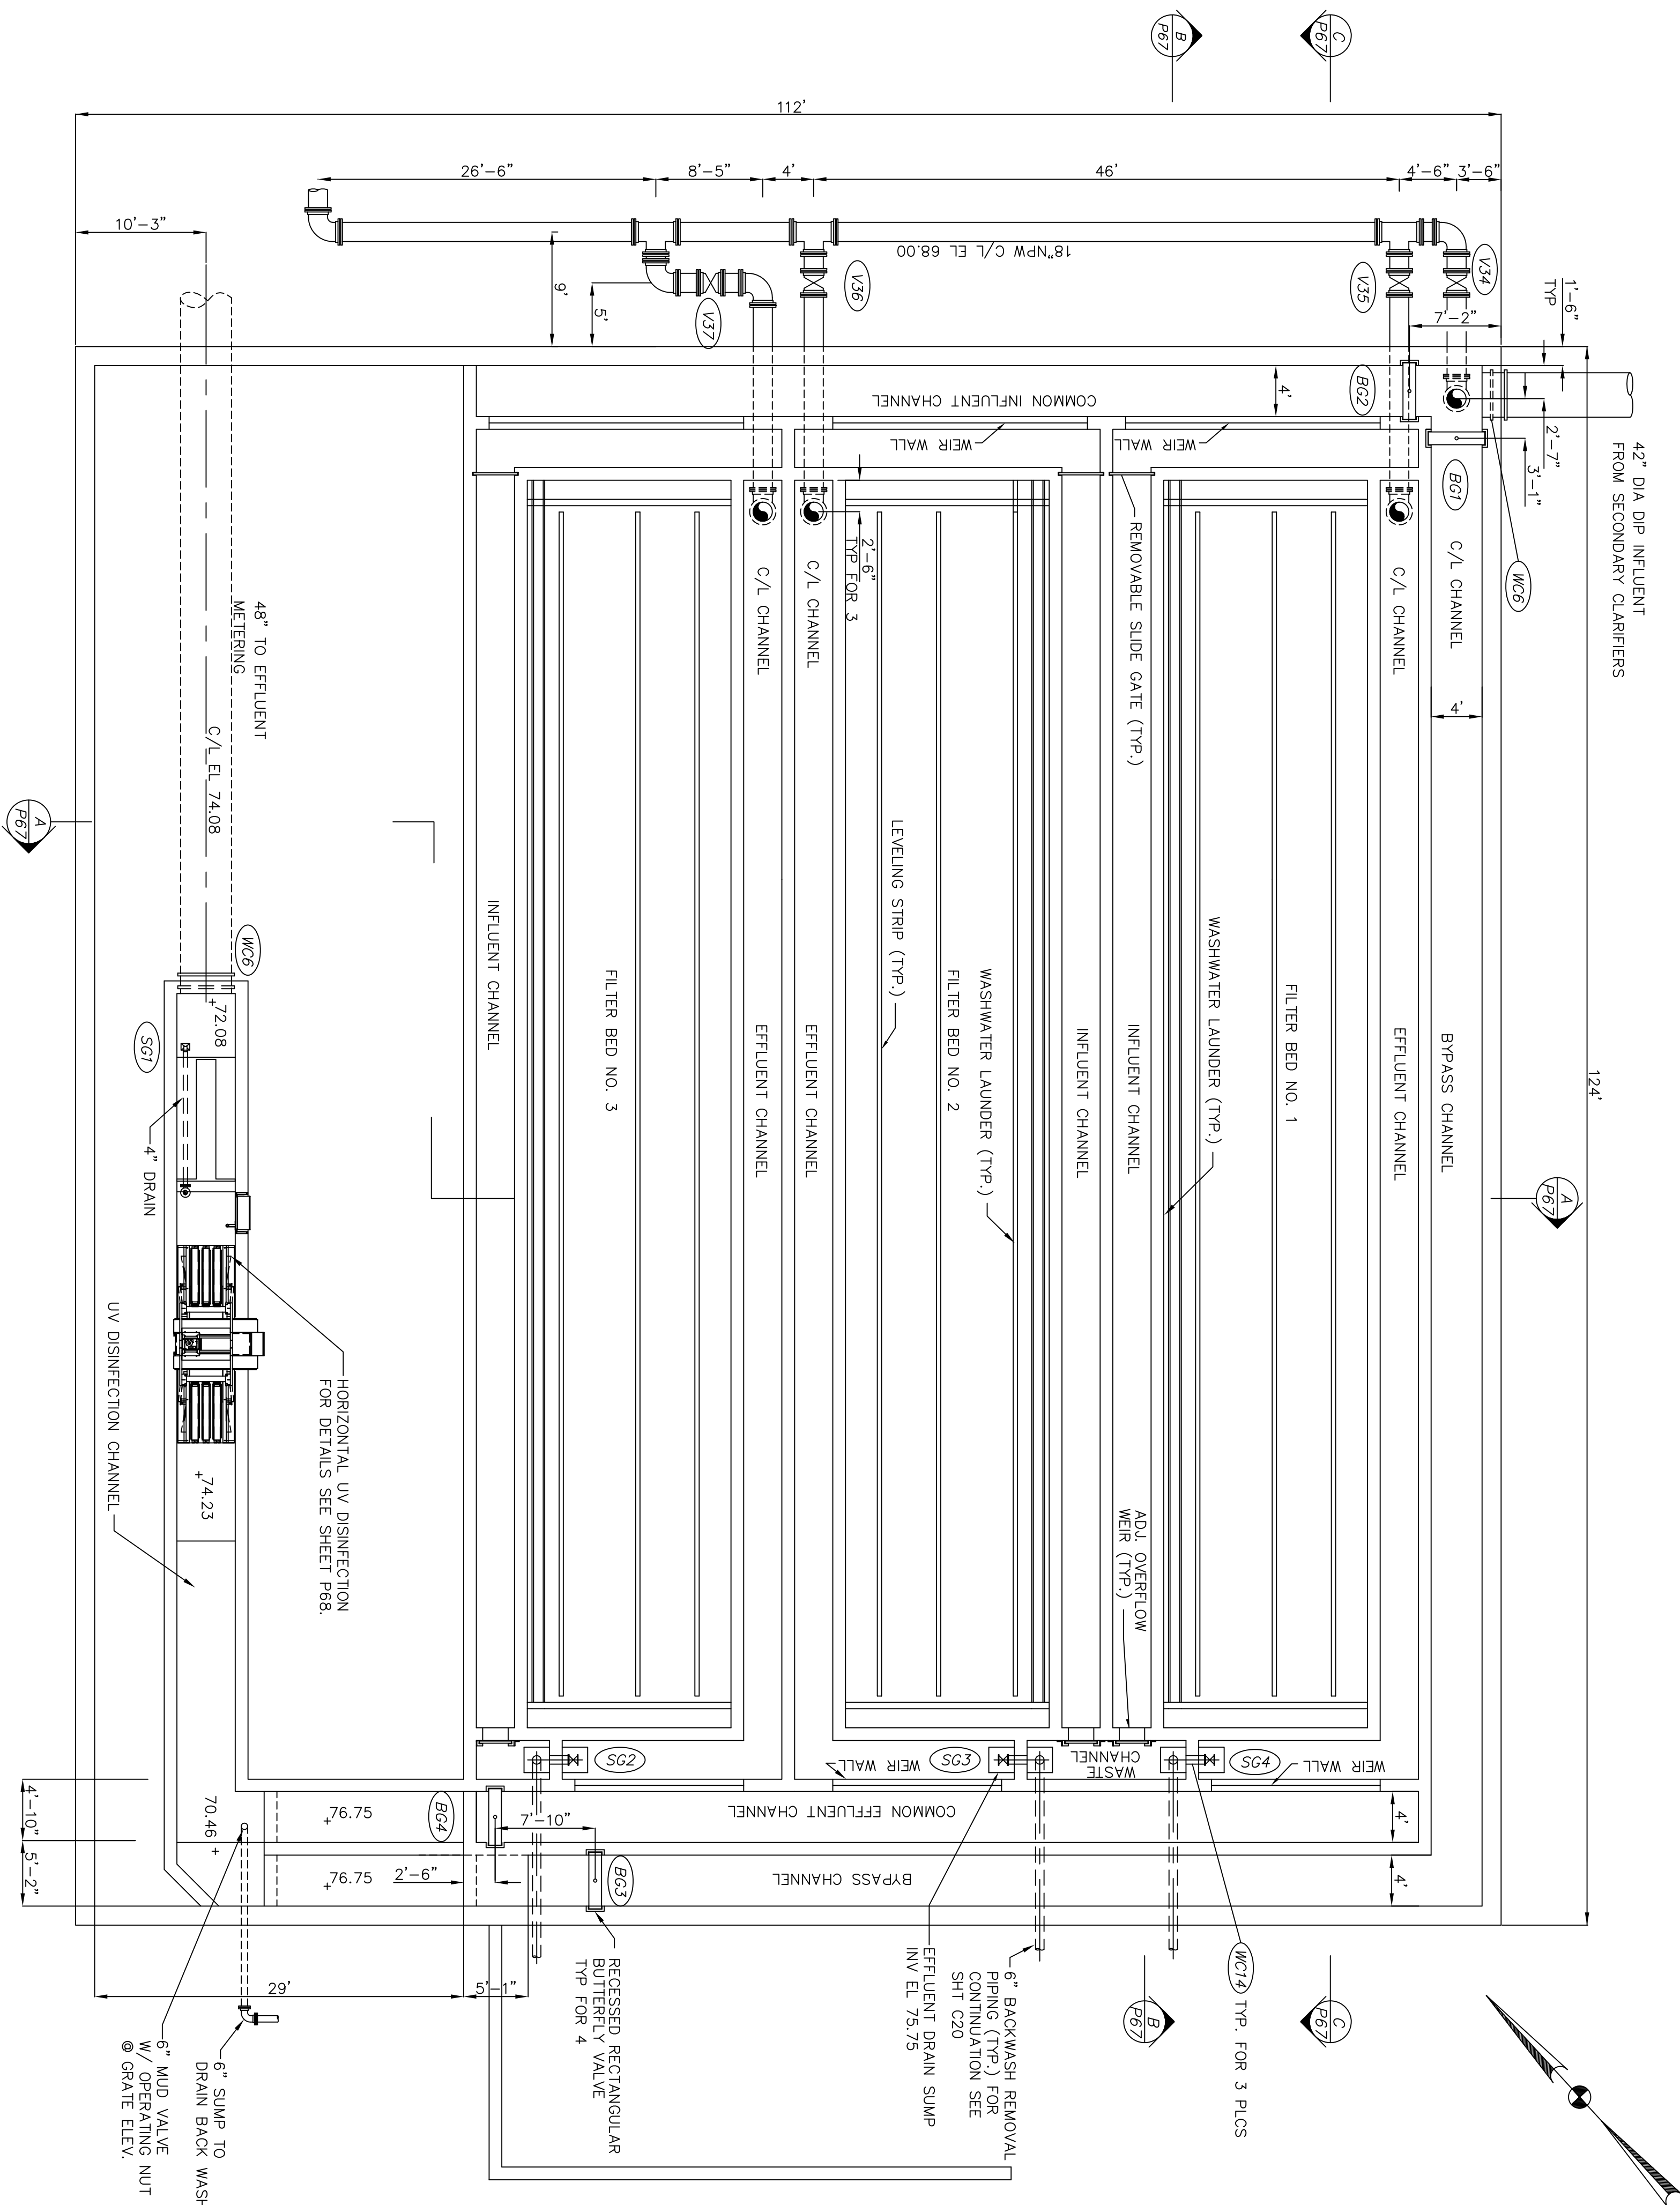


PLAN
SCALE 1/8" = 1'-0"

THESE RECORD DOCUMENTS HAVE BEEN PREPARED BASED ON INFORMATION PROVIDED BY OTHERS. CITI ENVIRONMENTAL HAS REVIEWED THE INFORMATION SUBMITTED AND BELIEVES IT REFLECTS THE WORK AS CONSTRUCTED. HOWEVER, ALL PERSONS SHALL VERIFY INFORMATION TAKEN FROM THIS DRAWING.

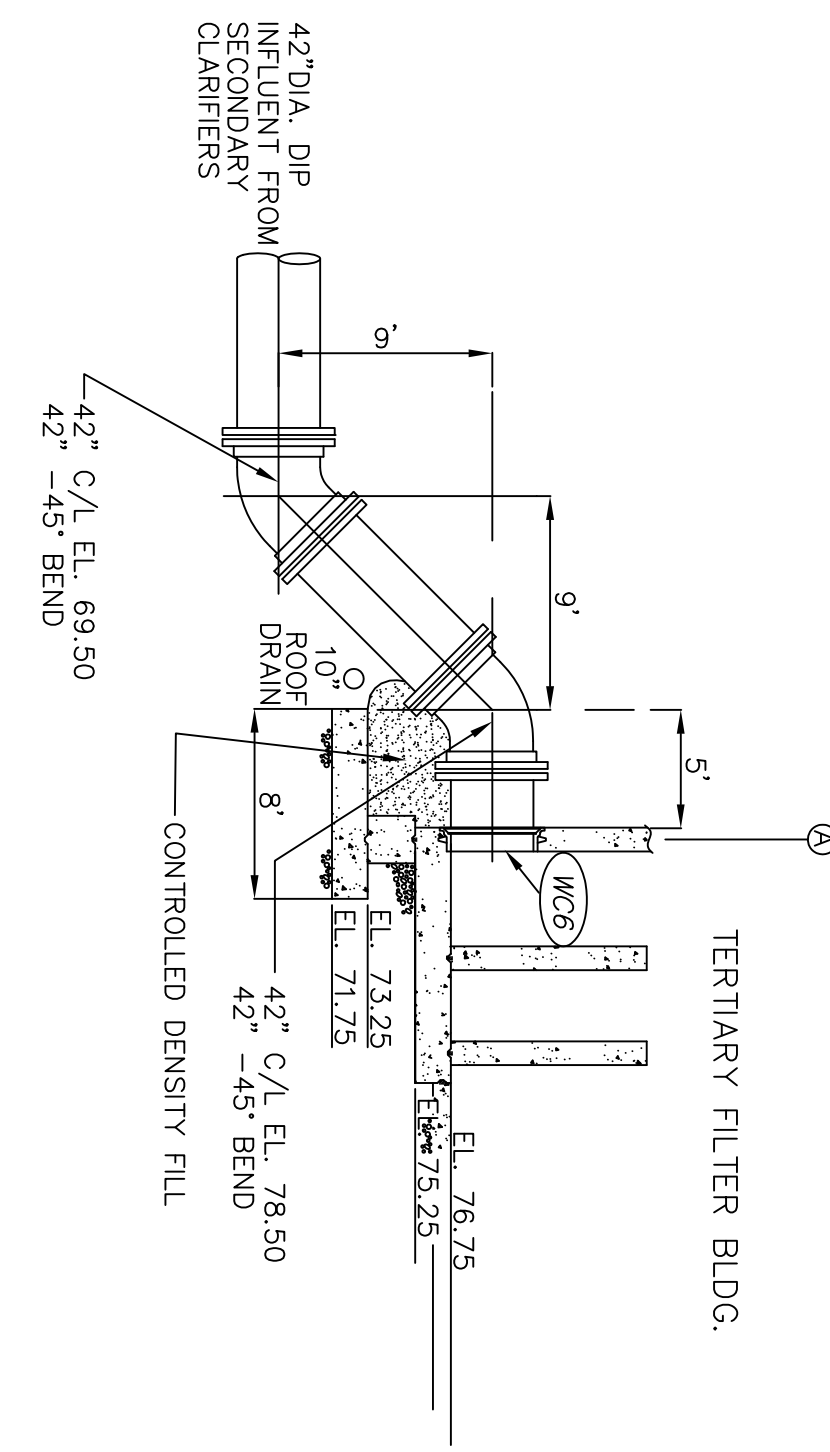

ADJUSTABLE WEIR DETAIL
N.T.S.

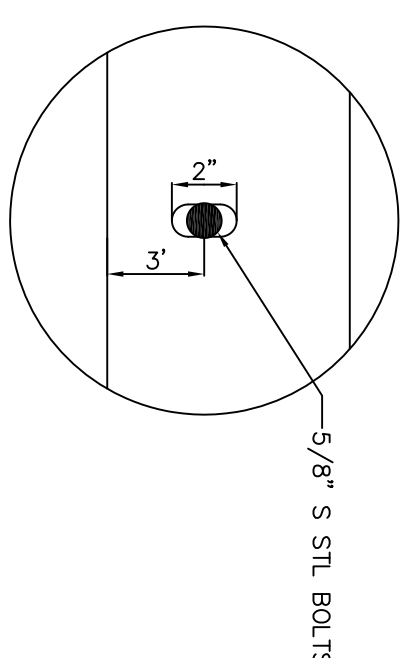

- NOTES:
1. WEIR PLATES SHALL BE ADJUSTABLE TO 1" VERTICALLY
 2. COAT WEIR PLATE WITH TWO (2) COATS BITUMINOUS PAINT PER SPECIFICATION 09900 BEFORE INSTALLING.
 3. MANUFACTURE WEIR OF 1/4" F.R.P.
 4. MINIMUM ANCHOR EMBEDMENT - 4".
 5. PROVIDE CONTINUOUS 1/8" THICK GASKET MEMBRANE FULL SURROUNDING ALL PLUG GASKET BETWEEN CONCRETE WALL AND WEIR PLATE



ENVIRONMENTAL, INC.
ENGINEERS IN WATER AND EARTH SCIENCES
UNIONTOWN, OHIO

CITY OF MASSILLON, OHIO
WWTP UPGRADE 2000
TERTIARY FILTER AND UV DISINFECTION BUILDING
PLAN - EL 76.75

DESIGNED BY	REVISIONS				
	NO.	DESCRIPTIONS	DATE	BY	APP'D
MGW	1	ADDENDUM NO. 3	9/28	MGW	WAD
	2	RECORD DRAWING	3/10	MGW	WAD
DRAWN BY					
SAT/AJP					
CHECKED BY					
MGW					
APPROVED BY					
WAD					

THIS DRAWING IS AN INSTRUMENT OF SERVICE OWNED BY CITI ENVIRONMENTAL, INC. WHICH SHALL BE DEEMED THE AUTHOR AND WHICH SHALL RETAIN ALL STATUTORY AND COMMON LAW RIGHTS, INCLUDING COPYRIGHTS. THIS DRAWING SHALL NOT BE SCANNED, COPIED, OR DISTRIBUTED TO OTHERS IN ANY FORM OR USED FOR ANY OTHER PURPOSE OR PROJECT WITHOUT PRIOR WRITTEN CONSENT OF CITI ENVIRONMENTAL, INC. CITI ENVIRONMENTAL, INC. CANNOT GUARANTEE THAT ELECTRONIC COPIES OF THIS DRAWING ARE EXACT DUPLICATES OF THE SEALED ORIGINAL DRAWING. IN THE EVENT OF A CONFLICT BETWEEN AN ELECTRONIC COPY AND THE SEALED ORIGINAL, THE SEALED ORIGINAL SHALL GOVERN.