




ADDENDUM NO. 3

CITY OF MASSILLON, OHIO
WWTP UPGRADE 2000
TERTIARY FILTERS

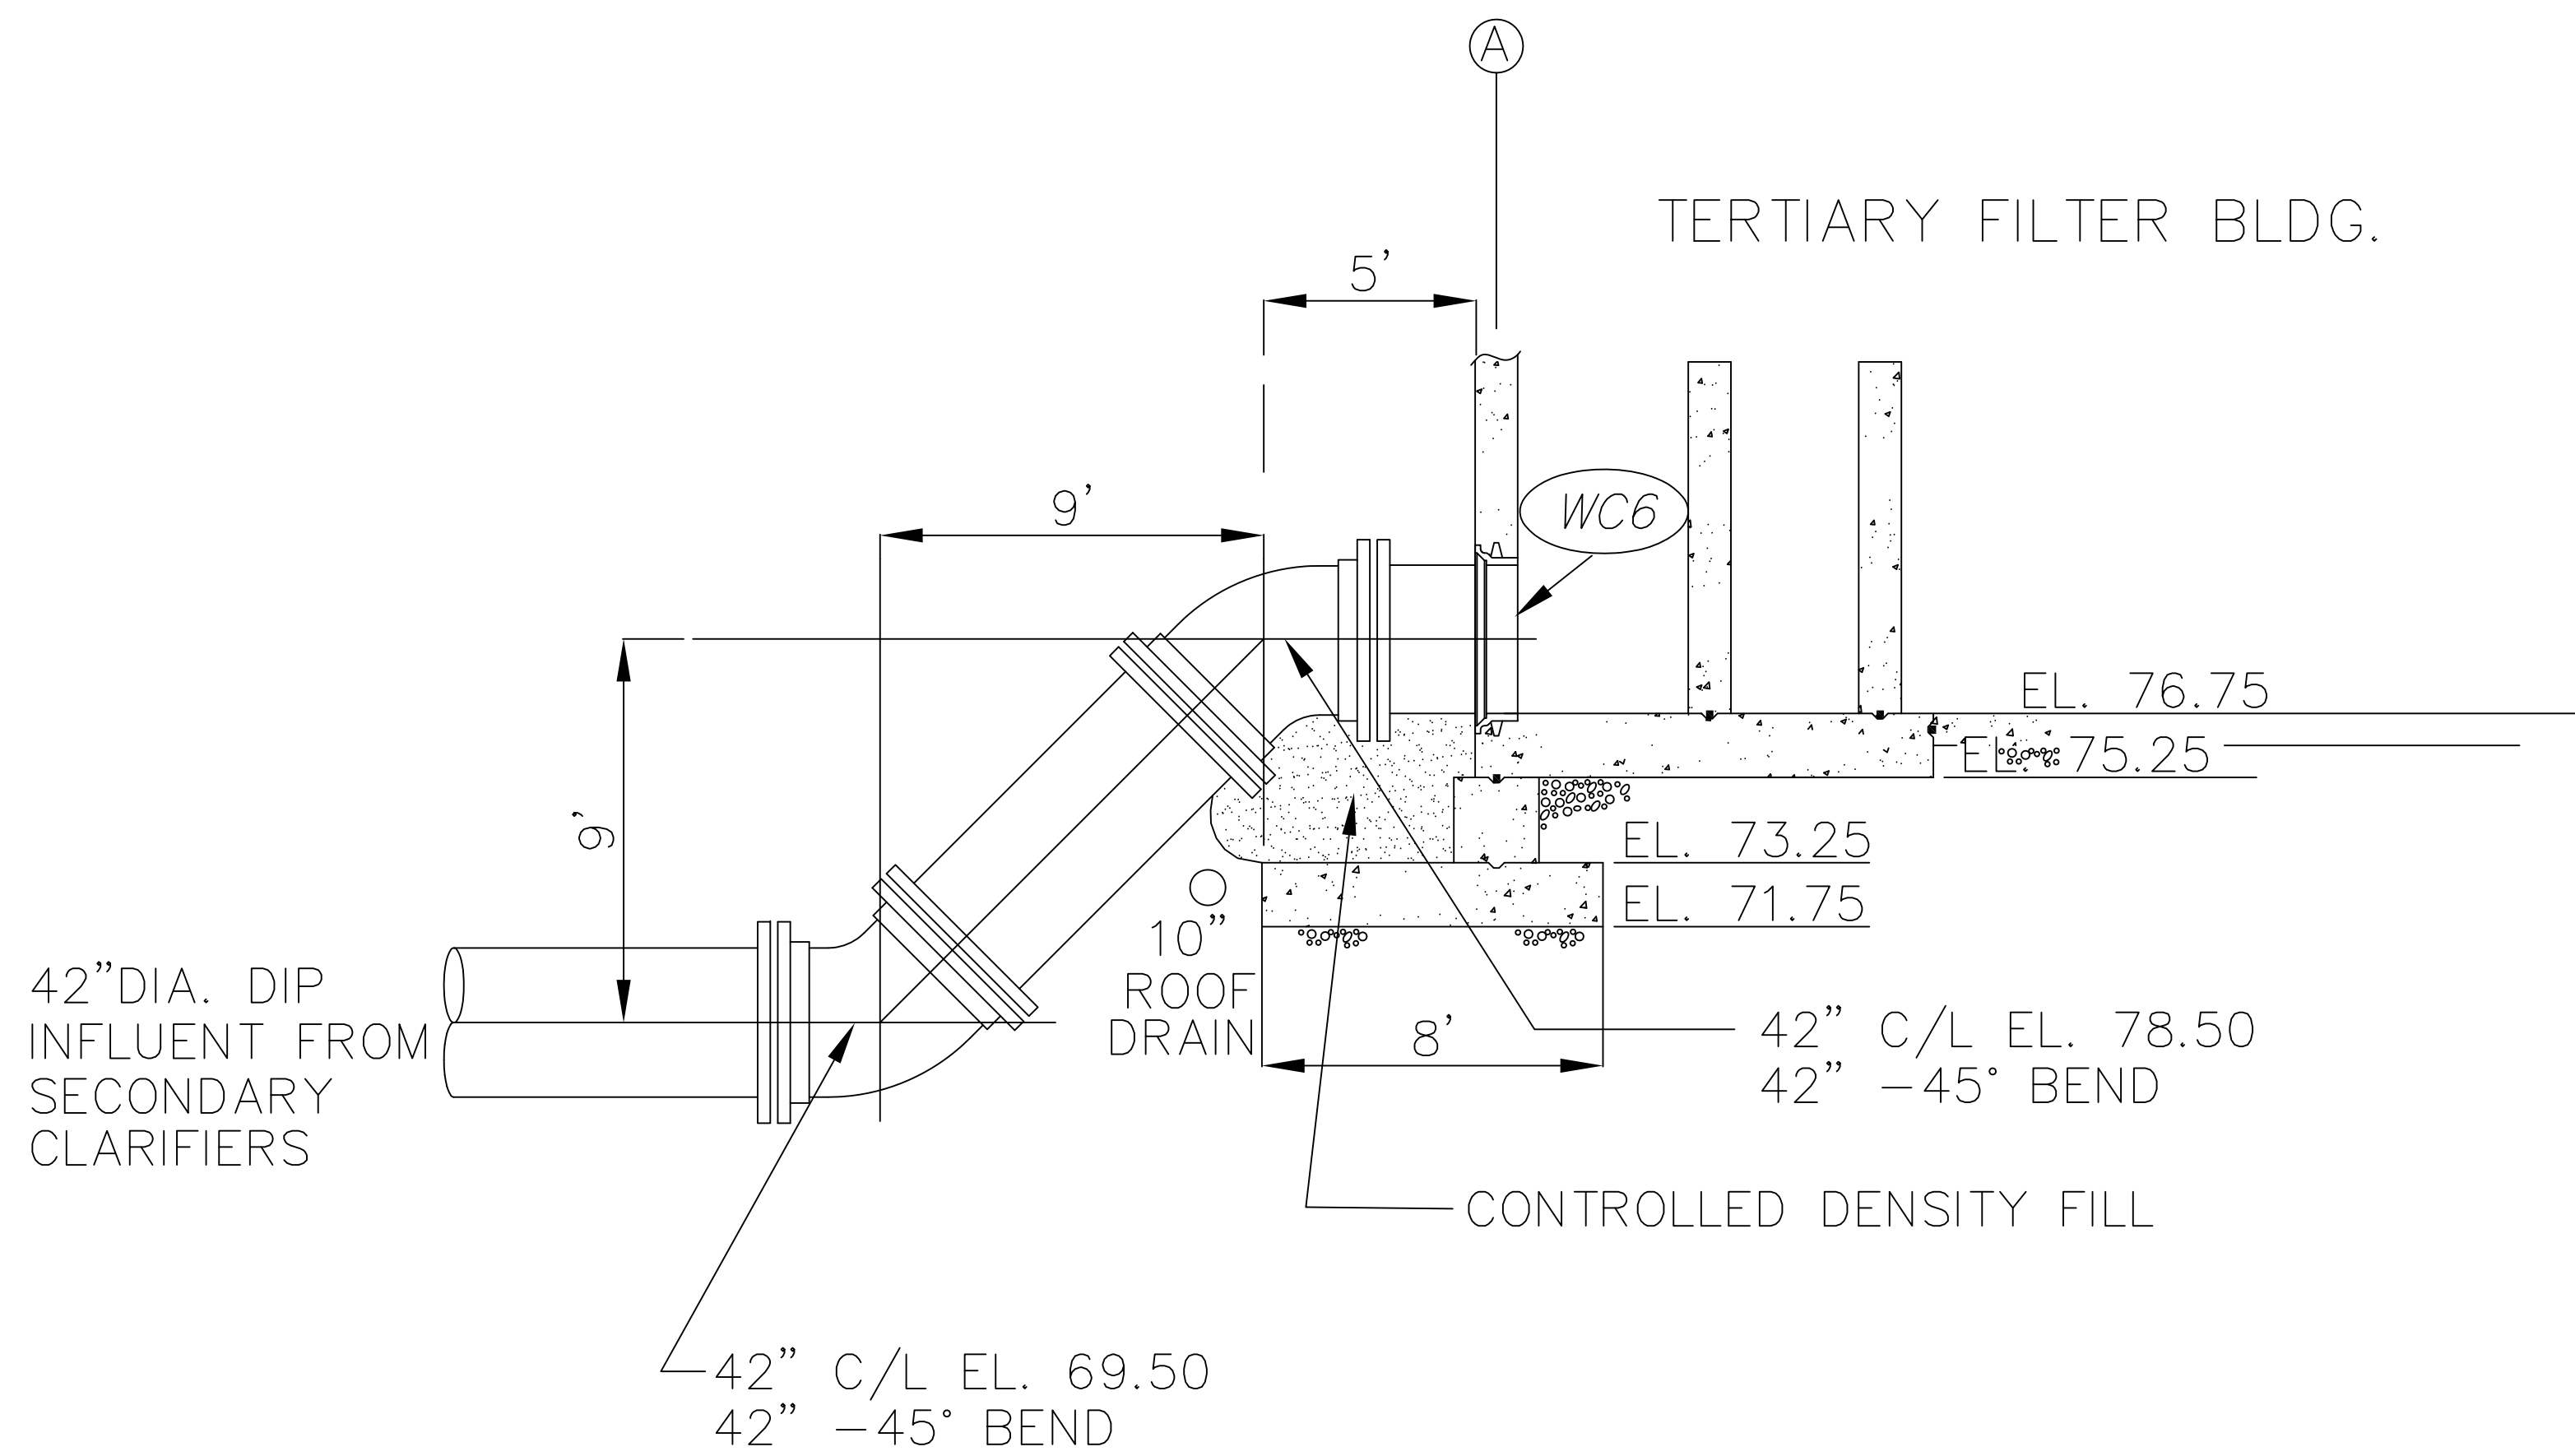

SK-P66-001