



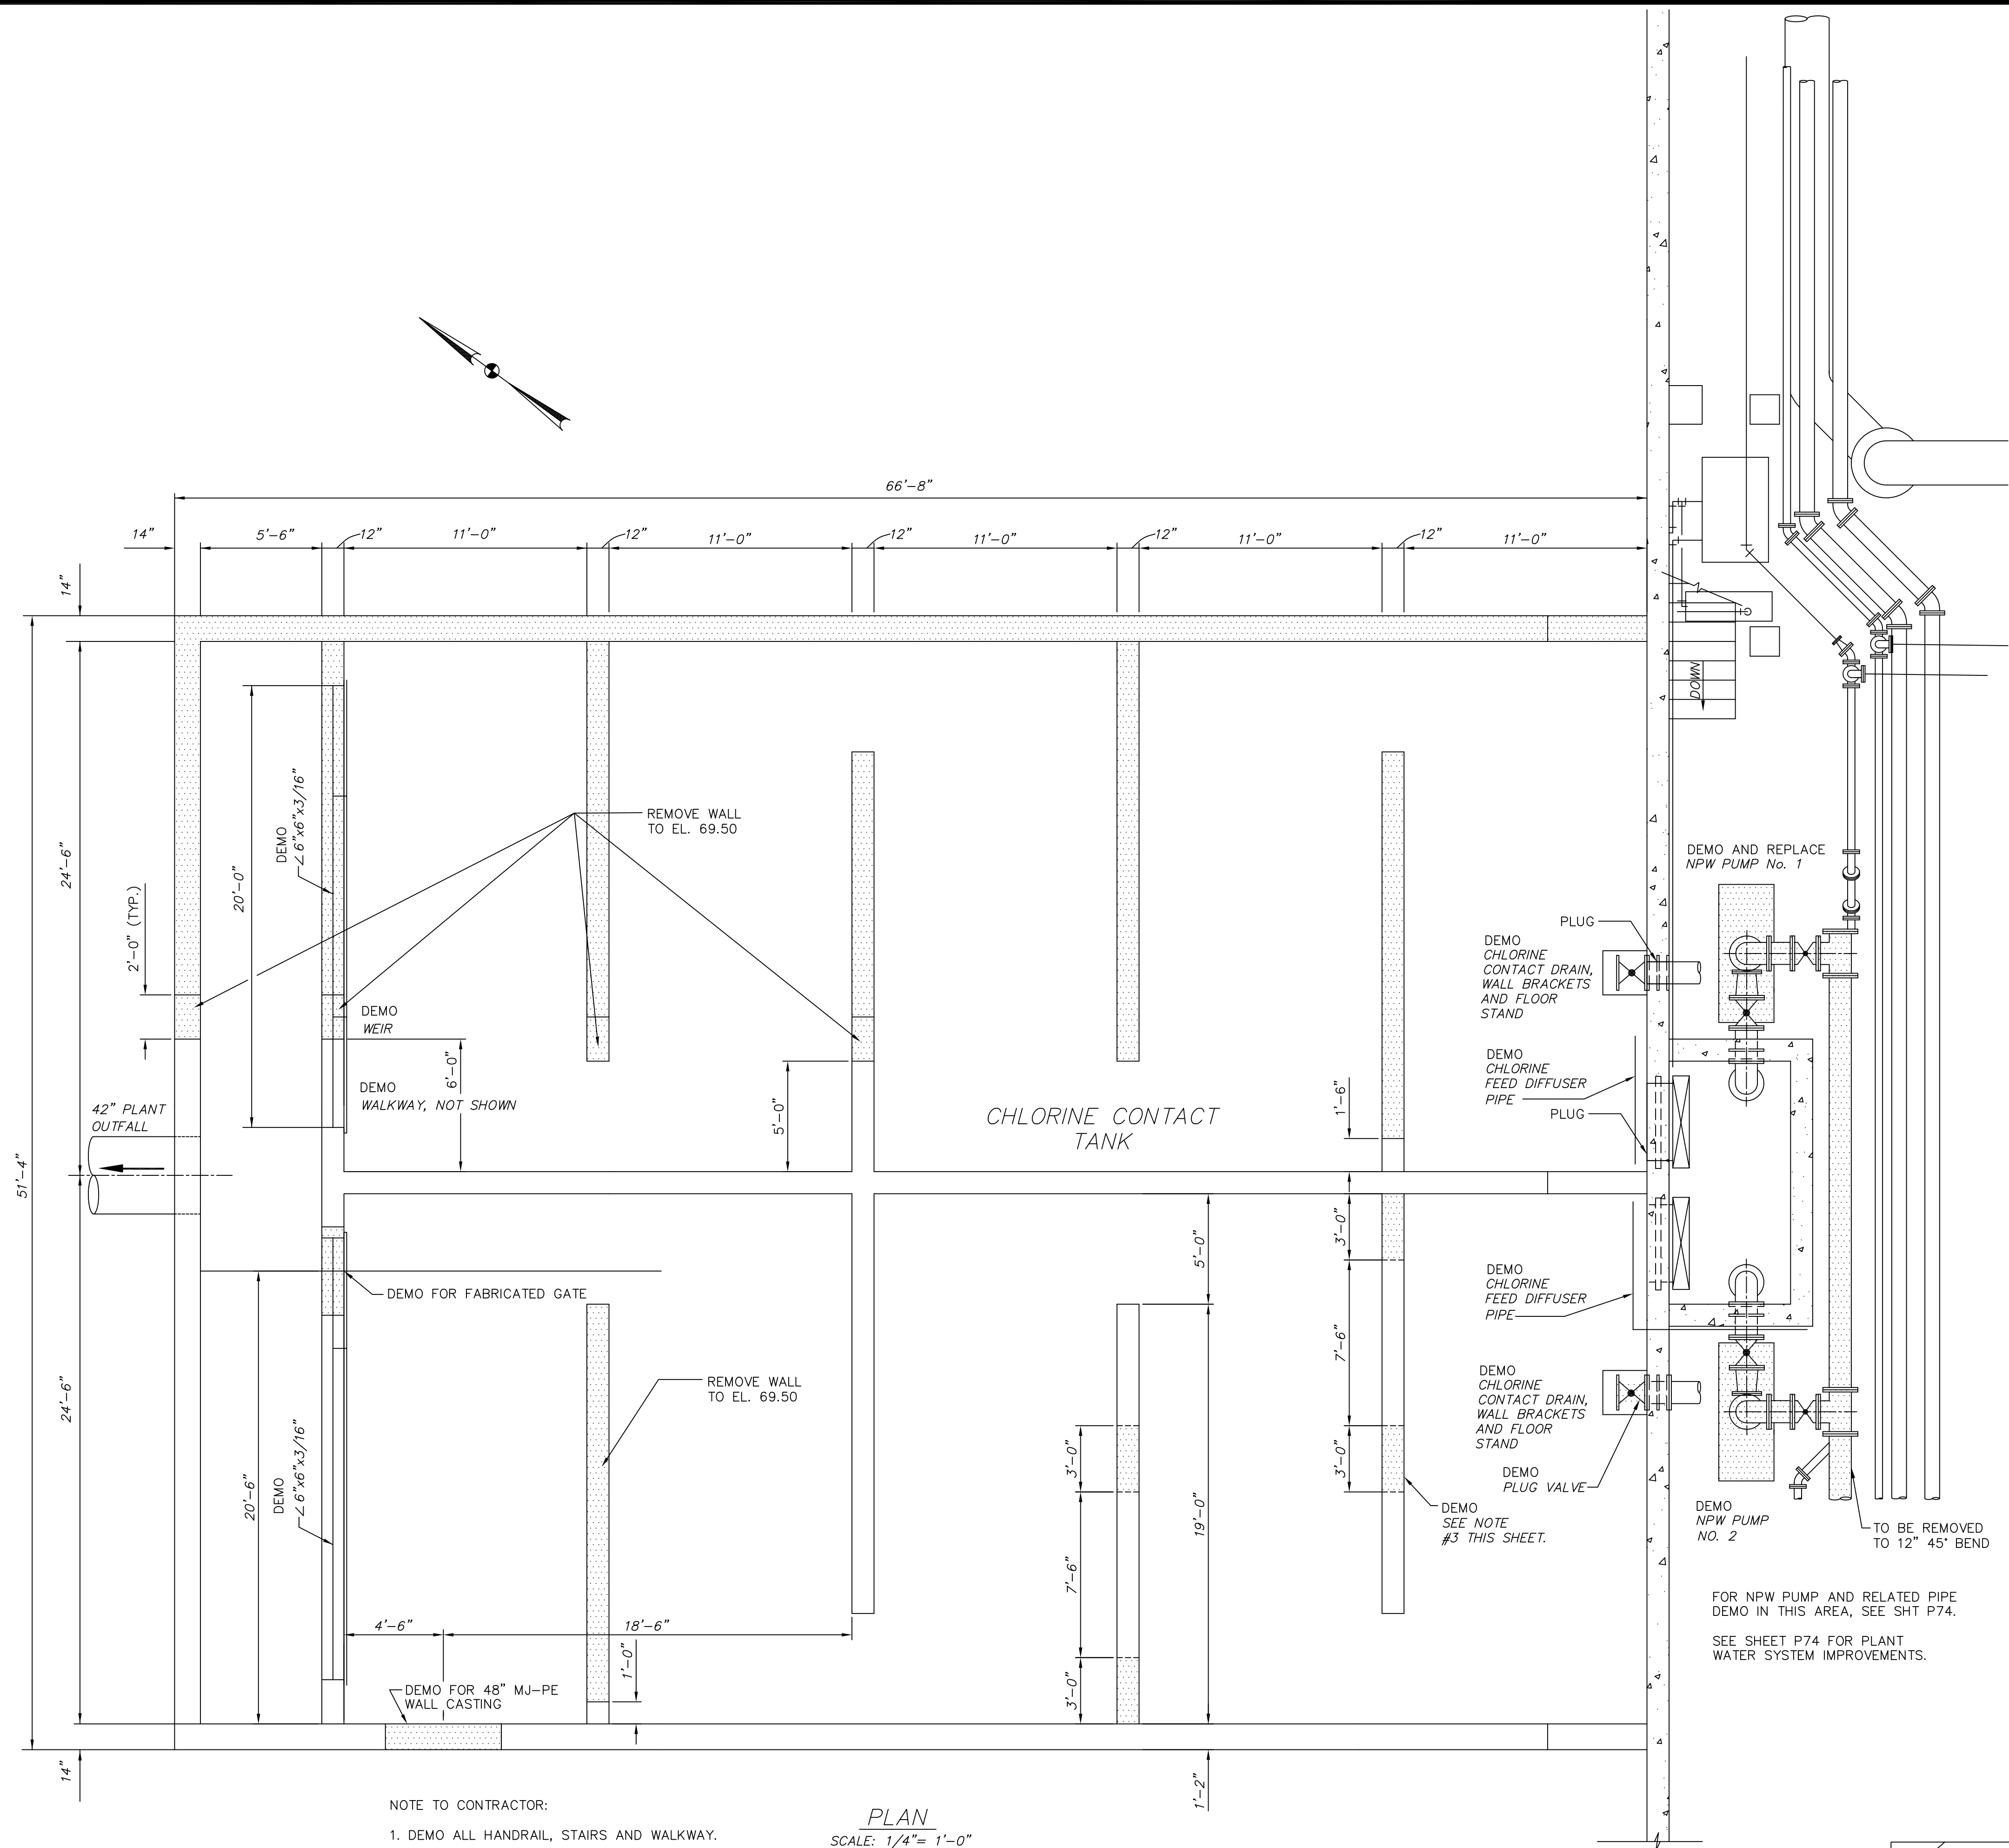

- NOTE TO CONTRACTOR:
1. DEMO ALL HANDRAIL, STAIRS AND WALKWAY.
 2. DEMO EXISTING WALLS TO 5'-0" BELOW PROPOSED GRADE, EXCEPT WHERE NOTED OTHERWISE.
 3. DEMO 3'-0" Wx1'-0"H OPENINGS AT THE BOTTOM OF EXIST Baffle WALLS, TYPICAL 4 PLCS.

PLAN
SCALE: 1/4" = 1'-0"

THESE RECORD DOCUMENTS HAVE BEEN PREPARED BASED ON INFORMATION PROVIDED BY OTHERS. CTI ENVIRONMENTAL HAS REVIEWED THE INFORMATION SUBMITTED AND BELIEVES IT REFLECTS THE WORK AS CONSTRUCTED. HOWEVER, ALL PERSONS SHALL VERIFY INFORMATION TAKEN FROM THIS DRAWING.

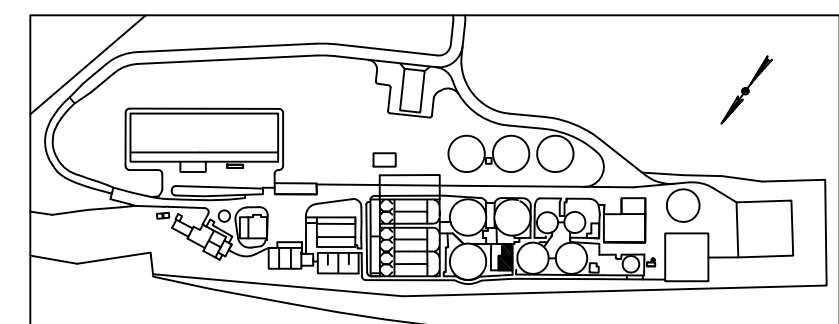

KEY PLAN

THIS DRAWING IS AN INSTRUMENT OF SERVICE OWNED BY CTI ENVIRONMENTAL, INC. WHICH SHALL BE DEEMED THE AUTHOR AND WHICH SHALL REMAIN THE PROPERTY OF CTI ENVIRONMENTAL, INC. THIS DRAWING SHALL NOT BE LOANED, REPRODUCED, COPIED, OR IN ANY MANNER USED FOR ANY OTHER PURPOSE OR PROJECT WITHOUT THE WRITTEN CONSENT OF CTI ENVIRONMENTAL, INC. THAT ELECTRONIC COPIES OF THIS DRAWING ARE EXACT DUPLICATES OF THE SEALED ORIGINAL DRAWING. ANY REVISIONS TO THIS DRAWING SHALL BE MADE BY A SEPARATE SHEET OF THE SEALED ORIGINAL. THE SEALED ORIGINAL SHALL GOVERN.

REVISIONS			
NO.	DESCRIPTIONS	DATE	BY
1	RECORD DRAWING	3/11	MGW
			WAD

DESIGNED BY
MGW

DRAWN BY
AJP / SAT

CHECKED BY
MGW

APPROVED BY
WAD

ENVIRONMENTAL, INC.
ENGINEERS IN WATER AND EARTH SCIENCES
UNIONTOWN, OHIO

CITY OF MASSILLON, OHIO
WWTP UPGRADE 2000
CHLORINE CONTACT TANK - DEMOLITION

JOB NO. E9031
DATE 08/13/01
SCALE AS NOTED
SHEET P70