


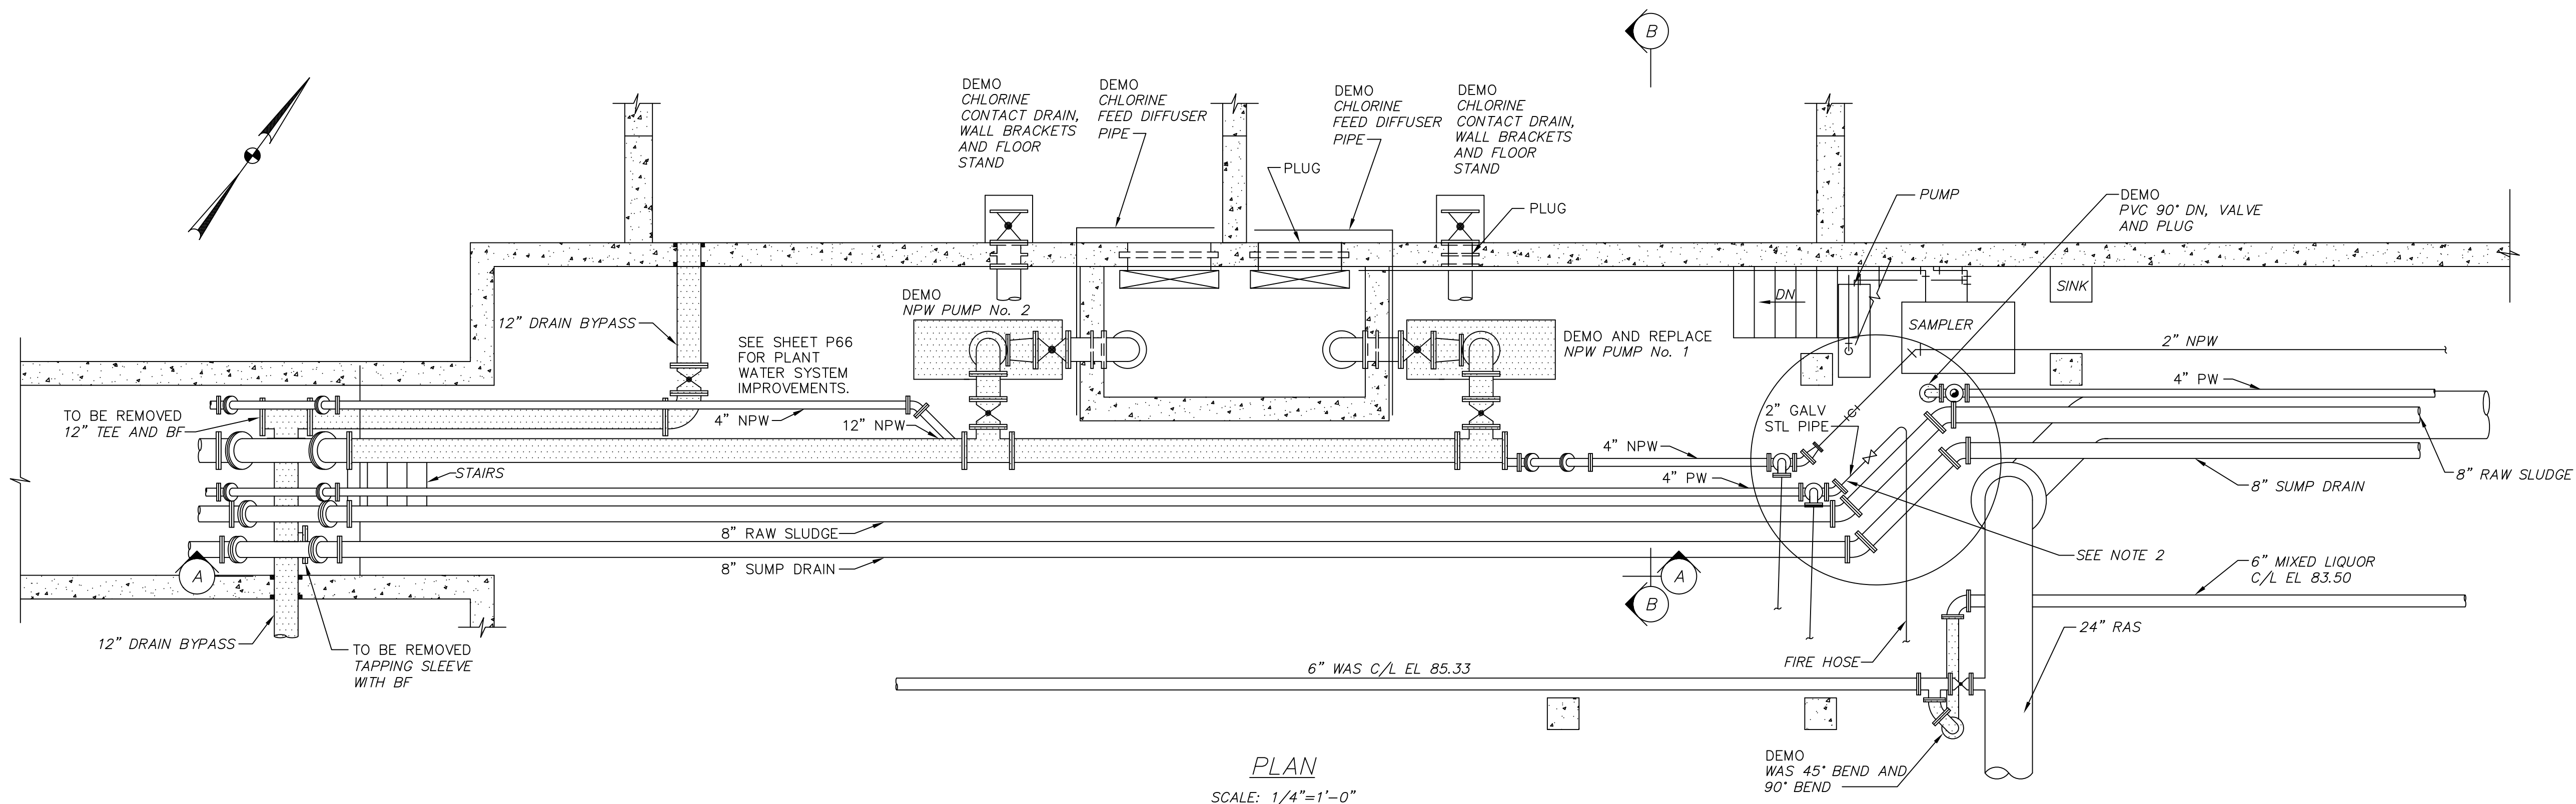


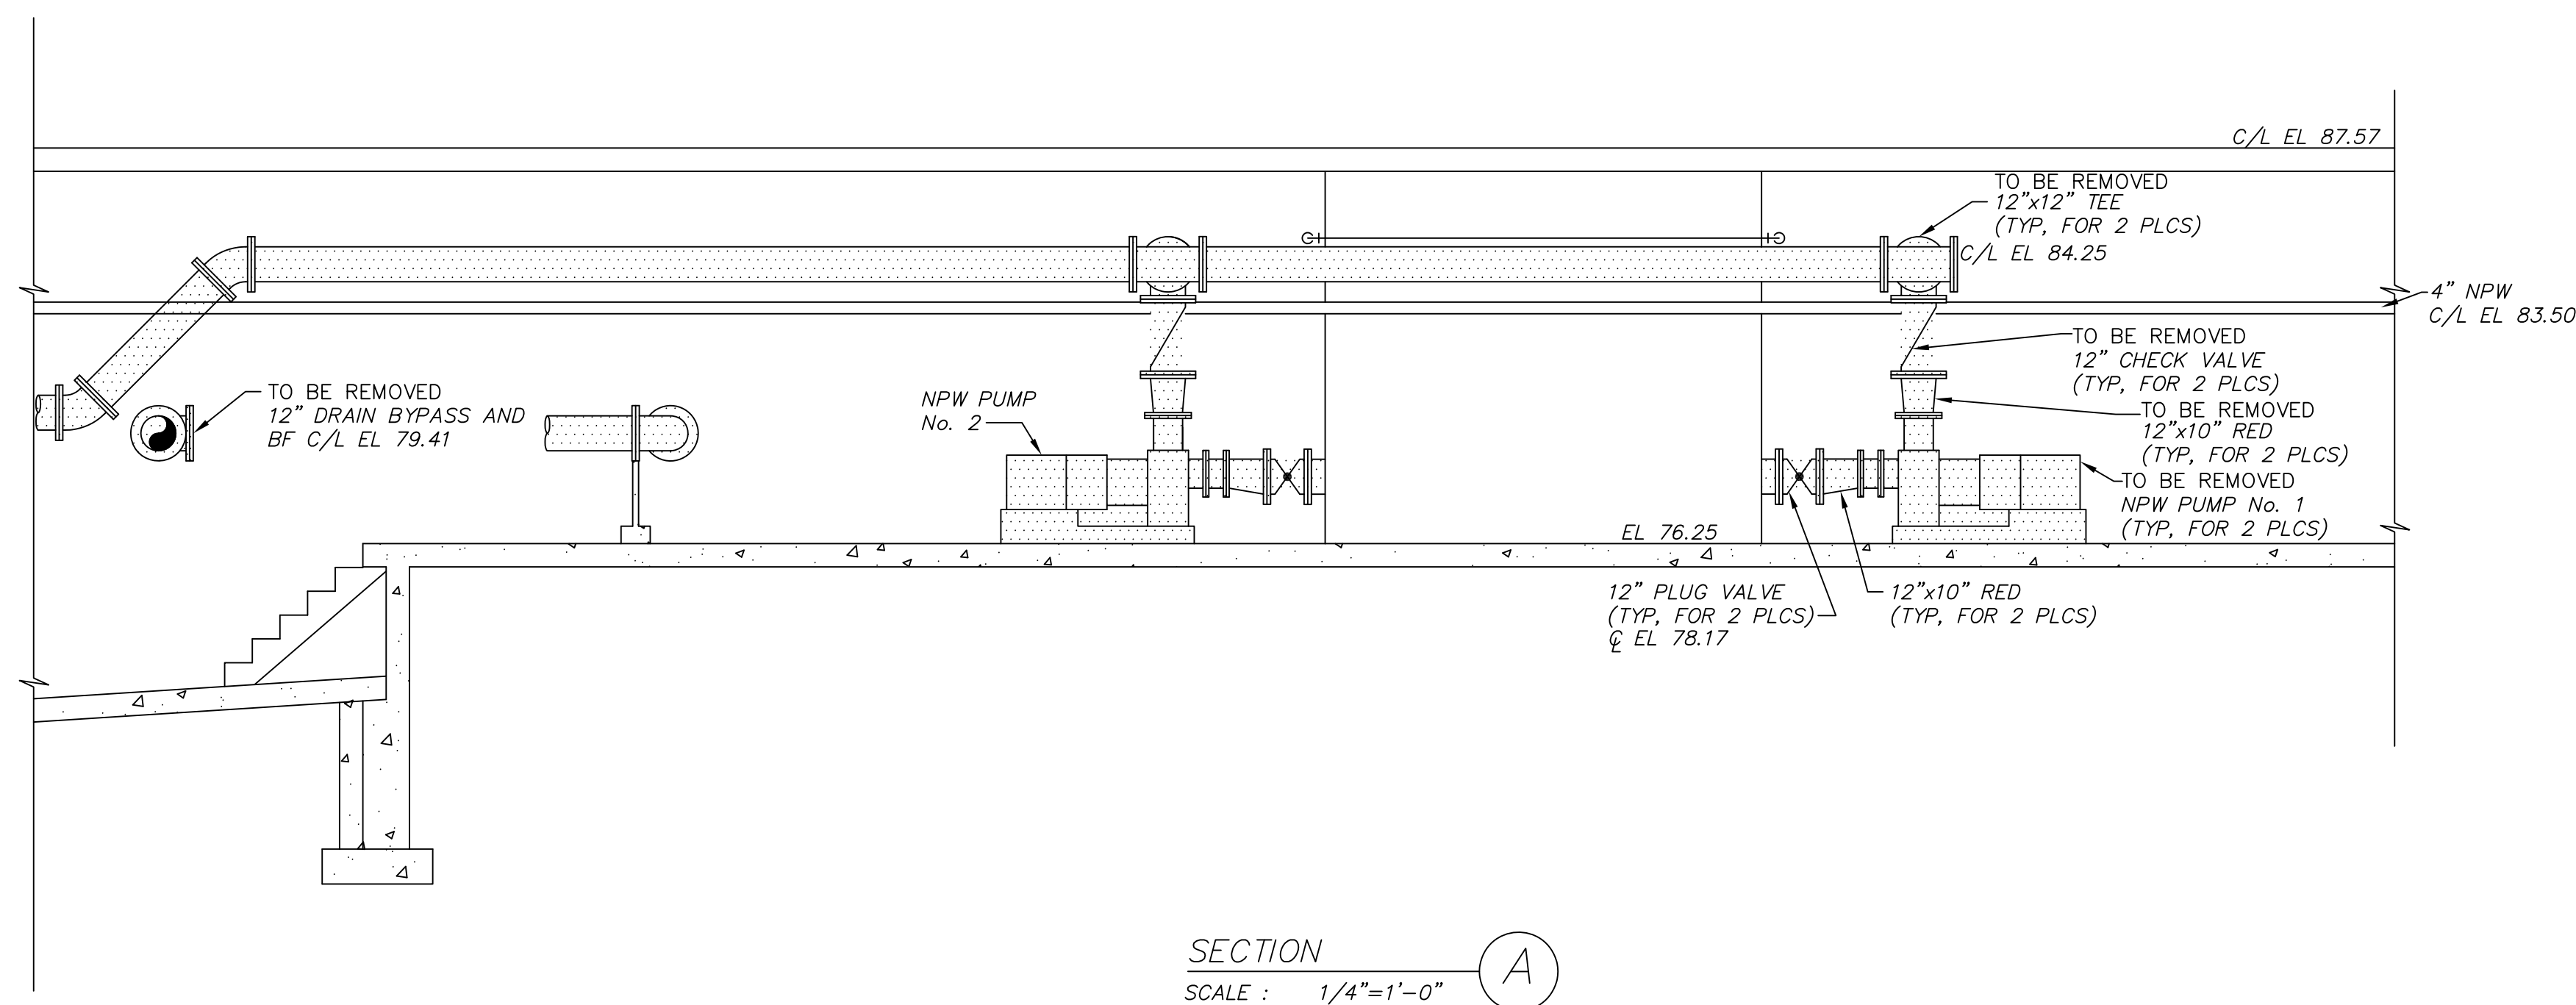

- NOTES:**
- CONTRACTOR SHALL DEMO 1" SEAL WATER FOR RAS PUMPS (TYP FOR 3) CONNECTED TO EXIST 4" PW.
 - CONTRACTOR SHALL DISCONNECT GALV STL PIPE AND FIREHOSE CONNECTED TO THE 4" PW AND RECONNECT TO THE 4" NPW.

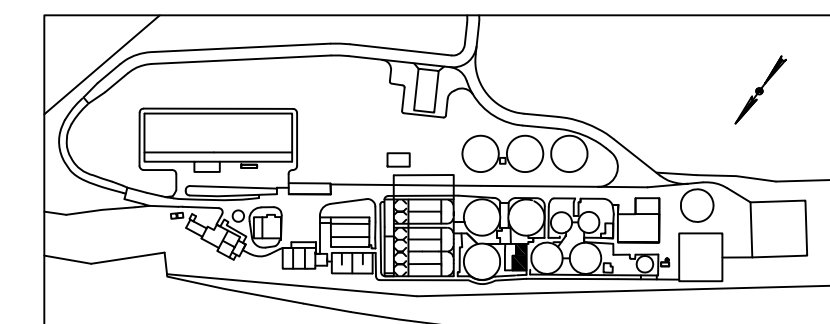

NOTE:
1. DRAIN BYPASS AND NPW PIPING ONLY SHOWN FOR CLARITY.

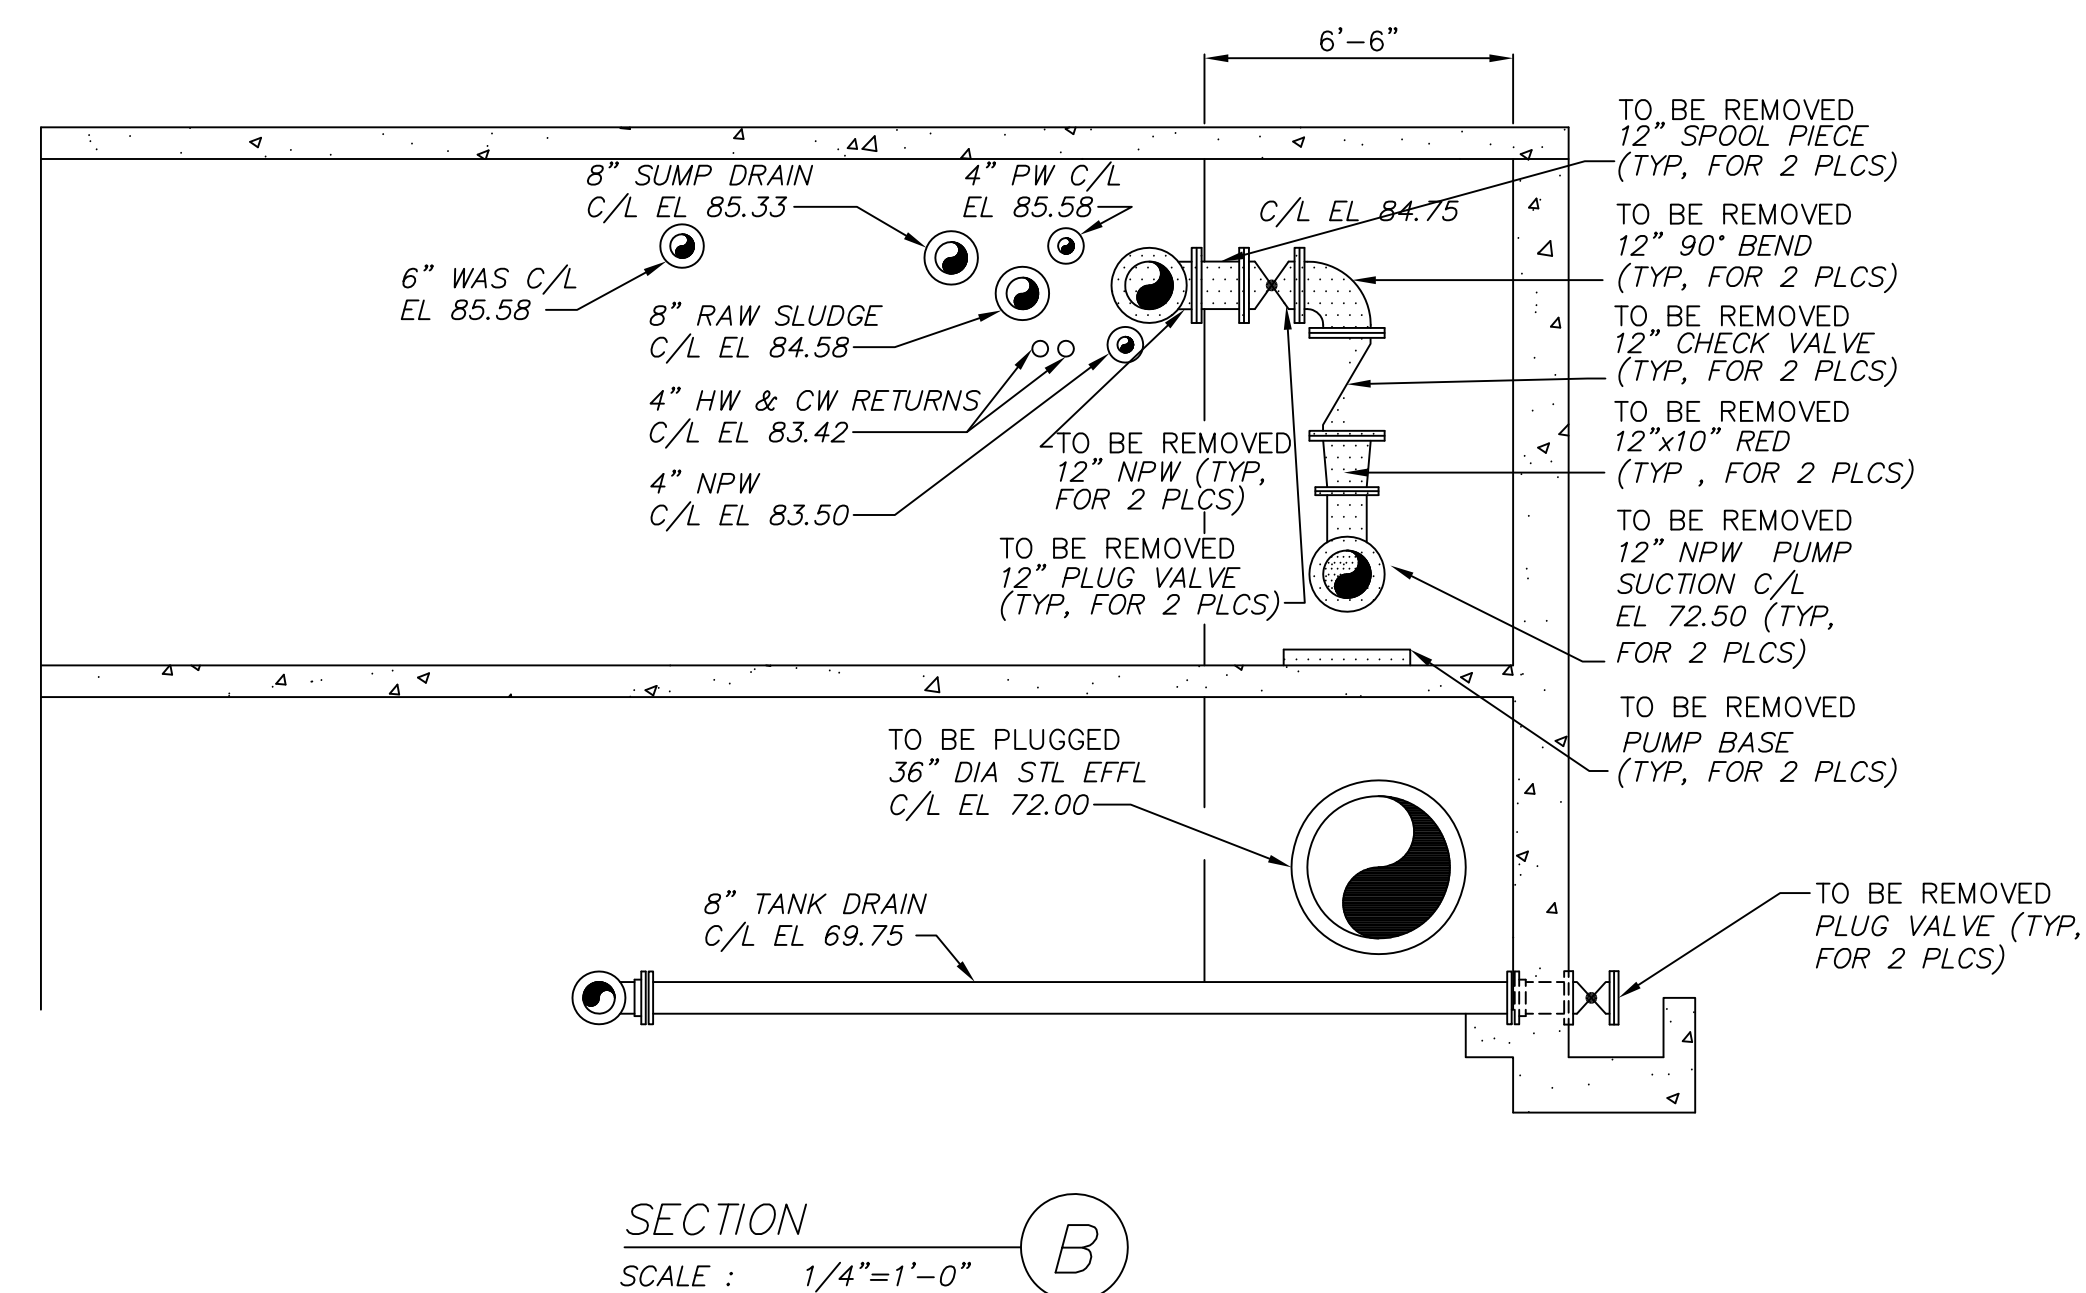

THESE RECORD DOCUMENTS HAVE BEEN PREPARED BASED ON INFORMATION PROVIDED BY OTHERS. CTI ENVIRONMENTAL HAS REVIEWED THE INFORMATION SUBMITTED AND BELIEVES IT REFLECTS THE WORK AS CONSTRUCTED. HOWEVER, ALL PERSONS SHALL VERIFY INFORMATION TAKEN FROM THIS DRAWING.

THIS DRAWING IS AN INSTRUMENT OF SERVICE OWNED BY CTI ENVIRONMENTAL, INC. WHICH SHALL BE DEEMED THE AUTHOR AND WHICH SHALL RETAIN ALL STATUTORY RIGHTS. IT IS TO BE USED ONLY FOR THE PROJECT AND SITE SPECIFICALLY IDENTIFIED HEREON. IT IS NOT TO BE REPRODUCED, COPIED, OR ANY OTHER PURPOSE OR PROJECT WITHOUT PRIOR WRITTEN CONSENT OF CTI ENVIRONMENTAL, INC. THAT ELECTRONIC COPIES OF THIS DRAWING ARE EXACT DUPLICATES OF THE SEALED ORIGINAL DRAWING. ANY REVISIONS TO THIS DRAWING SHALL BE MADE BY A SIGNED AND SEALED CORRECTION SHEET. THE SEALED ORIGINAL SHALL GOVERN.

DESIGNED BY		REVISIONS			APP'D	
MGW		NO.	DESCRIPTIONS	DATE	BY	WAD
DRAWN BY		1	RECORD DRAWING	3/23	MGW	
AJP/SAT						
CHECKED BY						
MGW						
APPROVED BY						
WAD						

DESIGNED BY: MGW
DRAWN BY: AJP / SAT
CHECKED BY: MGW
APPROVED BY: WAD

CTI
ENVIRONMENTAL, INC.
ENGINEERS IN WATER AND EARTH SCIENCES
UNIONTOWN, OHIO

CITY OF MASSILLON, OHIO
WWTP UPGRADE 2000
PLANT WATER SYSTEM - DEMOLITION

JOB NO. E9031
DATE 08/13/01
SCALE AS NOTED
SHEET P73