

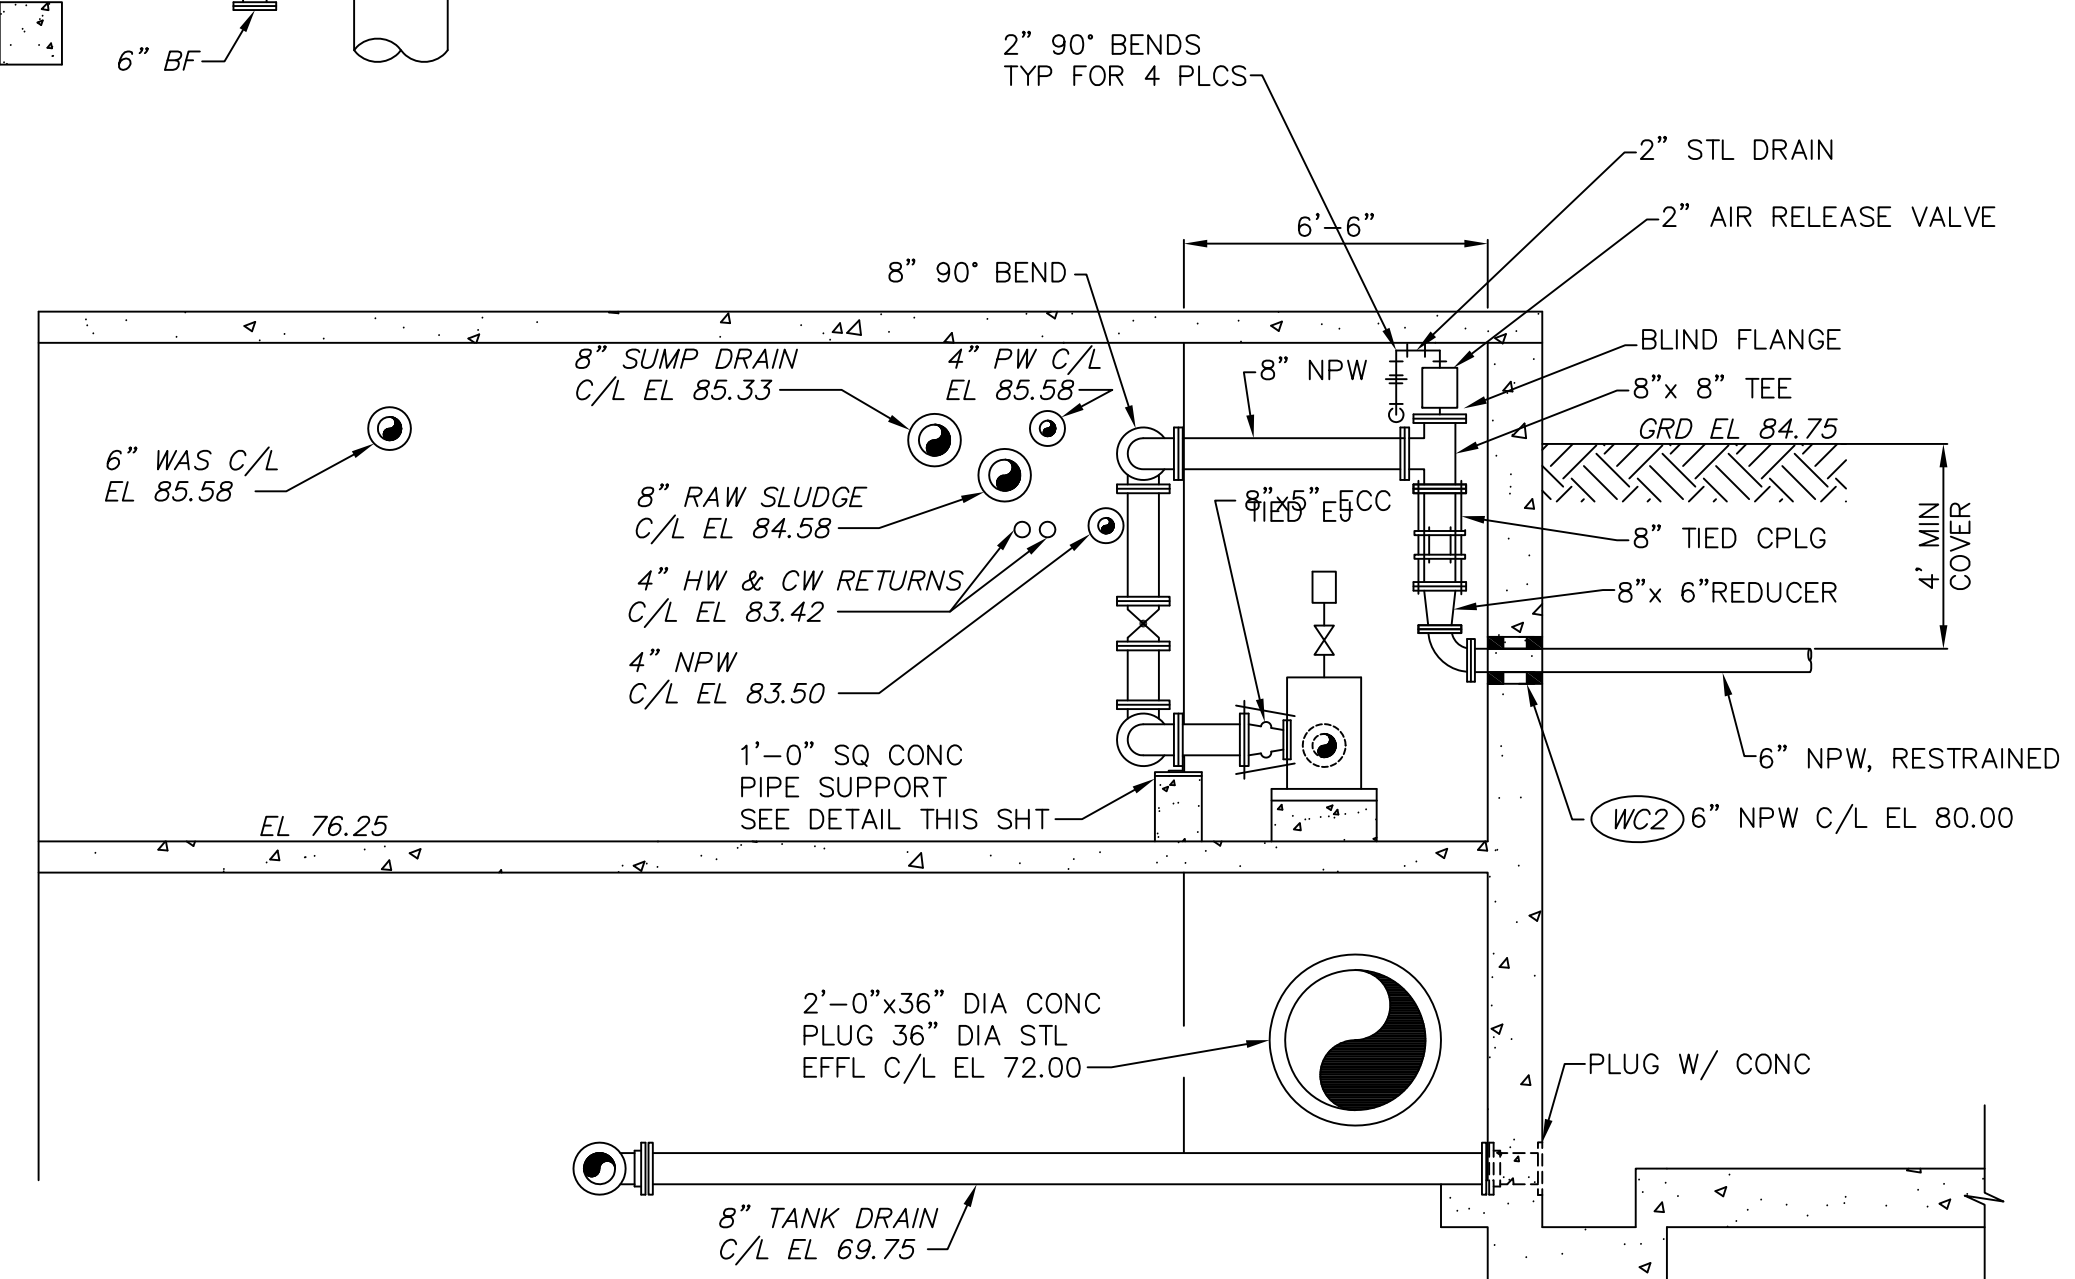
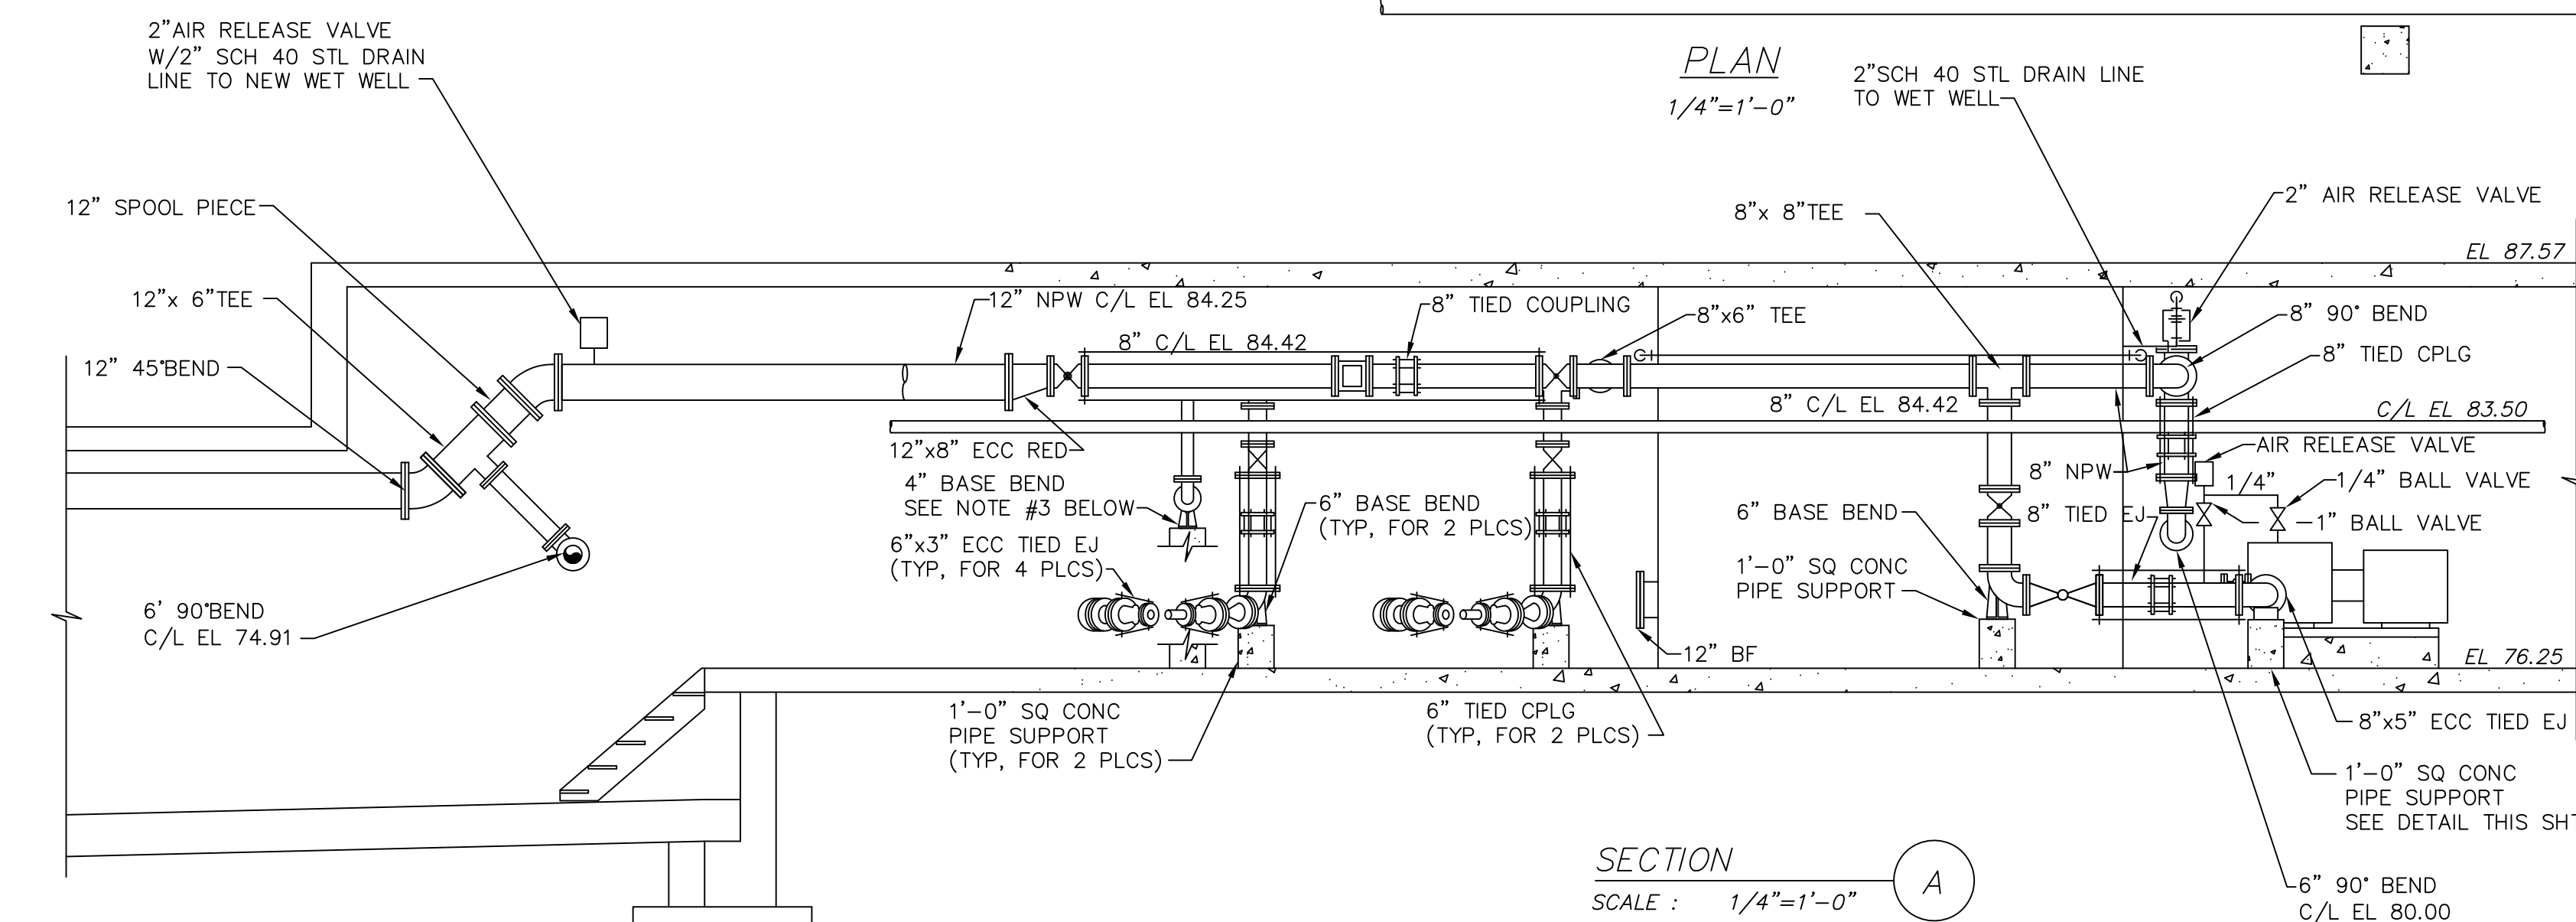
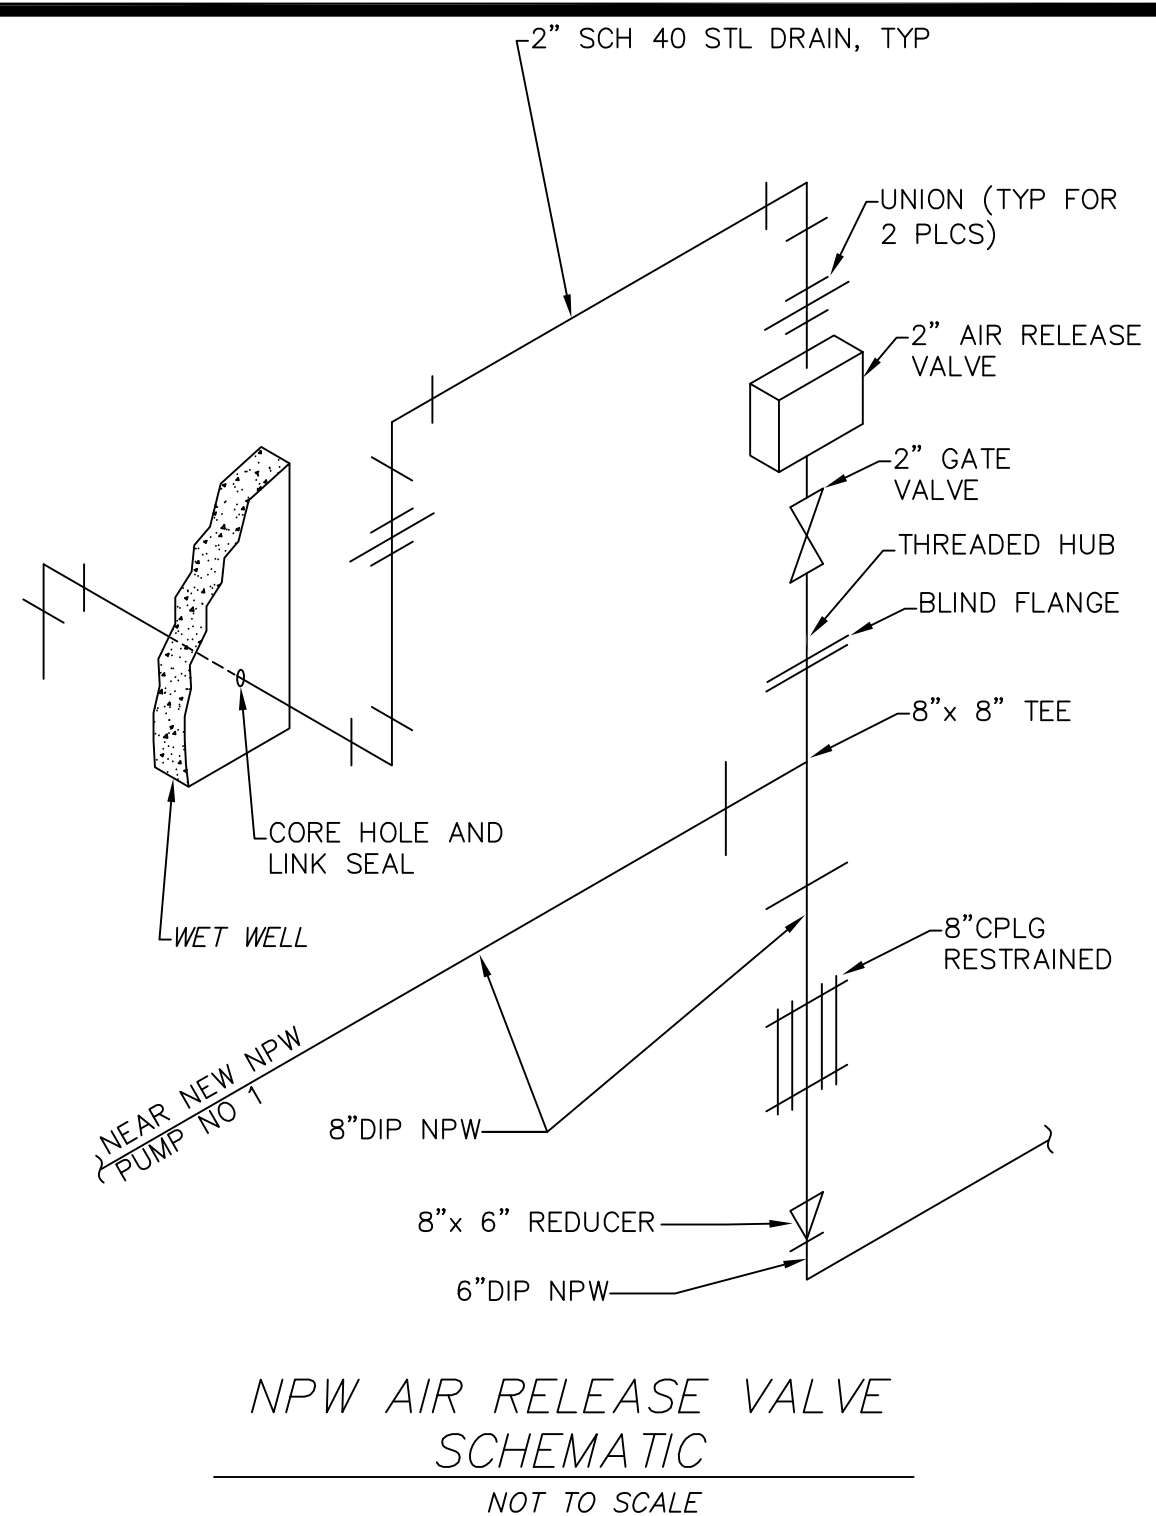


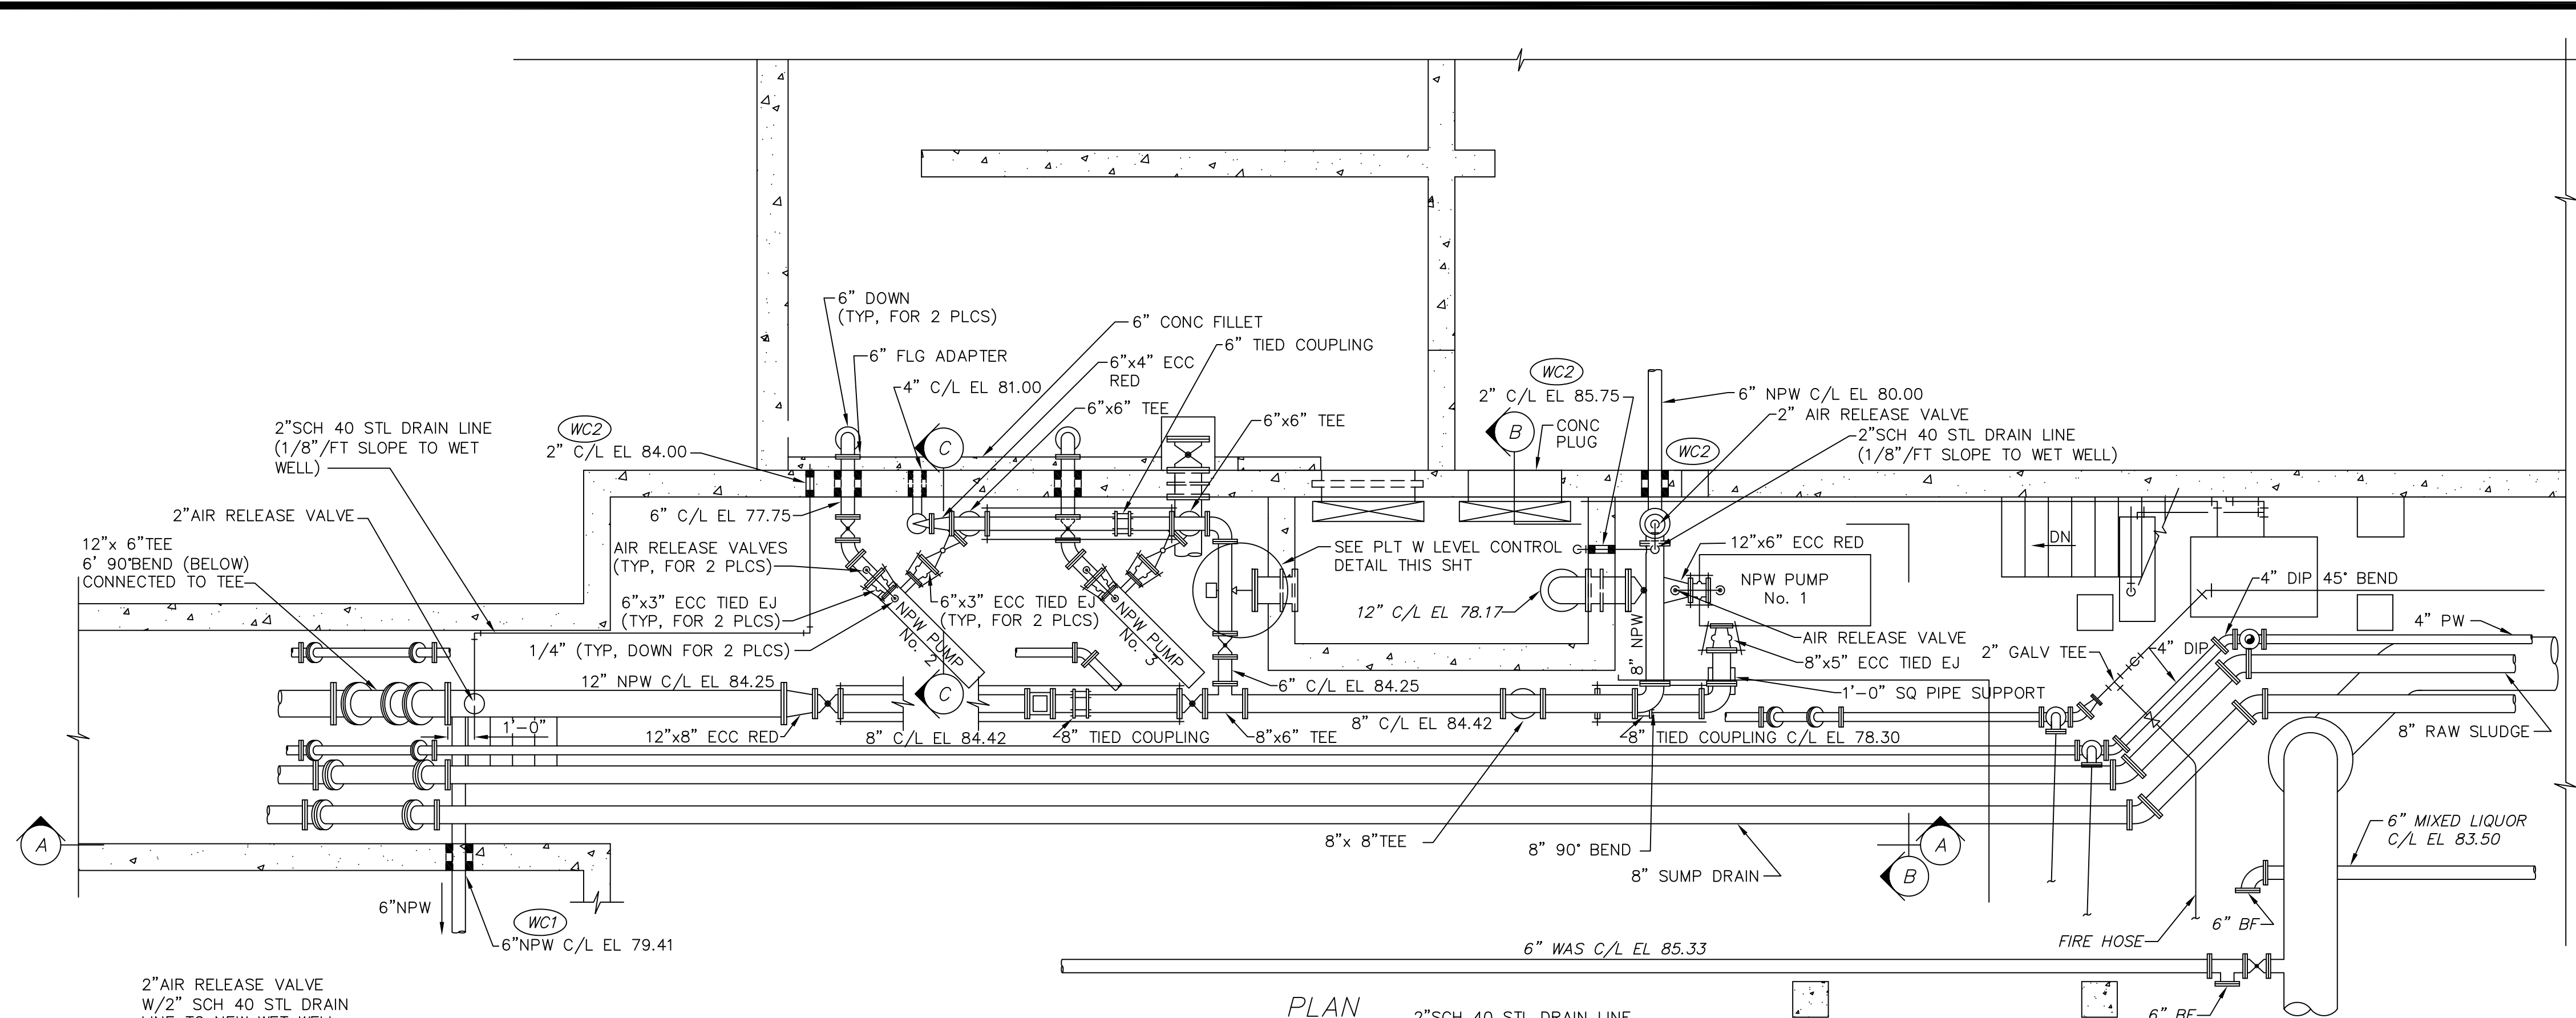


- NOTES:
1. AIR RELEASE VALVES AND PIPING NOT SHOWN AT NPW PUMP Nos. 2 AND 3 FOR CLARITY.
 2. NPW PUMP No. 2 AND 3 ARE NOT SHOWN FOR CLARITY.
 3. CONTRACTOR SHALL PROVIDE 1'-0\"/>

GENERAL NOTES:


1. CONTRACTOR SHALL PROVIDE 1\"/>
2. THE EXIST 4\"/>
3. PRIOR TO ACCEPTANCE, THESE POTABLE WATER PIPING SHALL BE TESTED ACCORDING TO AWWA C-600, AND DISINFECTED ACCORDING TO AWWA C-651 LATEST EDITION.

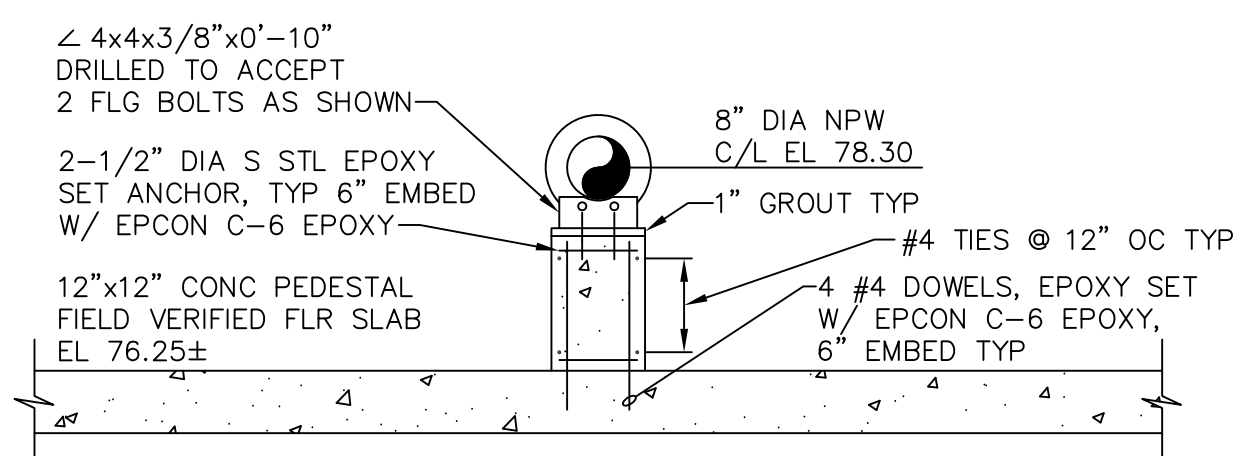


FLG PIPE SUPPORT DETAIL
SCALE: 1/2\"/>

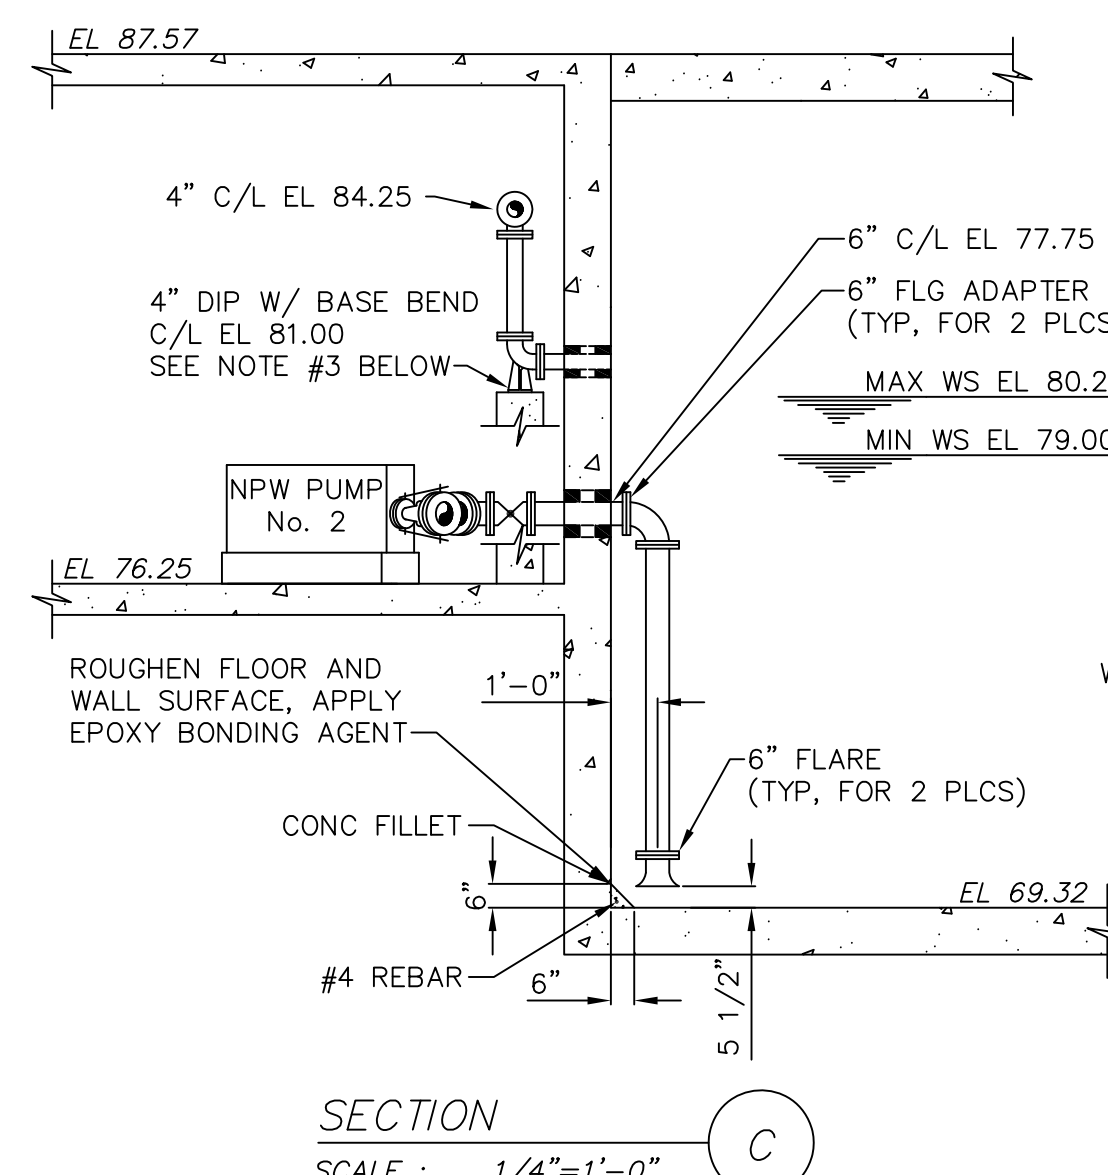

SECTION C
SCALE: 1/4\"/>

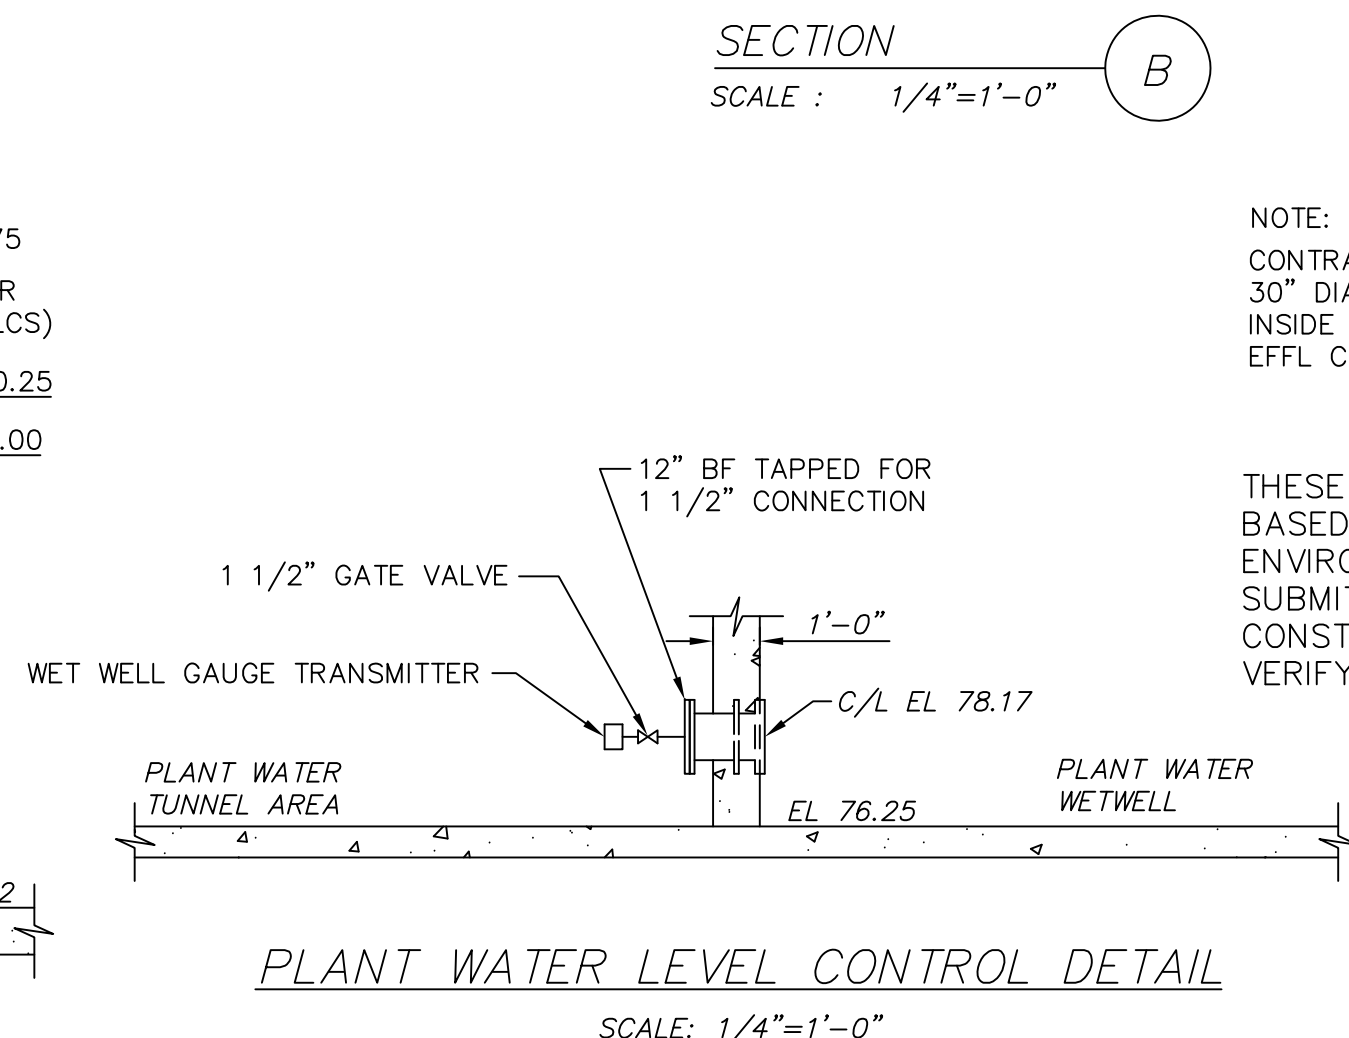

PLANT WATER LEVEL CONTROL DETAIL
SCALE: 1/4\"/>

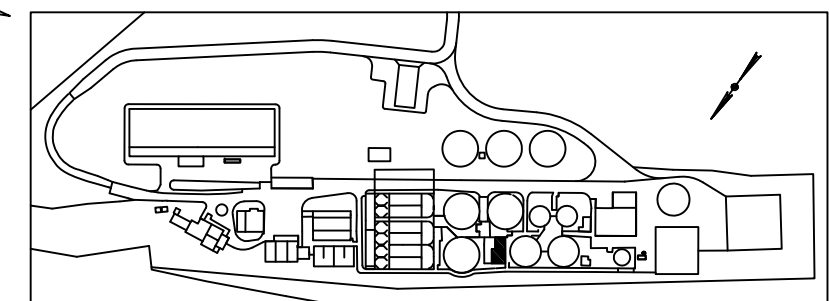

KEY PLAN

THIS DRAWING IS AN INSTRUMENT OF SERVICE OWNED BY CTI ENVIRONMENTAL, INC. AND SHALL REMAIN THE PROPERTY OF CTI ENVIRONMENTAL, INC. IT IS TO BE USED ONLY FOR THE PROJECT AND SITE SPECIFICALLY IDENTIFIED HEREON. IT IS NOT TO BE REPRODUCED, COPIED, OR DISTRIBUTED TO OTHERS IN ANY FORM OR BY ANY MEANS, ELECTRONIC OR MECHANICAL, INCLUDING PHOTOCOPYING, RECORDING, OR BY ANY INFORMATION STORAGE AND RETRIEVAL SYSTEM, WITHOUT THE WRITTEN CONSENT OF CTI ENVIRONMENTAL, INC. CTI ENVIRONMENTAL, INC. MAKES NO WARRANTY, GUARANTEE, OR REPRESENTATION, EXPRESS OR IMPLIED, THAT THIS DRAWING IS ACCURATE OR COMPLETE. IT IS THE USER'S RESPONSIBILITY TO VERIFY THE ACCURACY OF THE DATA AND INFORMATION PROVIDED HEREON. THE USER SHALL BE RESPONSIBLE FOR OBTAINING ALL NECESSARY PERMITS AND APPROVALS FROM THE APPROPRIATE AGENCIES. THE USER SHALL BE RESPONSIBLE FOR OBTAINING ALL NECESSARY PERMITS AND APPROVALS FROM THE APPROPRIATE AGENCIES. THE USER SHALL BE RESPONSIBLE FOR OBTAINING ALL NECESSARY PERMITS AND APPROVALS FROM THE APPROPRIATE AGENCIES.

NO.	REVISIONS	DESCRIPTIONS	DATE	BY	APP'D
1	RECORD DRAWING		1/27	MGW	WAD

DESIGNED BY: MGW
DRAWN BY: AJP / SAT
CHECKED BY: MGW
APPROVED BY: WAD

ENVIRONMENTAL, INC.
ENGINEERS IN WATER AND EARTH SCIENCES
UNIONTOWN, OHIO

CITY OF MASSILLON, OHIO
WWTP UPGRADE 2000
PLANT WATER SYSTEM MODIFICATION

JOB NO.
E9031
DATE
4/5/04
SCALE
AS NOTED
SHEET
P74