

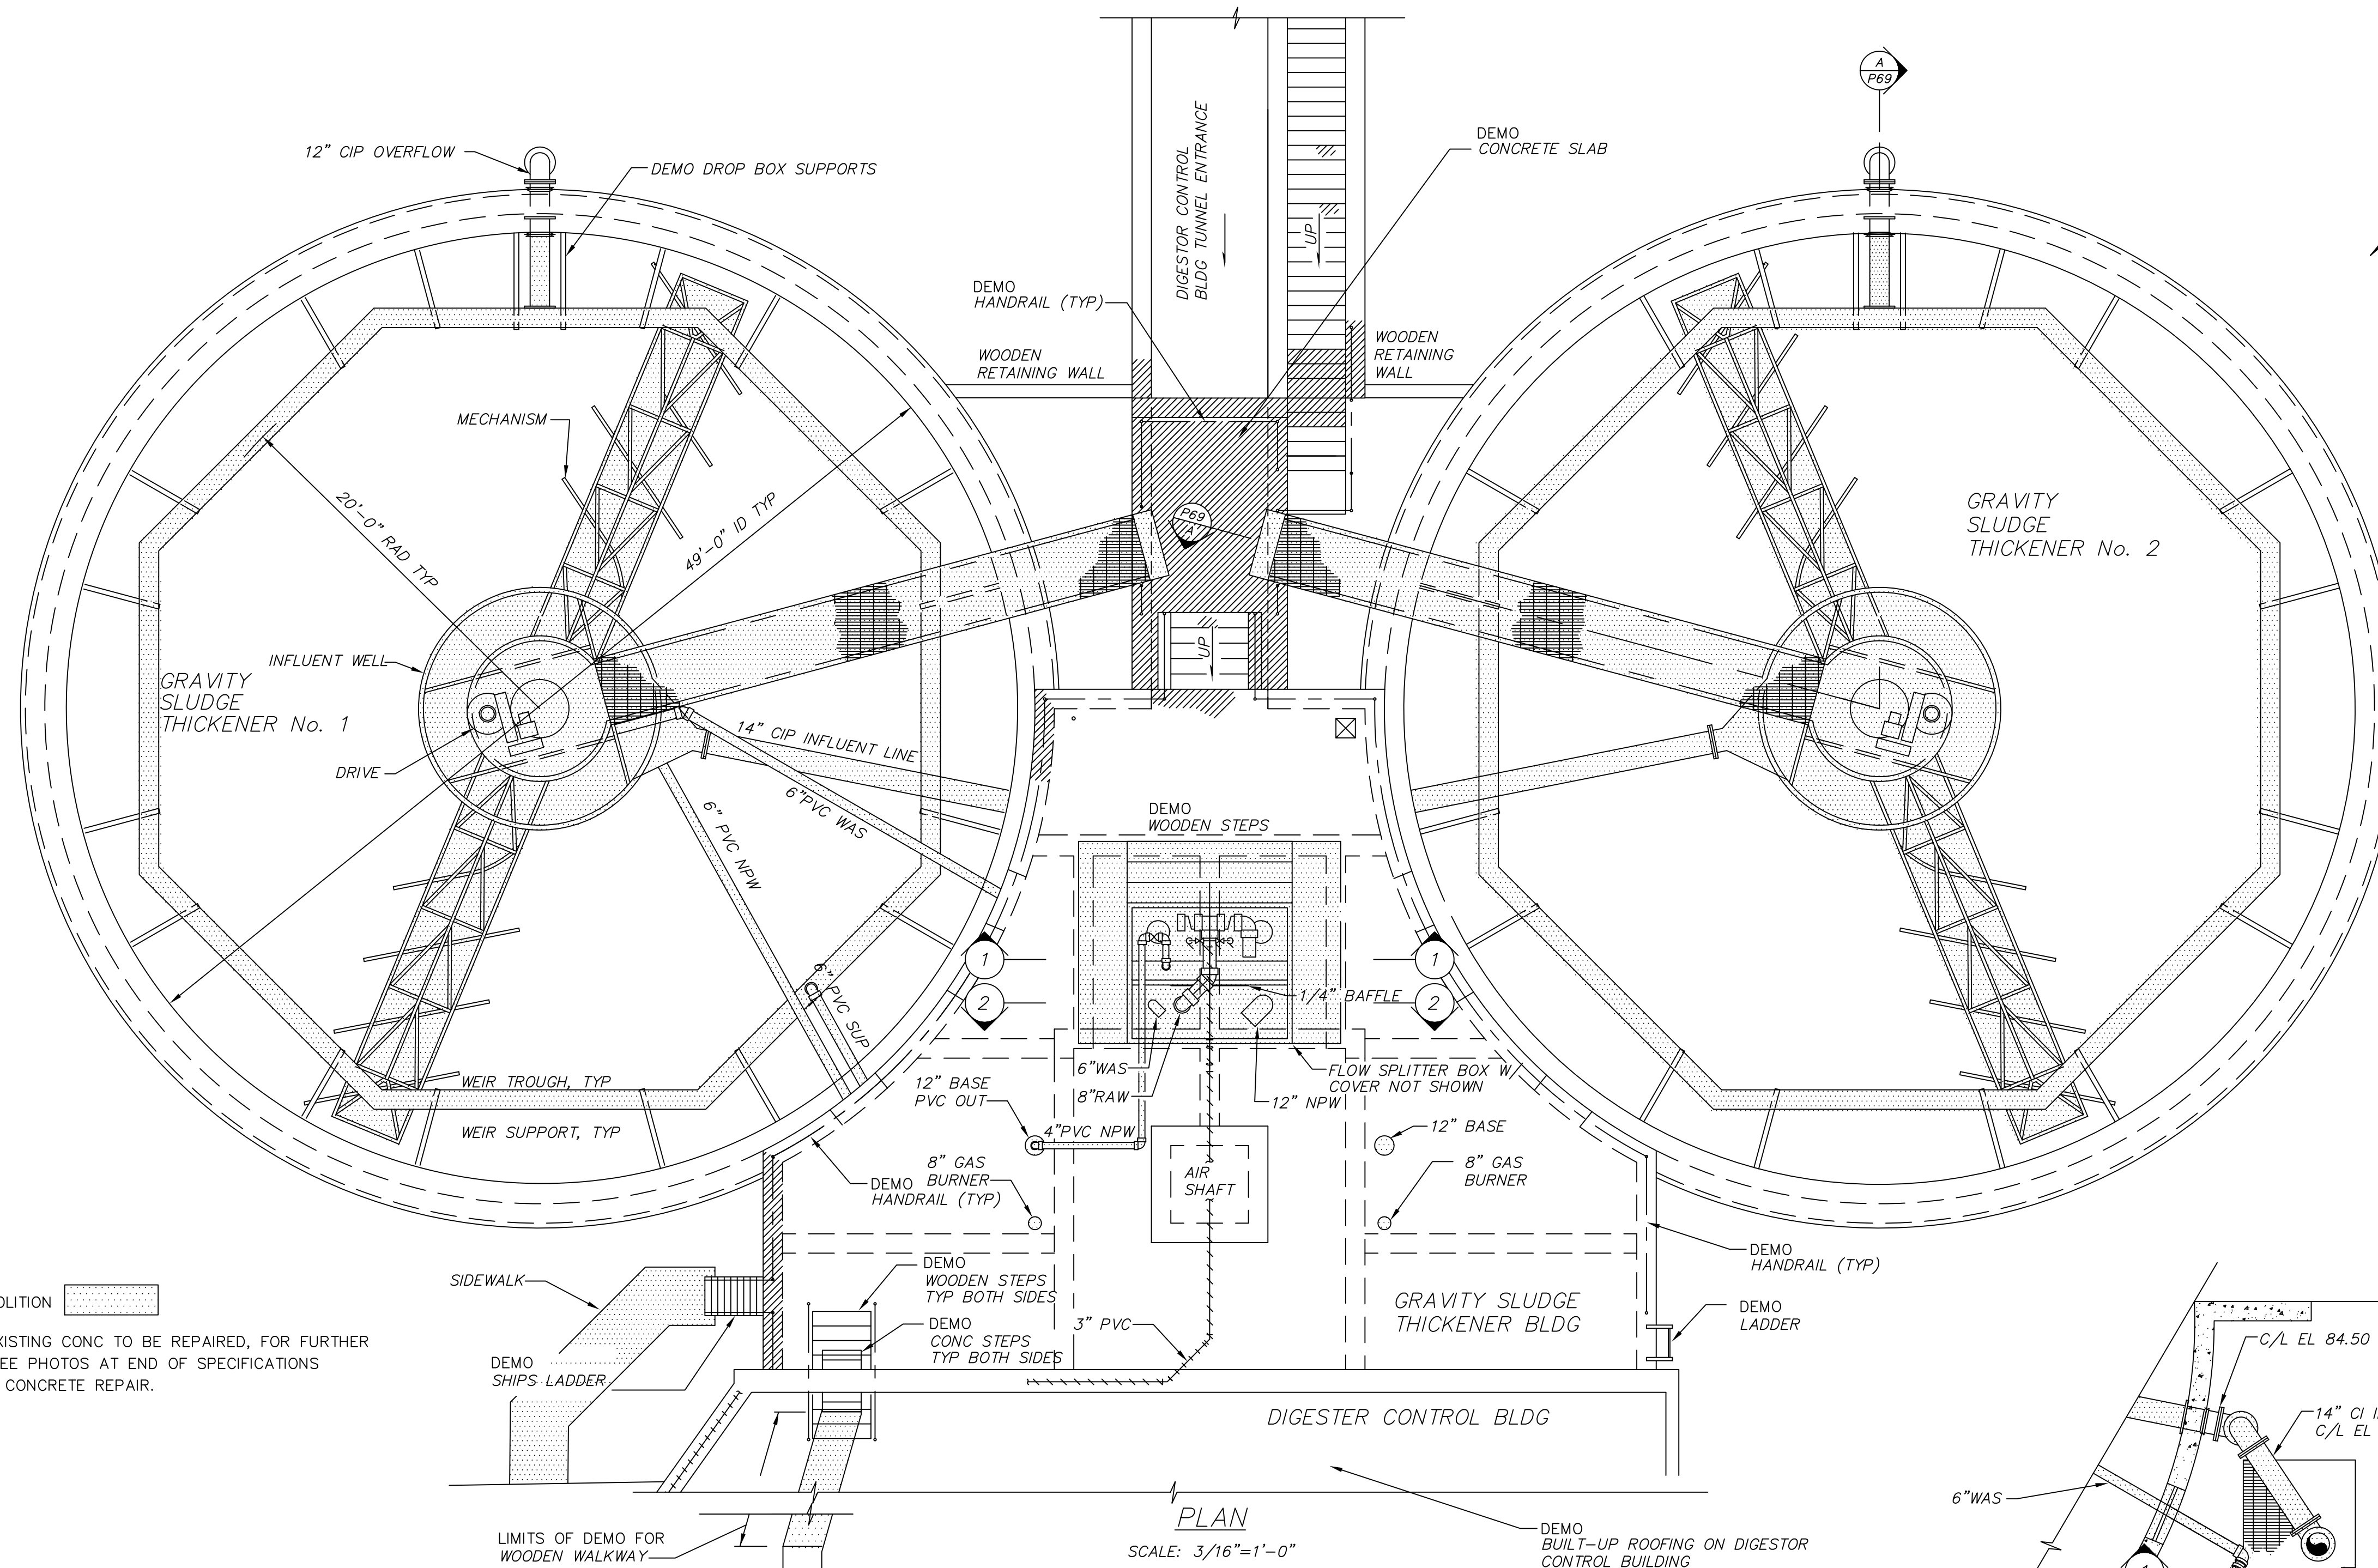
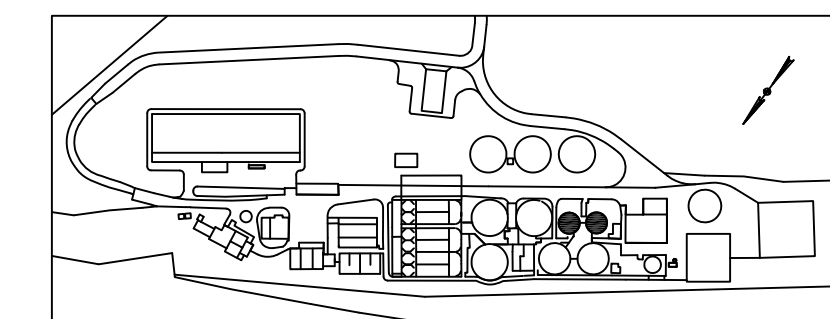
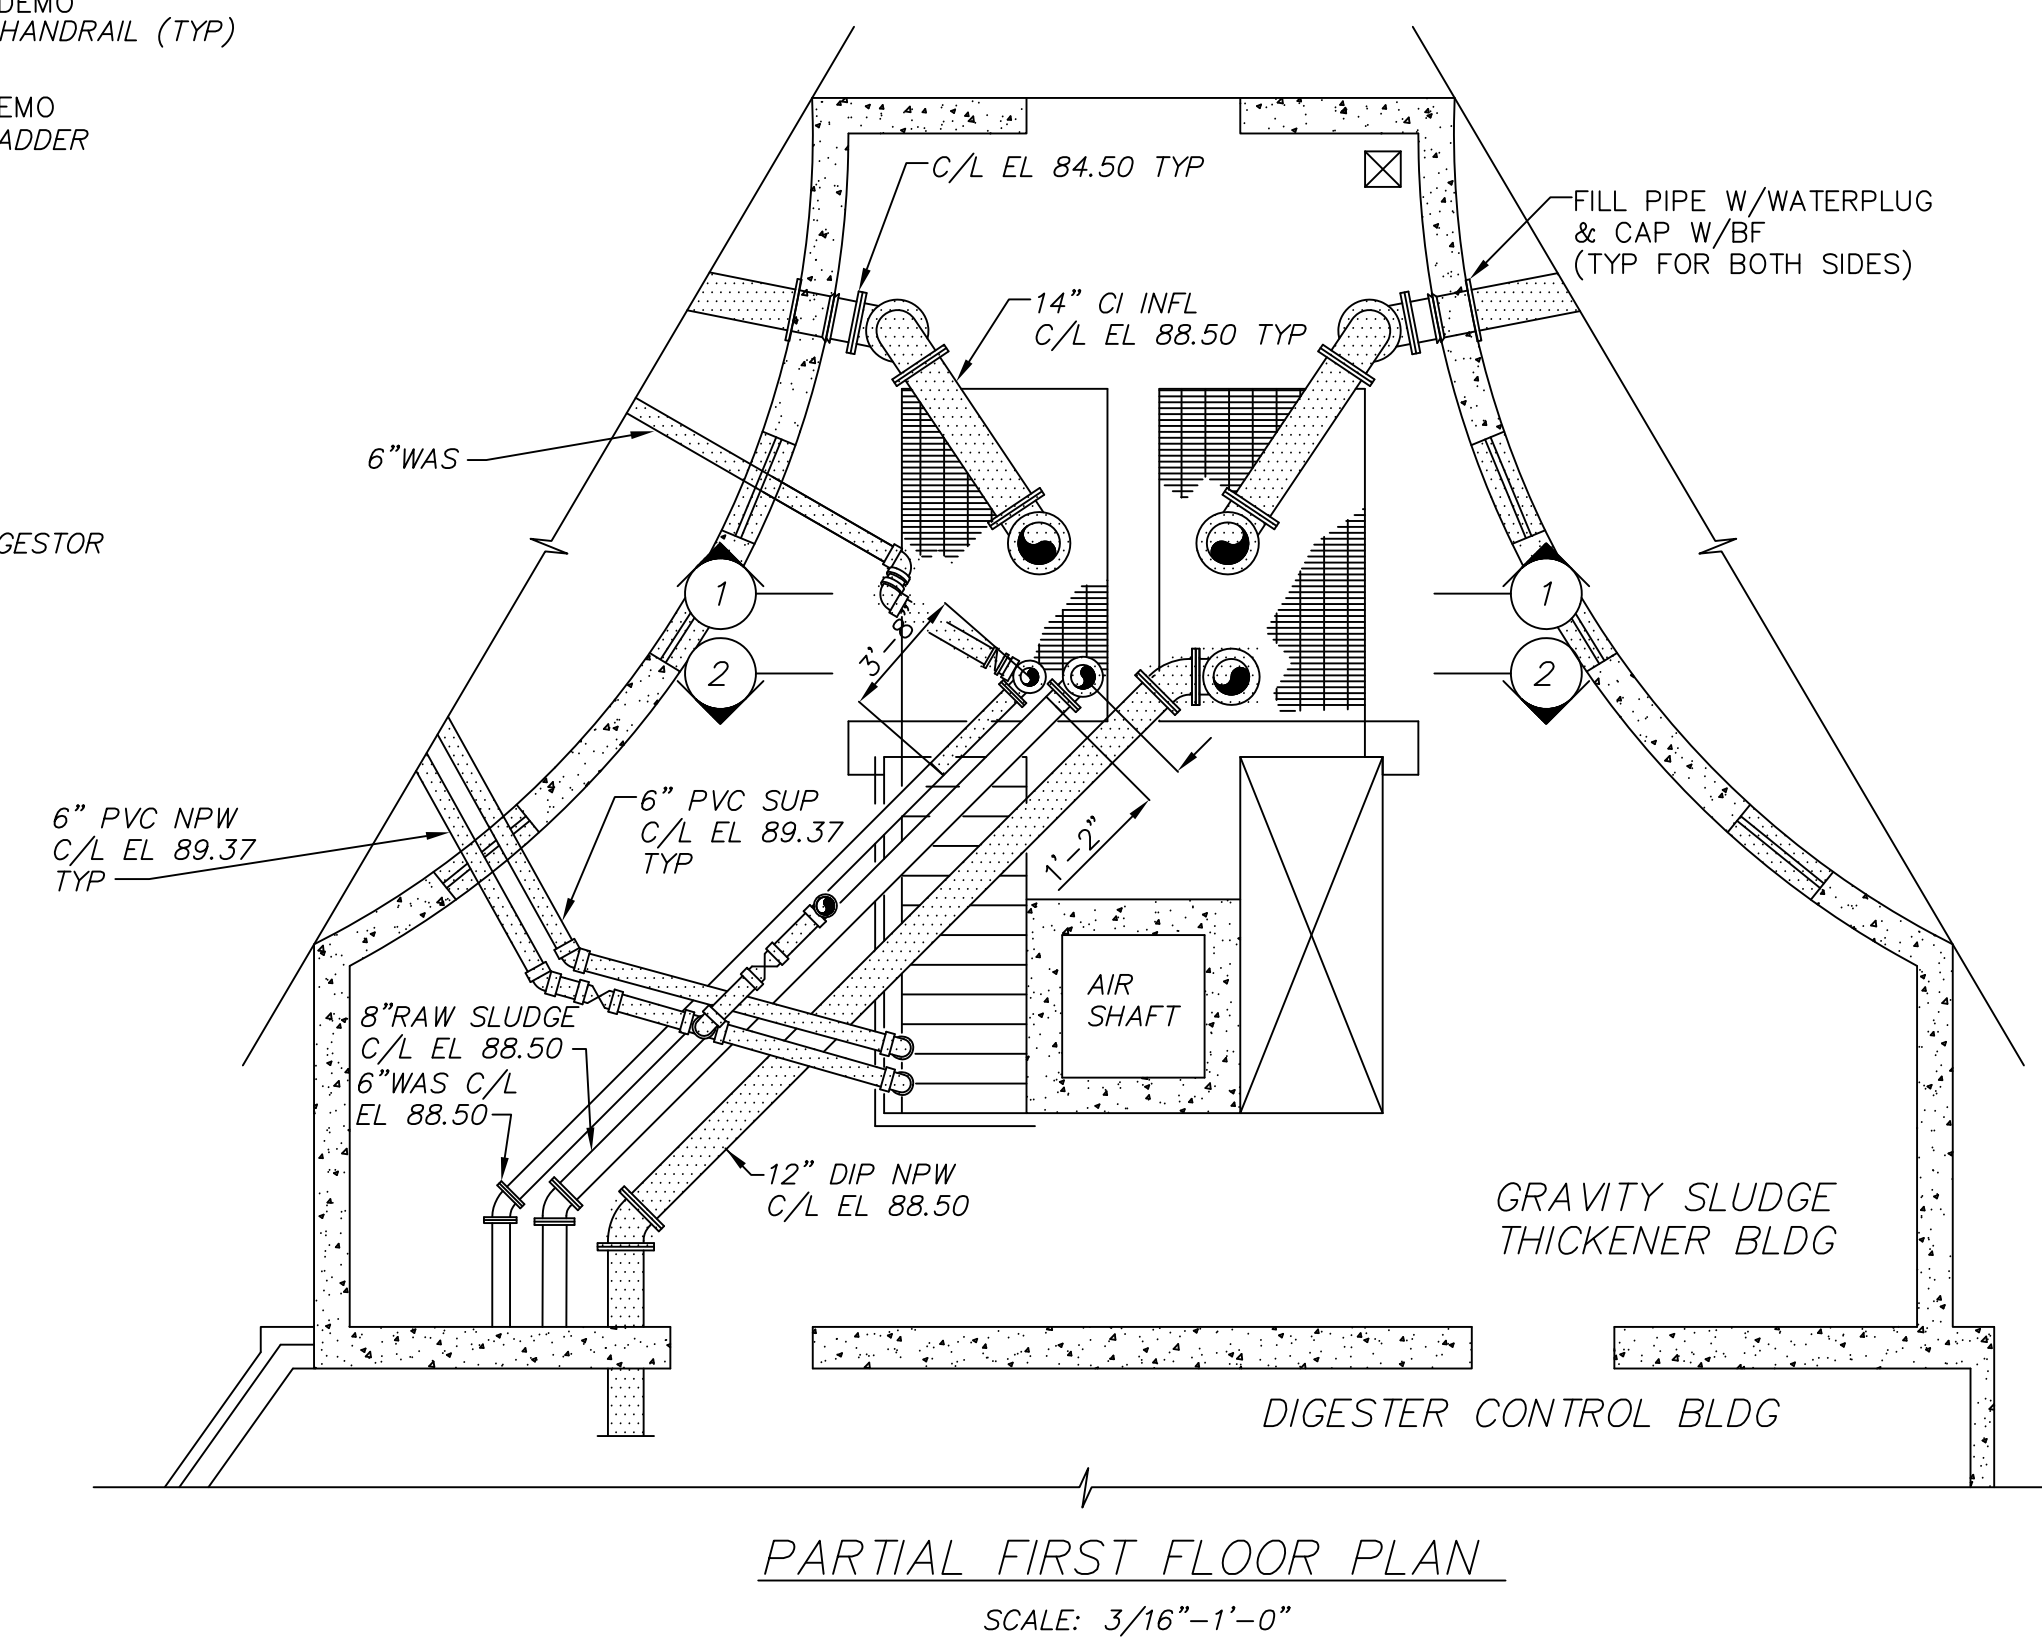


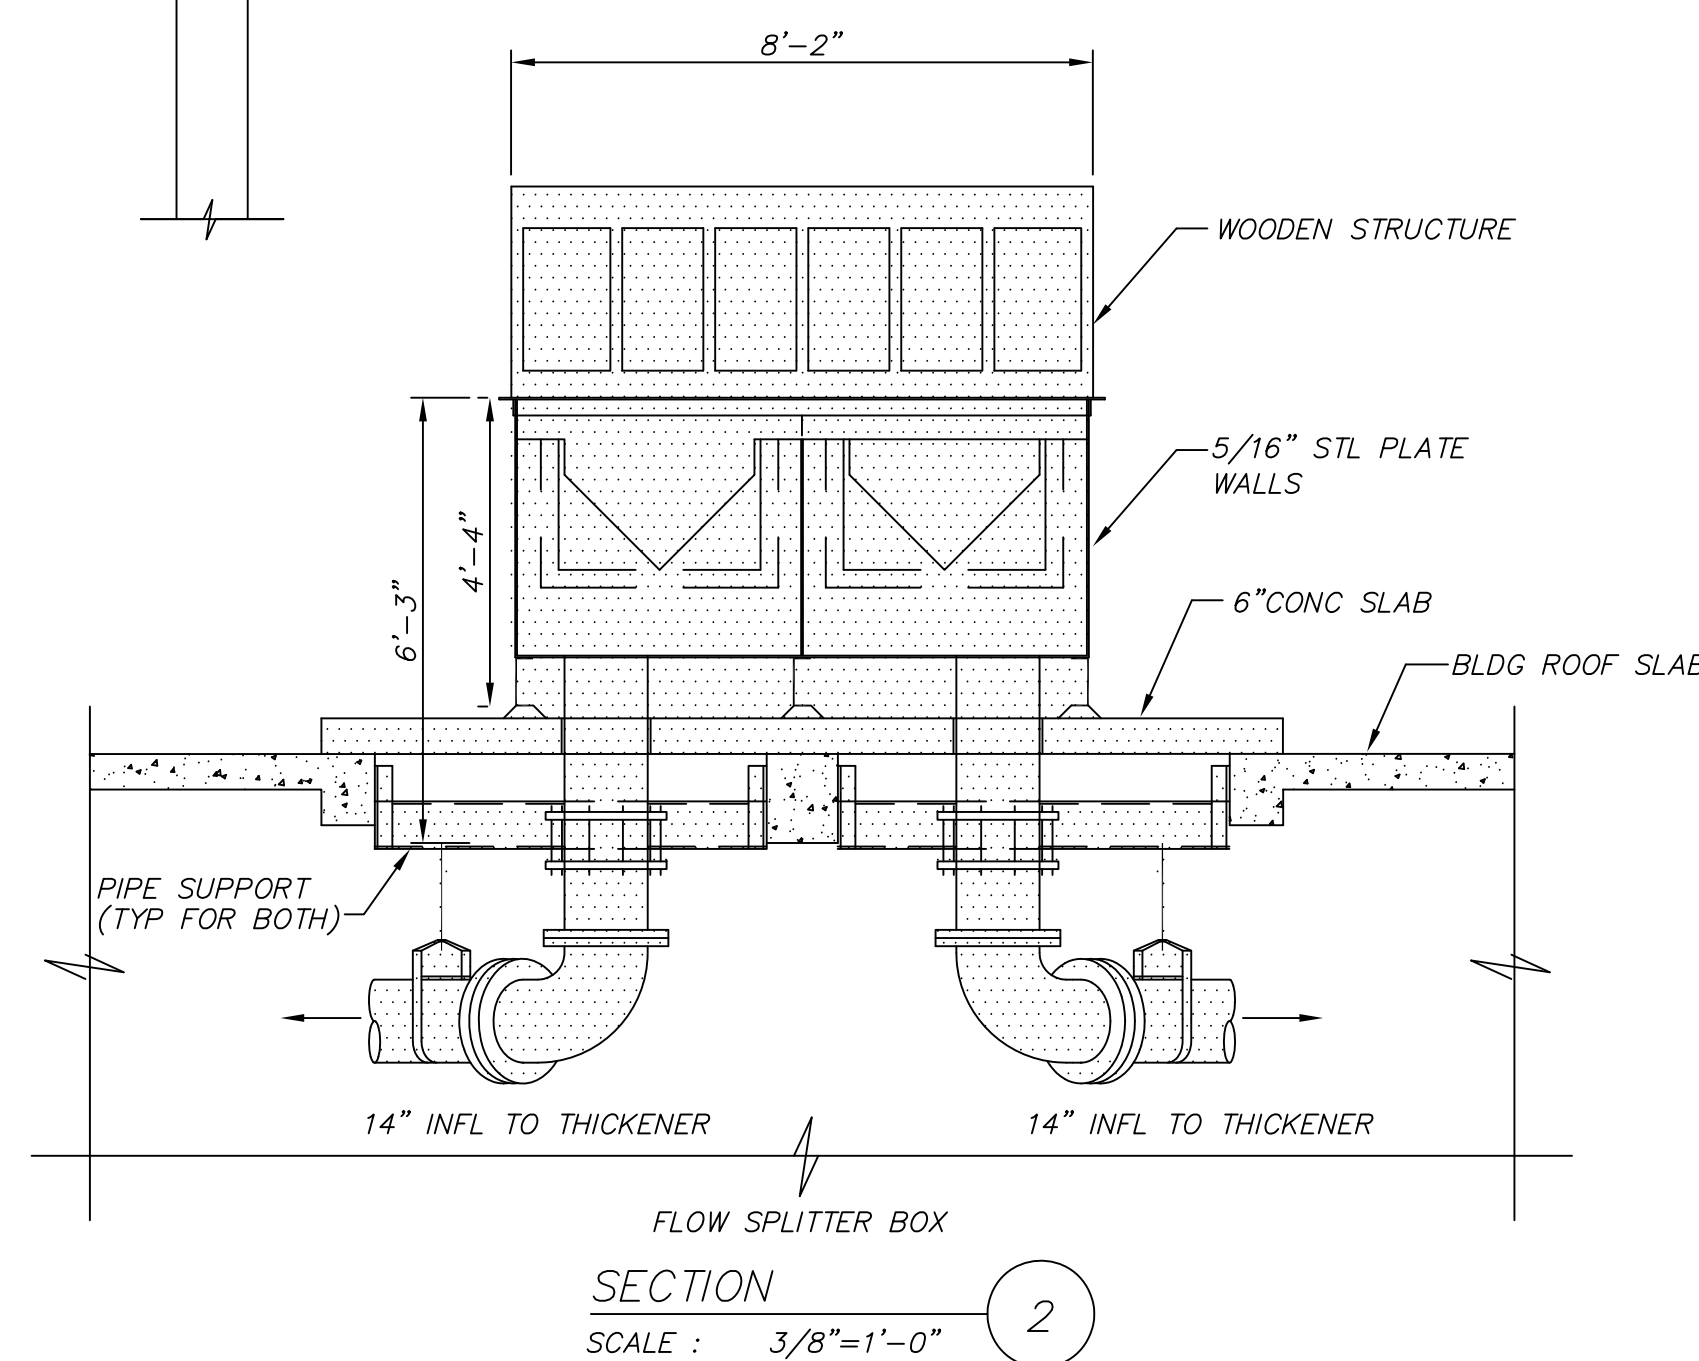

- NOTES:
- ITEMS FOR DEMOLITION
 - EXISTING CONC TO BE REPAIRED, FOR FURTHER CLARIFICATION SEE PHOTOS AT END OF SPECIFICATIONS SECTION 03732, CONCRETE REPAIR.

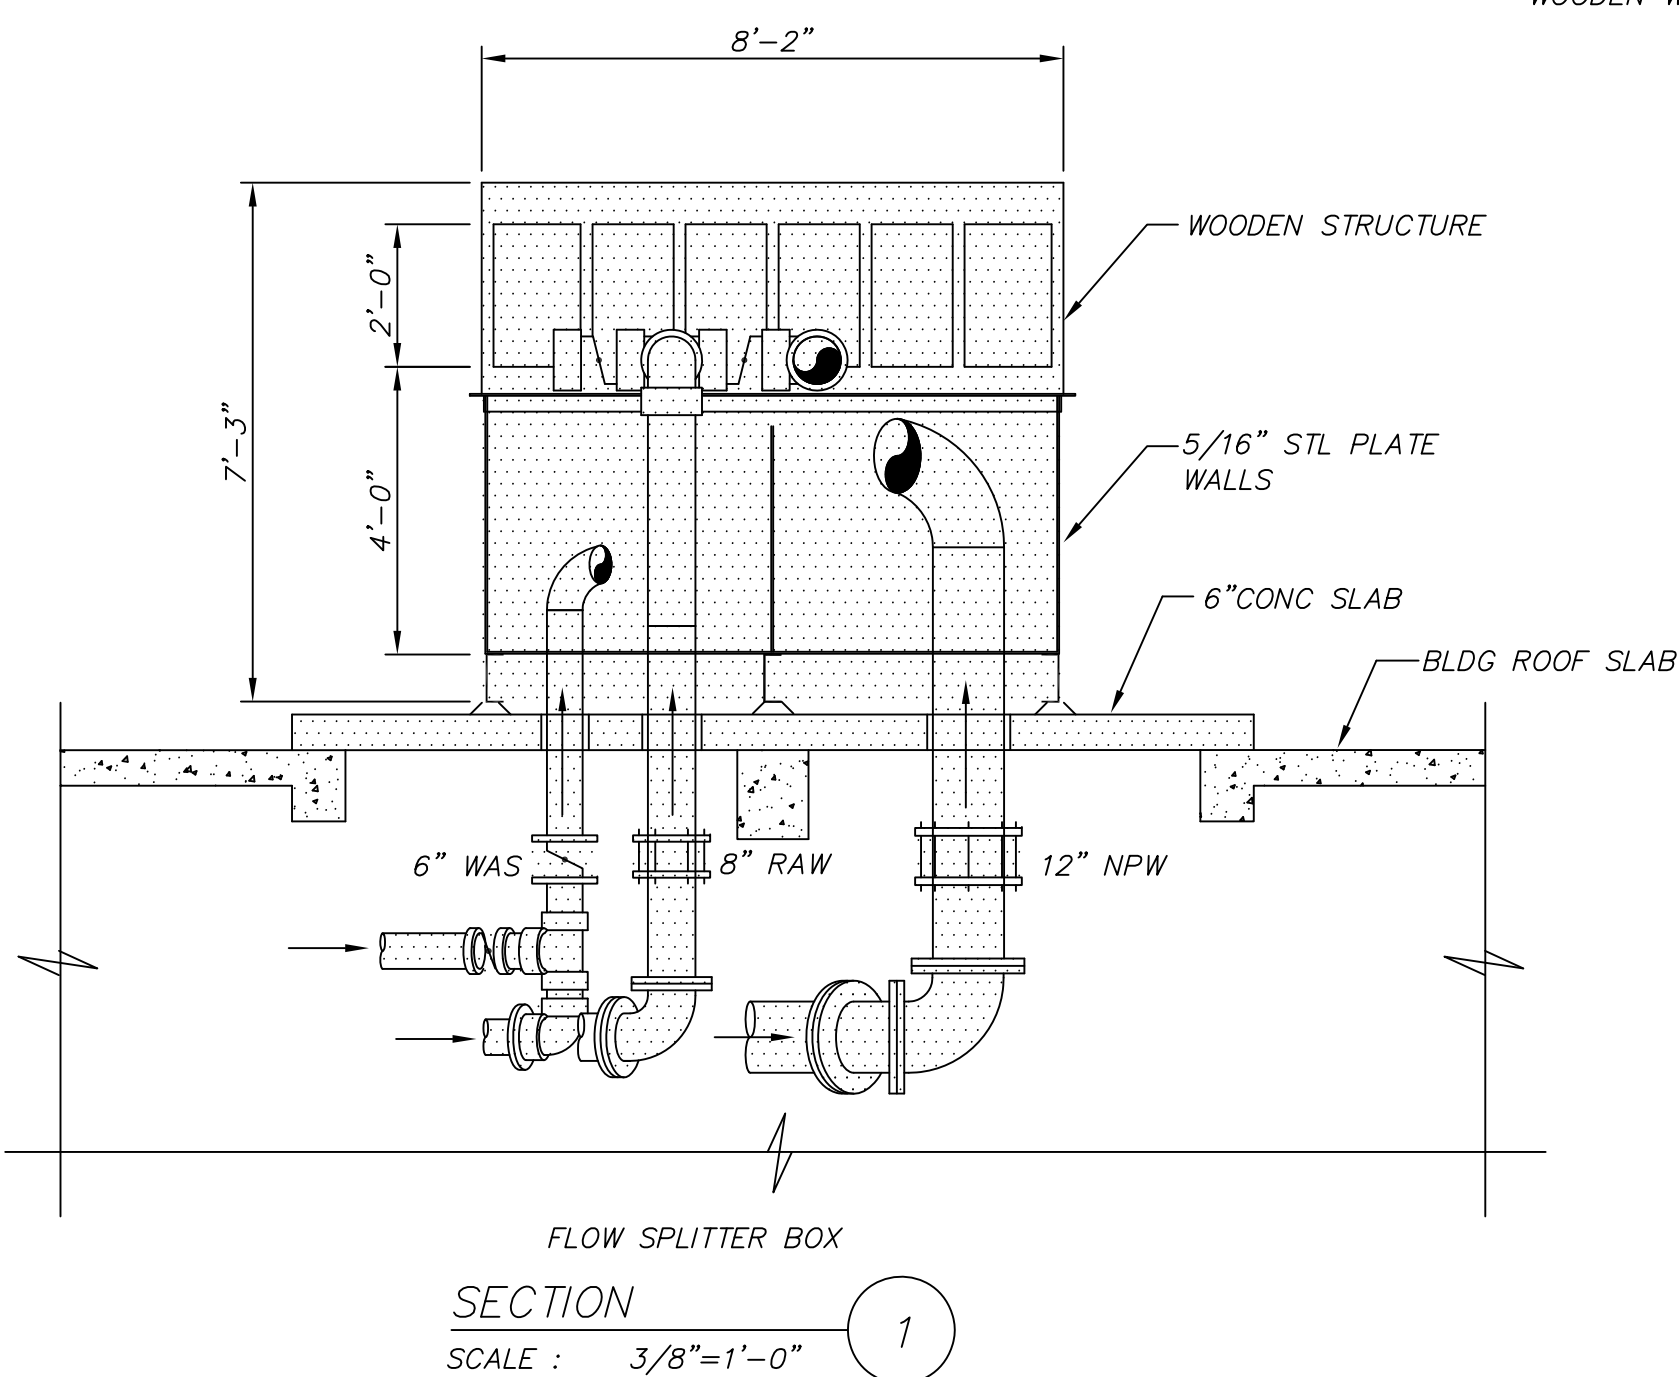

THESE RECORD DOCUMENTS HAVE BEEN PREPARED BASED ON INFORMATION PROVIDED BY OTHERS. CTI ENVIRONMENTAL HAS REVIEWED THE INFORMATION SUBMITTED AND BELIEVES IT REFLECTS THE WORK AS CONSTRUCTED. HOWEVER, ALL PERSONS SHALL VERIFY INFORMATION TAKEN FROM THIS DRAWING.

THIS DRAWING IS AN INSTRUMENT OF SERVICE OWNED BY CTI ENVIRONMENTAL, INC. WHICH SHALL BE DEEMED THE AUTHOR AND WHICH SHALL RETAIN ALL STATUTORY AND COMMON LAW RIGHTS. THIS DRAWING SHALL NOT BE REPRODUCED, COPIED, OR OTHERWISE USED FOR ANY OTHER PURPOSE OR PROJECT WITHOUT THE WRITTEN CONSENT OF CTI ENVIRONMENTAL, INC. THAT ELECTRONIC COPIES OF THIS DRAWING ARE EXACT DUPLICATES OF THE SEALED ORIGINAL DRAWING. ANY COPIES OF THIS DRAWING THAT ARE NOT THE SEALED ORIGINAL SHALL GOVERN.

DESIGNED BY	NO.	DESCRIPTIONS	DATE	BY	APP'D
RWR	1	ADDENDUM NO. 2	10/18	RWR	WAD
DRAWN BY	2	RECORD DRAWING	3/23	MGW	WAD
CHECKED BY					
APPROVED BY					

ENVIRONMENTAL, INC.
ENGINEERS IN WATER AND EARTH SCIENCES
UNIONTOWN, OHIO

CITY OF MASSILLON, OHIO
WWTP UPGRADE 2000
GRAVITY SLUDGE THICKENER DEMOLITION
UPPER PLAN, FLOW SPLITTER AND PARTIAL PLAN

JOB NO. E9031
DATE 08/13/01
SCALE AS NOTED
SHEET P75