



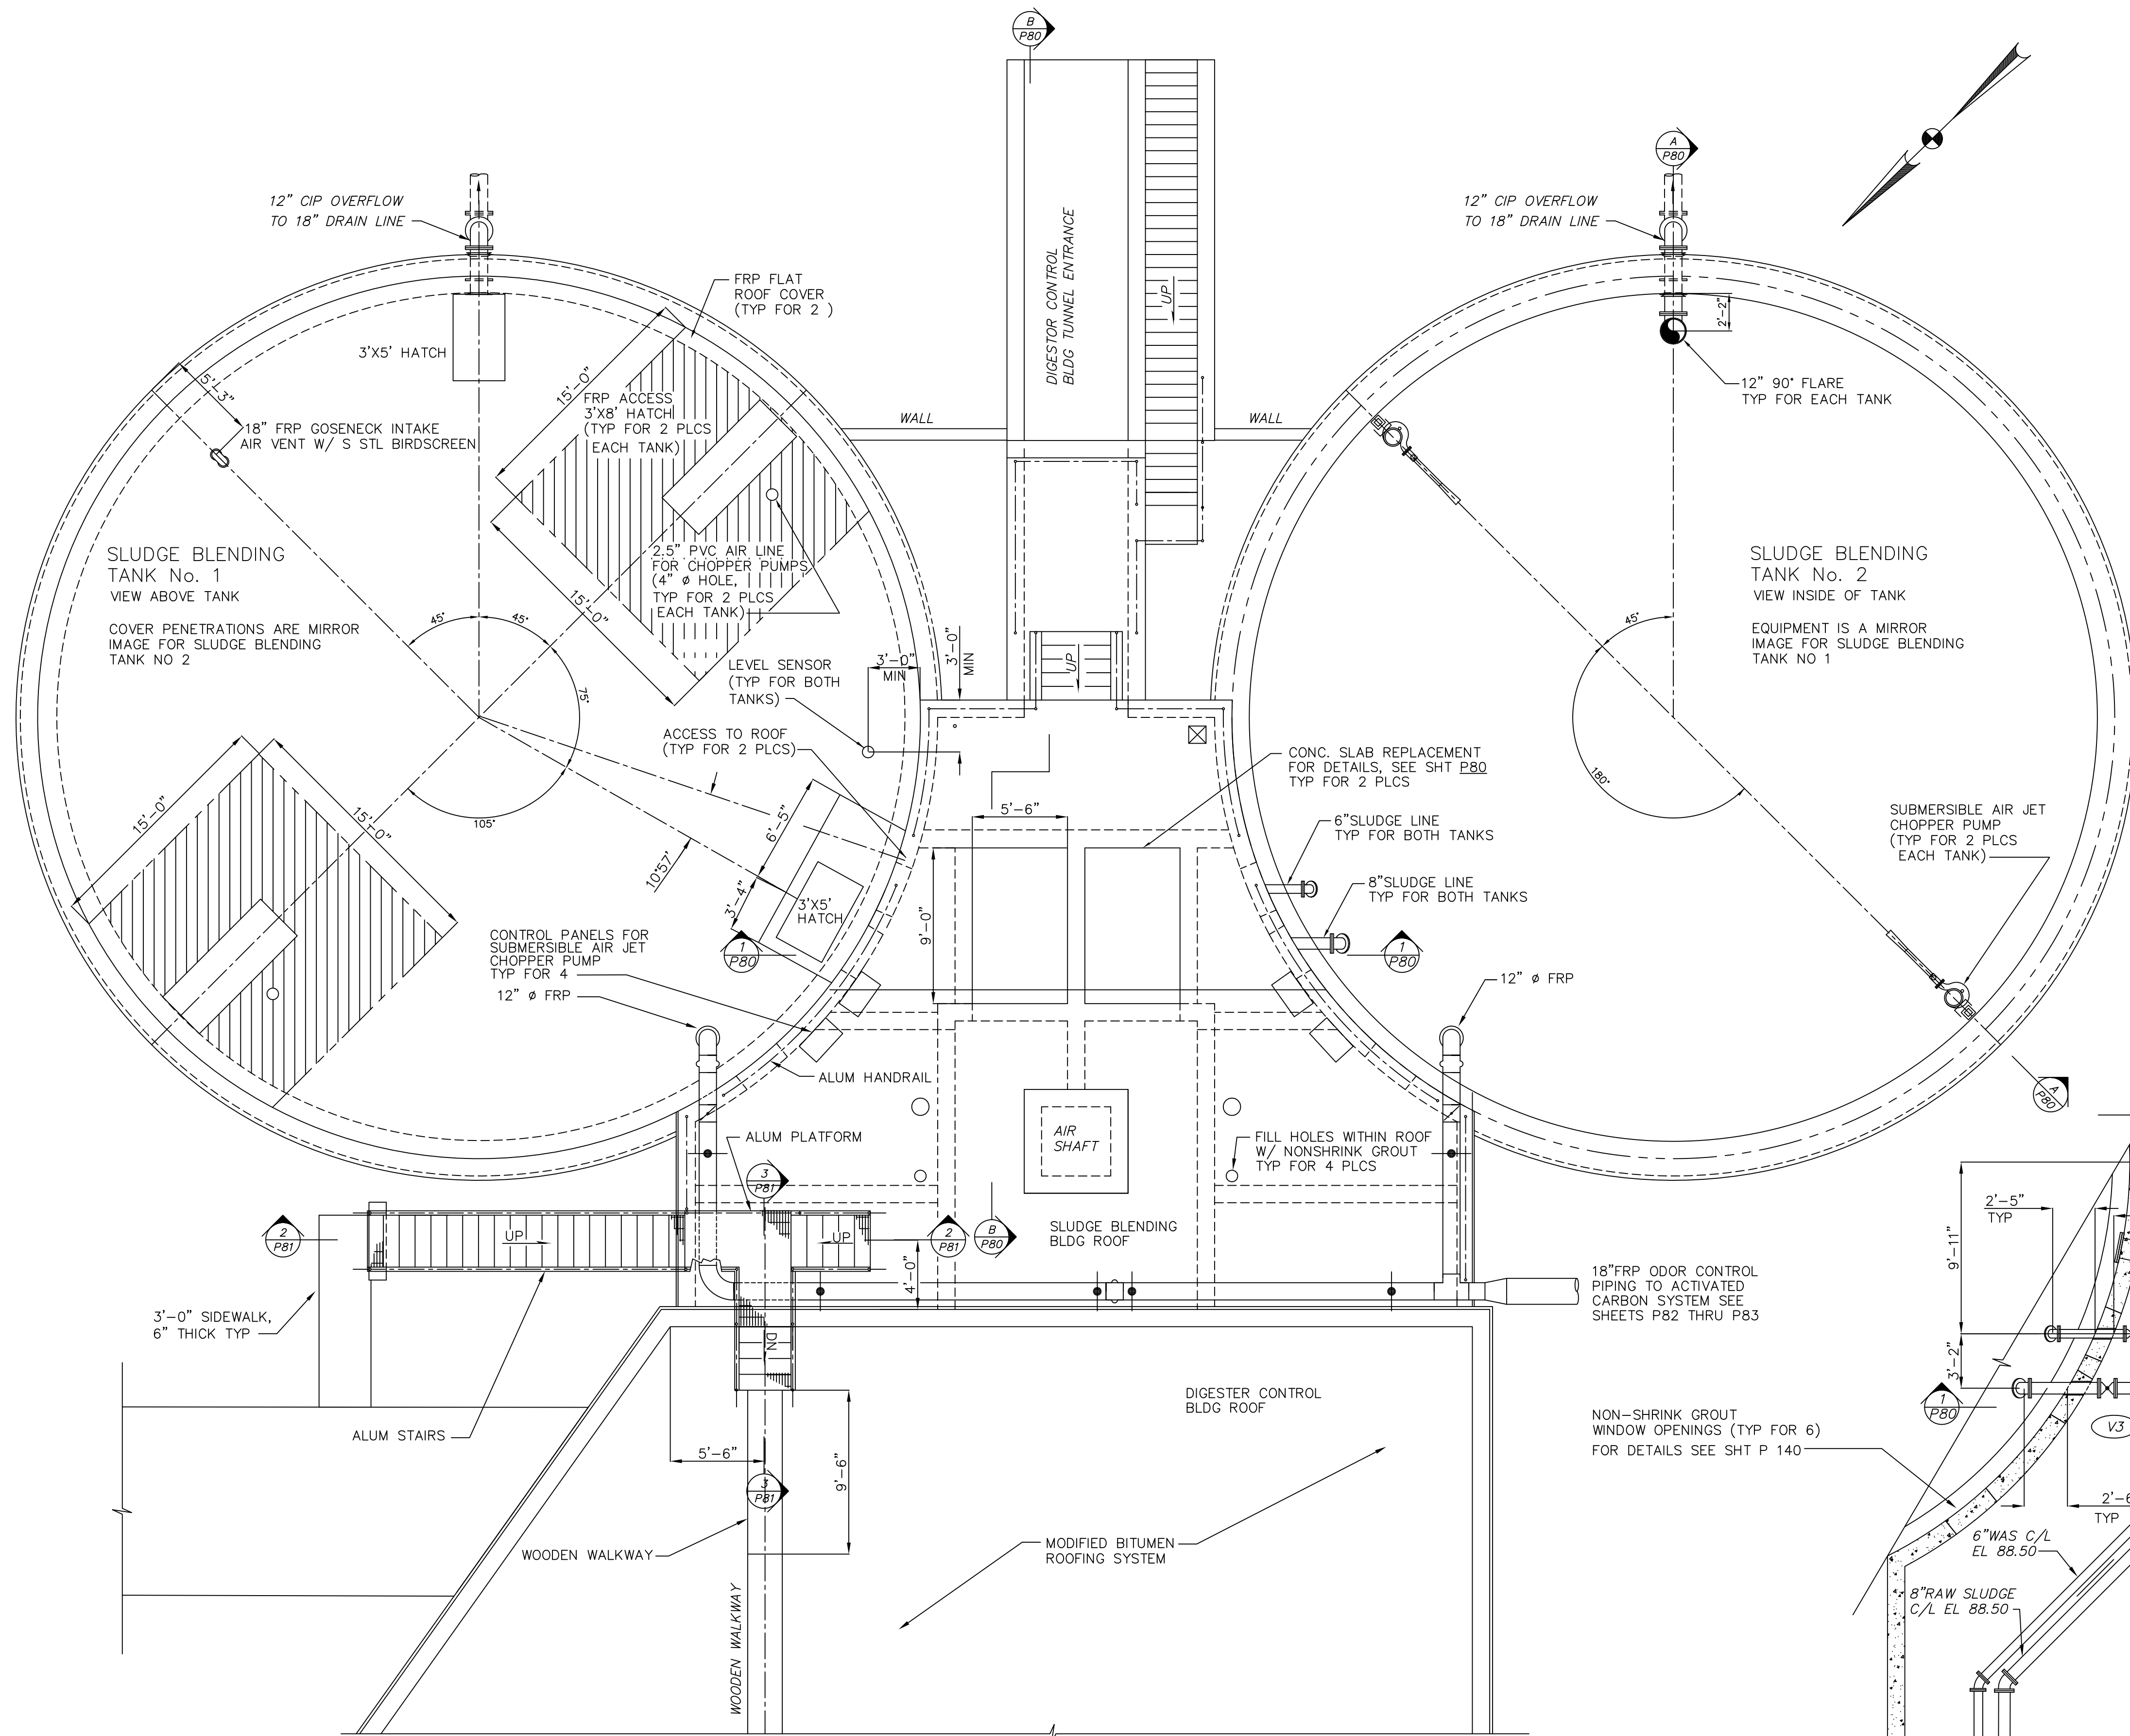


PLAN
SCALE: 3/16"=1'-0"

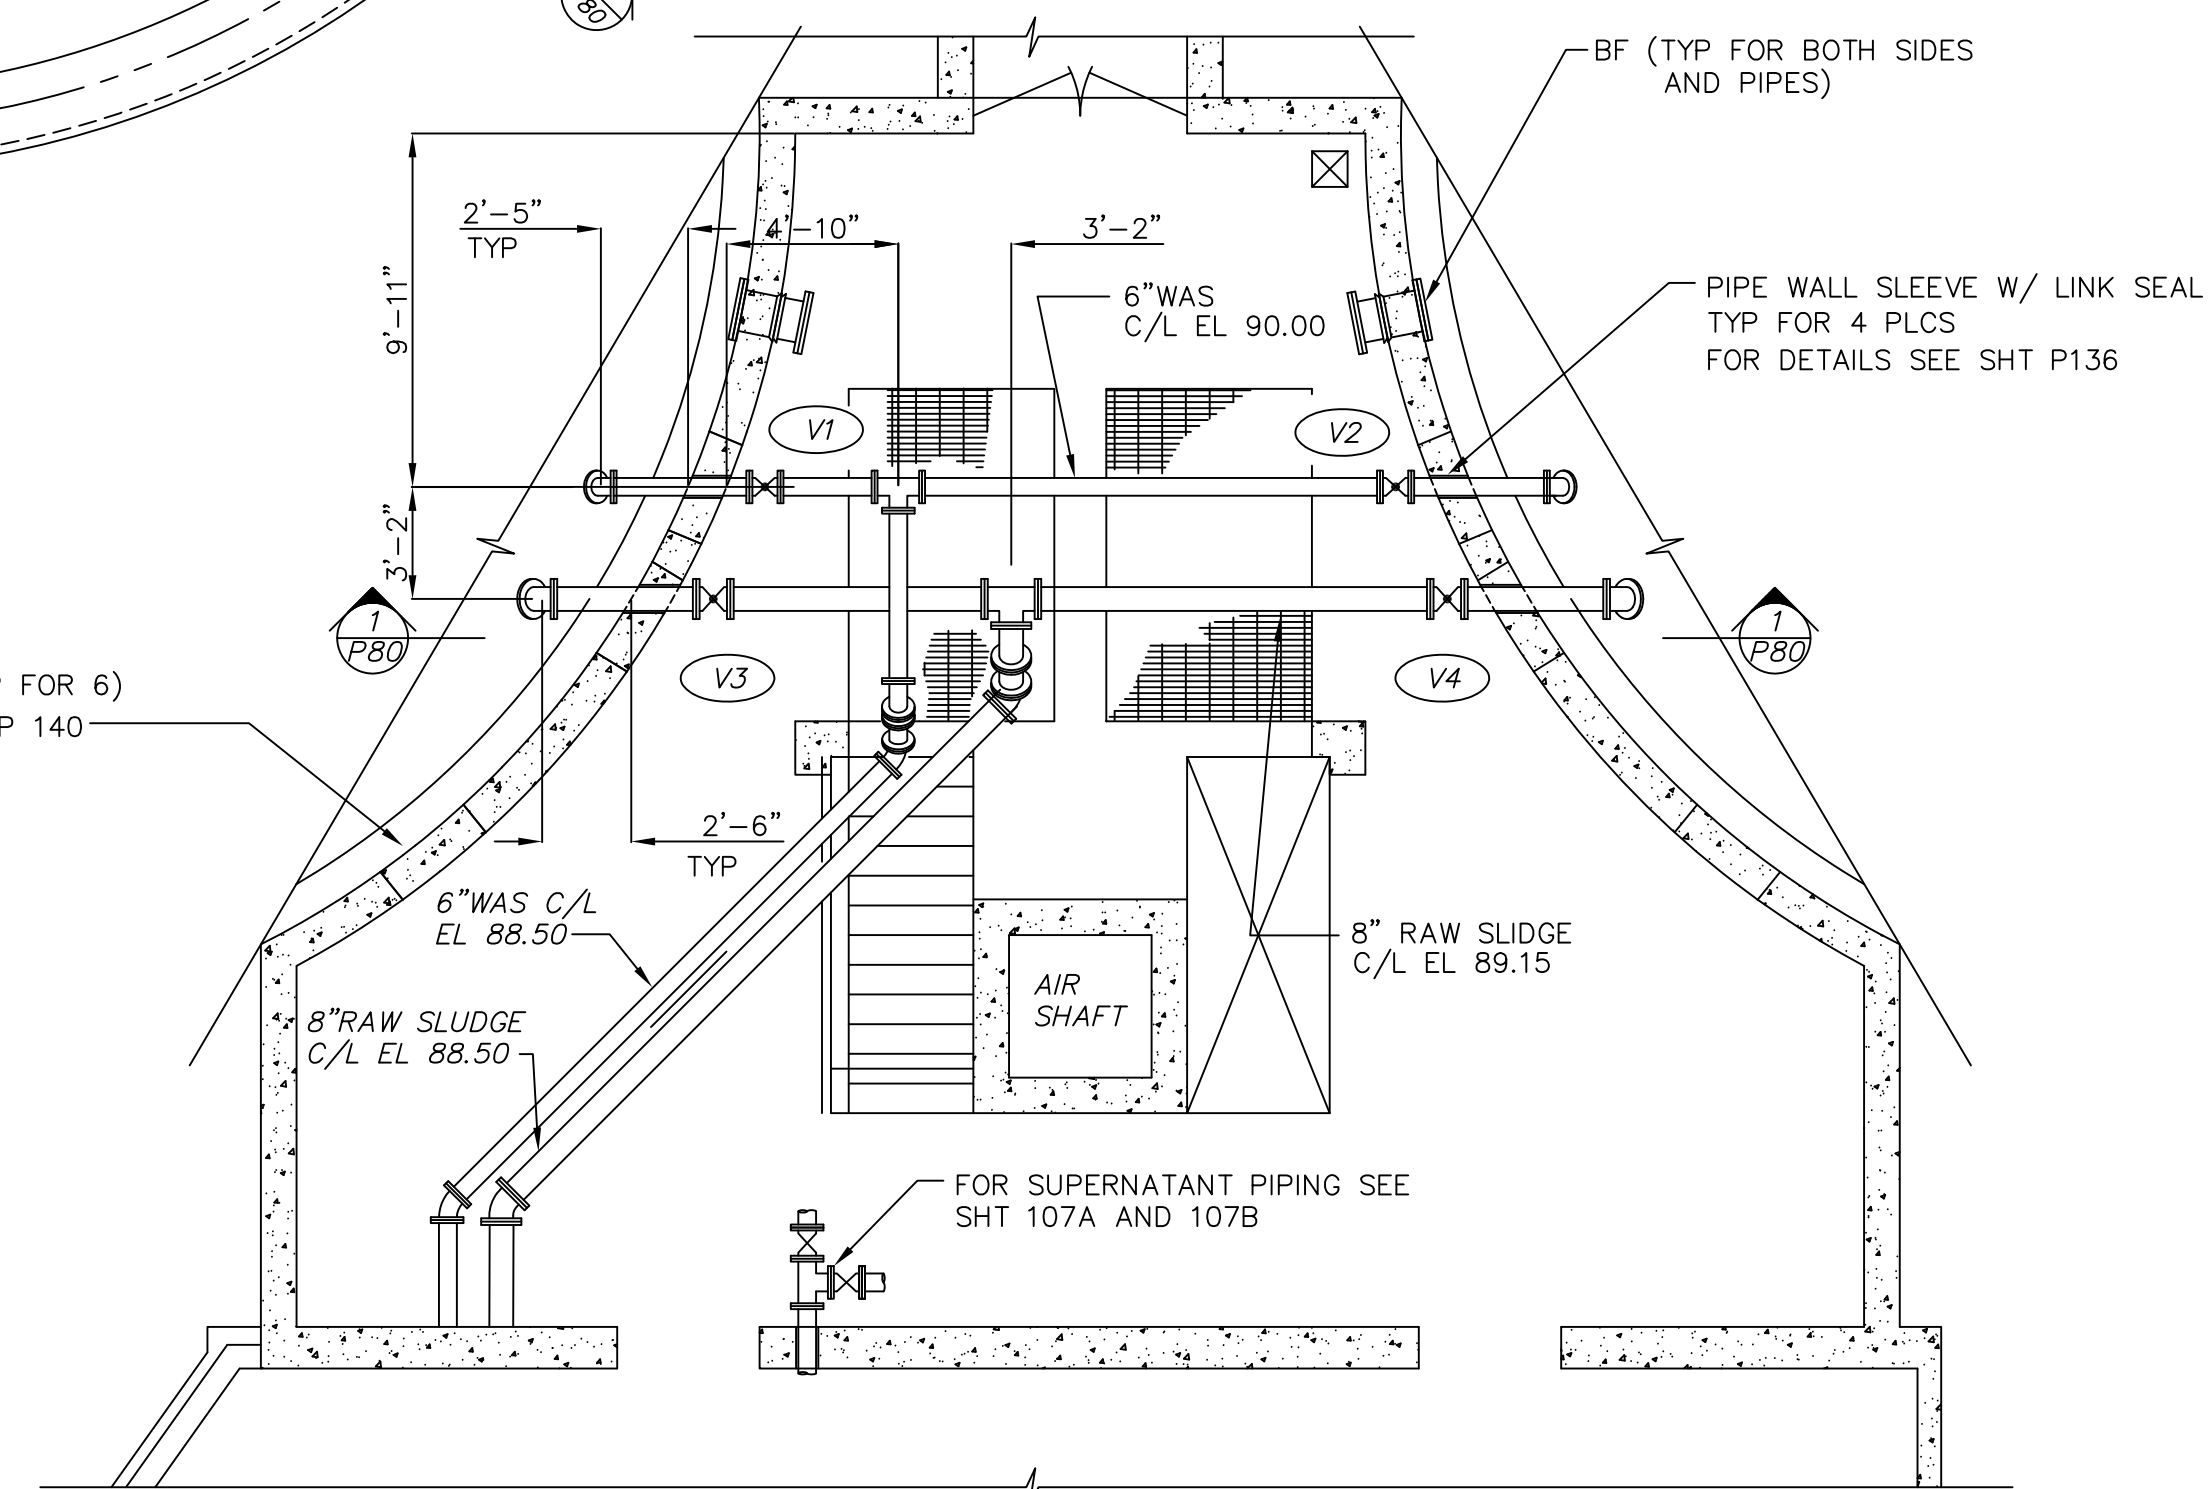

PLAN @ EL 90.00
SCALE: 3/16"=1'-0"

THESE RECORD DOCUMENTS HAVE BEEN PREPARED
BASED ON INFORMATION PROVIDED BY OTHERS. CTI
ENVIRONMENTAL HAS REVIEWED THE INFORMATION
SUBMITTED AND BELIEVES IT REFLECTS THE WORK AS
CONSTRUCTED. HOWEVER, ALL PERSONS SHALL
VERIFY INFORMATION TAKEN FROM THIS DRAWING.

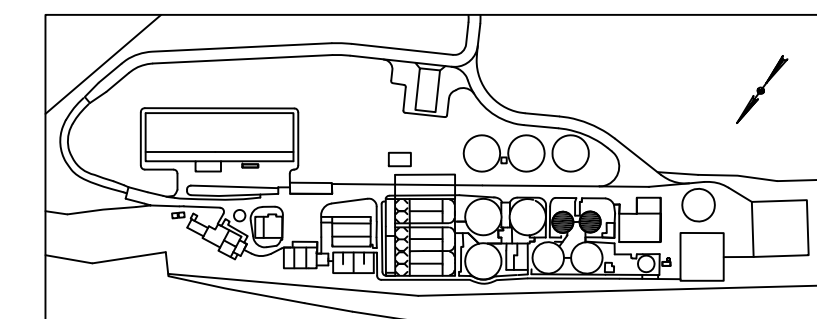

KEY PLAN

NOTES:

- FRP COVER TO BE DESIGNED FOR THE FOLLOWING LOADS:
LIVE LOAD - 40 psf. MIN.
WIND LOAD - 80 mph - MIN.
- THE AREAS DESIGNATED SHALL BE DESIGNED
FOR AN ADDITIONAL EQUIPMENT POINT LOAD OF 600 lbs.

THIS DRAWING IS AN INSTRUMENT OF SERVICE OWNED
BY CTI ENVIRONMENTAL, INC. WHICH SHALL BE DEEMED
THE AUTHOR AND WHICH SHALL RETAIN ALL STATUTORY
RIGHTS. THIS DRAWING SHALL NOT BE REPRODUCED, COPIED, OR
TRANSMITTED IN ANY FORM OR BY ANY MEANS, ELECTRONIC OR
MECHANICAL, WITHOUT THE WRITTEN CONSENT OF CTI ENVIRONMENTAL, INC. THAT
ANY OTHER PURPOSE OR PROJECT WITHOUT THE WRITTEN
CONSENT OF CTI ENVIRONMENTAL, INC. THAT
ELECTRONIC COPIES OF THIS DRAWING ARE EXACT
DUPLICATES OF THE SEALED ORIGINAL DRAWING.
COPY AND THE SEALED ORIGINAL THE SEALED ORIGINAL
SHALL GOVERN.

DESIGNED BY		DATE		BY		DATE		BY	
PMK		3/23		MGW		WAD			
DRAWN BY		RECORD DRAWING							
AJP									
CHECKED BY									
RWR									
APPROVED BY									
WAD									

ENVIRONMENTAL, INC.
ENGINEERS IN WATER AND EARTH SCIENCES
UNIONTOWN, OHIO



CITY OF MASSILLON, OHIO
WWTP UPGRADE 2000
SLUDGE BLENDING TANK UPPER AND FIRST FLOOR PLAN

JOB NO.
E9031
DATE
08/13/01
SCALE
AS NOTED
SHEET
P78