


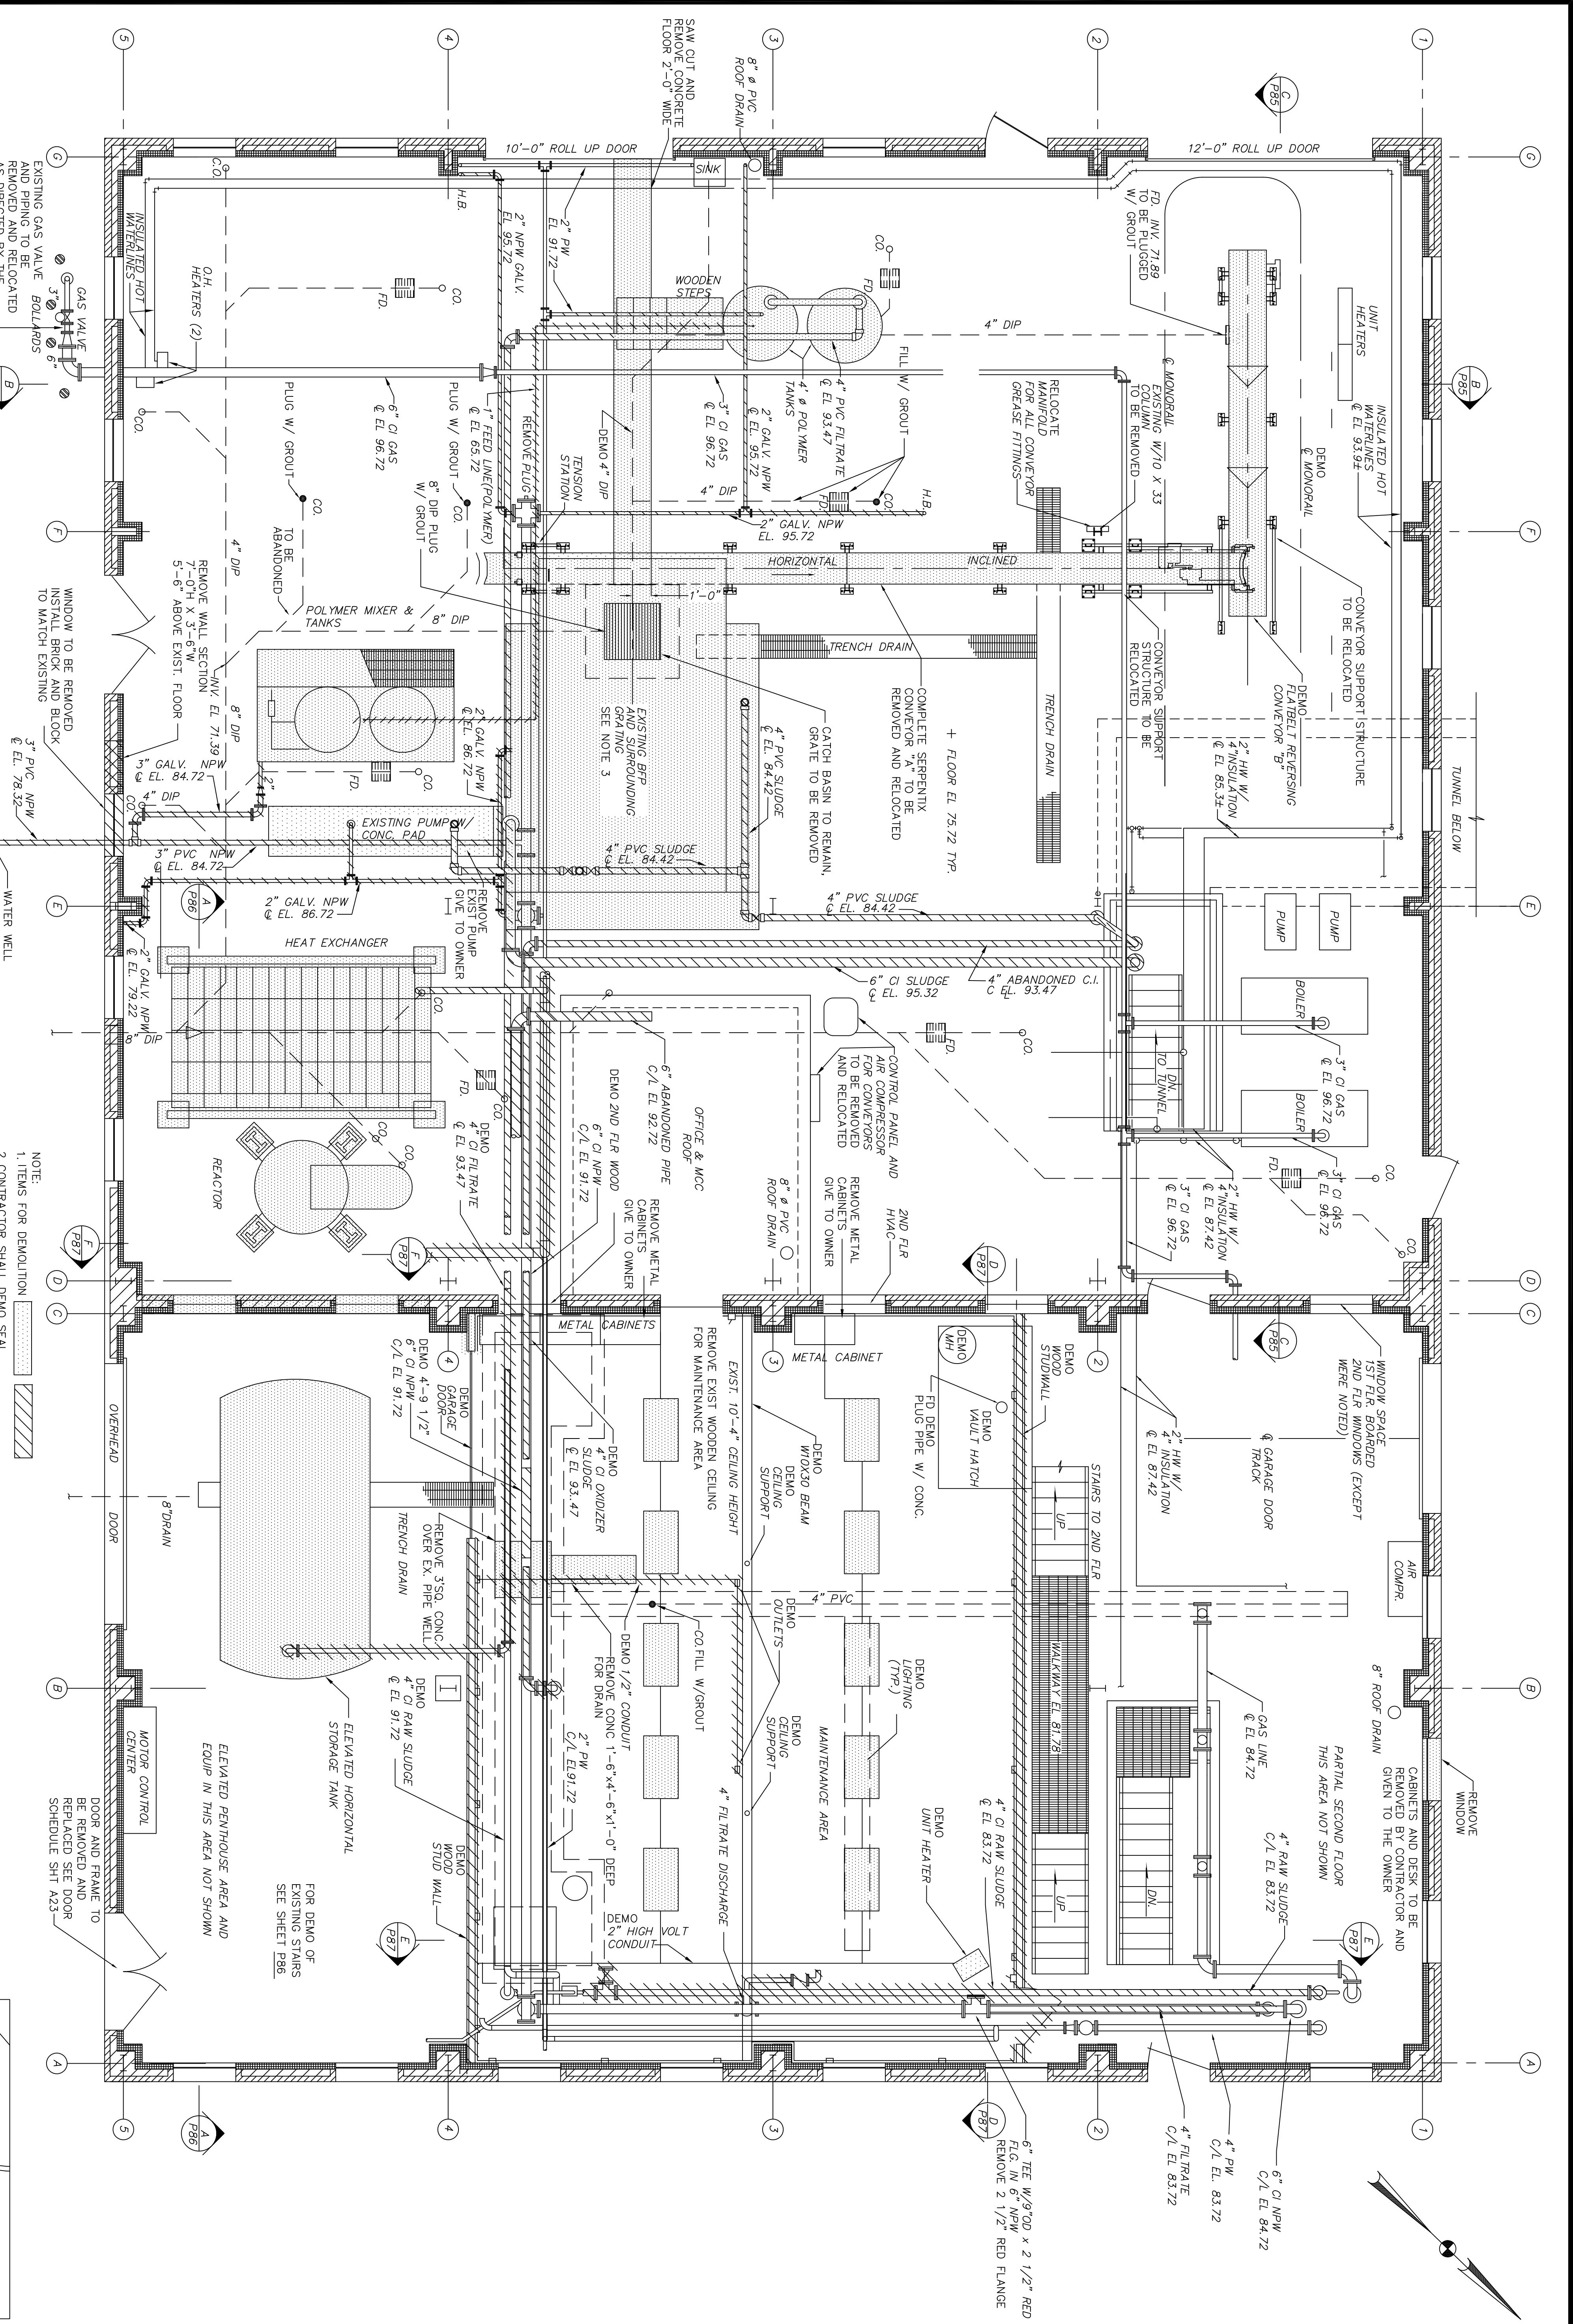

|                                                                                                                                                                                                                                                                                                     |             |           |                |  |      |     |       |  |                                                                                                                                                                                                                                                                                                                                                                                                                                                                                                                                                                                                                                               |
|-----------------------------------------------------------------------------------------------------------------------------------------------------------------------------------------------------------------------------------------------------------------------------------------------------|-------------|-----------|----------------|--|------|-----|-------|--|-----------------------------------------------------------------------------------------------------------------------------------------------------------------------------------------------------------------------------------------------------------------------------------------------------------------------------------------------------------------------------------------------------------------------------------------------------------------------------------------------------------------------------------------------------------------------------------------------------------------------------------------------|
| <div></div> <div>ENVIRONMENTAL, INC.<br/>ENGINEERS IN WATER AND EARTH SCIENCES<br/>UNIONTOWN, OHIO</div> <div>CITY OF MASSILLON, OHIO<br/>WWTP UPGRADE 2000<br/>SOLIDS HANDLING FACILITIES DEMOLITION PLAN</div> | DESIGNED BY | REVISIONS |                |  |      |     |       |  | <div>THIS DRAWING IS AN INSTRUMENT OF SERVICE OWNED BY CTI ENVIRONMENTAL, INC. WHICH SHALL BE DEEMED THE AUTHOR AND WHICH SHALL RETAIN ALL STATUTORY AND COMMON LAW RIGHTS, INCLUDING COPYRIGHTS. THIS DRAWING SHALL NOT BE SCANNED, COPIED, OR DISTRIBUTED TO OTHERS IN ANY FORM OR USED FOR ANY OTHER PURPOSE OR PROJECT WITHOUT THE WRITTEN CONSENT OF CTI ENVIRONMENTAL, INC. CTI ENVIRONMENTAL, INC. CANNOT GUARANTEE THAT ELECTRONIC COPIES OF THIS DRAWING ARE EXACT DUPLICATES OF THE SEALED ORIGINAL DRAWING. IN THE EVENT OF A CONFLICT BETWEEN AN ELECTRONIC COPY AND THE SEALED ORIGINAL, THE SEALED ORIGINAL SHALL GOVERN.</div> |
|                                                                                                                                                                                                                                                                                                     | TMK         | NO.       | DESCRIPTIONS   |  | DATE | BY  | APP'D |  |                                                                                                                                                                                                                                                                                                                                                                                                                                                                                                                                                                                                                                               |
|                                                                                                                                                                                                                                                                                                     | DRAWN BY    | 1         | RECORD DRAWING |  | 4/05 | MGW | WAD   |  |                                                                                                                                                                                                                                                                                                                                                                                                                                                                                                                                                                                                                                               |
|                                                                                                                                                                                                                                                                                                     | SAT/AJP     |           |                |  |      |     |       |  |                                                                                                                                                                                                                                                                                                                                                                                                                                                                                                                                                                                                                                               |
|                                                                                                                                                                                                                                                                                                     | CHECKED BY  |           |                |  |      |     |       |  |                                                                                                                                                                                                                                                                                                                                                                                                                                                                                                                                                                                                                                               |
|                                                                                                                                                                                                                                                                                                     | RWR         |           |                |  |      |     |       |  |                                                                                                                                                                                                                                                                                                                                                                                                                                                                                                                                                                                                                                               |
|                                                                                                                                                                                                                                                                                                     | APPROVED BY |           |                |  |      |     |       |  |                                                                                                                                                                                                                                                                                                                                                                                                                                                                                                                                                                                                                                               |
| WAD                                                                                                                                                                                                                                                                                                 |             |           |                |  |      |     |       |  |                                                                                                                                                                                                                                                                                                                                                                                                                                                                                                                                                                                                                                               |