



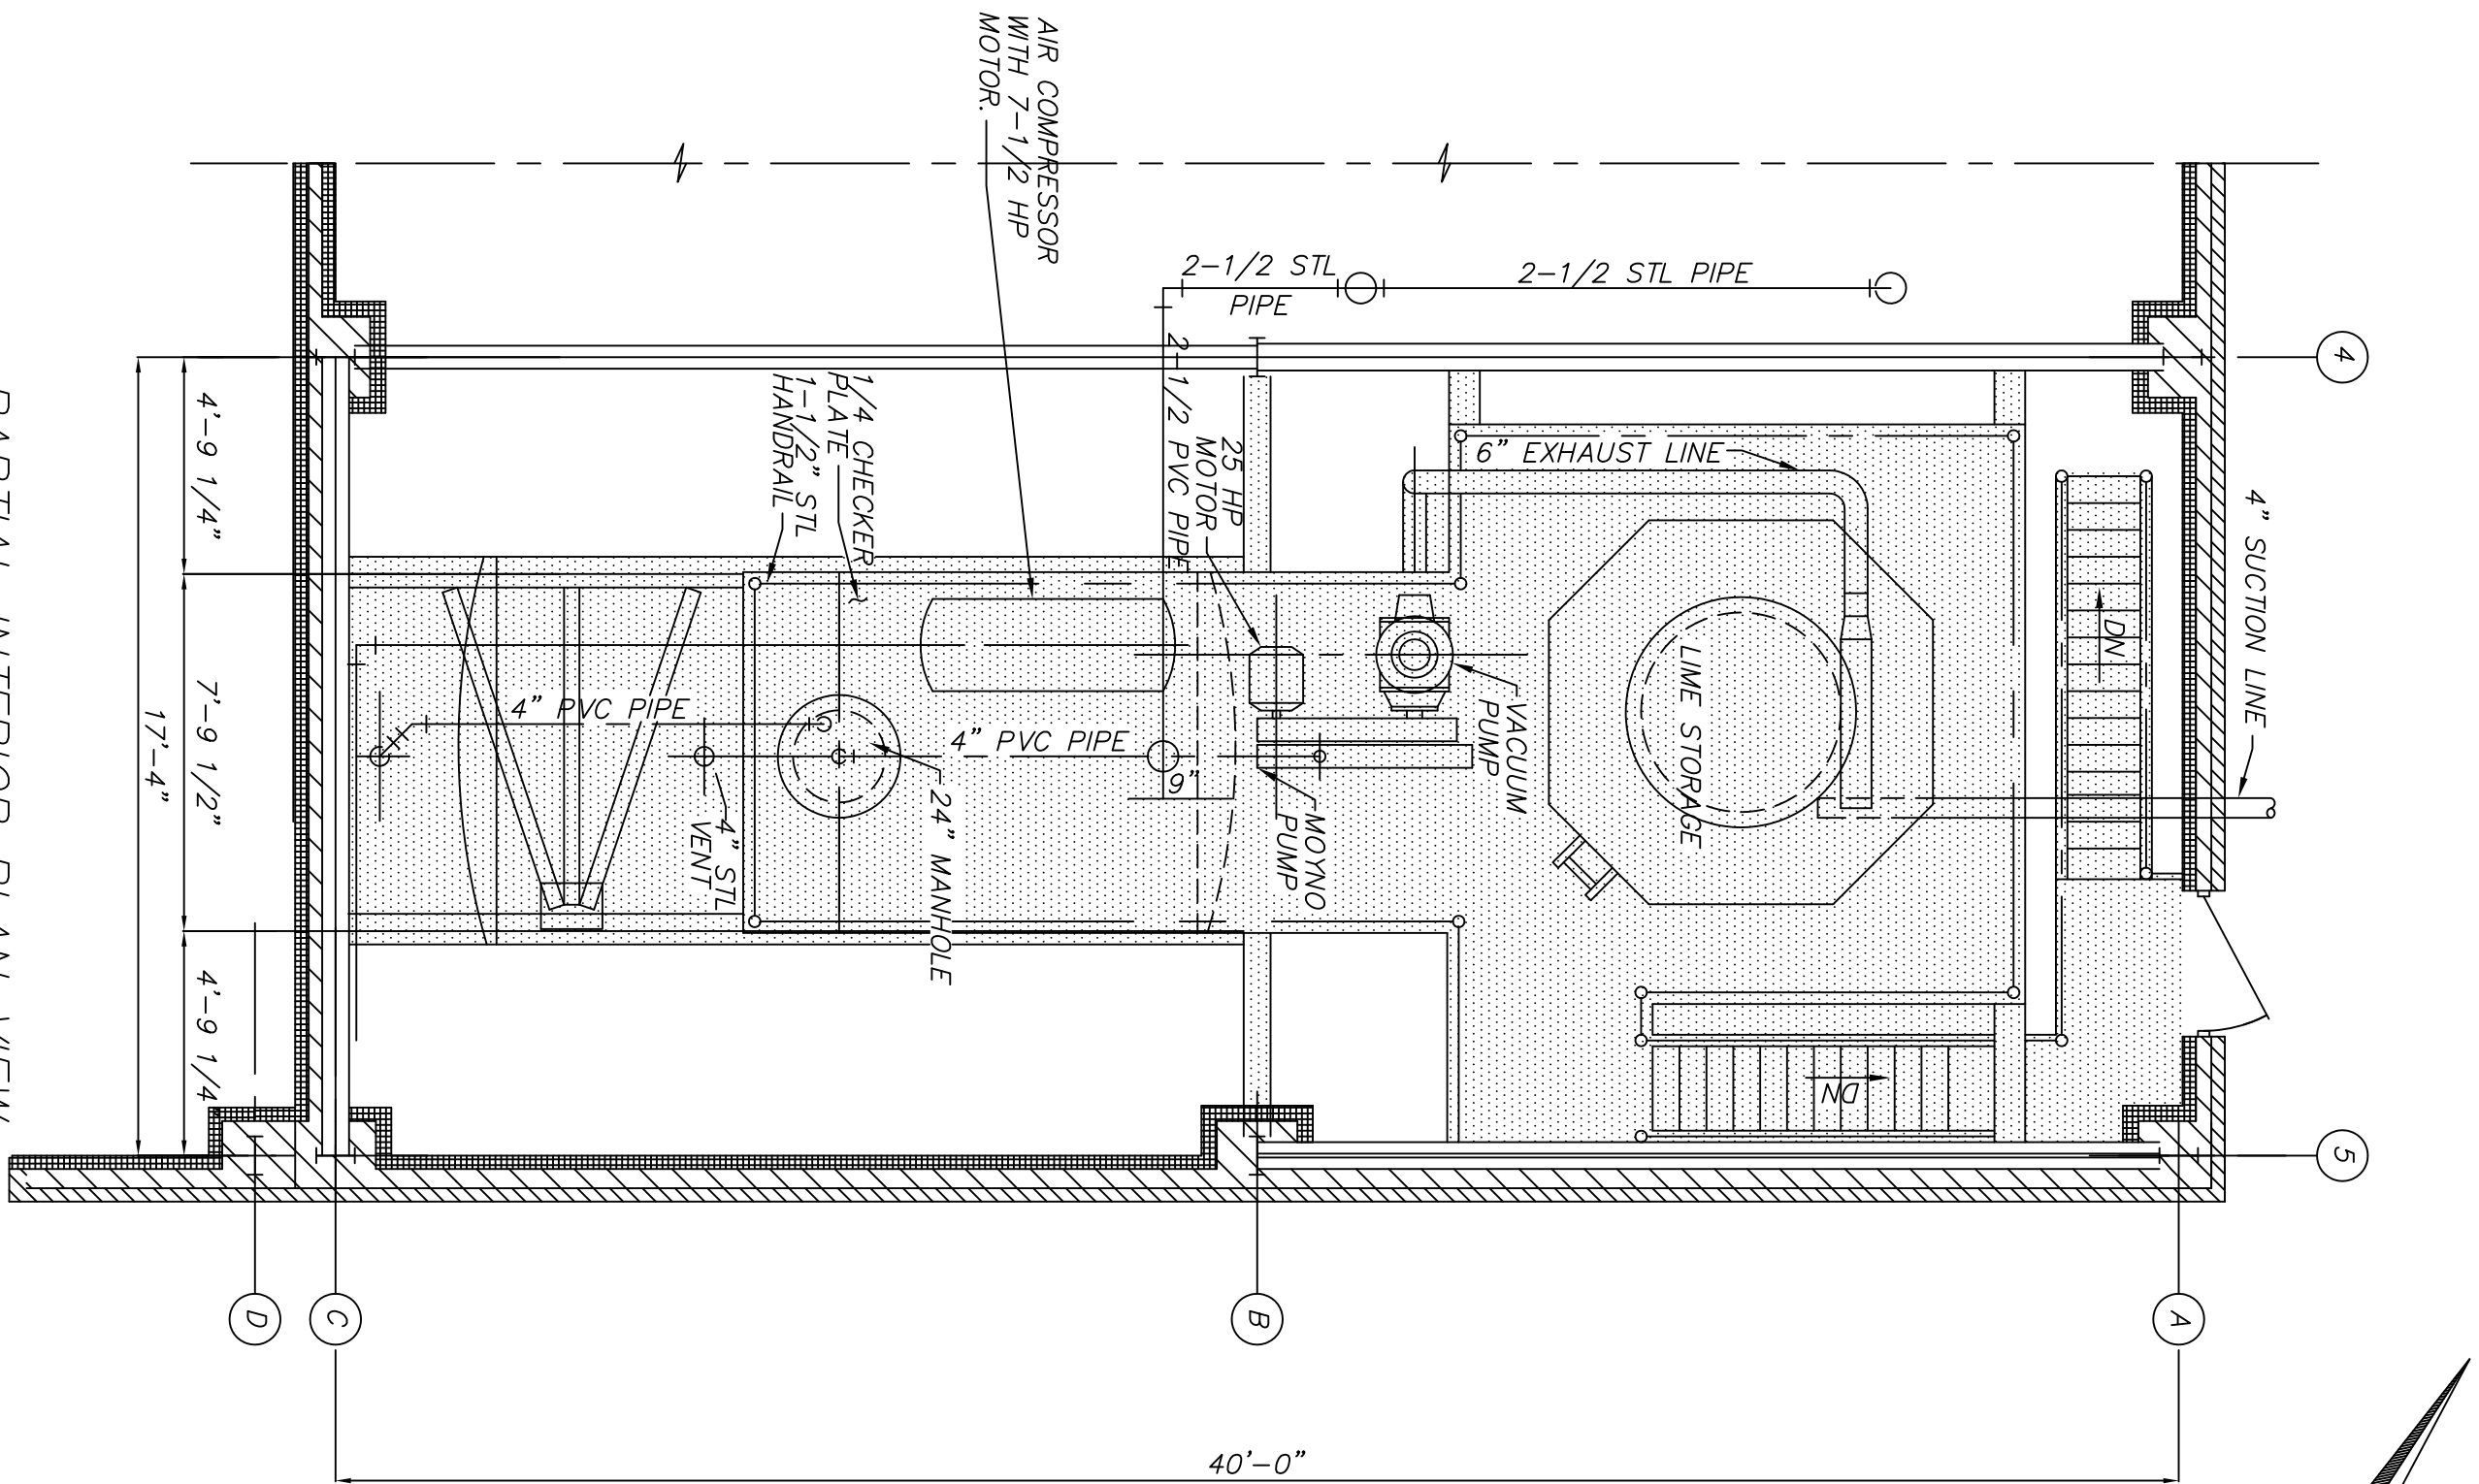

PARTIAL INTERIOR PLAN VIEW
PENTHOUSE AREA

SCALE: 1/4"=1'-0"

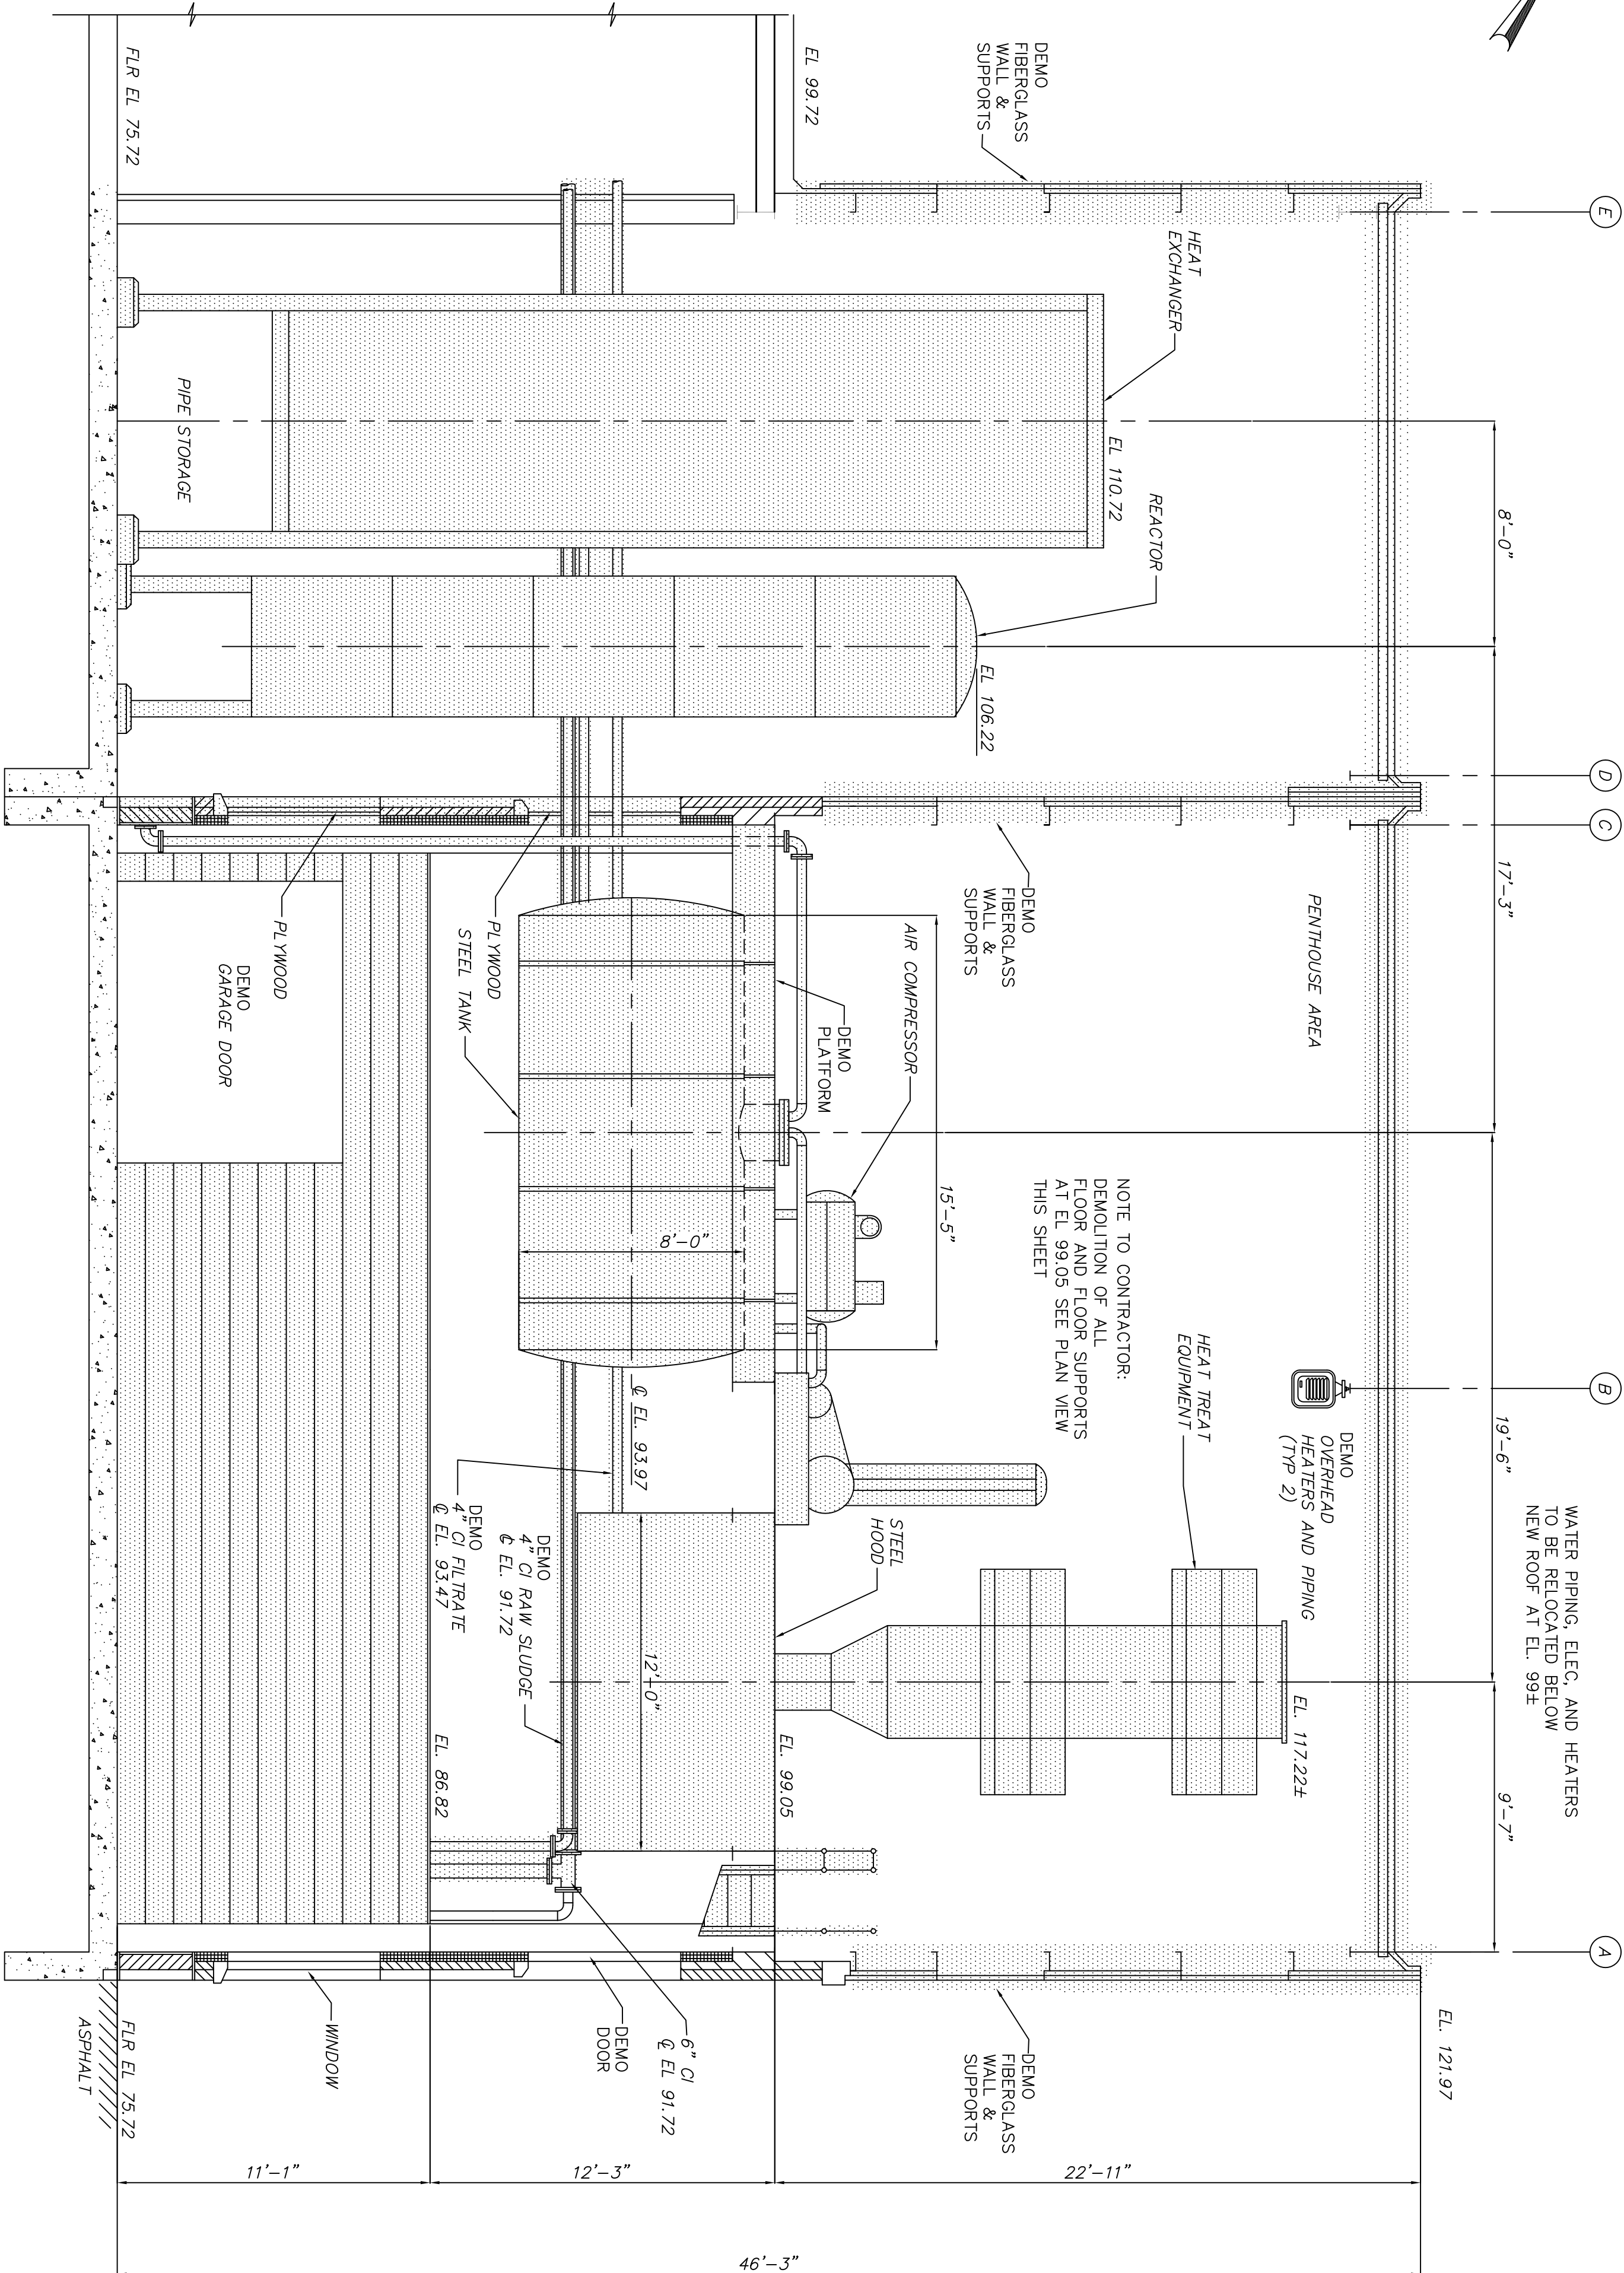

SECTION
SCALE : 1/4"=1'-0" A
P84

ITEMS FOR DEMOLITION

THESE RECORD DOCUMENTS HAVE BEEN PREPARED
BASED ON INFORMATION PROVIDED BY OTHERS. CTI
ENVIRONMENTAL HAS REVIEWED THE INFORMATION
SUBMITTED AND BELIEVES IT REFLECTS THE WORK AS
CONSTRUCTED. HOWEVER, ALL PERSONS SHALL
VERIFY INFORMATION TAKEN FROM THIS DRAWING.



ENVIRONMENTAL, INC.
ENGINEERS IN WATER AND EARTH SCIENCES
UNIONTOWN, OHIO

CITY OF MASSILLON, OHIO
WWTP UPGRADE 2000
SOLIDS HANDLING FACILITIES – DEMOLITION PLAN AND SECTION

DESIGNED BY	REVISIONS				
	NO.	DESCRIPTIONS	DATE	BY	APP'D
TMK	1	RECORD DRAWING	4/05	MGW	WAD
DRAWN BY					
SAT					
CHECKED BY					
RWR					
APPROVED BY					
WAD					

THIS DRAWING IS AN INSTRUMENT OF SERVICE OWNED
BY CTI ENVIRONMENTAL, INC. WHICH SHALL BE DEEMED
THE AUTHOR AND WHICH SHALL RETAIN ALL STATUTORY
AND COMMON LAW RIGHTS, INCLUDING COPYRIGHTS.
THIS DRAWING SHALL NOT BE SCANNED, COPIED, OR
DISTRIBUTED TO OTHERS IN ANY FORM OR USED FOR
ANY OTHER PURPOSE OR PROJECT WITHOUT PRIOR
WRITTEN CONSENT OF CTI ENVIRONMENTAL, INC.
CTI ENVIRONMENTAL, INC. CANNOT GUARANTEE THAT
ELECTRONIC COPIES OF THIS DRAWING ARE EXACT
DUPLICATES OF THE SEALED ORIGINAL DRAWING.
IN THE EVENT OF A CONFLICT BETWEEN AN ELECTRONIC
COPY AND THE SEALED ORIGINAL, THE SEALED ORIGINAL
SHALL GOVERN.

JOB NO.

E9031

DATE

08/13/01

SCALE

AS NOTED

SHEET

P86

E:/E9031/9031SHF3.DWG