


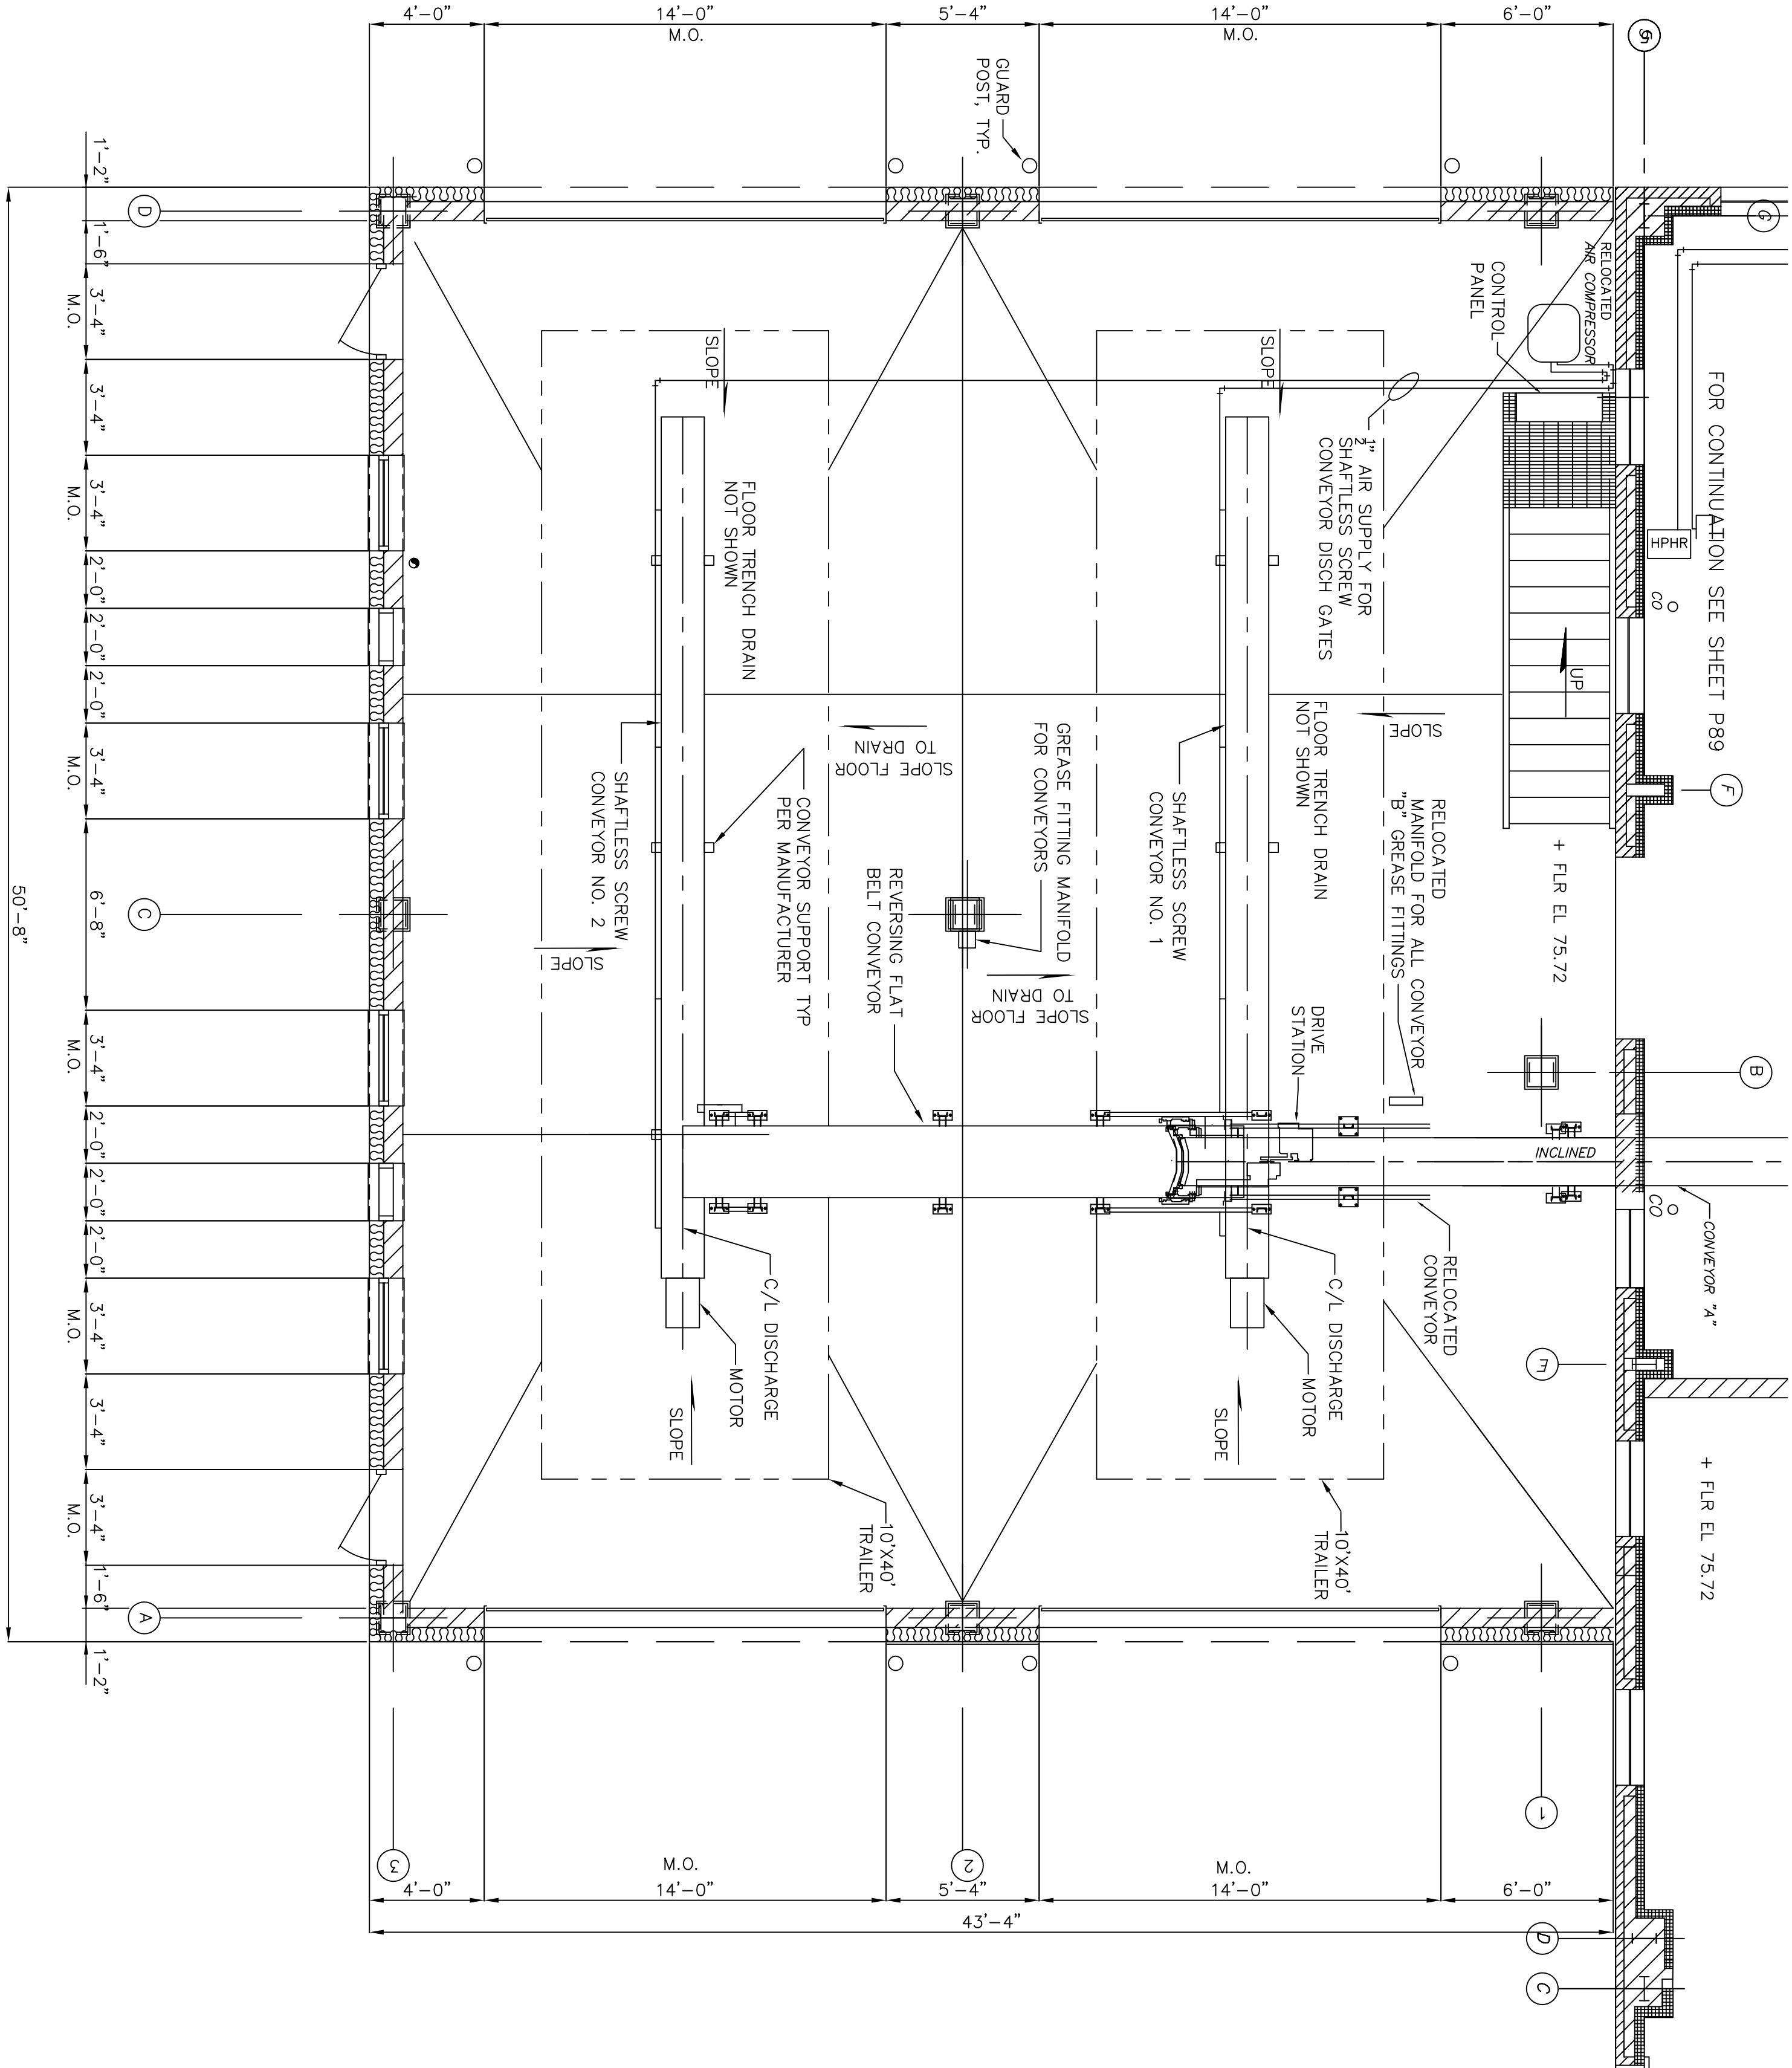

INTERIOR PLAN VIEW
SCALE: 1/4" = 1'-0"

- NOTES TO CONTRACTOR
1. VERTICAL SUPPORTS SHALL BE PROVIDED BY CONVEYOR MANUFACTURE. THE SUPPORTS SHALL BE ATTACHED TO THE CEILING.
 2. BOTH ENDS OF THE SCREW CONVEYORS ARE OPEN, WITH TWO PNEUMATIC SLIDE GATES EQUALLY SPACED ON EACH CONVEYOR. THE OPENING SIZE FOR EACH SLIDE GATE SHALL BE MIN 16"x12 5/8".
 3. THE DISCHARGE POINT OF THE HORIZONTAL BELT CONVEYOR SHALL BE APPROXIMATELY 2 FEET FROM THE END OF EITHER SHAFTLESS SCREW CONVEYOR.

THIS DRAWING IS AN INSTRUMENT OF SERVICE OWNED BY CTI ENVIRONMENTAL, INC. WHICH SHALL BE DEEMED THE AUTHOR AND WHICH SHALL RETAIN ALL STATUTORY AND COMMON LAW RIGHTS, INCLUDING COPYRIGHTS. THIS DRAWING SHALL NOT BE SCANNED, COPIED, OR DISTRIBUTED TO OTHERS IN ANY FORM OR USED FOR ANY OTHER PURPOSE OR PROJECT WITHOUT PRIOR WRITTEN CONSENT OF CTI ENVIRONMENTAL, INC. CTI ENVIRONMENTAL, INC. CANNOT GUARANTEE THAT ELECTRONIC COPIES OF THIS DRAWING ARE EXACT DUPLICATES OF THE SEALED ORIGINAL DRAWING. IN THE EVENT OF A CONFLICT BETWEEN AN ELECTRONIC COPY AND THE SEALED ORIGINAL, THE SEALED ORIGINAL SHALL GOVERN.

REVISIONS					
NO.	DESCRIPTIONS	DATE	BY	APP'D	
1	RECORD DRAWING	4/05	MGW	WAD	

DESIGNED BY TMK/AJP	CHECKED BY RWR	APPROVED BY WAD
DRAWN BY SAT/AJP		



ENVIRONMENTAL, INC.
ENGINEERS IN WATER AND EARTH SCIENCES
UNIONTOWN, OHIO

CITY OF MASSILLON, OHIO
WWTP UPGRADE 2000
SOLIDS HANDLING FACILITIES – PLAN

THESE RECORD DOCUMENTS HAVE BEEN PREPARED BASED ON INFORMATION PROVIDED BY OTHERS. CTI ENVIRONMENTAL HAS REVIEWED THE INFORMATION SUBMITTED AND BELIEVES IT REFLECTS THE WORK AS CONSTRUCTED. HOWEVER, ALL PERSONS SHALL VERIFY INFORMATION TAKEN FROM THIS DRAWING.

JOB NO. E9031	DATE 08/13/01	SCALE AS NOTED	SHEET P91
------------------	------------------	-------------------	--------------