


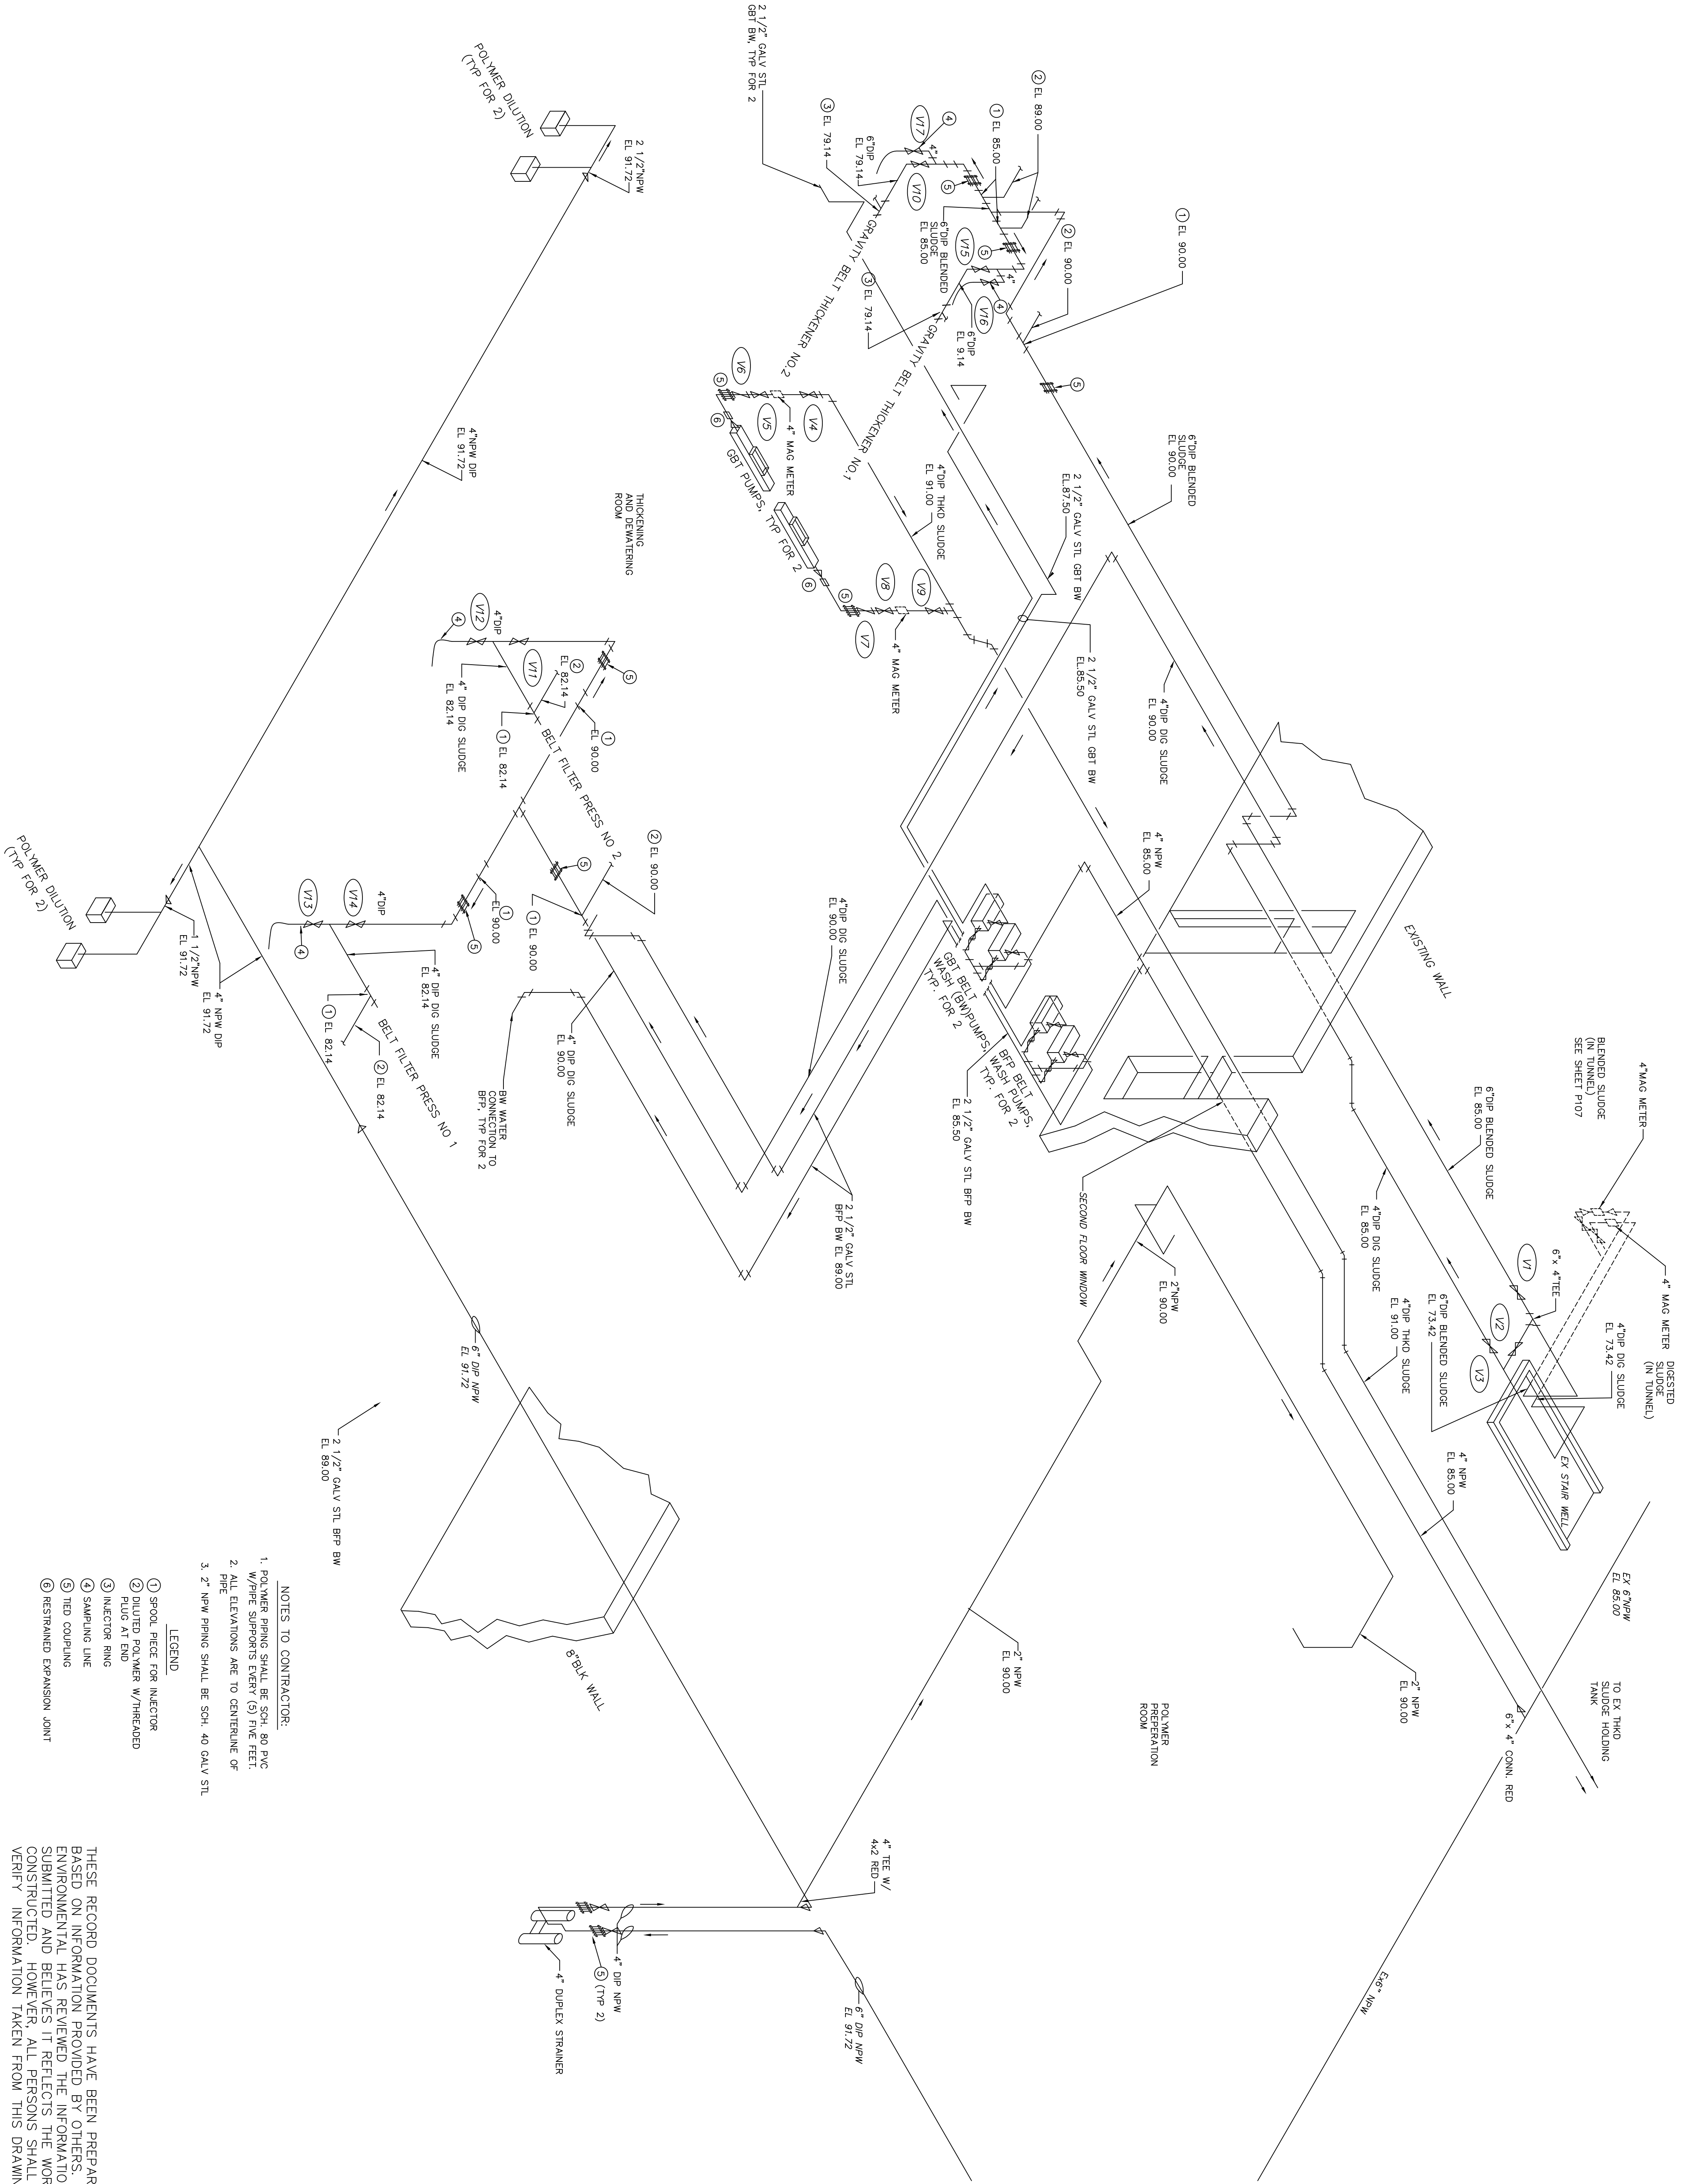

NOTES TO CONTRACTOR:

- POLYMER PIPING SHALL BE SCH. 80 PVC W/PIPE SUPPORTS EVERY (5) FIVE FEET.
- ALL ELEVATIONS ARE TO CENTERLINE OF PIPE
- 2" NPW PIPING SHALL BE SCH. 40 GALV STL

LEGEND

- 1. SPOOL PIECE FOR INJECTOR
- 2. DILUTED POLYMER W/THEADED PLUG AT END
- 3. INJECTOR RING
- 4. SAMPLING LINE
- 5. TIED COUPLING
- 6. RESTRAINED EXPANSION JOINT

THESE RECORD DOCUMENTS HAVE BEEN PREPARED BASED ON INFORMATION PROVIDED BY OTHERS. CITI ENVIRONMENTAL HAS REVIEWED THE INFORMATION SUBMITTED AND BELIEVES IT REFLECTS THE WORK AS CONSTRUCTED. HOWEVER, ALL PERSONS SHALL VERIFY INFORMATION TAKEN FROM THIS DRAWING.



ENVIRONMENTAL, INC.
ENGINEERS IN WATER AND EARTH SCIENCES
UNIONTOWN, OHIO

CITY OF MASSILLON, OHIO

WWTP UPGRADE 2000

SOLIDS HANDLING FACILITIES

SLUDGE AND PLANT WATER SCHEMATIC

DESIGNED BY
AJP

DRAWN BY
AJP

CHECKED BY
RWR

APPROVED BY
WAD

REVISIONS					
NO.	DESCRIPTIONS	DATE	BY	APP'D	
1	RECORD DRAWING	5/05	MGW	WAD	

THIS DRAWING IS AN INSTRUMENT OF SERVICE OWNED BY CITI ENVIRONMENTAL, INC. WHICH SHALL BE DEEMED BY THE AUTHOR AND WHICH SHALL RETAIN ALL STATUTORY AND COMMON LAW RIGHTS, INCLUDING COPYRIGHTS. THIS DRAWING SHALL NOT BE SCANNED, COPIED, OR DISTRIBUTED TO OTHERS IN ANY FORM OR USED FOR ANY OTHER PURPOSE OR PROJECT WITHOUT PRIOR WRITTEN CONSENT OF CITI ENVIRONMENTAL, INC. CITI ENVIRONMENTAL, INC. CANNOT GUARANTEE THAT ELECTRONIC COPIES OF THIS DRAWING ARE EXACT DUPLICATES OF THE SEALED ORIGINAL DRAWING. IN THE EVENT OF A CONFLICT BETWEEN AN ELECTRONIC COPY AND THE SEALED ORIGINAL, THE SEALED ORIGINAL SHALL GOVERN.