
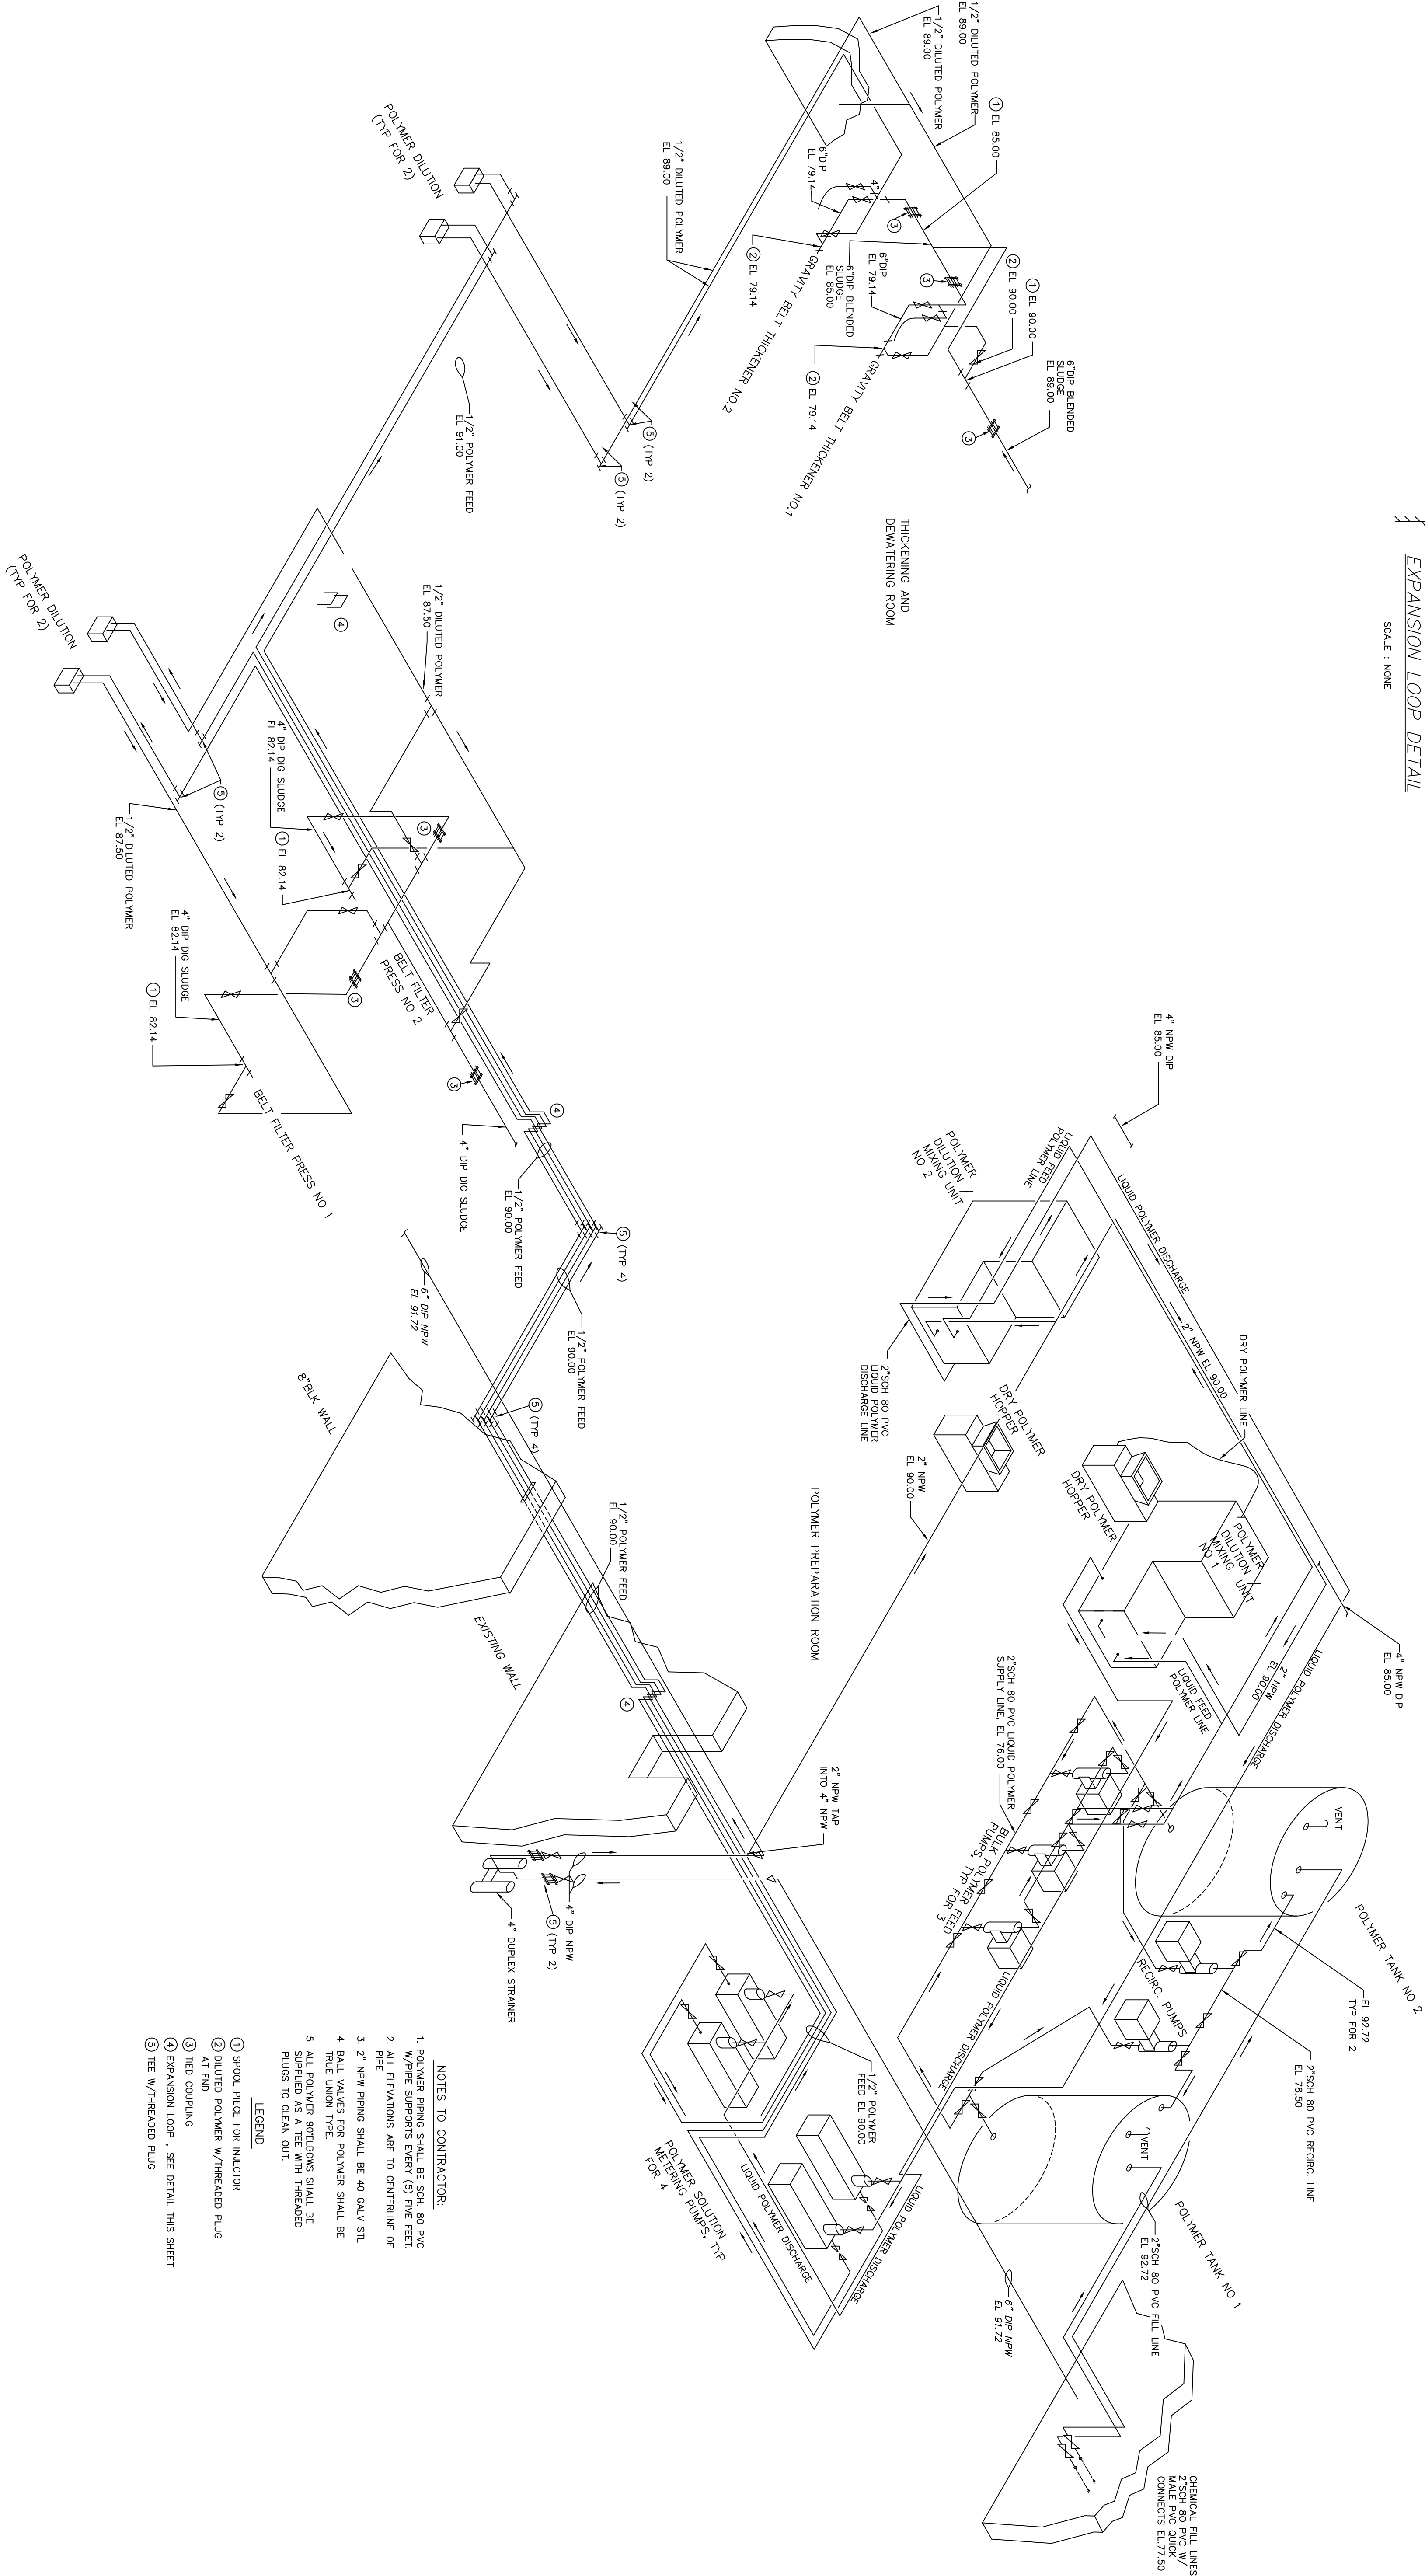


SOLIDS HANDLING BUILDING
HIGH PRESSURE WASH SCHEMATIC

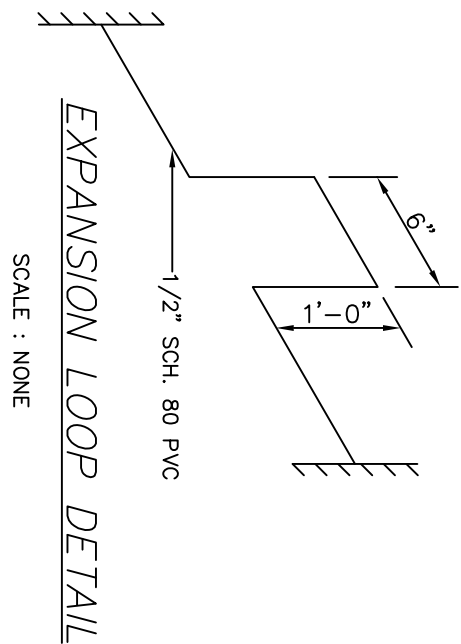

NOTES TO CONTRACTOR:

1. POLYMER PIPING SHALL BE SCH. 80 PVC W/PIPE SUPPORTS EVERY (6) FIVE FEET.
2. ALL ELEVATIONS ARE TO CENTERLINE OF PIPE.
3. 2" NFW PIPING SHALL BE 40 GALV STL.
4. BALL VALVES FOR POLYMER SHALL BE TRUE UNION TYPE.
5. ALL POLYMER BOTTLERONS SHALL BE SUPPLIED AS A TEE WITH THREADED PLUGS TO CLEAN OUT.

LEGEND

- ① SPOOL PIECE FOR INJECTOR
- ② DILUTED POLYMER W/THREADED PLUG AT END
- ③ TIED COUPLING
- ④ EXPANSION LOOP - SEE DETAIL THIS SHEET
- ⑤ TEE W/THREADED PLUG



ENVIRONMENTAL, INC.
ENGINEERS IN WATER AND EARTH SCIENCES
UNIONTOWN, OHIO

CITY OF MASSILLON, OHIO
WWTP UPGRADE 2000
SOLIDS HANDLING FACILITIES – POLYMER SCHEMATIC

DESIGNED BY AJP/TMK	REVISIONS				
	NO.	DESCRIPTIONS	DATE	BY	APP'D
DRAWN BY AJP	1	RECORD DRAWING	5/05	MGW	WAD
CHECKED BY RWR					
APPROVED BY RWR					

THIS DRAWING IS AN INSTRUMENT OF SERVICE OWNED BY CTI ENVIRONMENTAL, INC. WHICH SHALL BE DEEMED THE AUTHOR AND WHICH SHALL RETAIN ALL STATUTORY AND COMMON LAW RIGHTS, INCLUDING COPYRIGHTS. THIS DRAWING SHALL NOT BE SCANNED, COPIED, OR DISTRIBUTED TO OTHERS IN ANY FORM OR USED FOR ANY OTHER PURPOSE OR PROJECT WITHOUT PRIOR WRITTEN CONSENT OF CTI ENVIRONMENTAL, INC. CTI ENVIRONMENTAL, INC. CANNOT GUARANTEE THAT ELECTRONIC COPIES OF THIS DRAWING ARE EXACT DUPLICATES OF THE SEALED ORIGINAL DRAWING. IN THE EVENT OF A CONFLICT BETWEEN AN ELECTRONIC COPY AND THE SEALED ORIGINAL, THE SEALED ORIGINAL SHALL GOVERN.

THESE RECORD DOCUMENTS HAVE BEEN PREPARED BASED ON INFORMATION PROVIDED BY OTHERS. CTI ENVIRONMENTAL HAS REVIEWED THE INFORMATION SUBMITTED AND BELIEVES IT REFLECTS THE WORK AS CONSTRUCTED. HOWEVER, ALL PERSONS SHALL VERIFY INFORMATION TAKEN FROM THIS DRAWING.

SHEET
P97

SCALE
NONE

DATE
08/13/01

JOB NO.
E9031