

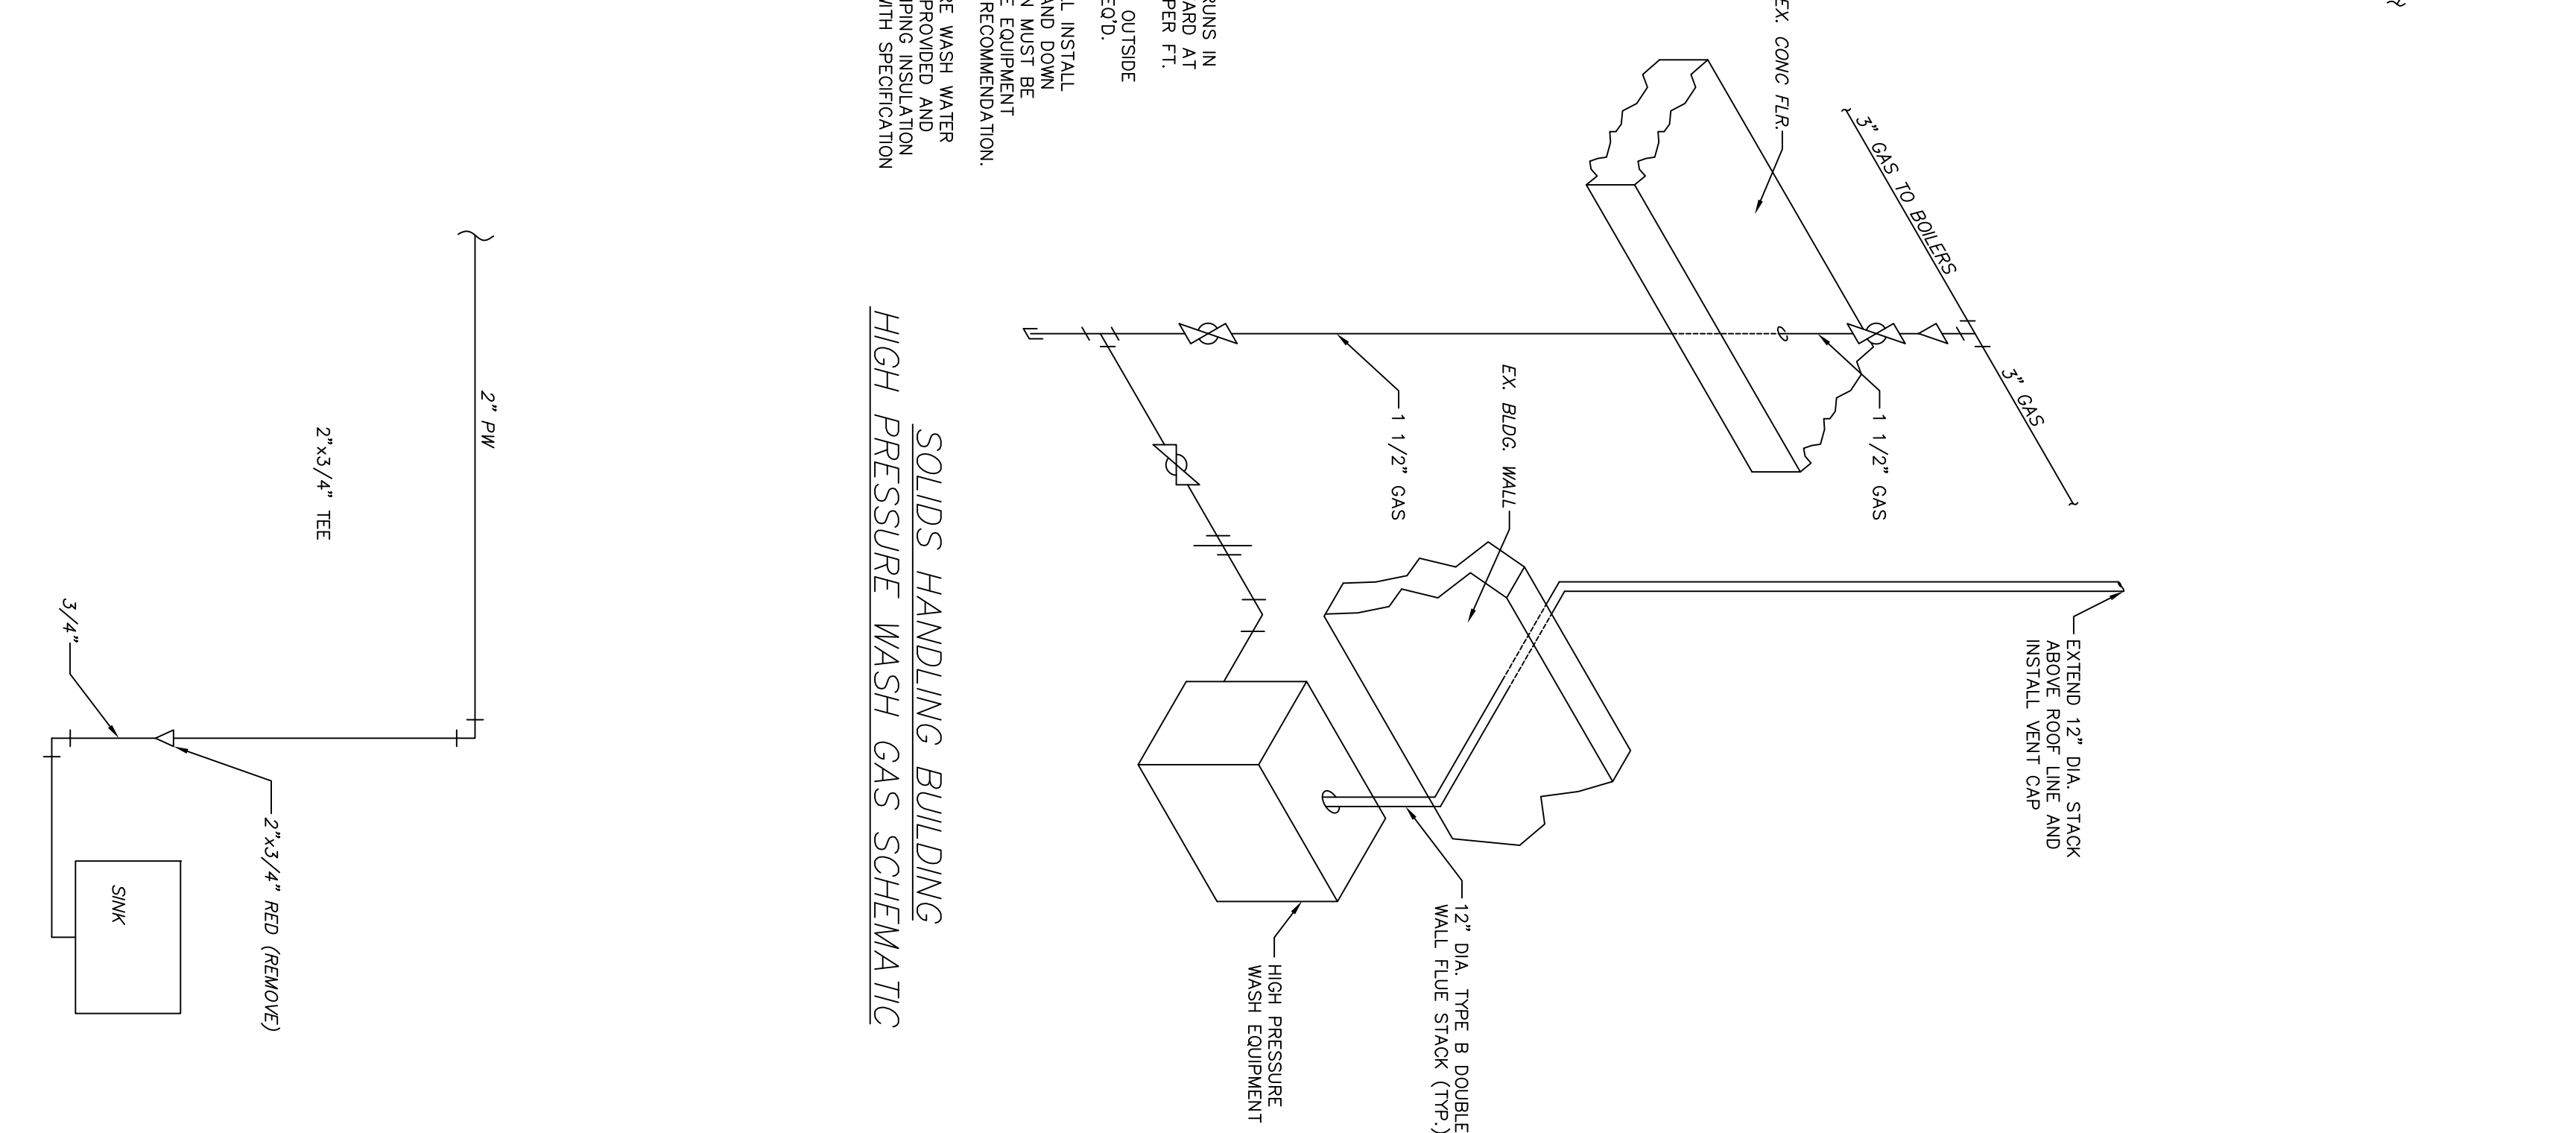
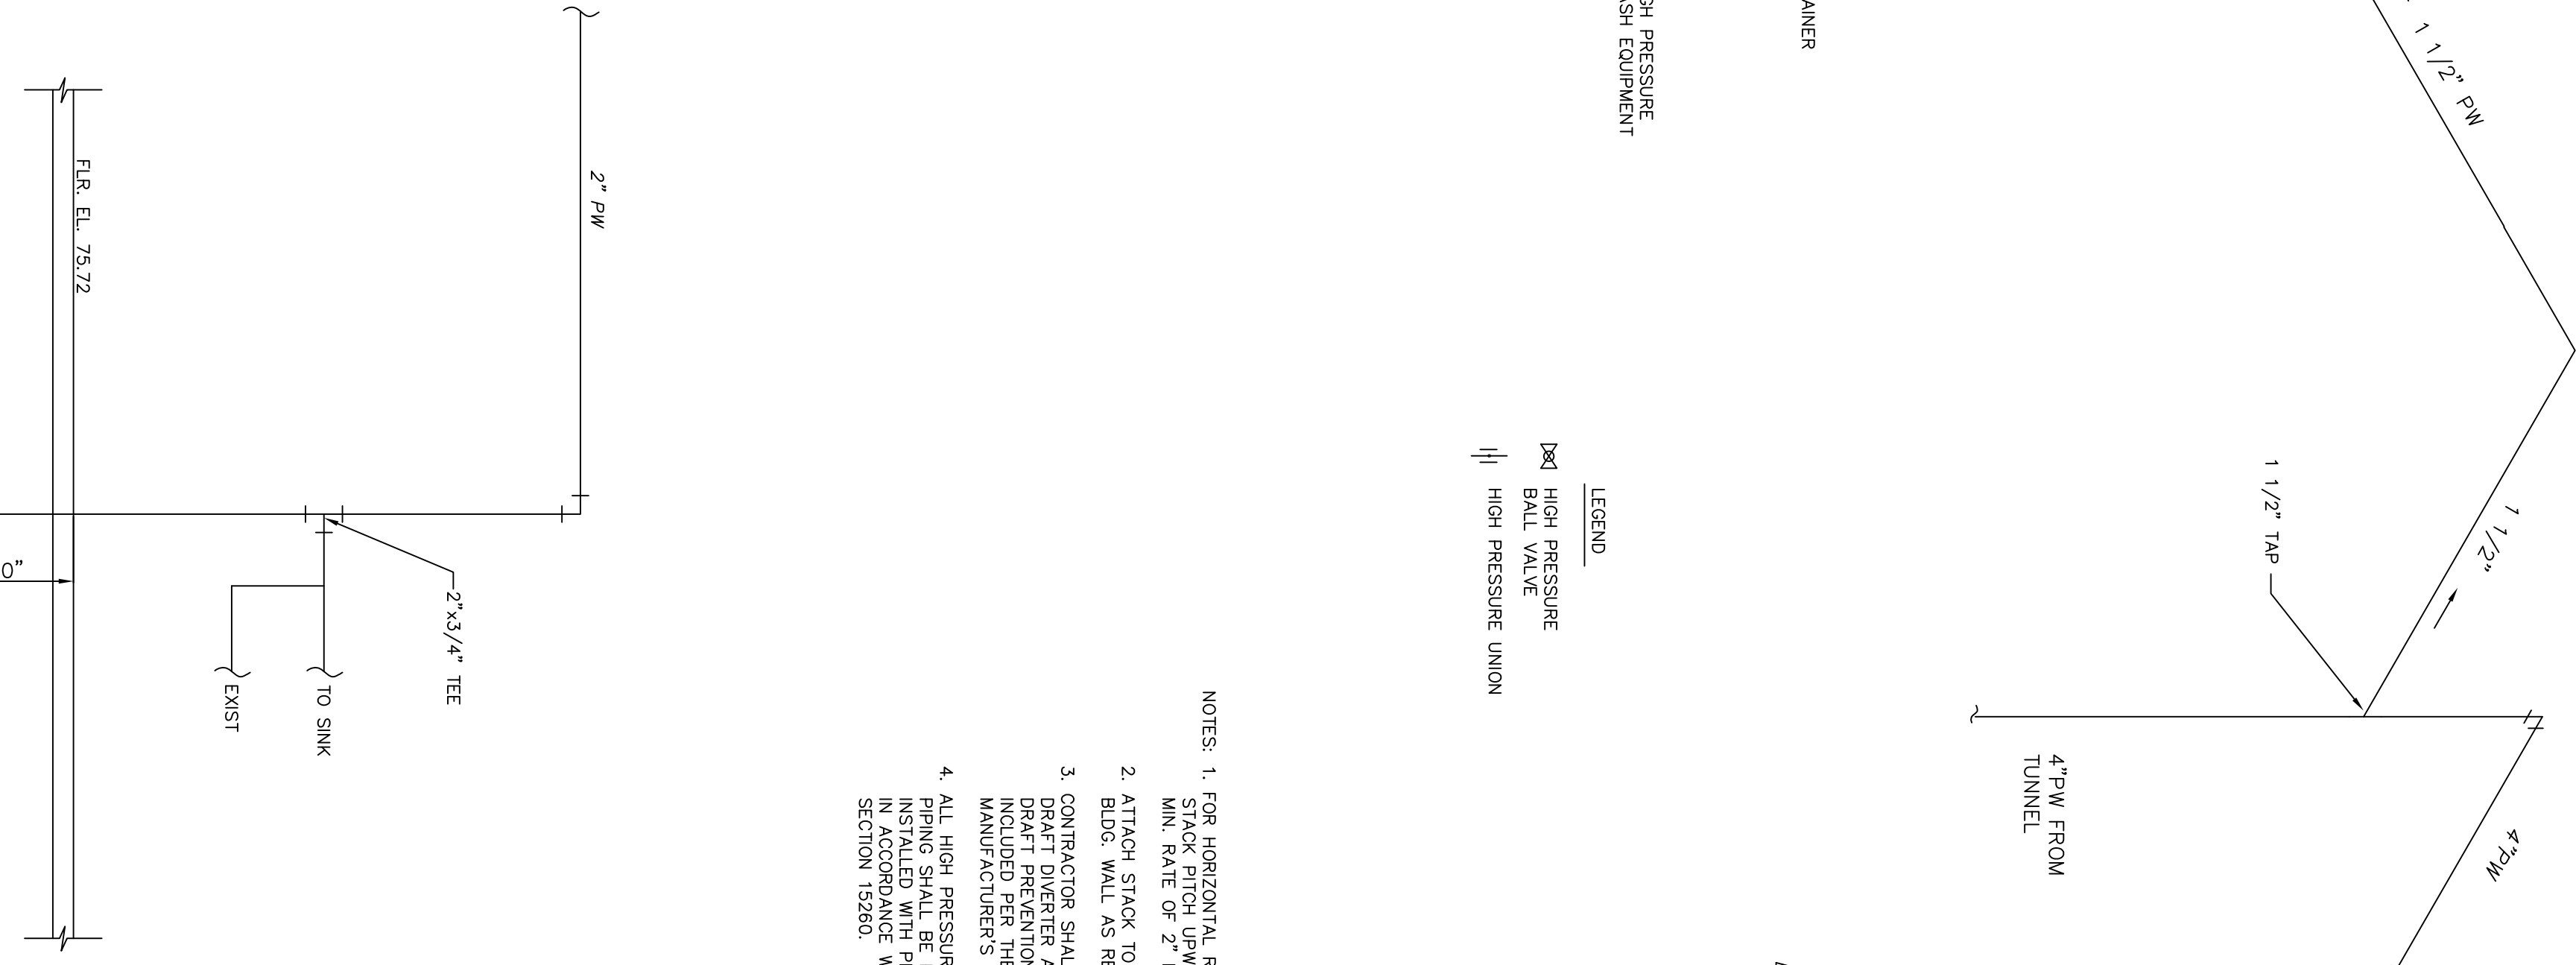


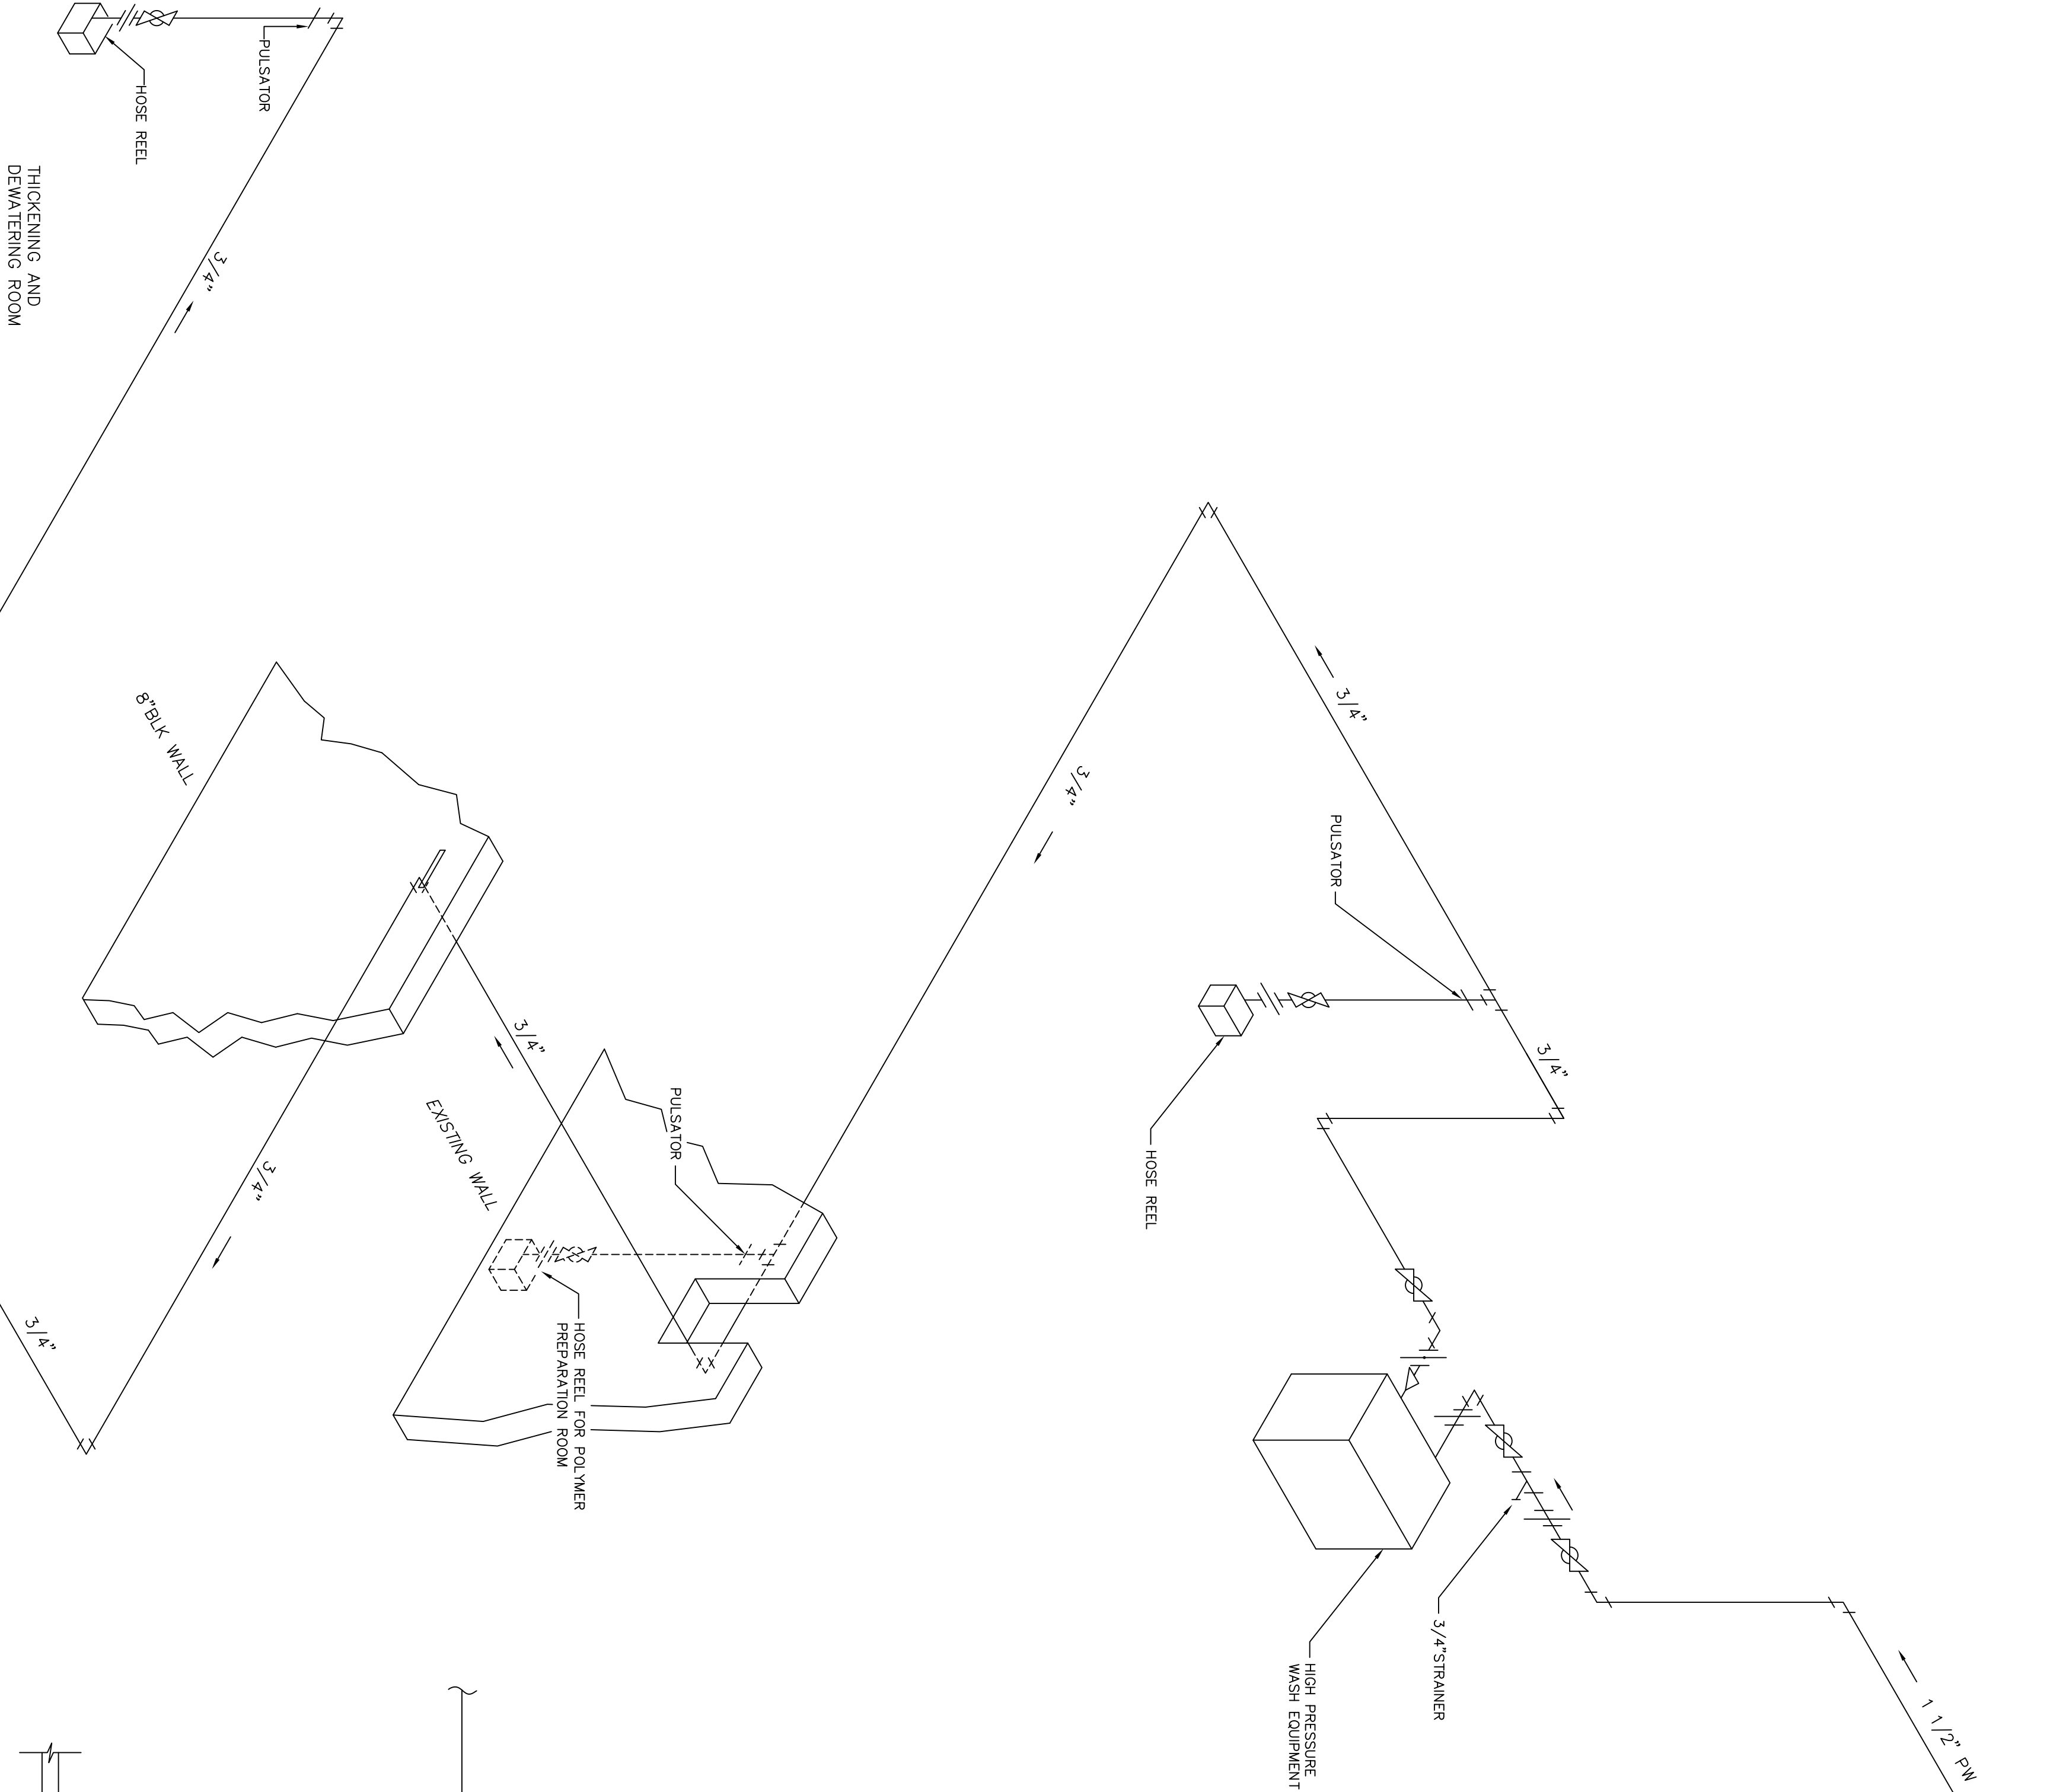

- NOTES:
1. FOR HORIZONTAL RUNS IN STACK RICH UPWARD AT MIN. RATE OF 2' PER FT.
 2. ATTACH STACK TO OUTSIDE BLDG. WALL AS REQ'D.
 3. CONTRACTOR SHALL INSTALL DRAFT DIVERTER AND DOWN DRAFT DIVERTER MUST BE INSTALLED PER THE EQUIPMENT MANUFACTURER'S RECOMMENDATION.
 4. ALL HIGH PRESSURE WASH WATER SHALL BE INSTALLED IN ACCORDANCE WITH SPECIFICATION SECTION 15260.

SOLIDS HANDLING BUILDING
HIGH PRESSURE WASH GAS SCHEMATIC

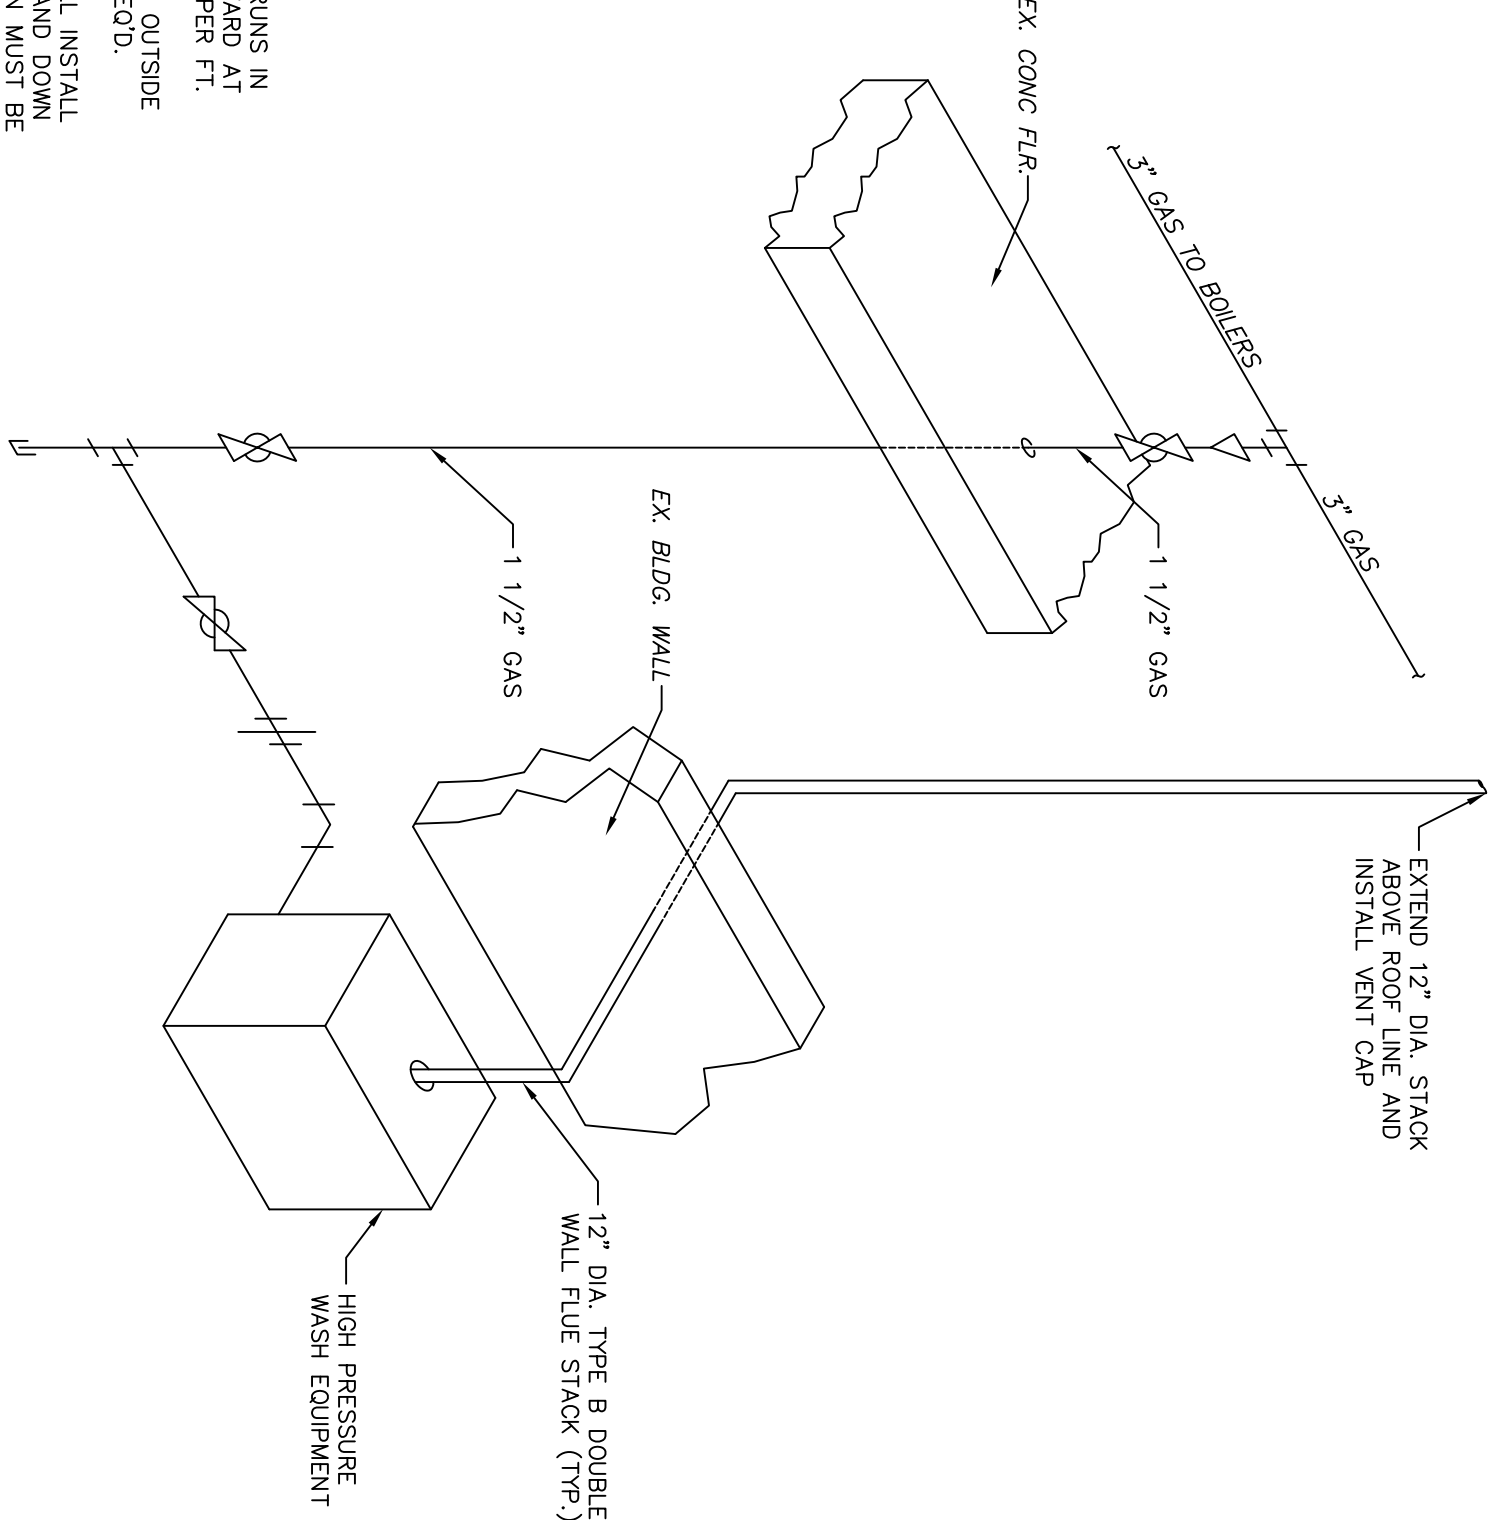

THIS DRAWING IS AN INSTRUMENT OF SERVICE OWNED BY CTI ENVIRONMENTAL, INC. WHICH SHALL BE DEEMED THE AUTHOR AND WHICH SHALL RETAIN ALL STATUTORY AND COMMON LAW RIGHTS, INCLUDING COPYRIGHTS. THIS DRAWING SHALL NOT BE SCANNED, COPIED, OR DISTRIBUTED TO OTHERS IN ANY FORM OR USED FOR ANY OTHER PURPOSE OR PROJECT WITHOUT PRIOR WRITTEN CONSENT OF CTI ENVIRONMENTAL, INC. CTI ENVIRONMENTAL, INC. CANNOT GUARANTEE THAT ELECTRONIC COPIES OF THIS DRAWING ARE EXACT DUPLICATES OF THE SEALED ORIGINAL DRAWING. IN THE EVENT OF A CONFLICT BETWEEN AN ELECTRONIC COPY AND THE SEALED ORIGINAL, THE SEALED ORIGINAL SHALL GOVERN.



ENVIRONMENTAL, INC.
ENGINEERS IN WATER AND EARTH SCIENCES
UNIONTOWN, OHIO

CITY OF MASSILLON, OHIO
WWTP UPGRADE 2000
SOLIDS HANDLING FACILITIES
HIGH PRESSURE WATER SCHEMATIC

DESIGNED BY	REVISIONS				
	NO.	DESCRIPTIONS	DATE	BY	APP'D
AJP/TMK	1	RECORD DRAWING	5/05	MGW	WAD
DRAWN BY					
AJP					
CHECKED BY					
RWR					
APPROVED BY					
WAD					

THESE RECORD DOCUMENTS HAVE BEEN PREPARED BASED ON INFORMATION PROVIDED BY OTHERS. CTI ENVIRONMENTAL HAS REVIEWED THE INFORMATION SUBMITTED AND BELIEVES IT REFLECTS THE WORK AS CONSTRUCTED. HOWEVER, ALL PERSONS SHALL VERIFY INFORMATION TAKEN FROM THIS DRAWING.

DETAIL 1
NTS

ELEVATION - PROPOSED

ELEVATION - DEMO

SOLIDS HANDLING BUILDING
HIGH PRESSURE WASH SCHEMATIC

JOB NO.	E9031
DATE	08/13/01
SCALE	NONE
SHEET	P98