

Project Information

Project Name	Project Number	Date:
D:\IT Projects\massillon_storm\massillon_stor m.db		10/29/2025 11:29:02 AM

Contractor:	
Responsible:	
Department:	
Street:	
City:	
Telephone:	
Fax:	
Mobile:	
Email:	

Notes:




Defect Listing Plot With Images

Pipe Segment Reference SWG40278	City* Massillon	Street* SR 21	Material* Concrete Segments (unbolted)		Location Code	Pipe Use Stormwater
Upstream MH* Ernies out fall	Total Length	Year Constructed	Shape* Circular		Location Details	
Length surveyed 354		Year Renewed	Height* 36	Width	Pipe Joint	

SPR 0	MPR 0	PO Number		Customer		
SPRI 0	MPRI 0	Work Order Number		Purpose		
QSR 0000	QMR 0000					
OPR 0	Surveyed By* Operator	Direction* Upstream	Date* 4/10/2026 9:13:54 AM		Media label	
OPRI 0	Certificate Number* 0	Pre-Cleaning Not Known	Time 4/10/2026 9:14:45 AM		Weather	
Date Cleaned			End Time 4/10/2026 9:39:53 AM		Additional Info	

- 0 ft Access Point Manhole
- 0 ft Miscellaneous Water Level
- 354 ft Access Point Manhole

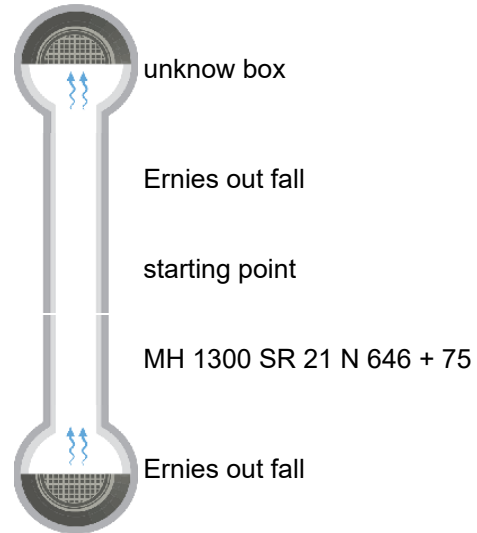


*Indicates required field

Defect Listing Plot

Pipe Segment Reference SWG40278	City* Massillon	Street* SR 21	Material* Concrete Segments (unbolted)		Location Code	Pipe Use Stormwater
Upstream MH* Ernies out fall	Total Length	Year Constructed	Shape* Circular		Location Details	
Length surveyed 354		Year Renewed	Height* 36	Width	Pipe Joint	

SPR 0	MPR 0	PO Number		Customer		
SPRI 0	MPRI 0	Work Order Number		Purpose		
QSR 0000	QMR 0000					
OPR 0	Surveyed By* Operator	Direction* Upstream	Date* 4/10/2026 9:13:54 AM		Media label	
OPRI 0	Certificate Number* 0	Pre-Cleaning Not Known	Time 4/10/2026 9:14:45 AM		Weather	
Date Cleaned			End Time 4/10/2026 9:39:53 AM		Additional Info	

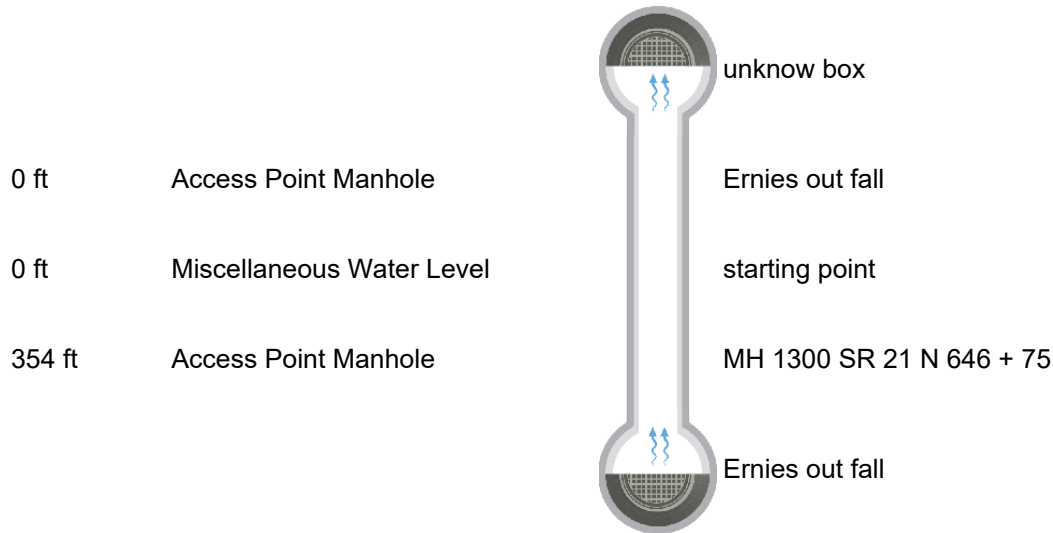

*Indicates required field



Defect Listing

Pipe Segment Reference SWG40278	City* Massillon	Street* SR 21	Material* Concrete Segments (unbolted)	Location Code	Pipe Use Stormwater
Upstream MH* Ernies out fall	Total Length	Year Constructed	Shape* Circular	Location Details	
Length surveyed 354		Year Renewed	Height* 36	Width	Pipe Joint

SPR	0	MPR	0	PO Number	Customer
SPRI	0	MPRI	0	Work Order Number	Purpose
QSR	0000	QMR	0000		
OPR	0	Surveyed By* Operator	Direction* Upstream	Date* 4/10/2026 9:13:54 AM	Media label
OPRI	0	Certificate Number* 0	Pre-Cleaning Not Known	Time 4/10/2026 9:14:45 AM	Weather
Date Cleaned				End Time 4/10/2026 9:39:53 AM	Additional Info

Distance	Condition	Cont. Dfct.	Values			Joint	Clock Position		Grade
			1st	2nd	%		At/From	To	
0	Access Point Manhole					<input type="checkbox"/>			
Remarks: Ernies out fall									
0	Miscellaneous Water Level				5	<input type="checkbox"/>			
Remarks: starting point									
354	Access Point Manhole					<input type="checkbox"/>			
Remarks: MH 1300 SR 21 N 646 + 75									

*Indicates required field