

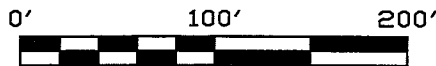


SANITARY SEWER AS-BUILT

LOCATED IN SOUTHEAST QUARTER, SECTION 29
AND SOUTHWEST QUARTER, SECTION 28
PERRY TOWNSHIP (T-10, R-9)
AND OUTLOT 569 & 595
CITY OF MASSILLON
STARK COUNTY, OHIO

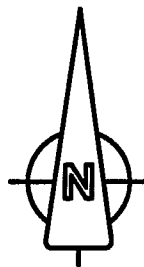

SCALE: 1" = 100'
AUGUST, 2008

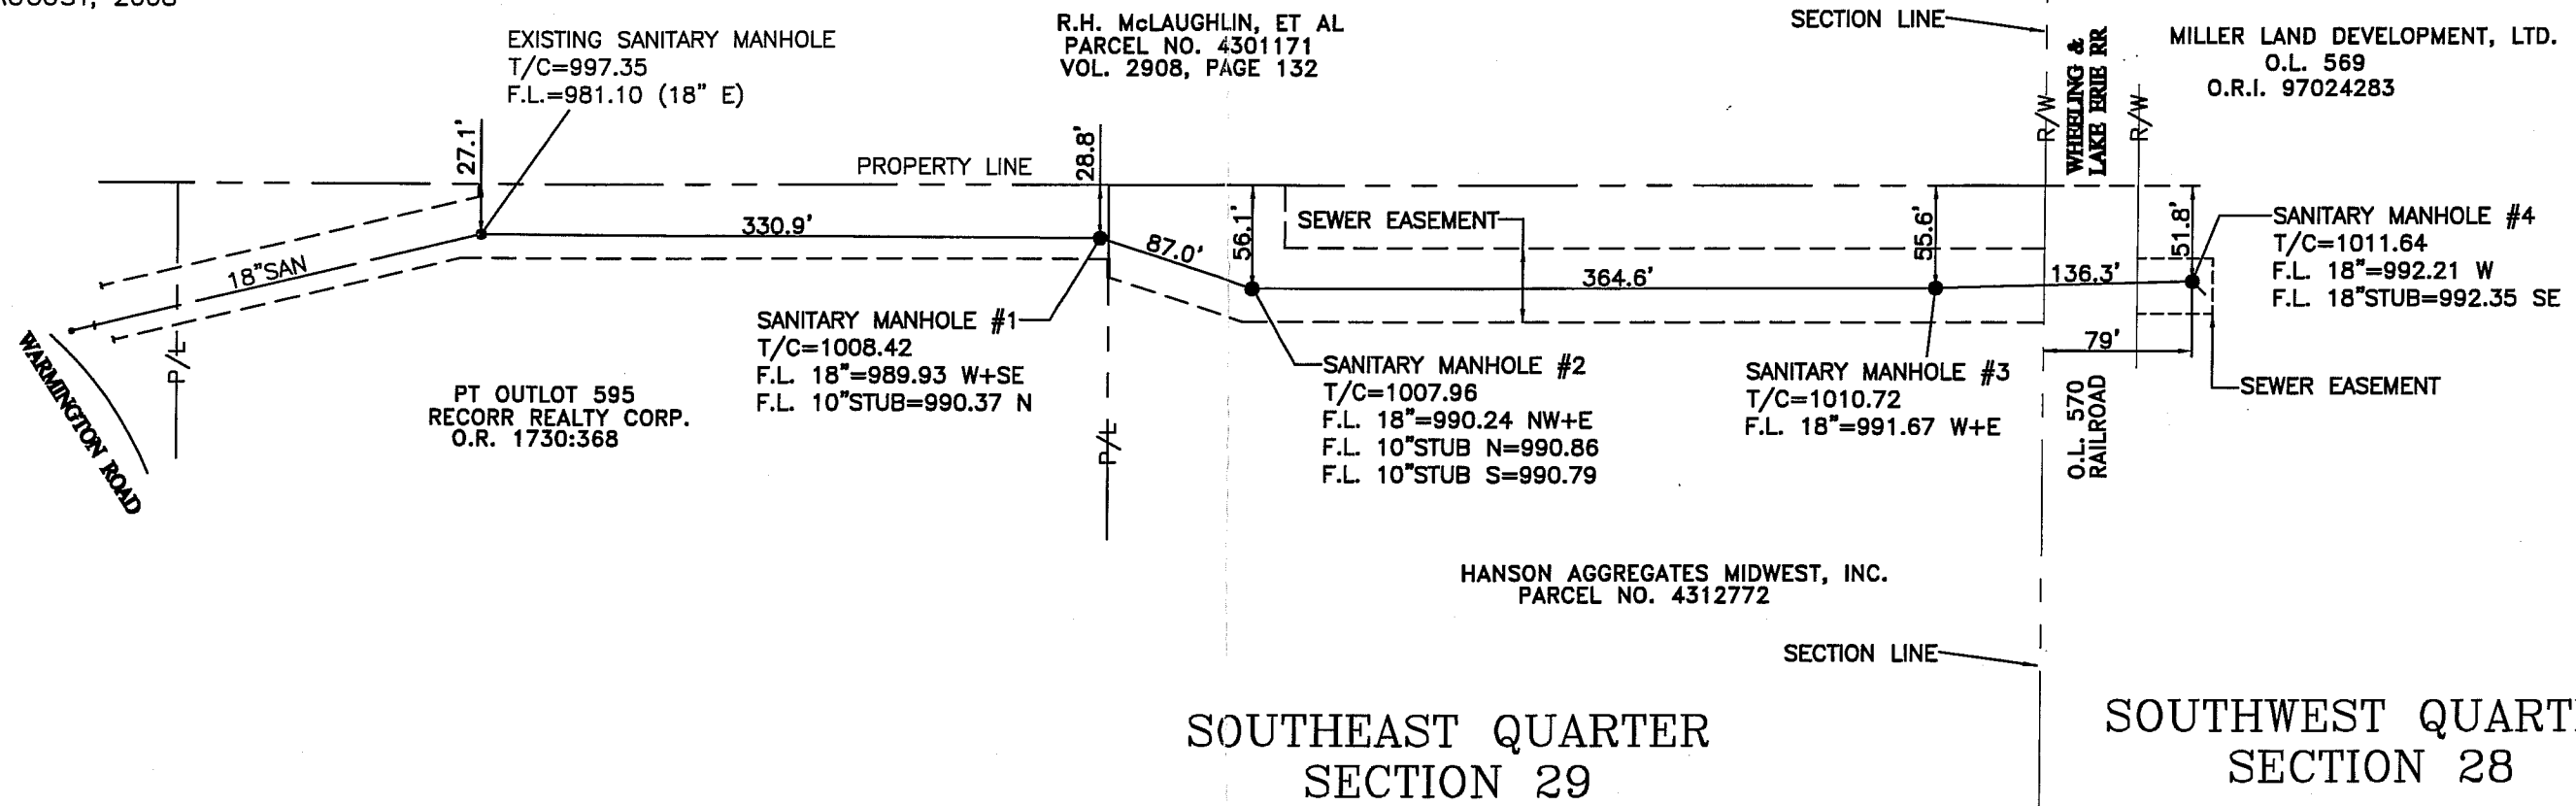

SOUTHEAST QUARTER
SECTION 29

SOUTHWEST QUARTER
SECTION 28

[Signature]
ROBERT L. AKINS
REGISTERED LAND SURVEYOR #6331
776 N. UNION AVE.
ALLIANCE, OH 44601
PHONE: (330) 821-4602 FAX: (330) 821-1600

8-14-08

