

CITY OF MASSILLON
CITY ENGINEER DEPARTMENT
STARK COUNTY, OHIO
NEOCOM SANITARY SEWER INTERCEPTOR

PROJECT DESCRIPTION

NEW 18" SANITARY SEWER ALONG THE SOUTH SIDE
OF OUTLOT 1054.

CONVENTIONAL SIGNS

RIGHT OF WAY . . . EXISTING: _____, PROPOSED: _____
COUNTY LINE . . . _____
TOWNSHIP LINE . . . _____
CORPORATION LINE . . . _____
FENCE LINE . . . EXISTING: -x-x-, PROPOSED: -x-x-
GUARDRAIL . . . EXISTING: -o-o-, PROPOSED: -o-o-
MANHOLES . . . EXISTING: ○, PROPOSED: ●, REHABILITATED: ⊙
CATCH BASINS . . . EXISTING: □, PROPOSED: ■, REHABILITATED: ⊠
SIGNS 1-POST: ⊥, 2-POST: ⊥, 3-POST: ⊥
EXISTING POLES . . . POWER: ⌀, TELEPHONE ⌀, LIGHT ⌀, SPAN ⌀
PROPOSED POLES . . . POWER: ⌀, TELEPHONE ⌀, LIGHT ⌀, SPAN ⌀
EXIST. UTILITIES . . . VALVE: ♂, HYDRANT: ♂, METERS: ♂ / ♂, GUY: ♂

PERMIT TO INSTALL

SANITARY SEWER PERMIT TO INSTALL (P.T.I.) HAS BEEN
RECEIVED FROM THE OHIO ENVIROMENTAL PROTECTION AGENCY
THIS 28 DAY OF, OCTOBER, 2008.

PTI No. 676456




TWO WORKING DAYS
BEFORE YOU DIG
CALL 1-800-362-2764 (TOLL FREE)
OHIO UTILITIES PROTECTION SERVICE
NON-MEMBERS
MUST BE CALLED DIRECTLY



TWO WORKING DAYS
BEFORE YOU DIG
1-800-925-0988 (TOLL FREE)
OIL & GAS PRODUCERS UNDERGROUND
PROTECTION SERVICE

PLAN PREPARED BY:
CITY OF MASSILLON
Engineering Department

OWNER:
CITY OF MASSILLON
151 Lincoln Way East
Massillon, Ohio 44646

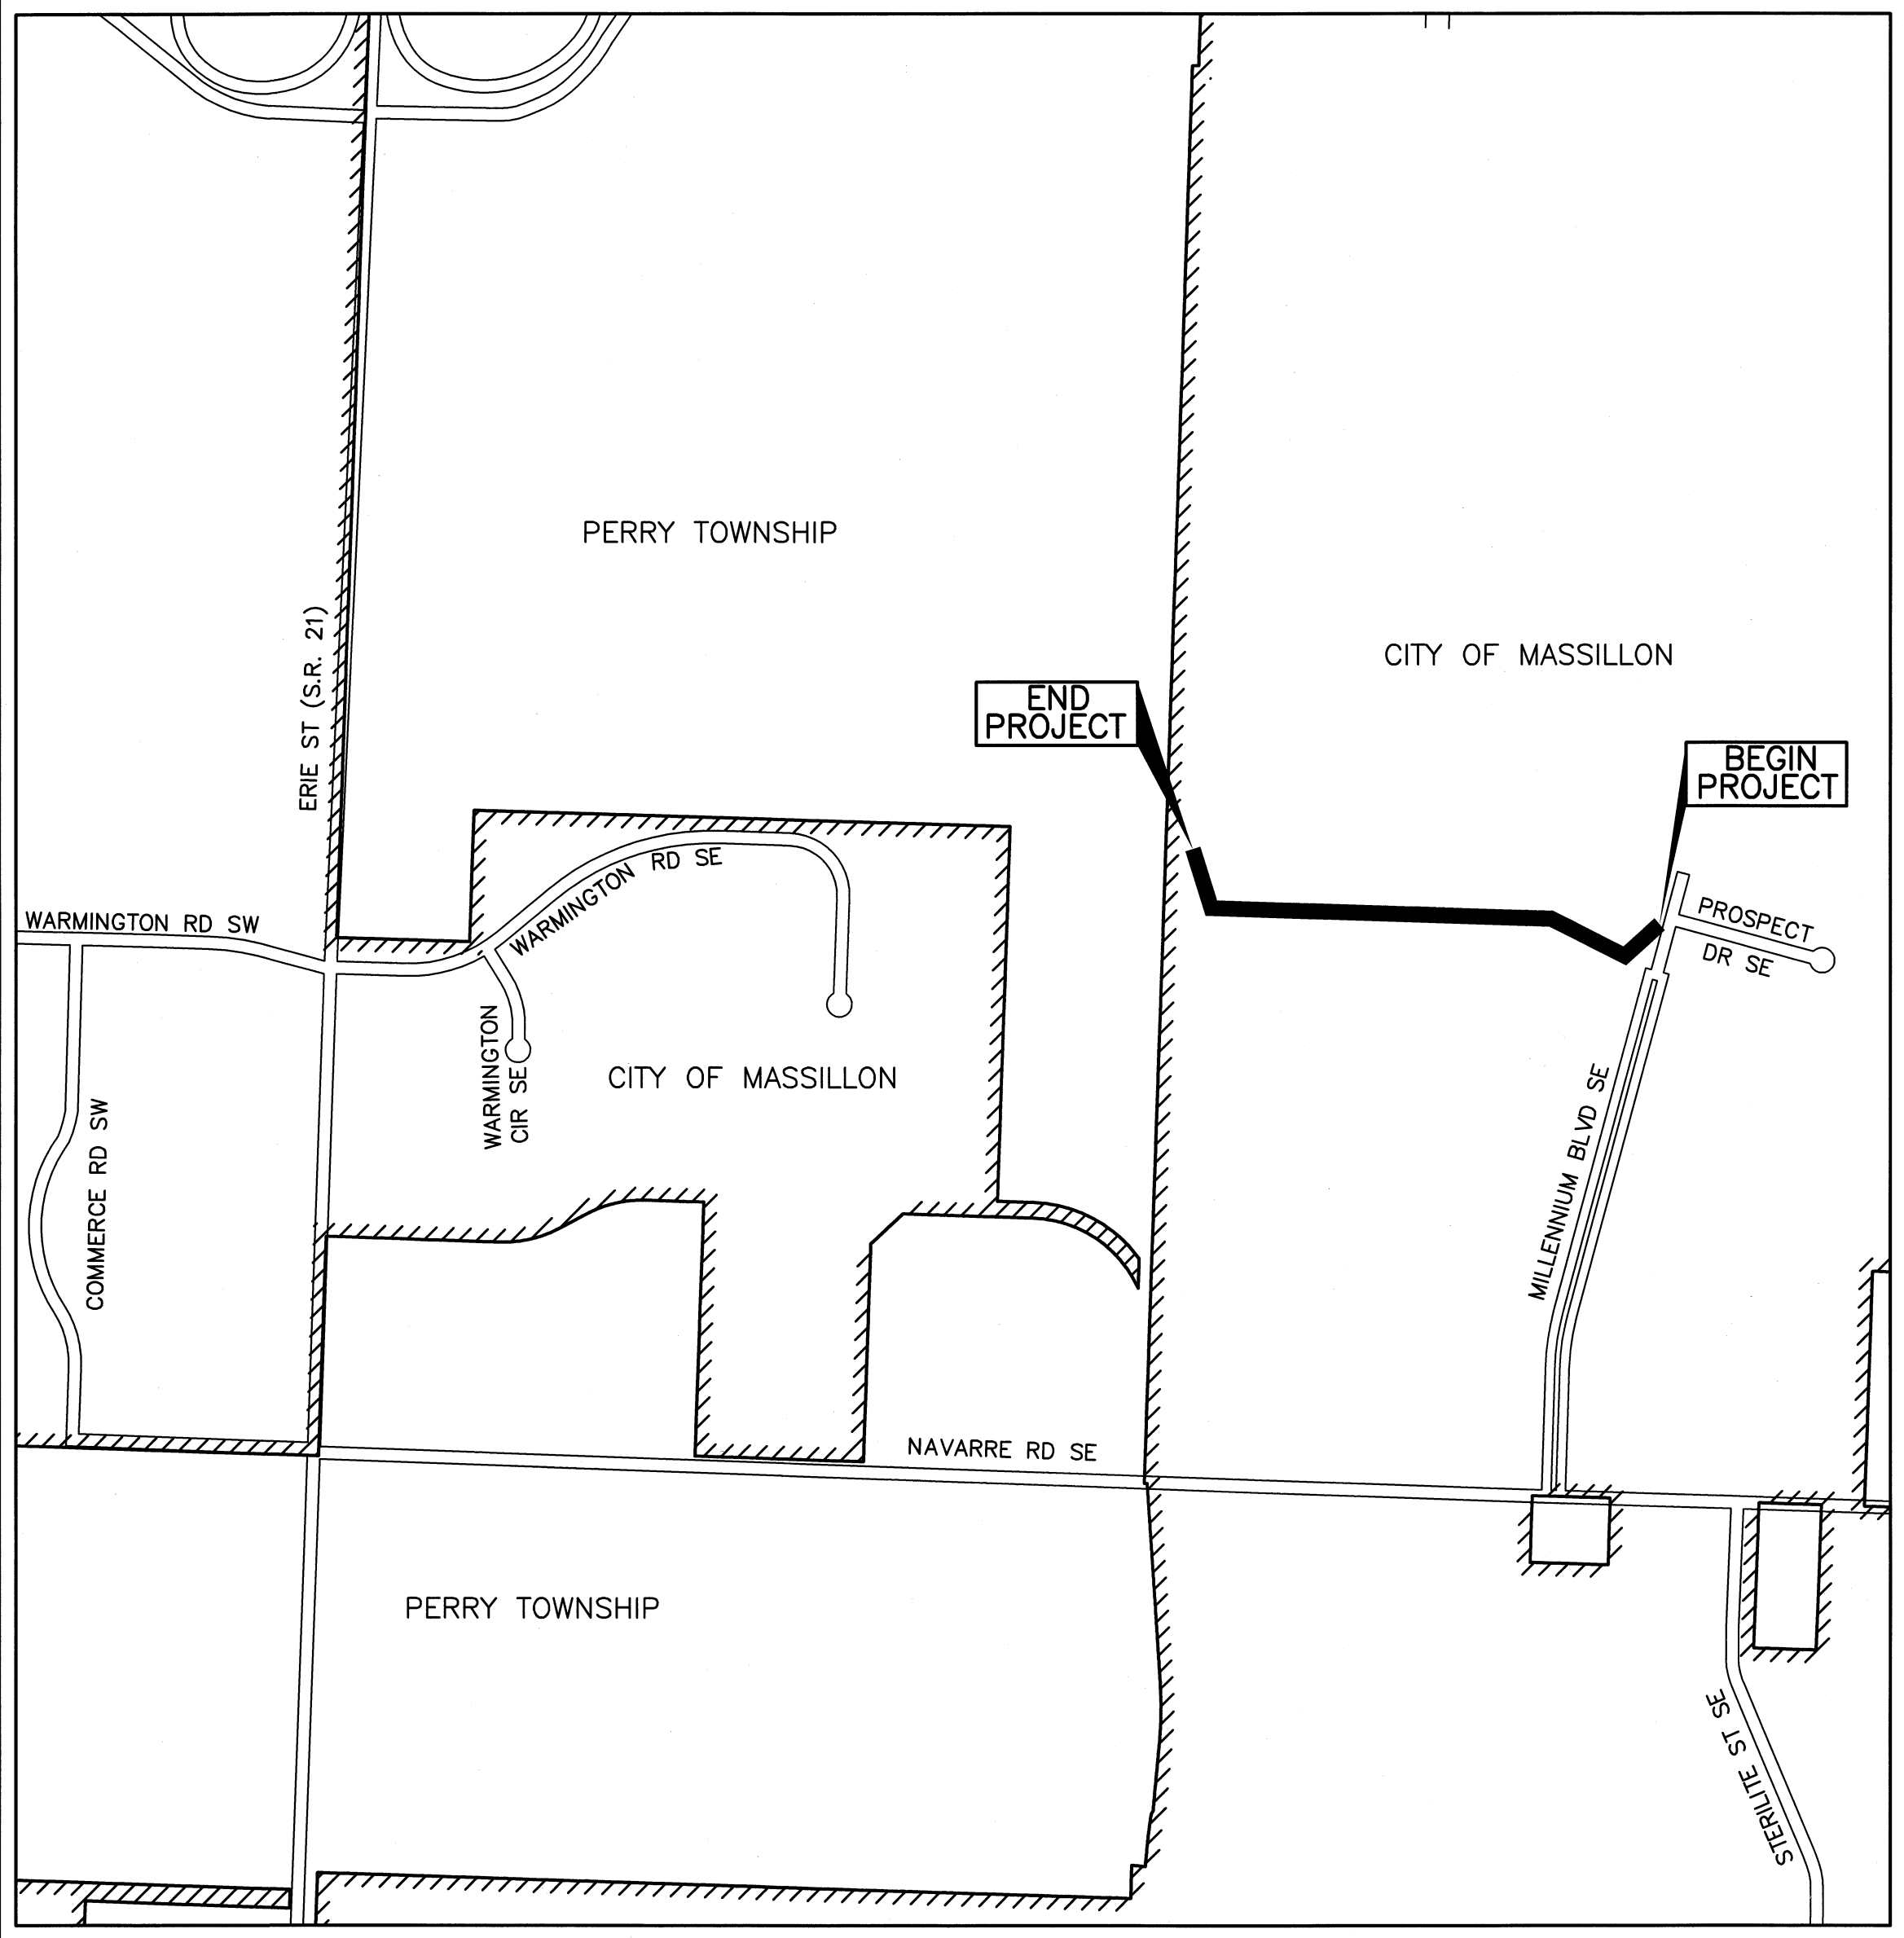

LOCATION MAP

PORTION TO BE IMPROVED _____
STREETS _____

Francis H. Cicchinelli, Jr.
Mayor




INDEX OF SHEETS:

TITLE SHEET	1
GENERAL NOTES	2-3
PLAN AND PROFILE	4-5
SANITARY SEWER DETAILS	6-7
GENERAL SUMMARY AND DETAILS	8

APPROVALS

 8-25-08
DIRECTOR OF PUBLIC SAFETY AND SERVICE MICHAEL J. LOUDIANA DATE
 8/25/08
CITY ENGINEER KEITH A. DYLEWSKI, P.E. DATE

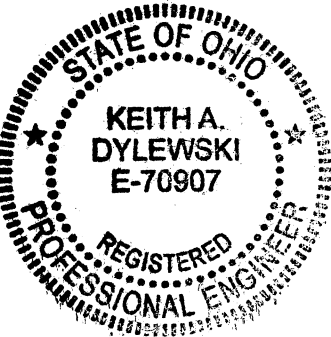


CITY OF MASSILLON ELECTED OFFICIALS

FRANCIS H. CICCHINELLI, Jr.	MAYOR
PERICLES G. STERGIOS	LAW DIRECTOR/PROSECUTOR
JAYNE FERRERO	AUDITOR
PAUL LAMBERT	TREASURER
COUNCIL	
GLEN E. GAMBER	PRESIDENT
RONALD E. MANG	1st WARD
CHUCK MAIER	2nd WARD
KATHERINE CATAZARO-PERRY	3rd WARD
TONY M. TOWNSEND	4th WARD
DONNIE PETERS JR.	5th WARD
DAVID K. McCUNE	6th WARD
PAUL MANSON	AT LARGE
LARRY SLAGLE	AT LARGE
DAVID HERSHER	AT LARGE

REVISIONS:	
DATE	DESCRIPTION

FILE NAME:
neocomTitle.DWG
ACCOUNT NUMBER
08SS02

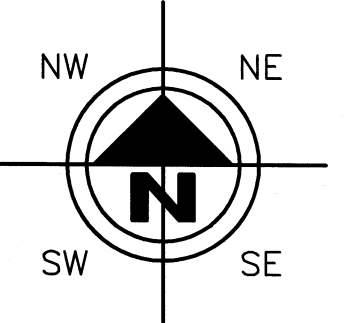

500 250 0 500
HORIZONTAL
SCALE IN FEET

NeoCom Sanitary Sewer Interceptor

Title Sheet
City of Massillon
Stark County, Ohio

Francis H. Cicchinelli, Jr.
Mayor



1 / 8

UTILITIES

LISTED BELOW ARE ALL KNOWN UTILITIES LOCATED WITHIN THE PROJECT CONSTRUCTION LIMITS TOGETHER WITH THEIR RESPECTIVE OWNERS:

AT&T 50 W.BOWERY, 6TH FLOOR AKRON, OH 44308 800-384-8057	AQUA OHIO WATER P.O. BOX 584 MASSILLON, OH 44648 (330) 833-4156	OHIO EDISON STARK DIVISION 2600 S. ERIE ST. MASSILLON, OH 44545 (330) 833-3141	MASSILLON CABLE TV P.O. BOX 814 MASSILLON, OH 44648 (330) 833-4134	GREAT LAKES 104 6TH ST. S.W. CANTON, OH 44702 (330) 456-2454
CITY OF MASSILLON SANITARY SEWER 151 LINCOLN WAY EAST MASSILLON, OH 44646 (330) 830-1722	AT&T COMMUNICATIONS 2535 E. 40TH AVE. DENVER, CO 80205-3601 (800) 852-3786	DOMINION EAST OHIO GAS COMPANY 4725 SOUTHWAY ST. S.W. CANTON, OH 44706 (330) 478-3142	NORTHEAST OHIO NATURAL GAS CORP. 9081 S.R. 250 STRASBURG, OH 44680-9766 (330) 878-5589	

THE CONTRACTOR SHALL NOTIFY ALL UTILITIES 48 HOURS PRIOR TO WORK.

THE LOCATION OF THE UNDERGROUND UTILITIES SHOWN ON THE PLANS ARE SHOWN AT APPROXIMATE LOCATIONS AND WHERE OBTAINED AS REQUIRED FROM THE OWNERS AS REQUIRED BY SECTION 153.64 O.R.C.

OUPS - 1-800-362-2764
OGUPUPS - 1-800-925-0988

DATUM ELEVATION

ALL BENCHMARKS ARE BASED ON REFERENCE BENCHMARKS PROVIDED BY THE CITY OF MASSILLON.

STATIONING

ALL STATIONING SHOWN IS REFERENCED TO THE BASELINE AS SHOWN.

NOTIFICATION OF SAFETY FORCES AND BUS GARAGES

THE CONTRACTOR SHALL NOTIFY ALL AGENCY LISTED BELOW AT LEAST 48 HOURS IN ADVANCE OF ANY STREET CLOSING OR TRAFFIC CHANGE.

MASSILLON SAFETY SERVICE 330-830-1702	MASSILLON FIRE DEPARTMENT 330-833-1053	PERRY TOWNSHIP HALL 330-833-2141	NORTH LAWRENCE FIRE DEPT. 330-832-6347
TUSCARAWAS TOWNSHIP HALL 330-832-4337	JACKSON FIRE DEPARTMENT 330-832-1553	MASSILLON POLICE DEPARTMENT 330-830-1735	MASSILLON SCHOOL BUS GARAGE 330-830-1849
JACKSON TOWNSHIP HALL 330-832-7416	PERRY FIRE DEPARTMENT 330-478-5121	JACKSON POLICE DEPARTMENT 330-497-7440	JACKSON SCHOOL BUS GARAGE 330-830-8042
PERRY POLICE DEPARTMENT 330-833-3865	PERRY SCHOOL BUS GARAGE 330-477-1300	STARK COUNTY SHERIFF 330-430-3887	TUSCARAWAS SCHOOL BUS GARAGE 330-837-7805

SARTA
330-454-5333

SUBSURFACE CONDITIONS

IT IS THE OBLIGATION AND RESPONSIBILITY OF THE CONTRACTOR TO MAKE HIS OWN INVESTIGATION OF SUBSURFACE CONDITIONS PRIOR TO SUBMITTING THEIR BID. PROSPECTIVE BIDDERS ARE TO COORDINATE WITH THE OWNER FOR ACCESS TO THE SITE FOR INSPECTIONS AND EXPLORATORY EXCAVATION. THE BIDDER SHALL CONTACT THE OWNER AT LEAST 72 HOURS IN ADVANCE OF THE DESIRED INSPECTION OR EXCAVATION. THE BIDDER SHALL CONTACT O.U.P.S. AND OBTAIN LOCATIONS OF OTHER UTILITIES.

QUANTITIES

QUANTITIES ARE INDICATED FOR COMPARISON OF BIDS ONLY. IT SHALL BE THE RESPONSIBILITY OF THE CONTRACTOR TO VERIFY QUANTITIES BEFORE ORDERING MATERIALS. VARIATIONS FROM THE PLAN QUANTITIES SHALL BE APPROVED BY THE CITY ENGINEER BEFORE MATERIAL ORDERS ARE PLACED. MATERIALS REJECTED DUE TO INCOMPATIBILITY BETWEEN ORDERED QUANTITIES AND FIELD CONDITIONS SHALL BE REPLACED AT THE CONTRACTOR'S EXPENSE.

CONSTRUCTION SPECIFICATIONS & STANDARDS

ALL CONSTRUCTION IS TO BE ACCORDING TO THE CITY OF MASSILLON SPECIFICATIONS AND STANDARDS, AND THE LATEST EDITION OF THE STATE OF OHIO DEPARTMENT OF TRANSPORTATION CONSTRUCTION AND MATERIAL SPECIFICATIONS. WHEN A CONFLICT ARISES BETWEEN THE CITY OF MASSILLON AND ODOT'S STANDARDS, THE MORE STRINGENT STANDARD WILL BE USED AT THE DISCRETION OF THE CITY ENGINEER. THE CONTRACTOR SHALL FOLLOW ALL OSHA AND ADA REGULATIONS AND REQUIREMENTS.

PRESERVATION OF EXISTING UTILITY SERVICES

ANY EXISTING WATER LINE, SANITARY SEWER, STORM SEWER, GAS LINE OR OTHER UTILITY IN OR OUTSIDE OF THE CONSTRUCTION LIMITS, DAMAGED DURING CONSTRUCTION OF THE PROPOSED PROJECT, WILL BE REPLACED AT THE CONTRACTORS EXPENSE.

CONTRACTOR AVAILABILITY

THE CONTRACTOR SHALL SUPPLY THE ENGINEER WITH A 24 HOUR PHONE NUMBER WHERE THE CONTRACTOR SHALL BE AVAILABLE FOR EMERGENCIES.

CONDITIONS OF WORK

ALL WORK PERFORMED UNDER THIS CONTRACT SHALL COMPLY WITH THE U.S. DEPARTMENT OF LABOR, OCCUPATIONAL SAFETY AND HEALTH ACT, STATE, COUNTY, AND CITY OF MASSILLON LAWS AND REGULATIONS. ALL WORK, AT ALL TIMES SHALL BE SUBJECT TO OBSERVATION BY THE OWNER AND/OR ENGINEER. ALL WORK SHALL COMPLY WITH THE CONDITIONS OF THE CONTRACT DOCUMENTS, OHIO EPA, AND STANDARDS OF THE CITY OF MASSILLON. ALL ELECTRICAL WORK SHALL COMPLY WITH THE NATIONAL ELECTRICAL CODE, AND APPLICABLE CITY, COUNTY, STATE AND FEDERAL CODES.

IT SHALL BE THE RESPONSIBILITY OF THE CONTRACTOR TO MAINTAIN SAFE AND SATISFACTORY ACCESS TO ALL ABUTTING PROPERTIES TO THE PROJECT SITE. ADJACENT ROADS SHALL BE MAINTAINED AND KEPT CLEAN OF MUD AND OTHER DEBRIS THAT MAY BE CAUSED BY TRAFFIC EXITING THE WORK SITE. THE CONTRACTOR SHALL COORDINATE AND PROVIDE FOR ALL NECESSARY TRAFFIC CONTROL. TRAFFIC CONTROL SHALL FOLLOWED CURRENT CITY OF MASSILLON RULES AND REGULATIONS AND THE OHIO MANUAL OF UNIFORM TRAFFIC CONTROL DEVICES.

IT SHALL BE THE RESPONSIBILITY OF THE CONTRACTOR TO PROVIDE AND MAINTAIN FACILITIES FOR A CONSTRUCTION OFFICE, EMPLOYEE PARKING, AND EMPLOYEE SANITARY FACILITIES. ON STREET PARKING WILL NOT BE PERMITTED. THE CONTRACTOR SHALL PROVIDE FOR THE LAWFUL OFF-SITE DISPOSAL OF DEMOLITION DEBRIS AND CONSTRUCTION WASTE.

EXISTING DATA

EACH CONTRACTOR SHALL VISIT THE SITE PERSONALLY TO ASCERTAIN THE NATURE OF THE WORK AND BECOME THOROUGHLY FAMILIARIZED WITH THE SITE PRIOR TO BID SUBMISSION.

EXISTING STRUCTURES, GRADES, PIPING, ETC. ARE INDICATED IN APPROXIMATE LOCATION ON THE PLAN. INFORMATION SHOWN IS NOT GUARANTEED TO BE CORRECT AND COMPLETE. THE DATA SHALL BE VERIFIED IN THE FIELD BY THE CONTRACTOR. THE EXISTENCE OF FACILITIES ABOVE OR BELOW GROUND, WHICH MAY NOT BE SHOWN, WILL NOT BE A BASIS FOR A CLAIM FOR EXTRA WORK.

EXISTING UNDERGROUND UTILITIES SHOWN ARE RECORDS PROVIDED BY UTILITY COMPANIES AND ARE APPROXIMATE ONLY. SERVICE LATERALS ARE NOT SHOWN.

IT IS THE RESPONSIBILITY OF CONTRACTOR TO NOTIFY THE CITY, PRIOR TO BID OPENING OF NON-CONFORMING OR CONFLICTING INFORMATION.

PRESERVATION OF PRIVATE PROPERTY

THE CONTRACTOR SHALL PERFORM WORK AS TO NOT DISTURB, DAMAGE OR DESTROY ANY TELEPHONE OR POWER POLES, SIGNS, LANDSCAPING ITEMS, ETC.. ANY ITEM DAMAGED OR DESTROYED ITEMS SHALL BE REPLACED AT THE CONTRACTOR'S EXPENSE AND ANY ITEM DISTURBED OR IN CONFLICT WITH THE WORK TO BE PERFORMED SHALL BE REMOVED AND RESET AT THE CONTRACTOR'S EXPENSE. PRIOR ENGINEER APPROVAL IS REQUIRED BEFORE ANY OF THE ABOVE ITEMS ARE PERFORMED.

EXCAVATED MATERIAL

ALL EXCAVATED MATERIAL AND ALL MATERIAL USED IN CONSTRUCTION OF THE WORK SHALL BE PILED AND STORED IN A MANNER THAT WILL NOT ENDANGER THE WORK AND THAT WILL LEAVE DRIVEWAYS OR OTHER CONTROLS UNOBSTRUCTED AND ACCESSIBLE WHILE THE WORK IS TO BE COMPLETED. SATISFACTORY PROVISIONS SHALL BE MADE FOR STREET DRAINAGE, AND NATURAL WATERCOURSES SHALL NOT BE OBSTRUCTED. DURING THE PROGRESS OF THE WORK, ALL MATERIAL PILES SHALL BE KEPT TRIMMED UP AND MAINTAINED IN A NEAT MANNER. ALL EXCAVATED WASTE MATERIAL SHALL BE REMOVED FROM THE PROJECT SITE, AS DIRECTED BY THE ENGINEER. THE WASTE SITE IS TO BE PROVIDED BY THE CONTRACTOR AT NO COST TO THE CITY, UNLESS OTHERWISE NOTED IN THE SPECIFICATIONS ALONG WITH A LETTER FROM THE PROPOSED WASTE SITE OWNER PERMITTING SUCH AND HOLDING THE CITY HARMLESS.

RESTORATION

FOR SANITARY SEWER INSTALLED, TESTED, AND ACCEPTED UP TO MAY 15TH OF ANY CALENDER YEAR, RESTORATION SHALL BE COMPLETED BY JUNE 30th OF THAT YEAR. FOR INSTALLATION OF SANITARY SEWER TESTED AND ACCEPTED FROM MAY 15th TO SEPTEMBER 30th OF ANY CALENDER YEAR, RESTORATION SHALL BE COMPLETED BY NOVEMBER 15th OF THAT CALENDER YEAR. FOR SANITARY SEWER INSTALLED, TESTED, AND ACCEPTED AFTER NOVEMBER 15TH OF ANY CALENDER YEAR, RESTORATION SHALL BE COMPLETED BY MAY 15th OF THE NEXT CALENDER YEAR.

PAVEMENT CROSSINGS WILL RECEIVE TYPE C PAVEMENT REPLACEMENT WITH FULL WIDTH PAVEMENT OVERLAY.

CONTRACTOR TO REPLACE ALL PAVEMENT MARKINGS, WITH THE COST TO BE INCLUDED IN THE UNIT PRICE BID FOR PAVEMENT.

CONTRACTOR TO USE HOT APPLIED JOINT CRACK SEALER ON ASPHALT PAVEMENT AT ALL ENDS AND INTERSECTIONS.

ALL TRENCHES IN ROAD RIGHT OF WAY WILL RECEIVE FULL DEPTH PREMIUM GRANULAR BACKFILL.

PAYMENT FOR THE OPERATIONS DESCRIBED ABOVE SHALL BE INCLUDED IN THE CONTRACT PRICE FOR THE PERTINENT ITEM.

REMOVAL AND RELOCATION OF EXISTING UTILITIES

THE CONTRACTOR IS REQUIRED TO COOPERATE WITH EACH RESPECTIVE UTILITY OWNER FOR THE REMOVAL AND RELOCATION OF ANY AND ALL UTILITIES THAT CREATE A CONFLICT WITH CONSTRUCTION OF THE PROJECT.

ITEM 623. CONSTRUCTION STAKING

CONTRACTOR IS RESPONSIBLE FOR ALL CONSTRUCTION LAYOUT. THIS WORK IS TO BE UNDER ITEM 623 CONSTRUCTION STAKING.

CROSSING OR CONNECTING TO EXISTING PIPES AND UTILITIES

WHERE PLANS PROVIDE FOR A PROPOSED CONDUIT TO BE CONNECTED TO, OR CROSS OVER OR UNDER AN EXISTING SEWER OR UNDERGROUND UTILITY, THE CONTRACTOR SHALL LOCATE THE EXISTING PIPES OR UTILITIES BOTH AS TO LINE AND GRADE BEFORE STARTING TO LAY THE PROPOSED CONDUIT.

IF IT IS DETERMINED THAT THE ELEVATION OF THE EXISTING CONDUIT, OR EXISTING APPURTENANCE TO BE CONNECTED, DIFFERS FROM THE PLAN ELEVATION OR RESULTS IN A CHANGE IN THE PLAN CONDUIT SLOPE, THE ENGINEER SHALL BE NOTIFIED BEFORE STARTING CONSTRUCTION OF ANY PORTION OF THE PROPOSED CONDUIT WHICH WILL BE AFFECTED BY THE DIFFERENCE IN THE EXISTING ELEVATIONS.

IF IT IS DETERMINED THAT THE PROPOSED CONDUIT WILL INTERSECT AN EXISTING SEWER OR UNDERGROUND UTILITY IF CONSTRUCTED AS SHOWN ON THE PLANS, THE ENGINEER SHALL BE NOTIFIED BEFORE STARTING CONSTRUCTION OF ANY PORTION OF THE PROPOSED CONDUIT WHICH WOULD BE AFFECTED BY THE INTERFERENCE WITH AN EXISTING FACILITY.

PAYMENT FOR THE OPERATIONS DESCRIBED ABOVE SHALL BE INCLUDED IN THE CONTRACT PRICE FOR THE PERTINENT 603 CONDUIT ITEM.

ITEM 659. TOPSOIL, SEEDING AND MULCHING

ITEM 659 SHALL BE APPLIED TO ALL EXPOSED SOIL AREAS DISTURBED DURING CONSTRUCTION. SUCH AS SPECIFIED IN ITEM 659 AND IS NOT LIMITED TO JUST TOPSOIL, SEEDING AND MULCHING. THE CITY SHALL APPROVE SEED MIX PRIOR TO CONSTRUCTION TO BE USED THROUGH OUT CONSTRUCTION LIMITS. PROPOSED MIX SHALL BE SUBMITTED IN WRITING PRIOR TO ANY CONSTRUCTION. ALL ABOVE SAID WORK SHALL BE PAID FOR UNDER:

ITEM 659, SEEDING AND MULCHING LUMP SUM BID

REVIEW OF SANITARY AND DRAINAGE FACILITIES

AN INSPECTION OF ALL EXISTING SEWERS WHICH ARE TO REMAIN IN SERVICE AND WHICH MAY BE AFFECTED BY THE WORK SHALL BE COMPLETED BEFORE AND AFTER WORK HAS COMMENCED. FINAL ACCEPTANCE BY THE CITY OF MASSILLON WILL NOT OCCUR UNTIL AFTER SAID INSPECTION. THE CONDITION OF THE EXISTING CONDUITS AND THEIR APPURTENANCES SHALL BE DETERMINED FROM FIELD OBSERVATIONS. RECORDS OF THE SHALL BE KEPT IN WRITING BY THE CITY OF MASSILLON.

ALL NEW CONDUITS, INLETS, CATCH BASINS, AND MANHOLES CONSTRUCTED AS A PART OF THE PROJECT SHALL BE FREE OF ALL FOREIGN MATTER AND IN A CLEAN CONDITION BEFORE THE PROJECT WILL BE ACCEPTED BT THE CITY OF MASSILLON.

ALL EXISTING SEWERS INSPECTED INITIALLY BY THE ABOVE MENTIONED PARTIES SHALL BE MAINTAINED AND LEFT IN A CONDITION REASONABLY COMPARABLE TO THAT DETERMINED BY THE ORIGINAL INSPECTION. ANY CHANGE IN THE CONDITION RESULTING FROM THE CONTRACTOR'S OPERATIONS SHALL BE CORRECTED BY THE CONTRACTOR TO THE SATISFACTION OF THE ENGINEER.

PAYMENT FOR ALL OPERATIONS DESCRIBED ABOVE SHALL BE INCLUDED IN THE CONTRACT PRICE FOR THE PERTINENT 603 CONDUIT ITEMS.

NeoCom Sanitary Sewer Interceptor

General Notes
City of Massillon
Stark County, Ohio

Francis H. Cicchinelli, Jr.



REVISIONS:	
DATE	DESCRIPTION
FILE NAME: NeocomNote1.DWG	
ACCOUNT NUMBER 08SS02	

2 / 8

EROSION CONTROL

THE CONTRACTOR SHALL PREPARE AND SUBMIT A STORM WATER POLLUTION CONTROL PLAN TO THE CITY OF MASSILLON ENGINEER TO BE FORWARDED TO THE APPROPRIATE PERMITTING AGENCIES. SAID PLAN MUST COMPLY WITH THE MOST CURRENT RULES AND REGULATIONS OF THE CITY OF MASSILLON.

SANITARY SEWER SPECIFICATIONS

SANITARY SEWER CONSTRUCTION PROPOSED FOR THIS PROJECT SHALL CONFORM TO THE LATEST CITY OF MASSILLON STANDARD CONSTRUCTION AND MATERIALS SPECIFICATIONS, TEN STATE STANDARDS, AND THE LATEST EDITION OF THE ODOT CMS, OR MODIFIED BY THE CONTRACT DRAWINGS. IF A CONFLICT ARISES BETWEEN SAID STANDARDS IT SHALL BE AT THE DISCRETION OF THE CITY ENGINEER AS TO WHICH STANDARD SHALL GOVERN. THE PROJECT CONTRACT DRAWINGS SHALL GOVERN UNLESS NOTED OTHERWISE.

SANITARY GRAVITY SEWER PIPE AND FITTINGS SHALL BE PVC SDR 35 CONFORMING TO ASTM D-3034 UNLESS OTHERWISE NOTED. PVC COMPOUNDS SHALL CONFORM TO ASTM D-1784 PVC PIPE AND FITTINGS SHALL HAVE BELL AND SPIGOT TYPE JOINTS CONFORMING TO ASTM D-3212 AND GASKETS CONFORMING TO ASTM F-477

BACKFILL IN SEWER TRENCHES SHALL BE PLACED IN LAYERS SUFFICIENT TO MEET THE COMPACTION REQUIREMENT OF 100% OF MAXIMUM LABORATORY DRY DENSITY PER ASTM D-698 AND THOROUGHLY COMPACTED WITH MACHINE MOUNDED COMPACTION EQUIPMENT. THE PLACING OF BACKFILL MATERIAL SHALL BE CONTINUED UNTIL THE TRENCH IS ENTIRELY FILLED AND COMPACTED TO THE GRADE CALLED FOR ON THE CONTRACT DRAWINGS. EXCAVATED MATERIAL CONFORMING TO ODOT ITEM 203 SHALL BE USED FOR BACKFILLING EXISTING STRUCTURES (AFTER REMOVAL) ONLY. CRUSHED GRAVEL CONFORMING TO GRADATION REQUIREMENTS OF ODOT ITEM 304 AS SHOWN IN ODOT TABLE 703-1 SHALL BE USED FOR BACKFILLING ALL SEWER TRENCHES, AREAS SHOWN ON THE PLANS AND AS DIRECTED BY THE CITY ENGINEER. FLOODING, JETTING, OR PUDDLING OF BACKFILL MATERIAL WILL NOT BE PERMITTED. COMPACTION TESTING OF THE BACKFILL BY A GEOTECHNICAL ENGINEER MAY BE REQUIRED BY THE OWNER AT THE EXPENSE OF THE CONTRACTOR.

SANITARY SEWERS SHALL BE AIR TESTED FOR LEAKAGE AND MANDREL TESTED FOR DEFLECTION. THE MAXIMUM ALLOWABLE PIPE DEFLECTION SHALL BE 5%.

PRIOR TO FINAL PAYMENT FOR AND ACCEPTANCE OF SANITARY SEWER INSTALLATION THE RESULTS OF THE AIR PRESSURE TESTS, TELEVISION TESTS AND MADREL TESTS SHALL BE FORWARDED TO THE CITY ENGINEER.

DEFLECTION TESTING

MAXIMUM ALLOWABLE PIPE DEFLECTION (REDUCTION IN VERTICAL INSIDE DIAMETER) SHALL BE 5%. DEFLECTION TESTS OF PIPE SHALL BE PERFORMED NOT SOONER THAN 30 DAYS AFTER THE BACKFILL HAS BEEN PLACED AND BEFORE FINAL ACCEPTANCE. LOCATIONS WITH EXCESS DEFLECTION SHALL BE EXCAVATED AND REPAIRED BY RE-BEDDING OR REPLACEMENT OF THE PIPE AT THE CONTRACTOR'S EXPENSE. DEVICES FOR TESTING INCLUDE A DEFLECTOMETER METER, OR PROPERLY SIZED "60, NO-GO" MANDREL OR SEWER BALL. THE DEFLECTION TESTING MUST BE CONDUCTED WITHOUT MECHANICAL PULLING DEVICES. FOR THE PURPOSE OF DEFLECTION MEASUREMENTS, THE BASE INSIDE PIPE DIAMETERS WITHOUT DEFLECTION ARE PROVIDED IN TABLE A. THE MAXIMUM ALLOWABLE DEFLECTION SHALL BE APPLIED TO THE BASE INSIDE DIAMETER IN DETERMINING THE MINIMUM PERMISSIBLE DIAMETER. IT MUST BE EMPHASIZED THAT TO INSURE ACCURATE TESTING, THE LINES MUST BE THOROUGHLY CLEANED.

TABLE A
INSIDE DIAMETERS FOR DEFLECTION MEASUREMENTS
OF ASTM D 3034 SDR 35 / SDR 21 PVC SEWER PIPE

SIZE	SDR	AVG. O.D.	t	1.06t or t'	AVG. I.D.	TOLERANCE	BASE I.D.	DEFLECTION MANDREL
6"	35	6.275	0.241	0.255	5.764	0.102	5.662	5.38
8"	35	8.400	0.323	0.342	7.715	0.127	7.588	7.21
10"	35	10.500	0.404	0.428	9.644	0.153	9.491	9.02

TELEVISION TESTING

ALL SANITARY SEWERS, 8-INCH DIAMETER AND LARGER, MUST PASS AN INTERNAL TELEVISION INSPECTION. THE CONTRACTOR SHALL PROVIDE COMPLETE INTERNAL INSPECTION VIDEOTAPE TO THE CITY OF MASSILLON ENGINEERING DEPARTMENT. THE VIDEOTAPING PROCEDURE SHALL BE IN ACCORDANCE WITH CITY OF MASSILLON ENGINEERING DEPARTMENT STANDARDS.

LEAKAGE TESTS

LEAKAGE TESTS SHALL BE SPECIFIED. THIS MAY INCLUDE APPROPRIATE WATER OR LOW PRESSURE AIR TESTING. THE TESTING METHODS SELECTED SHOULD TAKE INTO CONSIDERATION THE RANGE IN GROUNDWATER ELEVATIONS DURING THE TEST AND ANTICIPATED DURING THE DESIGN LIFE OF THE SEWER COMPLETED AND ACCEPTED.

WATER (HYDROSTATIC) TEST

THE LEAKAGE EXFILTRATION OR INFILTRATION SHALL NOT EXCEED 100 GALLONS PER INCH OF PIPE DIAMETER PER MILE PER DAY [9L/(MM OF PIPE DIAMETER KM D)] FOR ANY SECTION OF THE SYSTEM. AN EXFILTRATION OR INFILTRATION TEST SHALL BE PERFORMED WITH A MINIMUM POSITIVE HEAD OF 2 FEET (0.6 M).

AIR TESTING AS PER ASTM F1417

AIR TESTING WILL BE CONDUCTED AS THE PROJECT IS BEING INSTALLED. AT NO TIME WILL MORE THAN 900 FEET OF PIPE BE INSTALLED BEFORE AIR TESTING IS PERFORMED. SEWAGE WILL NOT BE DIVERTED TO ANY SECTION OF PIPE, REGARDLESS OF LENGTH, UNTIL ALL TESTING IS COMPLETED AND ACCEPTED.

AFTER BACKFILLING A MANHOLE TO MANHOLE REACH OF SANITARY SEWER LINE, THE CONTRACTOR SHALL, AT HIS EXPENSE, CONDUCT THE LINE ACCEPTANCE TESTS. THE TESTS SHALL BE PERFORMED ACCORDING TO THE STATED PROCEDURES AND UNDER THE SUPERVISION OF THE CITY ENGINEER OR HIS REPRESENTATIVE.

EQUIPMENT USED SHALL MEET THE FOLLOWING MINIMUM REQUIREMENTS AND BE APPROVED BY THE ENGINEER:

1. PNEUMATIC PLUGS SHALL HAVE A SEALING LENGTH EQUAL TO OR A GREATER THAN THE DIAMETER OF THE PIPE BEING INSPECTED.
2. PNEUMATIC PLUGS SHALL RESIST INTERNAL TEST PRESSURES WITHOUT REQUIRED EXTERNAL BRACING OR BLOCKING.
3. ALL AIR USED SHALL PASS THROUGH A SINGLE CONTROL PANEL.
4. THREE INDIVIDUAL HOSES SHALL BE USED FOR THE FOLLOWING CONNECTIONS:
 - a. FROM CONTROL PANEL TO PNEUMATIC PLUGS FOR INFLATION.
 - b. FROM CONTROL PANEL TO SEALED LINE FOR INTRODUCING THE LOW PRESSURE AIR.
 - c. FROM SEALED LINE TO CONTROL PANEL FOR CONTINUALLY MONITORING AIR PRESSURE RISE IN THE SEALED LINE.

TEST EQUIPMENT TESTING PROCEDURES SHALL BE AS FOLLOWS:
ALL PNEUMATIC PLUGS SHALL BE SEAL TESTED BEFORE BEING USED IN THE ACTUAL TEST INSTALLATION. ONE LENGTH OF PIPE SHALL BE LAID ON THE GROUND AN SEALED AT BOTH ENDS WITH THE PNEUMATIC PLUGS TO BE CHECKED. THE SEALED PIPE SHALL BE PRESSURED TO 5 PSIG. THE PLUGS MUST HOLD AGAINST THIS PRESSURE WITHOUT HAVING TO BE BRACED.

AFTER A MANHOLE TO MANHOLE REACH OF PIPE HAS BEEN BACKFILLED AND CLEANED, AND THE PNEUMATIC PLUGS ARE CHECKED BY THE ABOVE PROCEDURE, THE PLUGS SHALL BE PLACED IN THE LINE AT EACH MANHOLE. LOW PRESSURE AIR SHALL BE SLOWLY INTRODUCED INTO THIS SEALED LINE UNTIL THE INTERNAL AIR PRESSURE REACHES APPROXIMATELY 4 PSIG.

AT LEAST TWO MINUTES SHALL BE ALLOWED FOR THE AIR PRESSURE TO STABILIZE. WHEN THE PRESSURE HAS STABILIZED AND IS AT OR ABOVE 3.5 PSIG, THE AIR HOSE FROM THE CONTROL PANEL TO THE AIR SUPPLY SHALL BE DISCONNECTED. THE PORTION OF THE LINE BEING TESTED SHALL BE TERMED "ACCEPTABLE" IF THE TIME REQUIRED IN MINUTES FOR THE PRESSURE TO DECREASE FROM 3.5 TO 2.5 PSIG (GREATER THEN THE AVERAGE BACK PRESSURE OF ANY GROUNDWATER THAT MAY BE OVER THE PIPE) SHALL NOT BE LESS THAN THE TIME SHOWN FOR THE GIVEN DIAMETERS IN THE FOLLOWING TABLE:

PIPE DIAMETER IN.	MINIMUM TIME MINUTES	LENGTH FOR MINUTES TIME, FT.	TIME FOR LONGER LENGTH, S	SPECIFICATION TIME LENGTH (L) SHOWN, MINUTES							
				100 FT.	150 FT.	200 FT.	250 FT.	300 FT.	350 FT.	400 FT.	450 FT.
4	3:46	597	0.380 L	3:46	3:46	3:46	3:46	3:46	3:46	3:46	3:46
6	5:40	398	0.854 L	5:40	5:40	5:40	5:40	5:40	5:40	5:42	6:24
8	7:34	298	1.520 L	7:34	7:34	7:34	7:36	7:36	8:52	10:08	11:24
10	9:26	239	2.374 L	9:26	9:26	9:26	9:53	11:52	13:51	15:49	17:48
12	11:20	198	3.416 L	11:20	11:20	11:24	14:15	17:05	19:56	22:47	25:38
15	14:10	159	6.342 L	14:10	14:10	17:46	22:15	26:42	31:09	35:36	40:04
18	17:0	133	7.692 L	17:00	19:13	25:38	32:09	38:27	44:52	51:16	57:41
21	19:50	114	10.470 L	19:50	26:10	36:54	43:37	52:21	81:00	69:48	78:31
24	22:40	99	13.674 L	22:47	34:11	45:34	56:58	68:22	79:46	91:10	102:33
27	25:30	88	17.306 L	28:51	43:16	57:41	72:07	86:32	100:57	115:22	129:48
30	28:20	80	21.366 L	35:37	53:25	71:13	89:02	106:50	124:38	142:26	160:15
33	31:10	72	25.852 L	49:05	64:38	86:10	107:43	129:16	150:43	172:21	193:53
36	34:00	66	30.768 L	51:17	76:55	102:34	128:12	153:50	170:29	205:07	230:46

IN AREAS WHERE GROUND WATER IS KNOWN TO EXIST, THE CONTRACTOR SHALL INSTALL A 1/2 INCH DIAMETER CAPPED PIPE NIPPLE APPROXIMATELY 10 INCHES LONG, THROUGH THE MANHOLE WALL ON TOP OF ONE OF THE SANITARY SEWER LINES ENTERING THE MANHOLE. THIS SHALL BE DONE AT THE TIME THE SANITARY SEWER LINE IS INSTALLED. IMMEDIATELY PRIOR TO THE PERFORMANCE OF THE LINE ACCEPTABILITY TEST, THE GROUND WATER SHALL BE DETERMINED BY REMOVING THE PIPE CAP, BLOWING AIR THROUGH THE PIPE NIPPLE IN THE GROUND SO AS TO CLEAR IT, AND THEN CONNECTING A CLEAR PLASTIC TUBE TO THE NIPPLE. THE PLASTIC TUBE SHALL BE VERTICAL AND A MEASUREMENT OF THE HEIGHT, IN FEET OF WATER OVER THE INVERT OF THE PIPE, SHALL BE TAKEN AFTER THE WATER HAS STOPPED RISING IN THIS PLASTIC TUBE. AIR TEST PRESSURE IS TO BE INCREASED BY 0.433 PSI FOR EACH FOOT THE GROUND WATER IS ABOVE THE INVERT OF THE SEWER LINE BEING TESTED. THE ALLOWABLE DROP OF ONE POUND AND THE TIMING OF THE TEST REMAIN THE SAME.

IF A LINE ACCEPTABILITY TEST IS BEING CONDUCTED ON MORE THAN ONE MANHOLE REACH OF PIPE, THE ENTIRE SECTION BEING TESTED SHALL MEET THE LINE ACCEPTABILITY REQUIREMENTS AS IF ONLY ONE (1) OF THE MANHOLE REACHES IN THE SECTION WERE BEING TESTED.

NEGATIVE AIR PRESSURE (VACUUM) TESTING OF MANHOLES AS PER ASTM C-1244

PREPARATION OF THE MANHOLE:

- A. ALL LIFT HOLES SHALL BE PLUGGED.
- B. ALL PIPES ENTERING THE MANHOLE SHALL BE TEMPORARILY PLUGGED, TAKING CARE TO SECURELY BRACE THE PIPES AND PLUGS TO PREVENT THEM FROM BEING DRAWN INTO THE MANHOLE.

PROCEDURE:

- A. THE TEST HEAD SHALL BE PLACED AT THE TOP OF THE MANHOLE IN ACCORDANCE WITH THE MANUFACTURER'S RECOMMENDATIONS.
- B. A VACUUM OF 10 IN. OF MERCURY SHALL BE DRAWN ON THE MANHOLE, THE VALVE ON THE VACUUM LINE OF THE TEST HEAD CLOSED, AND THE VACUUM PUMP SHUT OFF. THE TIME SHALL BE MEASURED FOR THE VACUUM TO DROP TO 9 IN. OF MERCURY.
- C. THE MANHOLE SHALL PASS IF THE TIME FOR THE VACUUM READING TO DROP FROM 10 IN. OF MERCURY TO 9 IN. OF MERCURY MEETS OR EXCEEDS THE VALUES INDICATED IN TABLE BELOW.

DEPTH (FT)	MINIMUM TEST TIMES FOR MANHOLES									
	DIAMETER, IN.									
	30	33	36	42	48	54	60	66	72	
TIME, IN SECONDS										
8	11	12	14	17	20	23	26	29	33	
10	14	15	18	21	25	29	33	36	41	
12	17	18	21	25	30	35	39	43	49	
14	20	21	25	30	35	41	46	51	57	
16	22	24	39	34	40	46	52	58	67	
18	25	27	32	38	45	52	59	65	73	
20	28	30	35	42	50	53	65	72	81	
22	31	33	39	46	55	64	72	79	89	
24	33	36	42	51	59	64	78	87	97	
26	36	39	46	55	64	75	85	94	105	
28	39	42	49	59	69	81	91	101	113	
30	42	45	53	63	74	87	98	108	121	

WORKING AREA

NO EXCAVATION WITH SIDE SLOPES STEEPER THAN 2:1 AND/OR DEEPER THAN 2' WILL BE PERMITTED. OPEN CASTINGS AND PIPES SHALL BE LEFT SECURED WHEN THE SITE IS UNATTENDED BY THE CONTRACTOR. THE CONTRACTOR SHALL SECURE ALL SUCH EXCAVATIONS, OPEN CASTINGS AND PIPES AGAINST UNAUTHORIZED ENTRY COVERING WITH STEEL PLATES, TEMPORARY BACK FILLING, FENCING AND SECURITY SERVICES SHALL BE INCLUDED IN THE PRICE BID FOR THE WORK.

FINAL APPROVAL

PRIOR TO THE PROJECT COMMENCING AND AFTER THE FINAL INVOICE IS SUBMITTED. A VIDEO TAPE WILL BE MADE BY THE CONTRACTOR AND SUBMITTED TO THE CITY ENGINEER BEFORE FINAL ACCEPTANCE OF THE PROJECT. ANY DISCREPANCIES WILL BE RESOLVED PRIOR TO FINAL PAYMENT. AS BUILT DRAWINGS SHALL BE MAINTAINED BY THE CONTRACTOR ON SITE WITH ANY CORRECTIONS BEING RED LINED ON MYLAR DRAWINGS AND SUBMITTED TO THE CITY IN A CLEAR AND LEGIBLE MANNER PRIOR TO THE FINAL INVOICE BEING PAID.

COST OF THIS WORK SHALL BE INCLUDED IN ITEM 623 CONSTRUCTION STAKING

CLEAN WATER STATEMENT

ROOF DRAINS, FOUNDATION DRAINS, AND OTHER CLEAN WATER CONNECTIONS TO THE SANITARY SEWER ARE PROHIBITED.

NeoCom Sanitary Sewer Interceptor

General Notes
City of Massillon
Stark County, Ohio

Francis H. Cicchinelli, Jr.
Mayor



REVISIONS:

DATE	DESCRIPTION
11/5/2008	EROSION, LEAKAGE

FILE NAME:

NeocomNote2.dwg

ACCOUNT NUMBER

08SS03

3

/

8

This diagram is a sanitary sewer profile and manhole layout. The vertical axis represents elevation in feet, ranging from 985 to 1020. The horizontal axis represents stationing, ranging from 8 to 20. The profile shows the ground surface (dashed line) and the sewer pipe (solid line). The sewer pipe starts at station 8+00.00 and ends at station 20+00.00. The profile includes three manholes (SM-1, SM-2, SM-3) and four pipe segments (SP-1, SP-2, SP-3, SP-4). The manholes are labeled with their type, station, rim elevation, and 18-inch floor elevations. The pipe segments are labeled with their length, size, material, and slope. The diagram also shows existing manholes and sewer lines (dashed lines) and a proposed sewer line (solid line). The profile shows a general upward trend in elevation from station 8 to station 20, with a significant drop at station 12+00.00.

Station	Prop. Elev. (ft)	Exst. Elev. (ft)	Notes
8+00.00	990.00	990.00	Start of SP-1
8+61.25	1008.59	1008.59	Manhole SM-1
10+00.00	1009.62	1009.62	Manhole SM-2
12+00.99	1007.58	1007.58	Manhole SM-3
15+60.99	1008.83	1008.83	Manhole SM-4
19+20.99	1010.18	1010.18	Manhole SM-5
20+00.00	1020.00	1020.00	End of SP-4

The diagram illustrates a sanitary sewer profile with the following details:



- Vertical Axis:** Elevation in feet, ranging from 985 to 1020.
- Horizontal Axis:** Stationing, ranging from 8 to 20.
- Proposed Sewer Line:** A solid line showing the sewer profile with a 0.4% slope from station 10 to 12, and a 1.1% slope from station 12 to 19. A 1.0% slope is indicated for the final segment.
- Existing Features:** Dashed lines represent existing manholes and sewer lines, including an existing 18-inch sewer line (ex. 18" sn) and existing manholes (ex. manhole).
- Manhole Details:**
 - SM-1:** Manhole Type 3, Station 12+00.99, Rim = 1007.58. Inlets: 18" @ 991.17(N), 18" @ 991.17(W).
 - SM-2:** Manhole Type 3, Station 15+60.99, Rim = 1008.83. Inlets: 18" @ 995.13(S), 18" @ 995.13(W).
 - SM-3:** Manhole Type 3, Station 19+20.99, Rim = 1010.18. Inlets: 18" @ 999.13(S), 18" @ 999.13(W).
- Spill Points:**
 - SP-1:** 201'-18" SDR 35 Conduit @ 0.4% slope.
 - SP-2:** 360'-18" SDR 35 Conduit @ 1.10% slope.
 - SP-3:** 360'-18" SDR 35 Conduit @ 1.11% slope.
 - SP-4:** 370'-18" SDR 35 Conduit @ 1.0% slope.
- Other Labels:** "MEET EX. STUB" is noted at station 10+09.62.

This diagram illustrates the sanitary sewer profile and manhole details for a project. The vertical axis represents the proposed grade (PROP. @ GRADE) in feet, ranging from 985 to 1020. The horizontal axis represents stationing, ranging from 8 to 20. The profile shows the sewer line with various manholes (SM-1, SM-2, SM-3) and pipe segments (SP-1, SP-2, SP-3, SP-4). The sewer line is shown as a solid line, and the ground surface is shown as a dashed line. The manholes are shown as rectangular structures with their respective elevations and details. The pipe segments are shown as lines with their respective diameters, materials, and slopes.

Station	Prop. @ Grade (ft)	Ground Surface (ft)	Notes
8+00.00	990.00	990.00	ex. 18" sn
8+61.25	1008.59	1008.59	ex. manhole manhole type 3
10+00.00	1009.62	1009.62	ex. manhole manhole type 3
12+00.99	1007.58	1007.58	SM-1 MANHOLE TYPE 3
15+60.99	1008.83	1008.83	SM-2 MANHOLE TYPE 3
19+20.99	1010.18	1010.18	SM-3 MANHOLE TYPE 3
10+00.00	990.00	990.00	MEET EX. STUB
10+00.00	990.00	990.00	SP-1 201'-18" SDR 35 CONDUIT @ 0.4%
14+00.00	990.00	990.00	SP-2 360'-18" SDR 35 CONDUIT @ 1.10%
17+00.00	990.00	990.00	SP-3 360'-18" SDR 35 CONDUIT @ 1.11%
19+00.00	990.00	990.00	SP-4 370'-18" SDR 35 CONDUIT @ 1.0%

This diagram illustrates the sanitary sewer profile and manhole details for a project. The vertical axis represents the proposed grade (PROP. @ GRADE) in feet, ranging from 985 to 1020. The horizontal axis represents stationing, ranging from 8 to 20. The profile shows the sewer line with various manholes (SM-1, SM-2, SM-3) and pipe segments (SP-1, SP-2, SP-3, SP-4). The sewer line is shown as a solid line, and the ground surface is shown as a dashed line. The manholes are shown as rectangular structures with their respective elevations and details. The pipe segments are shown as lines with their respective diameters, materials, and slopes.

Station	Prop. @ Grade (ft)	Ground Surface (ft)	Notes
8+00.00	990.00	990.00	ex. 18" sn
8+61.25	1008.59	1008.59	ex. manhole manhole type 3
10+00.00	1009.62	1009.62	ex. manhole manhole type 3
12+00.99	1007.58	1007.58	SM-1 MANHOLE TYPE 3
15+60.99	1008.83	1008.83	SM-2 MANHOLE TYPE 3
19+20.99	1010.18	1010.18	SM-3 MANHOLE TYPE 3
10+00.00	990.00	990.00	MEET EX. STUB
10+00.00	990.00	990.00	SP-1 201'-18" SDR 35 CONDUIT @ 0.4%
14+00.00	990.00	990.00	SP-2 360'-18" SDR 35 CONDUIT @ 1.10%
17+00.00	990.00	990.00	SP-3 360'-18" SDR 35 CONDUIT @ 1.11%
19+00.00	990.00	990.00	SP-4 370'-18" SDR 35 CONDUIT @ 1.0%

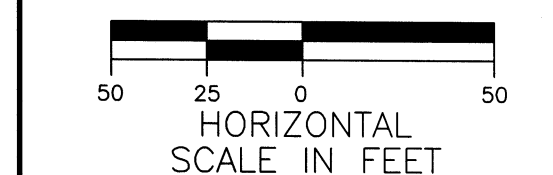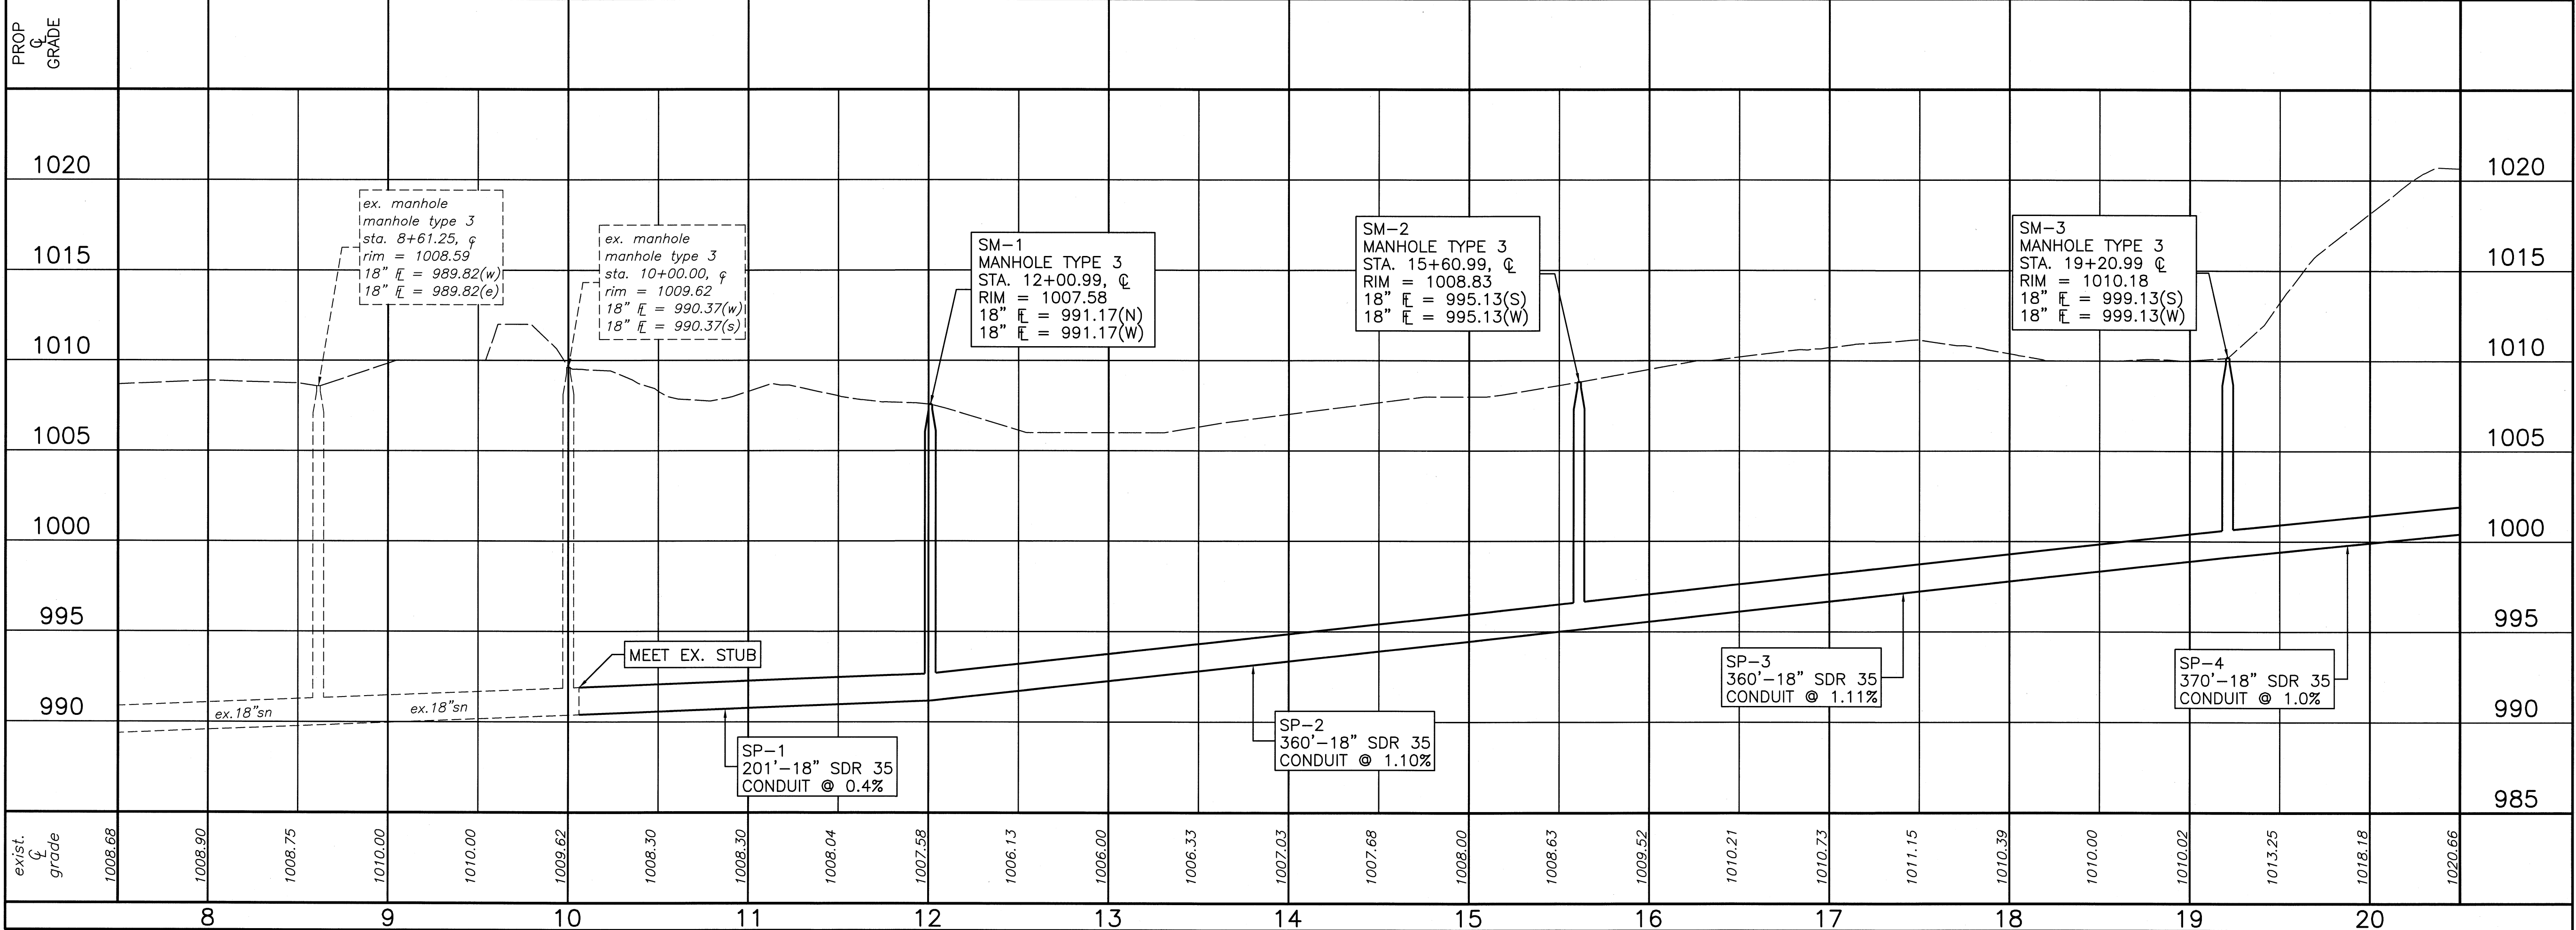

6

NeoCom Sanitary Sewer Interceptor
Sanitary Sewer Plan and Profile Sta. 7+50 to Sta. 20+50
City of Massillon
Stark County, Ohio





Massillon
Means More!

FILE NAME:
Neolterceptorpp1.DWG

SM-1
PRECAST CONCRETE DROP MANHOLE
JOINTS TO BE SEALED WITH CON SEAL FED SPEC SS-S-210A

SM-2
PRECAST CONCRETE MANHOLE
JOINTS TO BE SEALED WITH CON SEAL FED SPEC SS-S-210A

SM-3
PRECAST CONCRETE MANHOLE
JOINTS TO BE SEALED WITH CON SEAL FED SPEC SS-S-210A

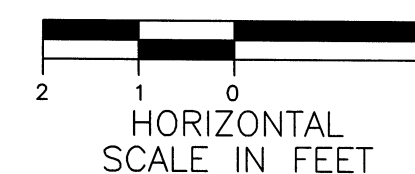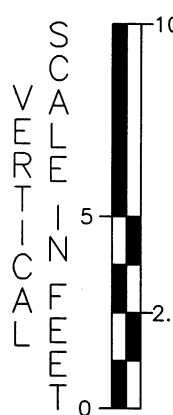

DRAWN BY: FPW	CHECKED BY: KAD
DATE: JULY, 2008	DATE: JULY, 2008

NeoCom Sanitary Sewer Interceptor

Francis H. Cicchinelli, Jr.



REVISIONS:

[illegible]

ELECTROINIC FILE NAME:
neocommanhole1.DWG

ACCOUNT NUMBER	08SS02
----------------	--------



- 1) CONCRETE BASE SHALL BE OF 1:2:4, 6 BAG MIX, PORTLAND CEMENT CONCRETE USING HIGH EARLY STRENGTH CEMENT AND IT MUST BE CURED AT LEAST 48 HRS.
- 2) ALL ABOVE WORK AND MATERIAL SHALL BE INCLUDED IN PERTINENT 603 ITEM
- 3) EXCAVATED MATERIAL MAY BE USED IF FOUND TO BE IN ACCEPTABLE CONDITION AS DETERMINED BY THE CITY ENGINEER.

OPEN CUT DETAIL

GENERAL SUMMARY

Francis H. Cicchinelli, Jr.

REVISIONS:

DATE	DESCRIPTION

ELECTRONIC FILE NAME:
Neocomqua.DWG

ACCOUNT NUMBER
08SS02

CITY OF MASSILLON

CITY ENGINEER DEPARTMENT

STARK COUNTY, OHIO

NEOCOM SANITARY SEWER INTERCEPTOR

PROJECT DESCRIPTION

NEW 18" SANITARY SEWER ALONG THE SOUTH SIDE OF OUTLOT 1054.

CONVENTIONAL SIGNS

RIGHT OF WAY . . . EXISTING: _____, PROPOSED: _____
 COUNTY LINE . . . _____
 TOWNSHIP LINE . . . _____
 CORPORATION LINE . . . _____
 FENCE LINE . . . EXISTING: , PROPOSED:
 GUARDRAIL . . . EXISTING: , PROPOSED:
 MANHOLES . . . EXISTING: , PROPOSED: , REHABILITATED:
 CATCH BASINS . . . EXISTING: , PROPOSED: , REHABILITATED:
 SIGNS 1-POST: , 2-POST: , 3-POST:
 EXISTING POLES . . . POWER: , TELEPHONE , LIGHT , SPAN
 PROPOSED POLES . . . POWER: , TELEPHONE , LIGHT , SPAN
 EXIST. UTILITIES . . . VALVE: , HYDRANT: , METERS: / , GUY:

PERMIT TO INSTALL

SANITARY SEWER PERMIT TO INSTALL (P.T.I.) HAS BEEN RECEIVED FROM THE OHIO ENVIRONMENTAL PROTECTION AGENCY THIS 28 DAY OF OCTOBER, 2008.


PTI No. 676456

UNDERGROUND UTILITIES

TWO WORKING DAYS
BEFORE YOU DIG
 CALL 1-800-362-2764 (TOLL FREE)
 OHIO UTILITIES PROTECTION SERVICE
 NON-MEMBERS
 MUST BE CALLED DIRECTLY
 TWO WORKING DAYS
BEFORE YOU DIG
 1-800-925-0988 (TOLL FREE)
 OIL & GAS PRODUCERS UNDERGROUND
 PROTECTION SERVICE

PLAN PREPARED BY:
 CITY OF MASSILLON
 Engineering Department

OWNER:
 CITY OF MASSILLON
 151 Lincoln Way East
 Massillon, Ohio 44646

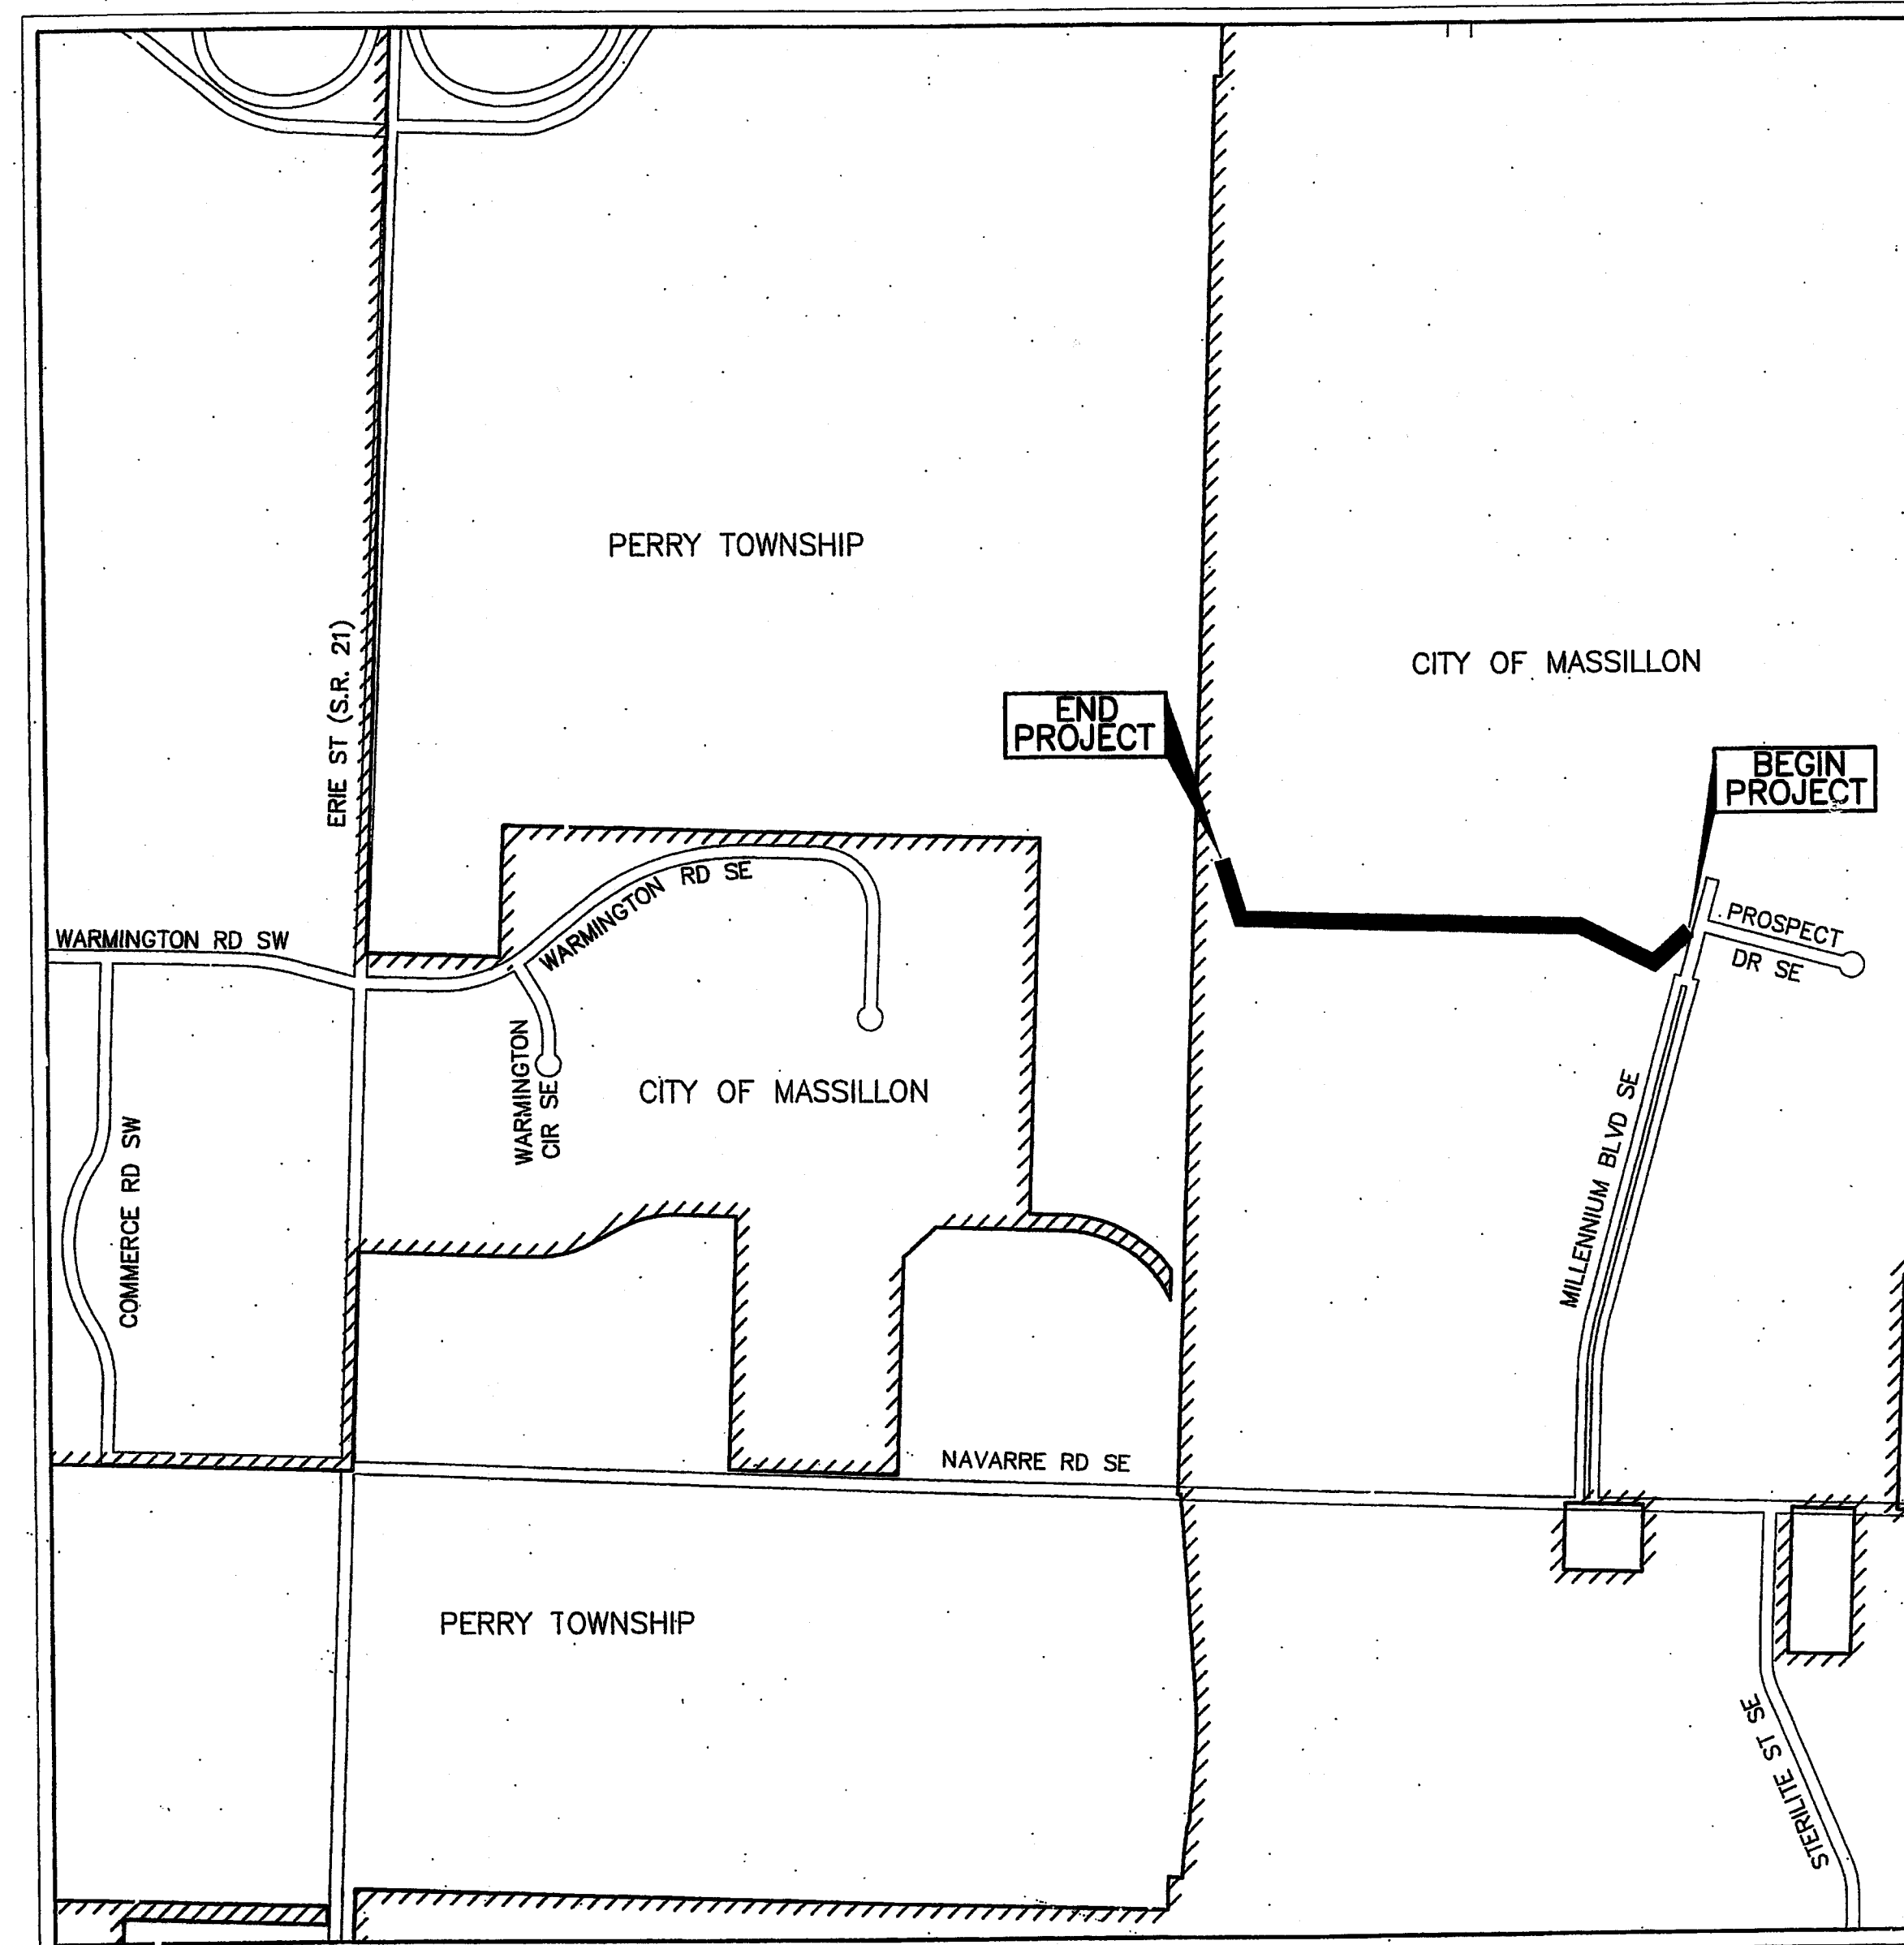

LOCATION MAP

PORTION TO BE IMPROVED _____
 STREETS _____

Francis H. Cicchinelli, Jr.
 Mayor



INDEX OF SHEETS:

TITLE SHEET 1
 GENERAL NOTES 2-3
 PLAN AND PROFILE 4-5
 SANITARY SEWER DETAILS 6-7
 GENERAL SUMMARY AND DETAILS 8


APPROVALS

8/25/08
 DIRECTOR OF PUBLIC SAFETY AND SERVICE MICHAEL J. LOUDIANA DATE
8/25/08
 CITY ENGINEER KEITH A. DYLEWSKI, P.E. DATE



CITY OF MASSILLON ELECTED OFFICIALS

FRANCIS H. CICCHINELLI, Jr. MAYOR
 PERICLES G. STERGIOS LAW DIRECTOR/PROSECUTOR
 JAYNE FERRERO AUDITOR
 PAUL LAMBERT TREASURER
COUNCIL
 GLEN E. GAMBER PRESIDENT
 RONALD E. MANG 1st WARD
 CHUCK MAIER 2nd WARD
 KATHERINE CATAZARO-PERRY 3rd WARD
 TONY M. TOWNSEND 4th WARD
 DONNIE PETERS JR. 5th WARD
 DAVID K. McCUNE 6th WARD
 PAUL MANSON AT LARGE
 LARRY SLAGLE AT LARGE
 DAVID HERSHER AT LARGE

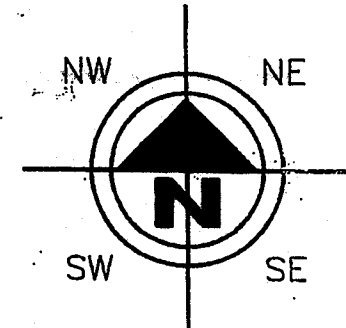

500 250 0 250 500
 HORIZONTAL
 SCALE IN FEET

DRAWN BY: FPW	CHECKED BY: KAD
DATE: JULY, 2008	DATE: JULY, 2008

NeoCom Sanitary Sewer Interceptor

Title Sheet
 City of Massillon,
 Stark County, Ohio

Francis H. Cicchinelli, Jr.
 Mayor



REVISIONS:



DATE	DESCRIPTION
	AS-BUILT

FILE NAME:
 neocomTitle.DWG
 ACCOUNT NUMBER:
 08SS02

CONTROL DATA				
	STATION	NORTH	EAST	ELEVATION
ex. mh	10+00.00	397162.96	2243660.38	
SM-1	12+00.99	396973.14	2243726.46	
SM-2	15+60.99	396961.67	2244086.27	
SM-3	19+20.99	396950.20	2244446.09	
SM-4	22+90.15	396938.44	2244815.07	
SM-5	25+52.77	396819.92	2245049.42	
SM-6	27+03.19	396920.35	2245161.41	
IP FND	22+90.18, 0.35'LT	396938.74	2244815.25	1013.91
IP FND	25+80.55, 70.80'RT	396785.76	2245117.37	1019.59

Case Farms LCC
 Lot = O.L. 1054
 PPN = 0701710
 Zoning = I-2

Miller Land Development LTD
Lot = O.L. 1055
PPN = 0701709
Zoning = I-2

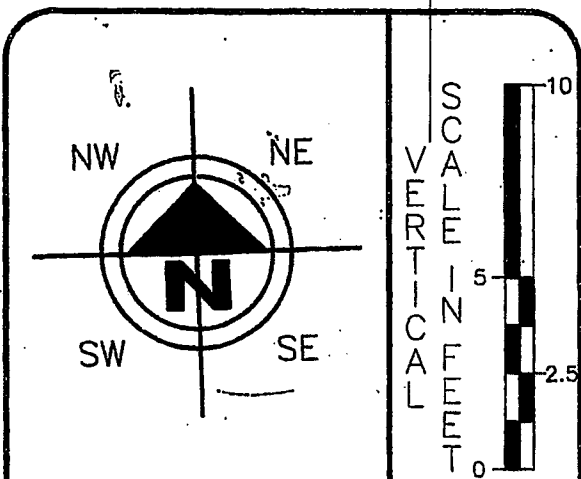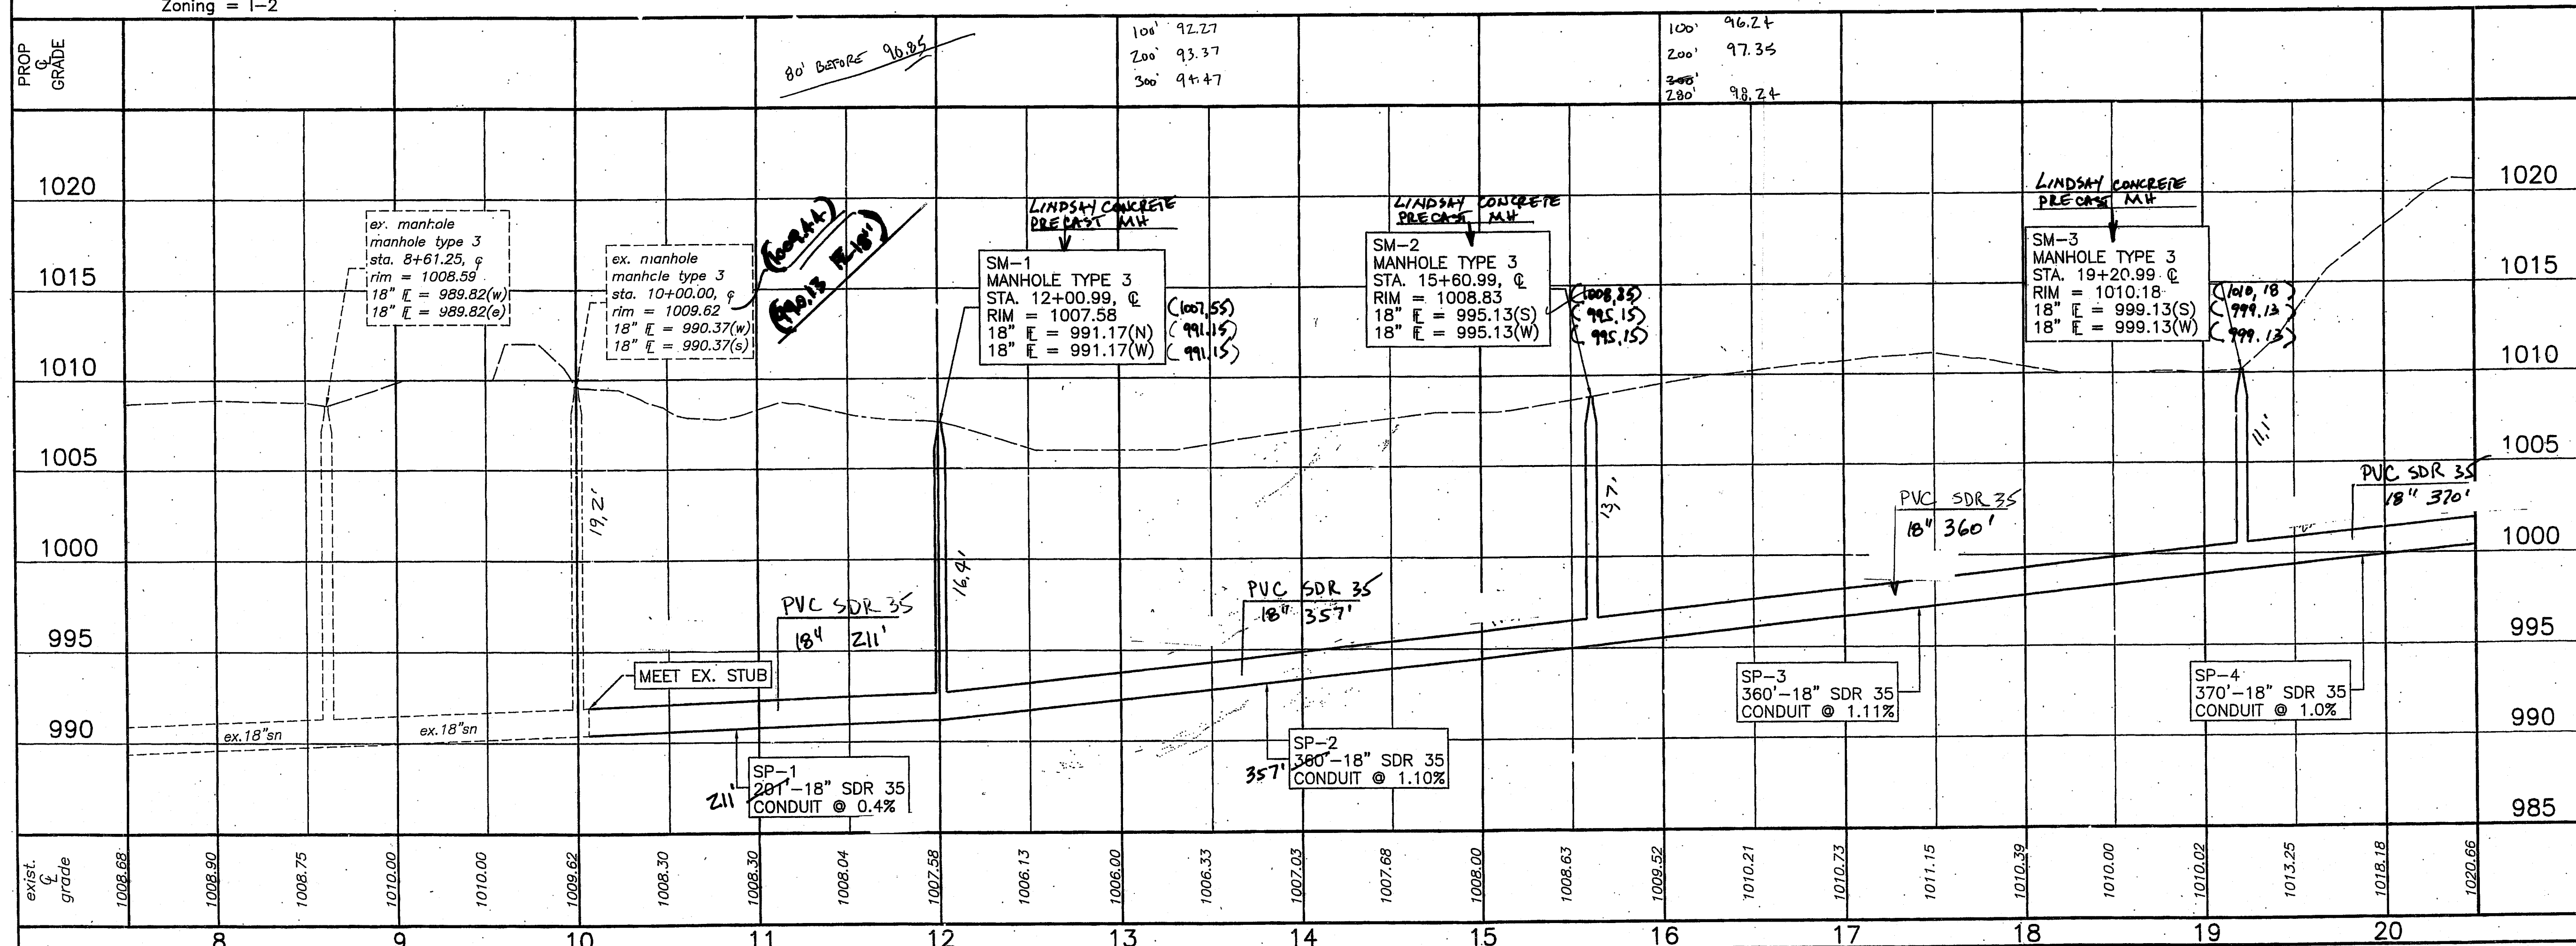

A horizontal scale bar with markings at 50, 25, 0, and 50 feet. The text "HORIZONTAL SCALE IN FEET" is printed below the scale.

DRAWN BY: FPW	CHECKED BY: KAD
------------------	--------------------

DATE: JULY 2008	DATE: JULY 2008
--------------------	--------------------

NeoCom Sanitary Sewer Interceptor
Sanitary Sewer Plan and Profile Sta. 7+50 to Sta. 20+50
City of Massillon
Stark County, Ohio

Francis H. Cicchinelli, Jr.

[illegible]

FILE NAME:
Neolterceptorpp1.DWG

ACCOUNT NUMBER
08SS03

