

CITY OF MASSILLON

CITY ENGINEER DEPARTMENT

STARK COUNTY, OHIO

27th St NW SANITARY SEWER PROJECT

PROJECT DESCRIPTION

NEW 8" SANITARY SEWER ALONG THE EAST SIDE OF BISON AVENUE.

CONVENTIONAL SIGNS

RIGHT OF WAY . . . EXISTING: _____, PROPOSED: _____

COUNTY LINE . . . _____

TOWNSHIP LINE . . . _____

CORPORATION LINE . . . _____

FENCE LINE . . . EXISTING: _____, PROPOSED: _____

GUARDRAIL . . . EXISTING: _____, PROPOSED: _____

MANHOLES . . . EXISTING: ☉, PROPOSED: ●, REHABILITATED: ●

CATCH BASINS . . . EXISTING: ■, PROPOSED: ■, REHABILITATED: ■

SIGNS . . . 1-POST: ⊥, 2-POST: ⊥, 3-POST: ⊥, STREET: ⊥

EXISTING POLES . . . POWER: ⚡, TELEPHONE: ⚡, LIGHT: ⚡, SPAN: ○

PROPOSED POLES . . . POWER: ⚡, TELEPHONE: ⚡, LIGHT: ⚡, SPAN: ●

EXIST. UTILITIES . . . VALVE: ⚙, HYDRANT: ⚙, METERS: ⚙, GUY: ⊥

PERMIT TO INSTALL

SANITARY SEWER PERMIT TO INSTALL (P.T.I.) HAS BEEN RECEIVED FROM THE OHIO ENVIRONMENTAL PROTECTION AGENCY PROTECTION AGENCY THIS _____ DAY OF _____, 20____.

PTI No. _____

UNDERGROUND UTILITIES

TWO WORKING DAYS

BEFORE YOU DIG

CALL 1-800-362-2764 (TOLL FREE)

OHIO UTILITIES PROTECTION SERVICE

NON-MEMBERS

MUST BE CALLED DIRECTLY

TWO WORKING DAYS

BEFORE YOU DIG

1-800-925-0988 (TOLL FREE)

OIL ● GAS PRODUCERS UNDERGROUND PROTECTION SERVICE

PLAN PREPARED BY:
CITY OF MASSILLON
Engineering Department

OWNER:
CITY OF MASSILLON
151 Lincoln Way East
Massillon, Ohio 44646



LOCATION MAP

PORTION TO BE IMPROVED . . . _____

STREETS . . . _____



Kathy Catanzaro-Perry, Mayor
Massillon
City of Champions

AS-BUILT DATA RECORDED ON
SEPTEMBER 20, 2013
BY CAPPELLI SURVEYING, INC.


INDEX OF SHEETS:

TITLE SHEET 1

GENERAL NOTES 2-3

PLAN AND PROFILE 4-5

GENERAL SUMMARY AND DETAILS 6

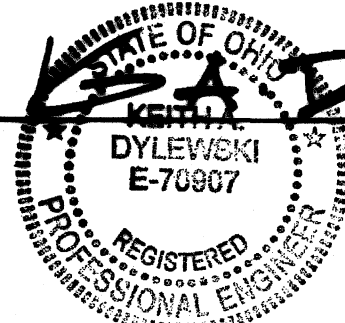

CITY ENGINEER _____ **KEITH A. DYLEWSKI, P.E., P.S.** DATE **3/1/13**

CITY OF MASSILLON ELECTED OFFICIALS

KATHY CATAZARO-PERRY MAYOR

PERICLES G. STERGIOS LAW DIRECTOR/PROSECUTOR

JAYNE FERRERO AUDITOR

MAUDE SLAGLE TREASURER

COUNCIL

TONY M. TOWNSEND PRESIDENT

SARITA CUNNINGHAM-HEDDERLY 1st WARD

NANCY HALTER 2nd WARD

ANDREA SCASSA 3rd WARD

_____ 4th WARD

DONNIE PETERS JR. 5th WARD

ED LEWIS 6th WARD

PAUL MANSON AT LARGE

LARRY SLAGLE AT LARGE

MILAN CHOVAN AT LARGE



VERTICAL SCALE IN FEET
0 100 200

HORIZONTAL SCALE IN FEET
0 100 200



CHECKED BY: KAD
DATE: MAY, 2012
DRAWN BY: FPW
DATE: MAY, 2012

REVISIONS:	DATE	DESCRIPTION

27th St NW Sanitary Sewer Project
Title Sheet
City of Massillon
Stark County, Ohio

Kathy Catanzaro-Perry, Mayor
Massillon
City of Champions

DRAWING NAME: bitofedenTitle.DWG
CITY NUMBER: 10ss03
1 / 6

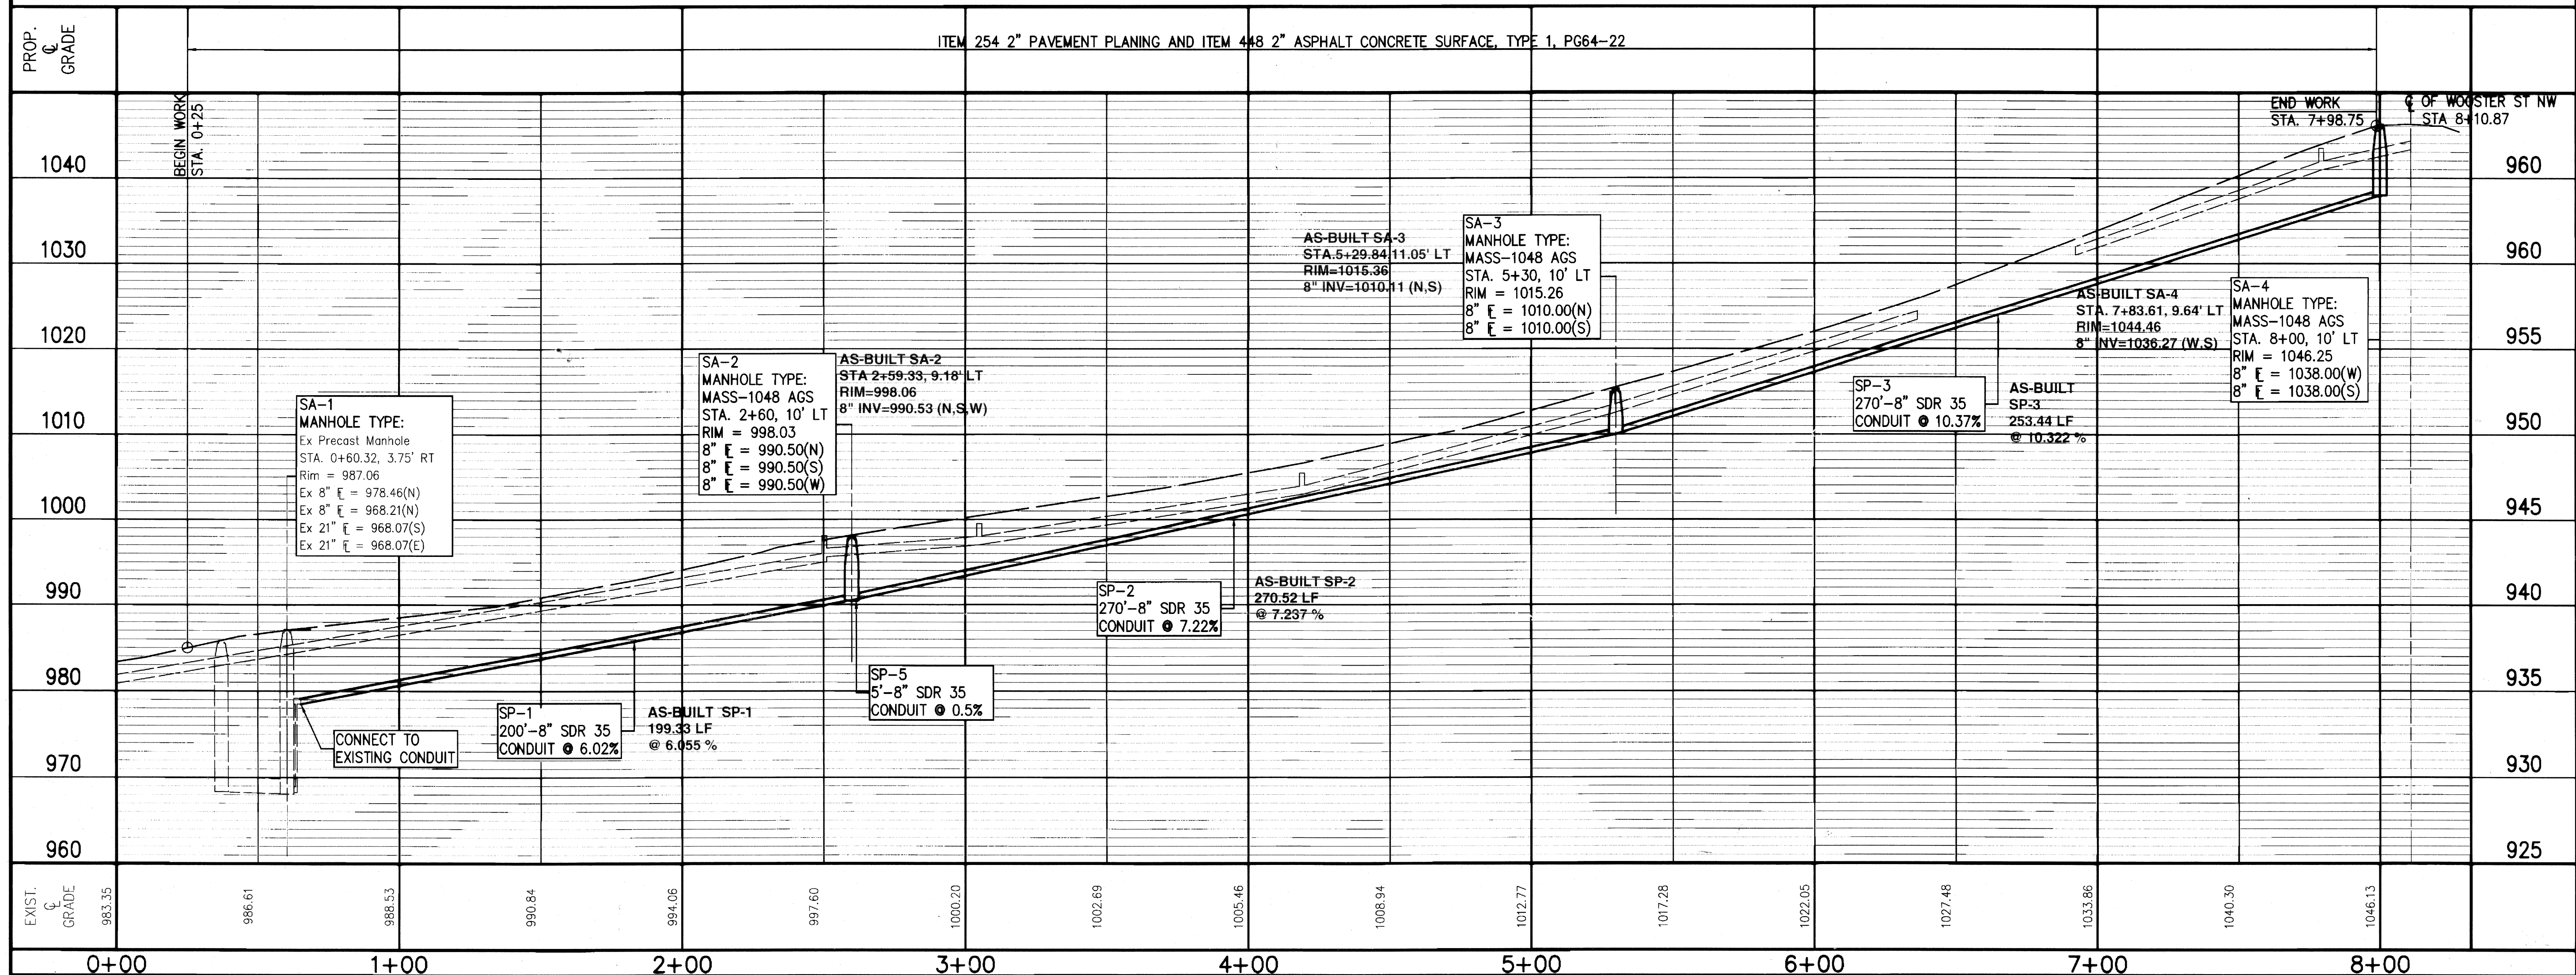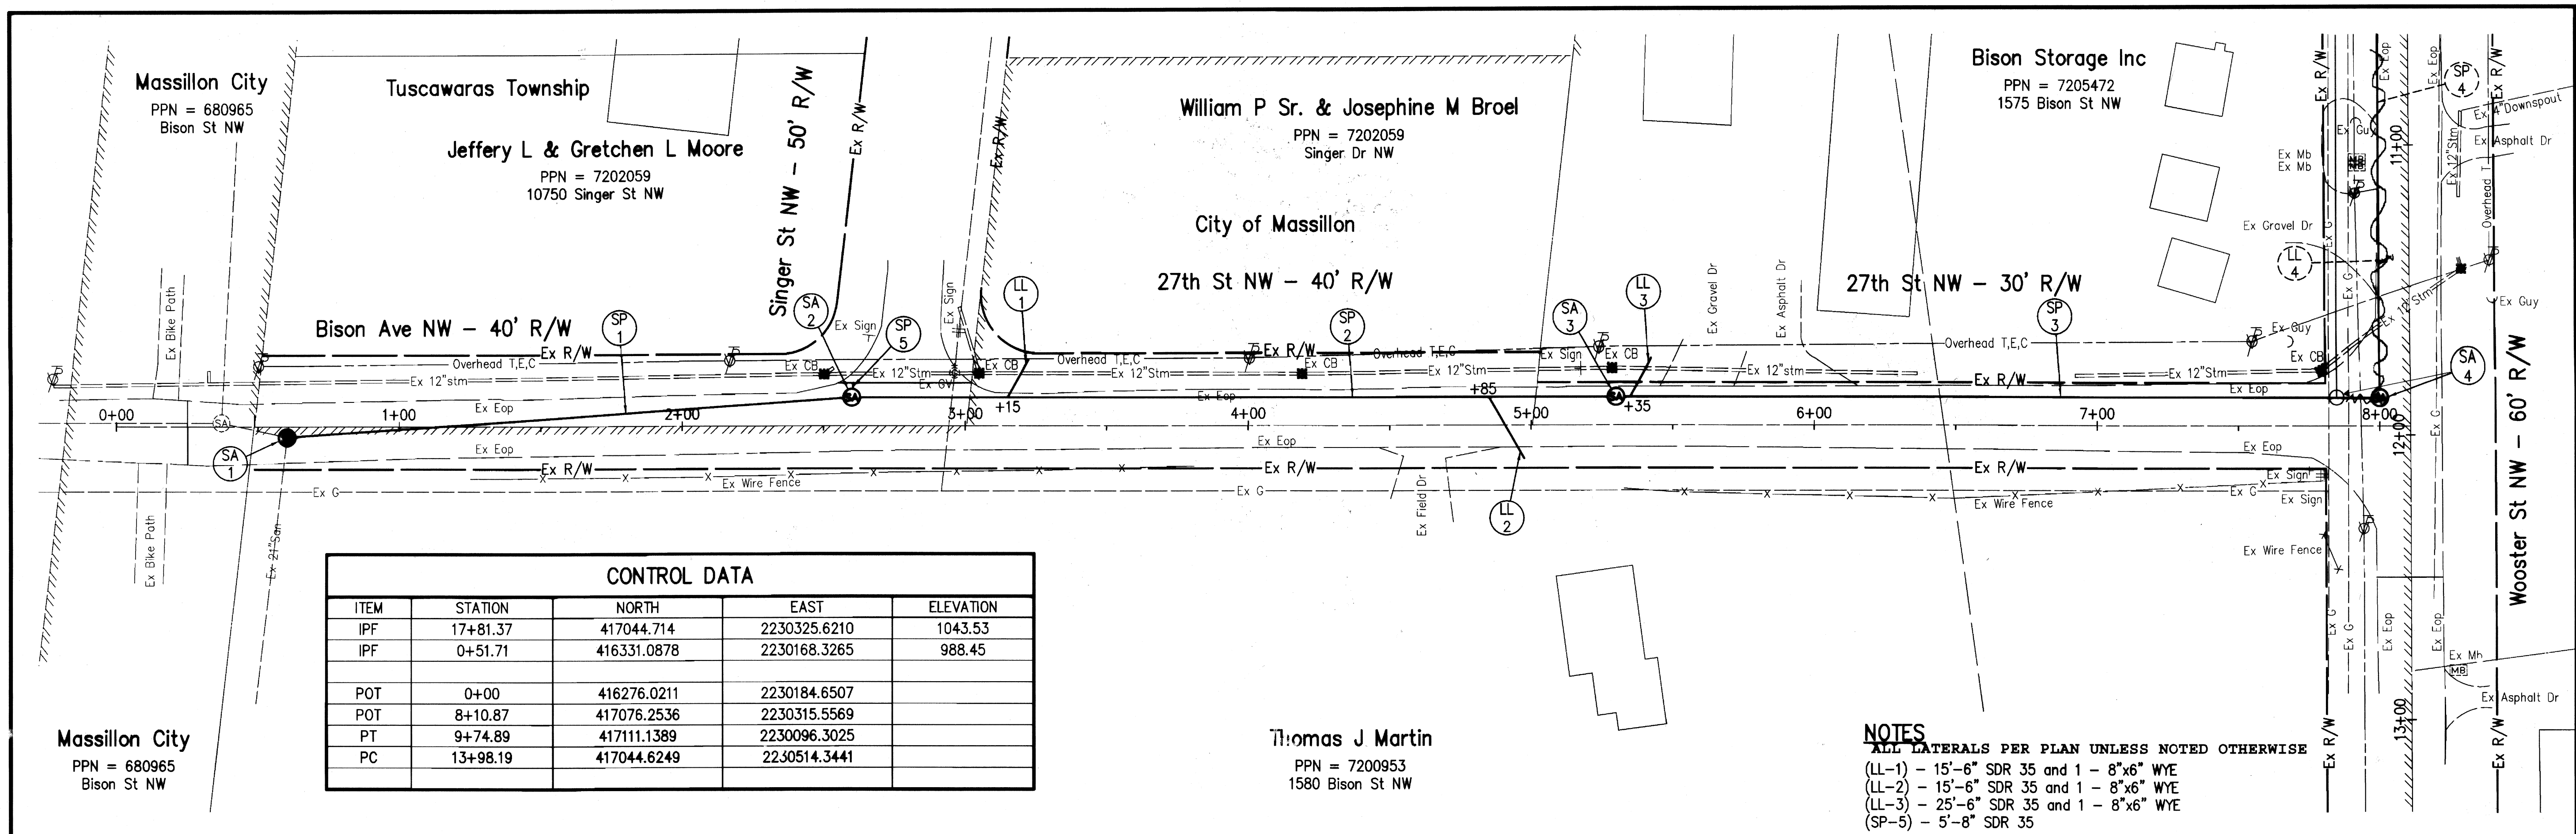

MASSILLON
 City of Champions

27th St NW Sanitary Sewer Project
 Bison Ave Plan And Profile Sta. 0+00 To Sta. 8+25

City of Massillon
 Stark County, Ohio

REVISIONS:

DATE	DESCRIPTION

CHECKED BY:
 KAD

DATE:
 MAY, 2012


DRAWN BY:
 FPW

DATE:
 MAY, 2012

DRAWING NAME:
 BisonPP1.DWG

CITY NUMBER:
 08ss01

4 / 6

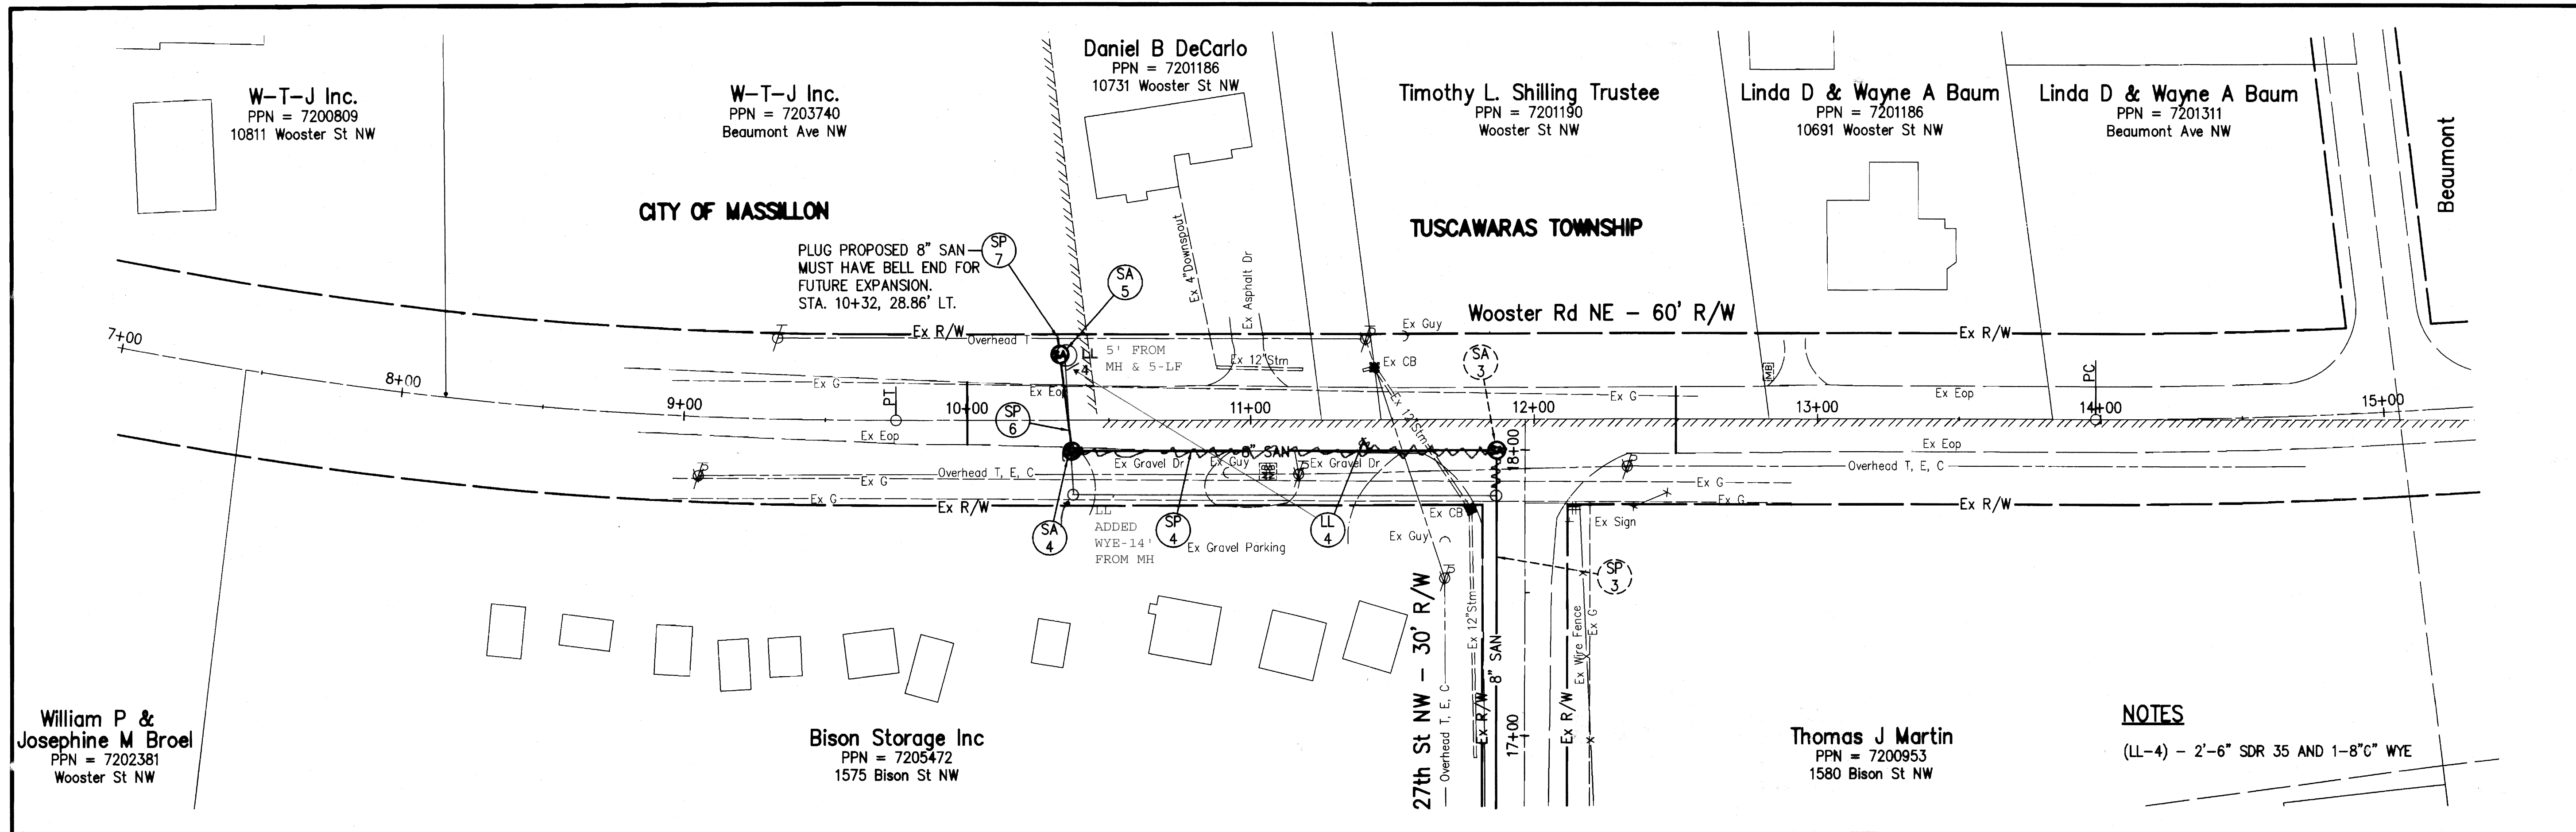

NOTES
(LL-4) - 2'-6" SDR 35 AND 1-8" WYE

PROP. GRADE	ITEM 254 2" PAVEMENT PLANING AND ITEM 448 2" ASPHALT CONCRETE SURFACE TYPE 1, PG64-22										
1070											1070
1060											1060
1050											1050
1040											1040
1030											1030
1020											1020
1010											1010
1000											1000
990											990
EXIST. GRADE											
7+00	8+00	9+00	10+00	11+00	12+00	13+00	14+00	15+00			

0 10 20 30
HORIZONTAL SCALE IN FEET

CHECKED BY: KAD
DATE: MAY, 2012
DRAWN BY: FPW
DATE: MAY, 2012

REVISIONS:	DATE	DESCRIPTION

27th St NW Sanitary Sewer Project
Wooster Rd Plan and Profile Sta. 7+00 To Sta. 15+00
City of Massillon
Stark County, Ohio

Kathy Catzaro-Perry, Mayor
Massillon
City of Champions

DRAWING NAME: Woosterp1.DWG
CITY NUMBER: 08ss01
5 / 6