

Nº 2083

FOLLOWING DATA TO BE ANSWERED BY INSPECTOR
AND SIGNED WHEN RETURNED

11/10 ✓

Date Inspected Dec. 8, 1925

House No. new

Size of pipe used 4"

Was lateral at curb? No

Was attached to main No

If so how and location from
first manhole down stream

Distance from first manhole
down stream to ditch at
curb line and depth


Name of Contractor

Pipe was run direct into

Manhole at intersection of Cady
Cont and Randall

Maestroni

Show by diagram relation of lateral to wall of building served.

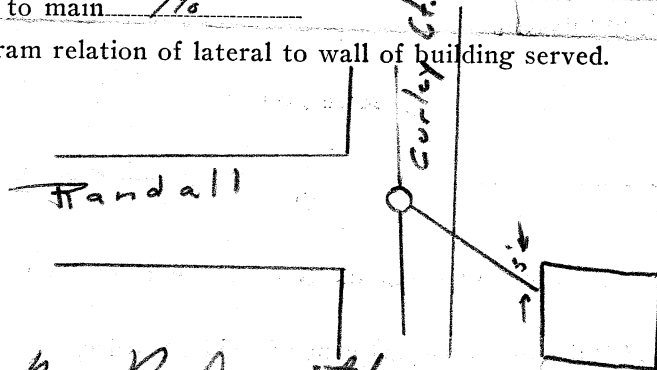

Signed

M. R. Smith

Inspector for City

Filed at Engineer's Office

DEC 10 1925

Remarks

Pipe was laid and covered up before Inspector came on job. Maestroni
was told just before digging ditch not to lay pipe until inspector was there.

OFFICE OF THE DIRECTOR OF PUBLIC SERVICE

No 2083

PERMIT TO TAP SEWER

Massillon, O., Dec 7 1925

Received of H Curley fee of \$2.00

for which permission is granted H Curley

to tap Sum sewer, on the North side

of Curley St Ave., the premises being Lot. No. pt 3476
St.

House No. Work to be done in accordance with Ordinance No. 2323, duly passed
by the City Council, and Rules of the Department of Public Service.

Name of Contractor Maestroni