

FOLLOWING DATA TO BE ANSWERED BY INSPECTOR
AND SIGNED WHEN RETURNED

Nº 2225

Date Inspected 6/21/25

If so how and location from
first manhole down stream

House No. 1206

Distance from first manhole
down stream to ditch at
curb line and depth


Size of pipe used 6" Pipe

Was lateral at curb? yes

Name of Contractor W. Fisher

Was attached to main

Show by diagram relation of lateral to wall of building served.

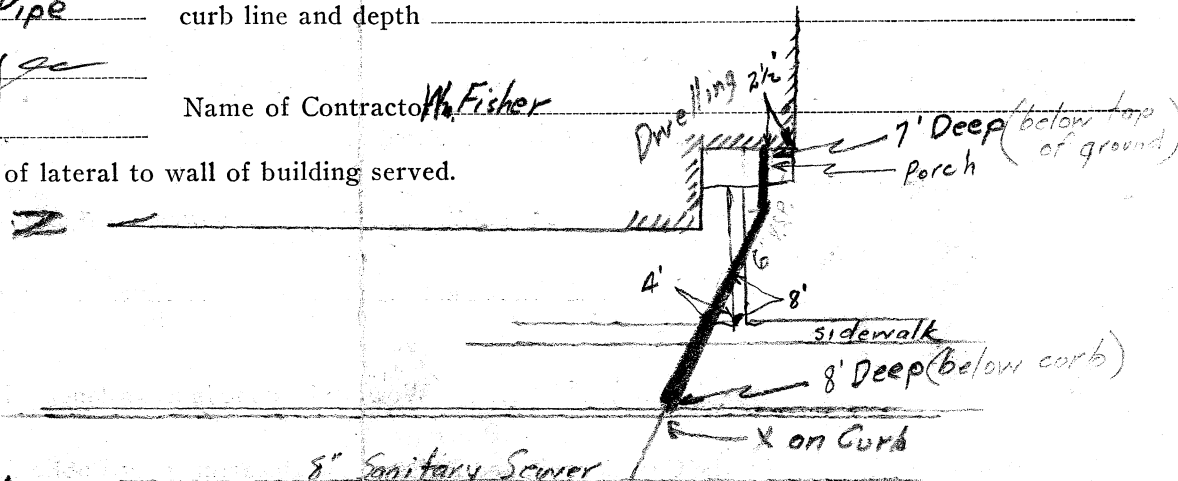

Signed

G. B. Hallam

Inspector for City

Filed at Engineer's Office

JUN 21 1926

Remarks

Sewer was laid before I got there.

OFFICE OF THE DIRECTOR OF PUBLIC SERVICE

Nº 2225

PERMIT TO TAP SEWER

Massillon, O., June 19 1926

Received of John F. Fisher fee of \$ 2.00

for which permission is granted John D. Morgan

to tap Sanitary sewer, on the East side

of Young Ave., the premises being Lot. No. 2579
St.

House No. 1246. Work to be done in accordance with Ordinance No. 2323, duly passed

by the City Council, and Rules of the Department of Public Service.

Name of Contractor Fisher