

**FOLLOWING DATA TO BE ANSWERED BY INSPECTOR
AND SIGNED WHEN RETURNED**

No. 3710

Date Inspected MARCH-16-35

I so how and location from
first manhole down stream

House No. 300

Distance from first manhole
down stream to ditch at

Size of pipe used 4"

curb line and depth 44 FT. FROM MH. at 2nd ST. 4' Deep

Was lateral at curb? YES

Name of Contractor


GEO. EARLY

Was attached to main

NO

Show by diagram relation of lateral to wall of building served.

*19' of 4" V.S.P. was used then
connected on to a 4" iron pipe
that was laid from cellar out.*

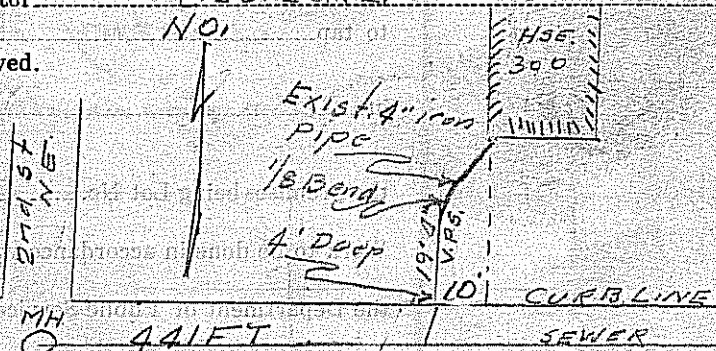

Signed

[Signature]

Inspector for City

Filed at Engineer's Office

MAR 18 1935

Remarks

This sewer was re-laid because of roots in pipe. Pressite joints used in join

OFFICE OF THE DIRECTOR OF PUBLIC SERVICE

N^o 3710

PERMIT TO TAP SEWER

Massillon, O., March 16th 1918Received of Mr. Young fee of \$ 2.⁰⁰for which permission is granted Geo. Earlyto tap Sanitary sewer, on the Northof Commonwealth Ave. Ave., Type of Street Brick
St.,the premises being Lot No. 4816, House No. 300Work to be done in accordance with Ordinance No. 2323, duly passed by the City Council, and by
the Department of Public Service.Name of Contractor Geo. Early**NOTE.** This permit covers work outside of building only. Any work inside walls of building
is subject to Massillon Board of Health Regulations.