

10777

**FOLLOWING DATA TO BE ANSWERED BY INSPECTOR
AND SIGNED WHEN RETURNED**

No 3872

Date Inspected 4/24/37

I so how and location from
first manhole down stream

House No. 114

Distance from first manhole
down stream to ditch at
curb line and depth

Size of pipe used 6"

Was lateral at curb? No

Name of Contractor J. A. Murphy

Was attached to main Yes

Show by diagram relation of lateral to wall of building served.

Signed

Frank B. G. [Signature]

Inspector for City

Filed at Engineer's Office


Remarks:

140' 0" Main 26' 0" South

3rd St NE

5/24/37

W.E.S.

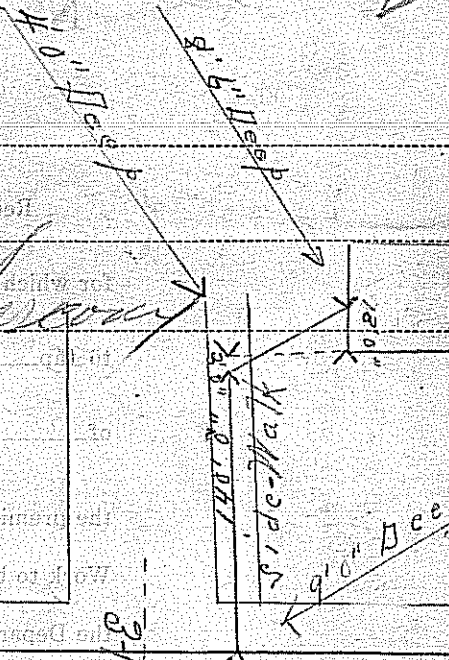

OFFICE OF THE DIRECTOR OF PUBLIC SERVICE

No 3872

PERMIT TO TAP SEWER

Massillon, O.,

19

Received of

fee of \$

for which permission is granted

to tap

sewer, on the

of

Ave., Type of Street
St.,

the premises being Lot No.

House No.

Work to be done in accordance with Ordinance No. 2323, duly passed by the City Council, and Rule No. 1, of the Department of Public Service.

Name of Contractor

NOTE. This permit covers work outside of building only. Any work inside walls of building is subject to Massillon Board of Health Regulations.

This 6" sewer was constructed by Joechercony and is under side walk from Federal Ave NE to lot # Ph 369