

1/5

FOLLOWING DATA TO BE ANSWERED BY INSPECTOR
AND SIGNED WHEN RETURNED

N^o. 3974

DATE INSPECTED

6/29/38

IF SO HOW AND LOCATION FROM
FIRST MANHOLE DOWN STREAM

74'

HOUSE NO.

704

DISTANCE FROM FIRST MANHOLE
DOWN STREAM TO DITCH AT
CURB LINE AND DEPTH

74

7' 6" deep

SIZE OF PIPE USED

4"

WAS LATERAL AT CURB?

Yes

WAS ATTACHED TO MAIN


Yes

NAME OF CONTRACTOR

Geo. Earley

SHOW BY DIAGRAM RELATION OF LATERAL TO WALL OF BUILDING SERVED.

LINCOLN WAY, E.

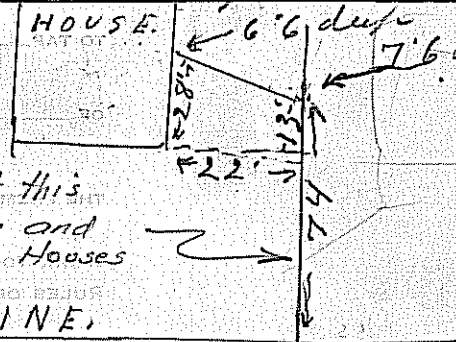

Howenstein said that this
main was built privately and
that it served couple houses
in rear

CURB LINE.

SIGNED

John E. Shum
INSPECTOR FOR CITY

FILED AT ENGINEER'S OFFICE

JUN 29 38

REMARKS.

TAPED TO MAIN BETWEEN THE TWO HOUSES 74' IN
FROM CURB LINE, ON 6" PIPE.

OFFICE OF THE DIRECTOR OF PUBLIC SERVICE
No. 3974
PERMIT TO TAP SEWER

MASSILLON, OHIO, June 20 1919
RECEIVED OF John Howenstein FEE OF \$ 2.00

FOR WHICH PERMISSION IS GRANTED Geo Early

TO TAP Sanitary SEWER, ON THE North

OF Lincoln Way E AVE., TYPE OF STREET Residential
ST.,

THE PREMISES BEING LOT No. 488 House No. 704

WORK TO BE DONE IN ACCORDANCE WITH ORDINANCE No. 2323, DULY PASSED BY THE CITY COUNCIL
RULES OF THE DEPARTMENT OF PUBLIC SERVICE.

NAME OF CONTRACTOR Geo Early

Note. This permit covers work outside of building only. Any work inside
of building is subject to Massillon Board of Health Regulations.