

Nº 5014

FOLLOWING DATA TO BE ANSWERED BY INSPECTOR
AND SIGNED WHEN RETURNED

DATE INSPECTED 8/24/47

IF SO HOW AND LOCATION FROM
FIRST MANHOLE DOWN STREAM

No. find laid when sewer
was constructed

HOUSE NO. _____

SIZE OF PIPE USED 6"

DISTANCE FROM FIRST MANHOLE
DOWN STREAM TO DITCH AT
CURB LINE AND DEPTH

157' From M.H. at Foundation
3' Deep

WAS LATERAL AT CURB? Yes


WAS ATTACHED TO MAIN No

NAME OF CONTRACTOR

Diana

SHOW BY DIAGRAM RELATION OF LATERAL TO WALL OF BUILDING SERVED.

Calc Tite joints used.

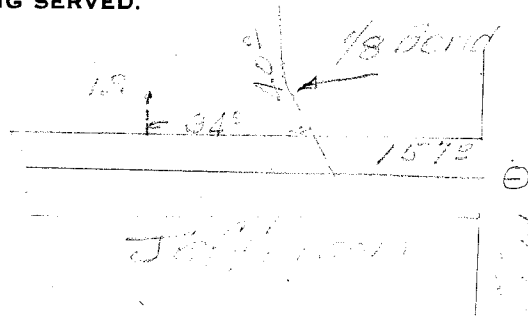

SIGNED Doc.
INSPECTOR FOR CITY

FILED AT ENGINEER'S OFFICE

REMARKS:

sewer was laid before Insp. got on the job.

Nº 5014

OFFICE OF THE DIRECTOR OF PUBLIC SERVICE

PERMIT TO TAP SEWER

MASSILLON, OHIO,

8/12 1947

RECEIVED OF

FEE OF \$

FOR WHICH PERMISSION IS GRANTED

TO TAP

SEWER, ON THE

SIDE

OF

AVE.,
ST.,

TYPE OF STREET

THE PREMISES BEING LOT NO.

HOUSE NO.

WORK TO BE DONE IN ACCORDANCE WITH ORDINANCE NO. 2323, DULY PASSED BY THE CITY COUNCIL, AND RULES OF THE DEPARTMENT OF PUBLIC SERVICE.

NAME OF CONTRACTOR

Note. This permit covers work outside of building only. Any work inside walls of building is subject to Massillon Board of Health Regulations.