

Nº 6527

FOLLOWING DATA TO BE ANSWERED BY INSPECTOR
AND SIGNED WHEN RETURNED

DATE INSPECTED 6-28-56

IF SO HOW AND LOCATION FROM
FIRST MANHOLE DOWN STREAM _____

HOUSE NO. 831

SIZE OF PIPE USED 6"


DISTANCE FROM FIRST MANHOLE
DOWN STREAM TO DITCH AT
CURB LINE AND DEPTH 32' 8' deep

WAS LATERAL AT CURB? Yes

WAS ATTACHED TO MAIN NO

NAME OF CONTRACTOR G. D. Dineen

SHOW BY DIAGRAM RELATION OF LATERAL TO WALL OF BUILDING SERVED.

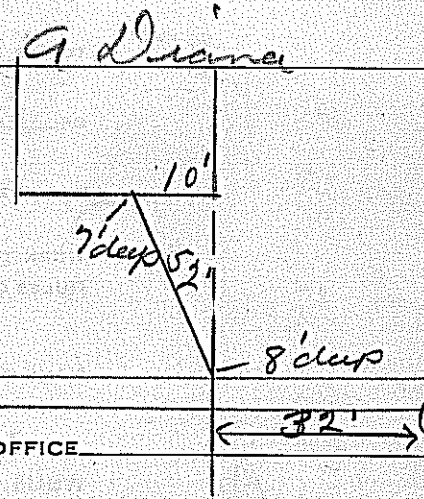

SIGNED

Ray Latham
INSPECTOR FOR CITY

FILED AT ENGINEER'S OFFICE

REMARKS

10-23
OFFICE OF THE DIRECTOR OF PUBLIC SERVICE

Nº 6527

PERMIT TO TAP SEWER

MASSILLON, OHIO, 6/27 1925

RECEIVED OF A. J. Deana FEE OF \$ 2.00

FOR WHICH PERMISSION IS GRANTED Len G. Ritz

TO TAP Side SEWER ON THE W

OF Hemlock AVE. TYPE OF STREET Block Tap

THE PREMISES BEING LOT NO. 11084, HOUSE NO. 831

WORK TO BE DONE IN ACCORDANCE WITH ORDINANCE No. 2323, DULY PASSED BY THE CITY COUNCIL
RULES OF THE DEPARTMENT OF PUBLIC SERVICE.

NAME OF CONTRACTOR Deana

Note This permit covers work outside of building only. Any work in walls of building is subject to Massillon Board of Health Regulations.