

No. 7180

FOLLOWING DATA, TO BE ANSWERED BY INSPECTOR  
AND SIGNED WHEN RETURNED

DATE INSPECTED 11-27-59

IF SO HOW AND LOCATION FROM  
FIRST MANHOLE DOWN STREAM

HOUSE NO. 500

SIZE OF PIPE USED 6"

DISTANCE FROM FIRST MANHOLE  
DOWN STREAM TO DITCH AT  
CURB LINE AND DEPTH



WAS LATERAL AT CURB? Yes

WAS ATTACHED TO MAIN NO

NAME OF CONTRACTOR

SHOW BY DIAGRAM RELATION OF LATERAL TO WALL OF BUILDING SERVED.

A. D. King

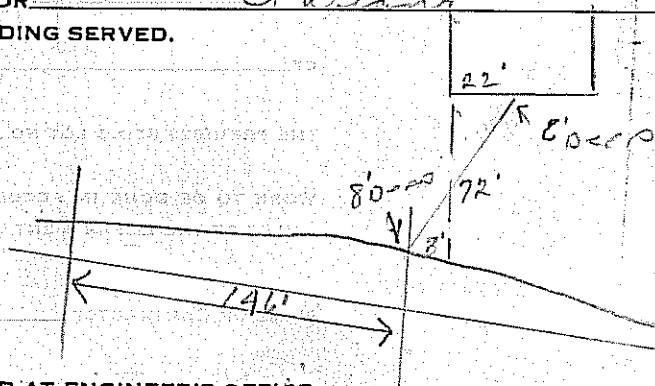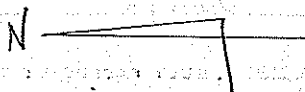

SIGNED

Roy Lathin  
INSPECTOR FOR CITY

FILED AT ENGINEER'S OFFICE

REMARKS

17-16  
1-5-60

OFFICE OF THE DIRECTOR OF PUBLIC SERVICE

NO. 7180

PERMIT TO TAP SEWER

MASSILLON, OHIO, November 25, 19

RECEIVED OF A. J. Tians FEE OF \$ 2

FOR WHICH PERMISSION IS GRANTED Kitsen Bros Inc

TO TAP Side SEWER ON THE East

OF 24<sup>th</sup> Ave ST. TYPE OF STREET Dist

THE PREMISES BEING LOT NO. 12060, HOUSE NO. 500

WORK TO BE DONE IN ACCORDANCE WITH ORDINANCE No. 2323, DULY PASSED BY THE CITY COUNCIL  
RULES OF THE DEPARTMENT OF PUBLIC SERVICE.

NAME OF CONTRACTOR A. J. Tians

Note This permit covers work outside of building only. Any work in walls of building is subject to Massillon Board of Health Regulations.