

No As BUILTS - DONE UNDER COUNTY?

20-
6

✓
Nº 9358

FOLLOWING DATA TO BE ANSWERED BY INSPECTOR
AND SIGNED WHEN RETURNED

DATE INSPECTED 3-18-80

IF SO HOW AND LOCATION FROM
FIRST MANHOLE DOWN STREAM 178'

HOUSE NO. 382-386

SIZE OF PIPE USED 8"


DISTANCE FROM FIRST MANHOLE
DOWN STREAM TO DITCH AT
CURB LINE AND DEPTH 178

WAS LATERAL AT CURB? Manhole

WAS ATTACHED TO MAIN yes

NAME OF CONTRACTOR Oakes Construction

SHOW BY DIAGRAM RELATION OF LATERAL TO WALL OF BUILDING SERVED.

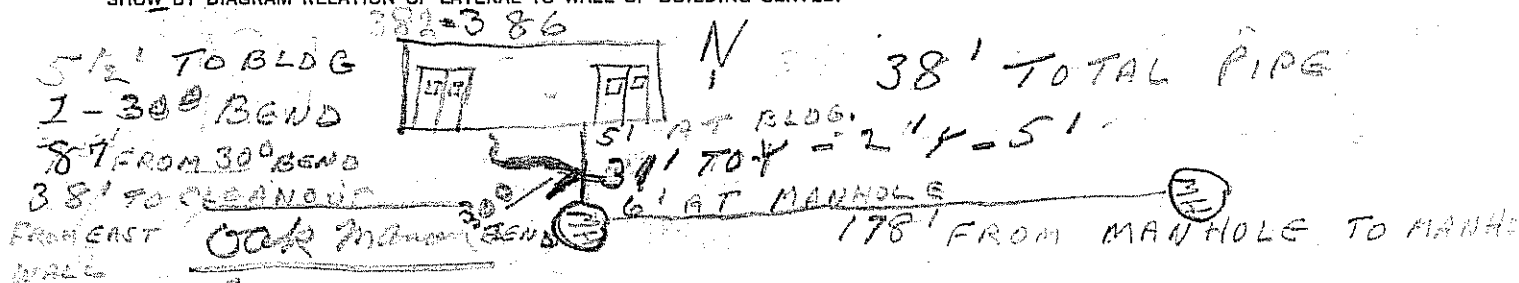

SIGNED

William Windom

Inspector for City

FILED AT ENGINEER'S OFFICE

REMARKS

Duplex
No 9358

OFFICE OF THE DIRECTOR OF PUBLIC SERVICE
PERMIT TO TAP SEWER

MASSILLON, OHIO, *March 17*

RECEIVED OF

Cahis Construction, Inc.

FEE OF \$

25.

FOR WHICH PERMISSION IS GRANTED

Cahis Construction, Inc.

TO TAP

Sanitary

SEWER ON THE

West

OF

Cah Mahan Ave. N.E.

AVE.

ST. TYPE (F STREET

Chp. & Loc

THE PREMISES BEING LOT NO.

Pl. 13996

HOUSE NO.

387-388

WORK TO BE DONE IN ACCORDANCE WITH ORDINANCE NO. 19-1971 DULY PASSED BY THE CITY COUNCIL, AND R
OF THE DEPARTMENT OF PUBLIC SERVICE.

NAME OF CONTRACTOR

Cahis

TUES 3-18
Note: This permit covers work outside of building only. Any work
walls of building is subject to Massillon Board of Health Regulations.